


RECORD DRAWING  
1/9/2008  
MLT

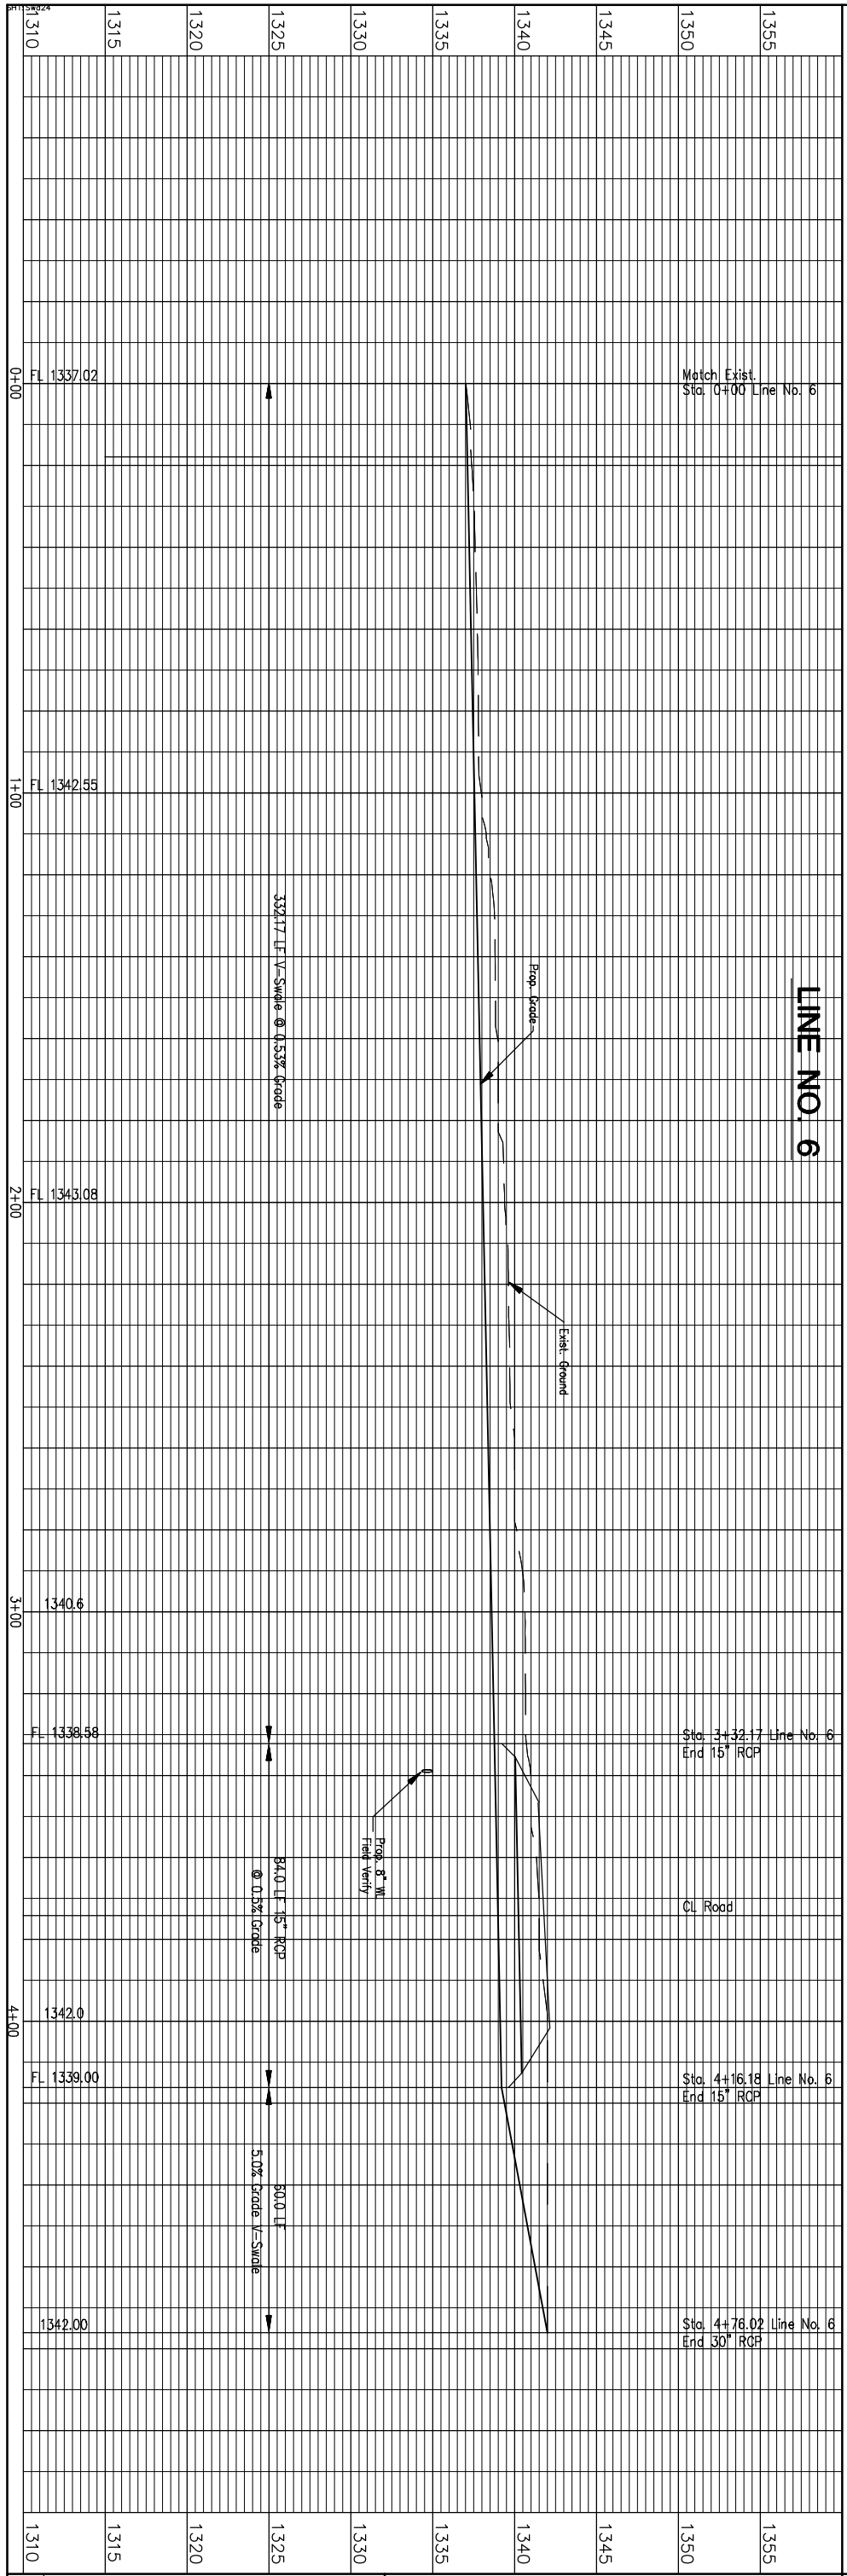

**FINAL**  
Designed By: J. Ubert / J. Dickman  
Drawn By: M. Tucker  
Poe Job No.: 1809  
Date: April 2007

**POE & ASSOCIATES, INC.**  
CONSULTING ENGINEERS  
5940 E. Central, Suite 200 ■ Wichita, KS 67208-4242  
Phone 316/685-4114 ■ FAX 316/685-4444

TERRADYNE WEST ADDITION  
STREET & STORM SEWER IMPROVEMENTS  
STORM SEWER LINE NO. 6  
CITY OF WICHITA, KANSAS  
JAMES L. ARMOUR, P.E. - CITY ENGINEER  
Private Project # 179PPP OCA# 607879

No.	Date	By	Approved	Revision
1	1/9/08	MLT	JPD	Moved Curb Inlet South to New Location