

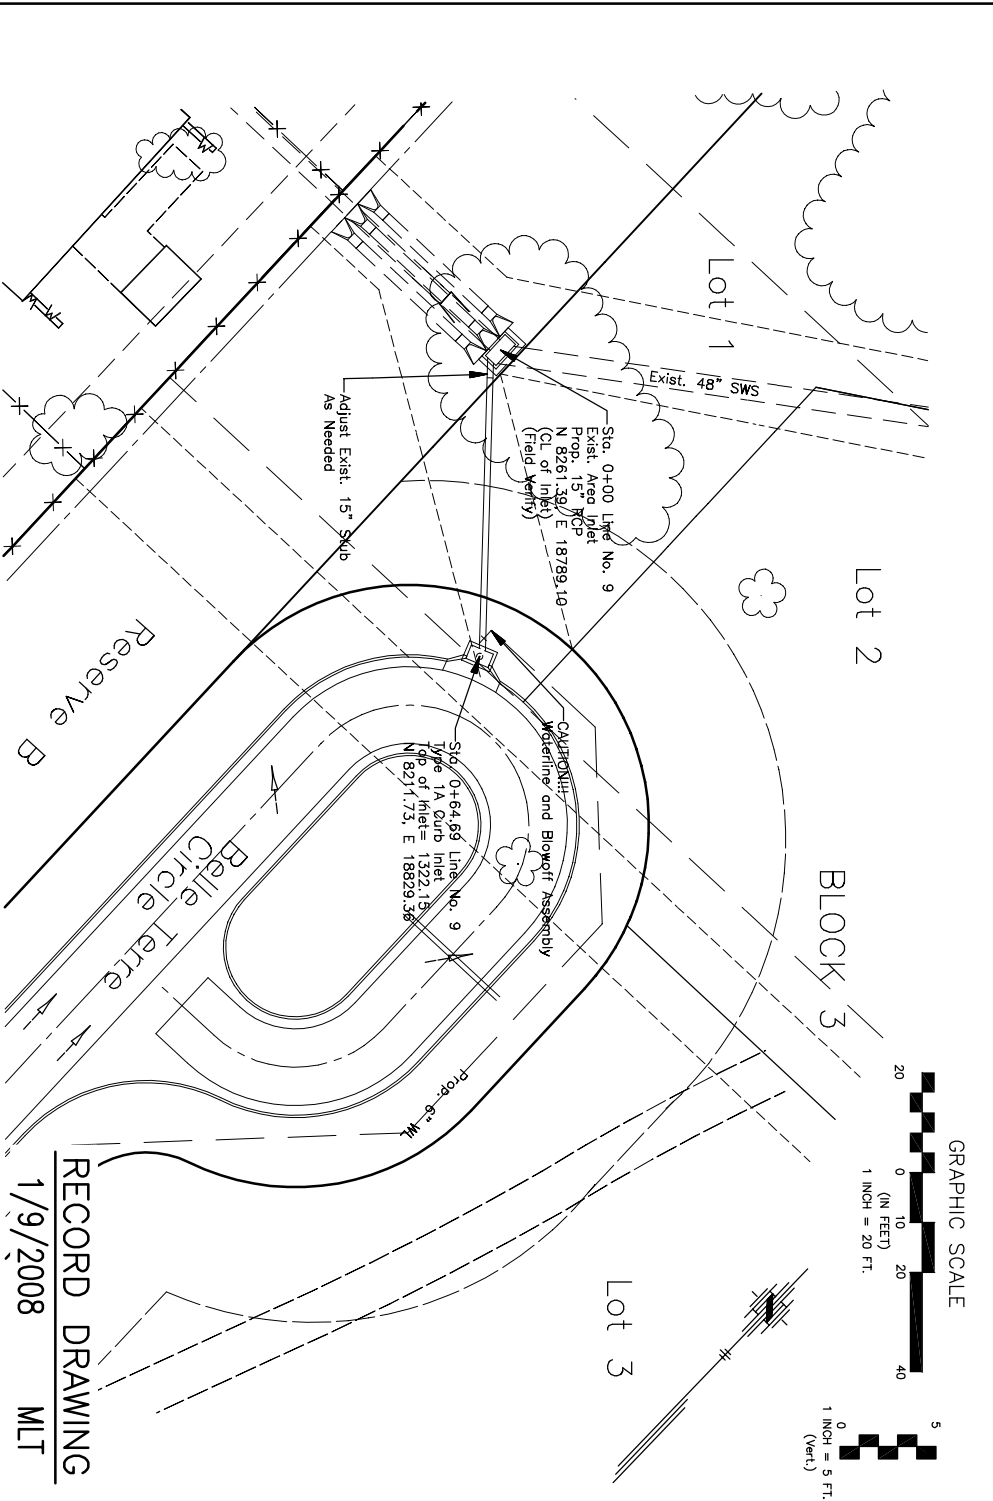
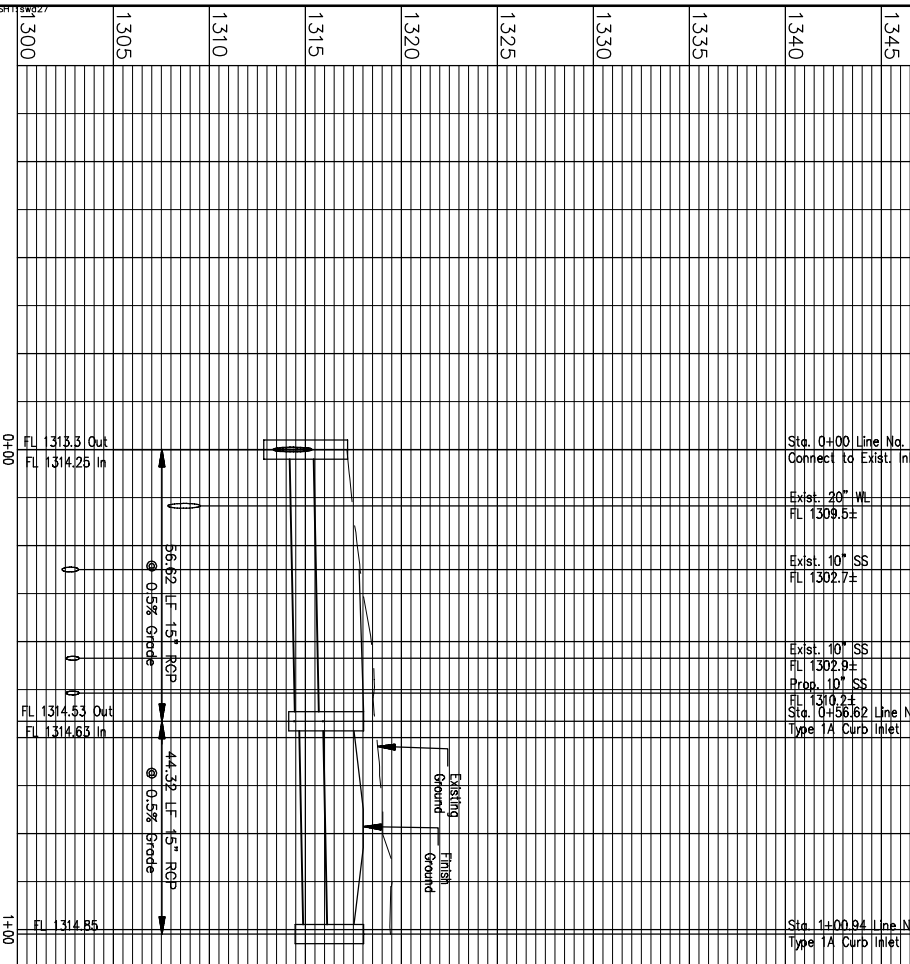


LINE NO. 8

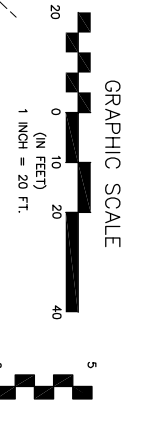

LINE NO. 9

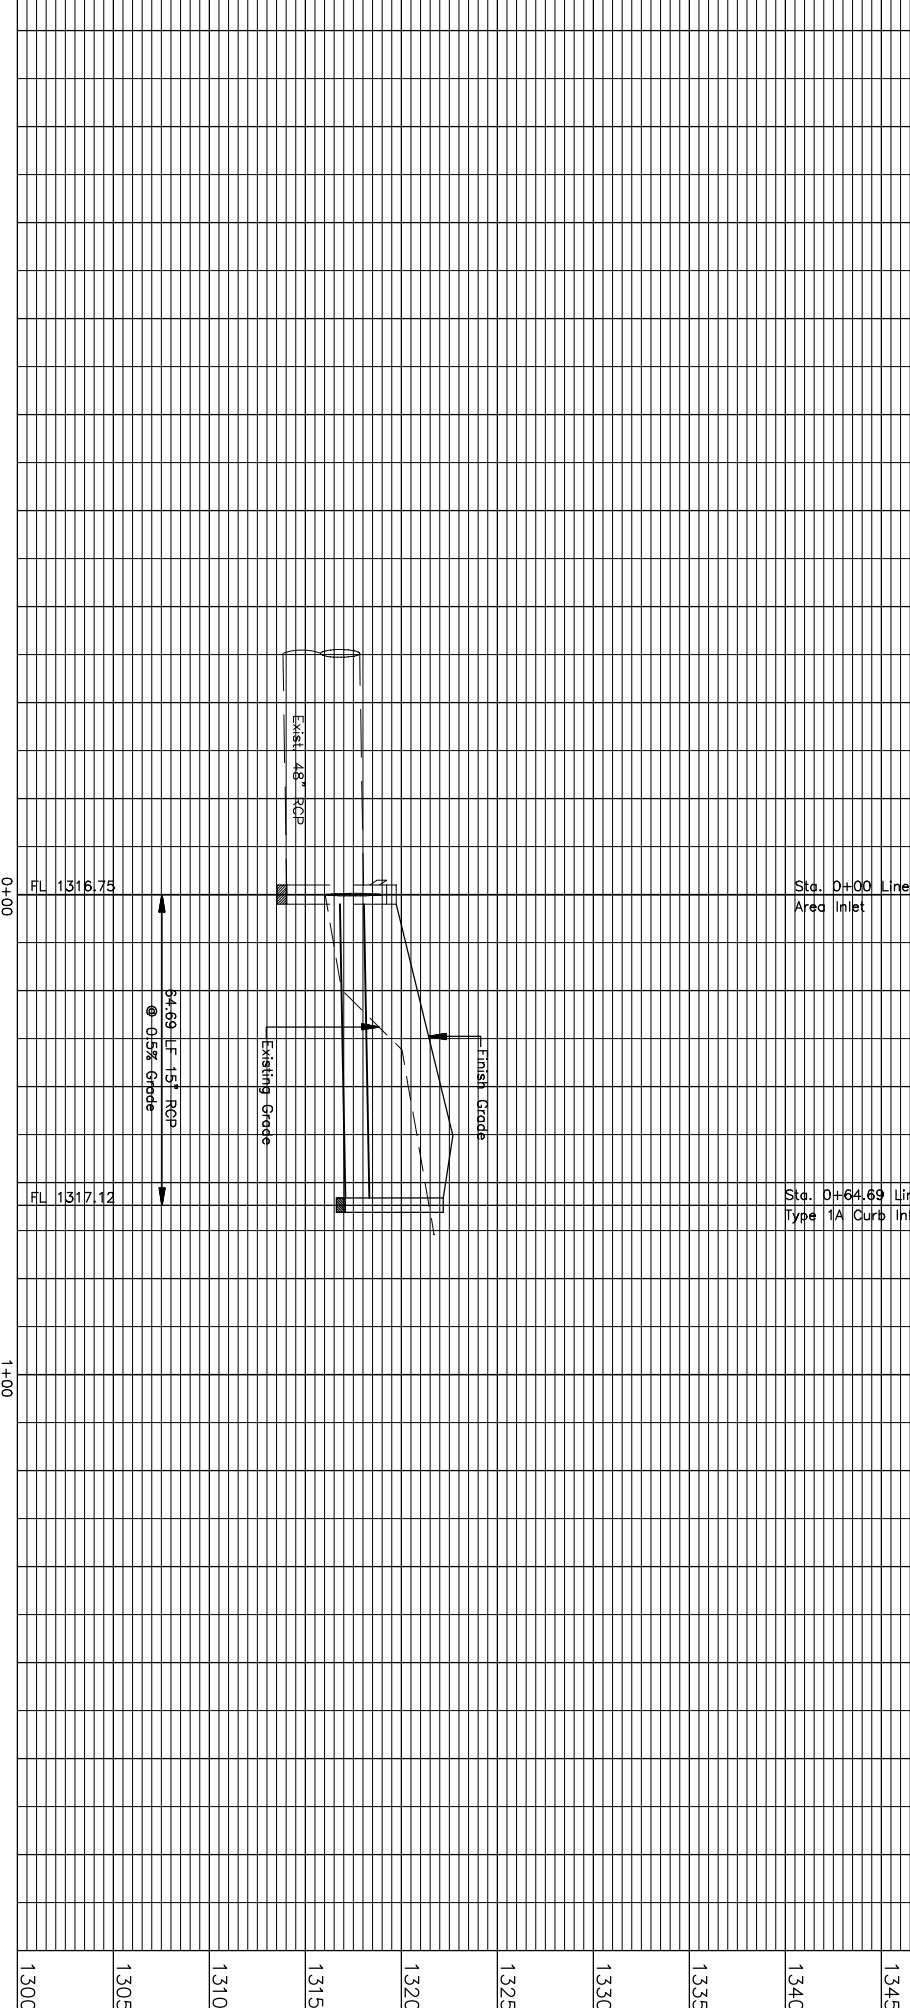

RECORD DRAWING
1/9/2008
MLT

No.	Date	By	Approved	Revision
1	1/9/08	MLT	JPD	Moved Curb Inlet South to New Location



POE & ASSOCIATES, INC.
CONSULTING ENGINEERS
5940 E. Central, Suite 200 ■ Wichita, KS 67208-4242
Phone 316/685-4114 ■ FAX 316/685-4444

FINAL
Designed By: J. Ubert / J. Dickman
Drawn By: M. Tucker
Poe Job No.: 1809
Date: April 2007

TERRADYNE WEST ADDITION
STREET & STORM SEWER IMPROVEMENTS
STORM SEWER LINE NO. 8 & 9
CITY OF WICHITA, KANSAS
JAMES L. ARMOUR, P.E. - CITY ENGINEER
Private Project # 179PPP OCA# 607879