

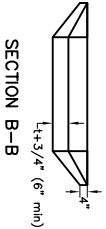
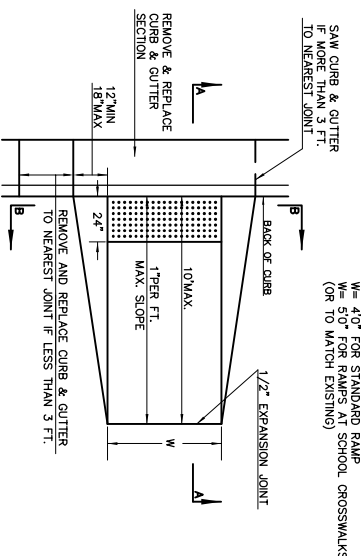




STANDARD WHEELCHAIR RAMP
CONSTRUCTION DETAIL FOR STREETS
WITH COMBINED CURB & GUTTER
(TYPE A)

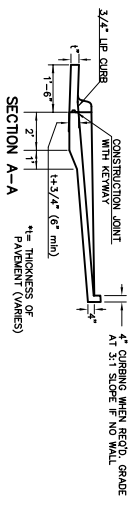



STANDARD WHEELCHAIR RAMP CONSTRUCTION DETAIL FOR STREET WITH COMBINED CURB AND GUTTER ON RADIUS WITH 6 ± FROM BACK OF CURB TO PROPERTY CORNER (TYPE C)

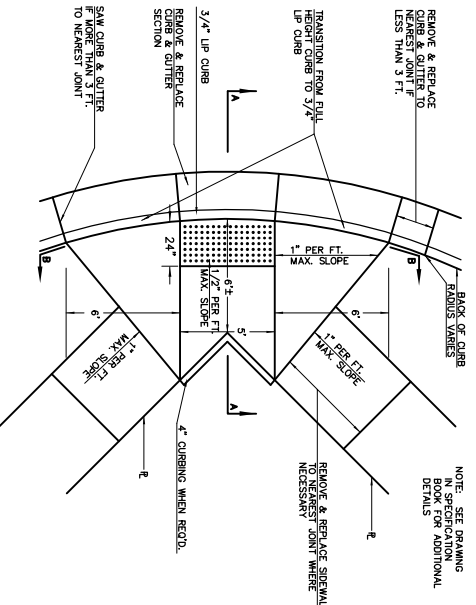



STANDARD WHEELCHAIR RAMP CONSTRUCTION DETAIL FOR CONCRETE STREETS WITH MONOLITHIC CURB (TYPE A)

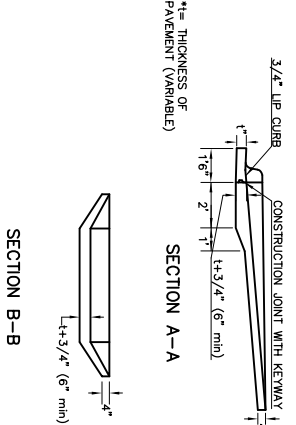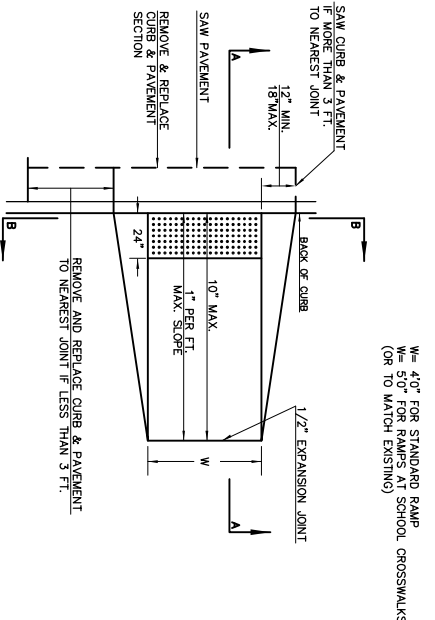



STANDARD WHEELCHAIR RAMP CONSTRUCTION DETAIL FOR STREET WITH MONOLITHIC CURB ON RADIUS WITH 6 ± FROM BACK OF CURB TO PROPERTY CORNER (TYPE C)

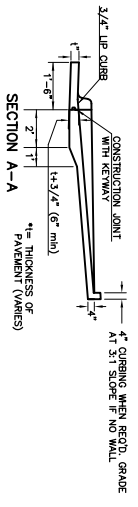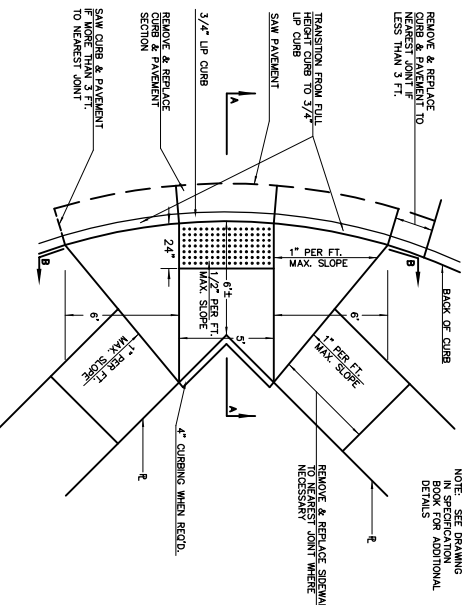




STANDARD WHEELCHAIR RAMP CONSTRUCTION DETAIL FOR STREETS WITH COMBINED CURB & GUTTER AND FULL WALK (TYPE B)

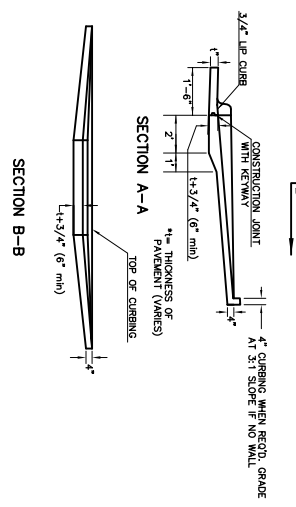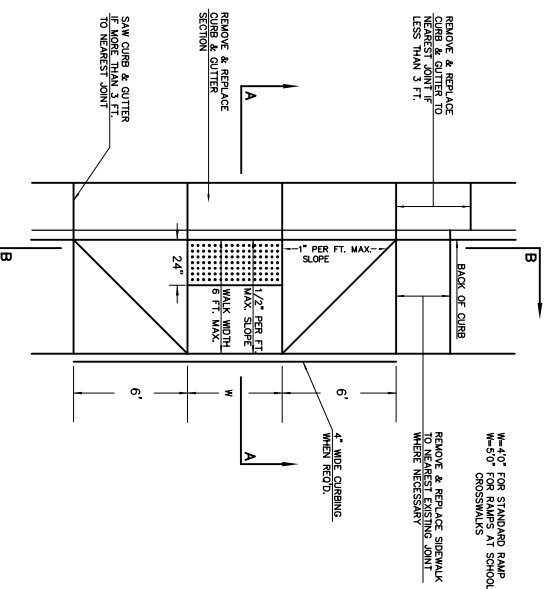


STANDARD WHEELCHAIR RAMP CONSTRUCTION DETAIL FOR STREETS WITH COMBINED CURB & GUTTER WITH ONE FULL SIDEWALK (TYPE D)

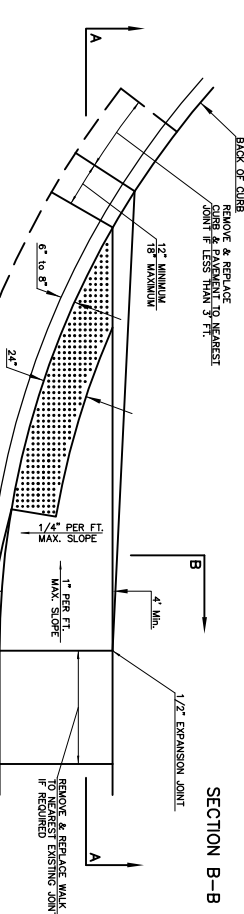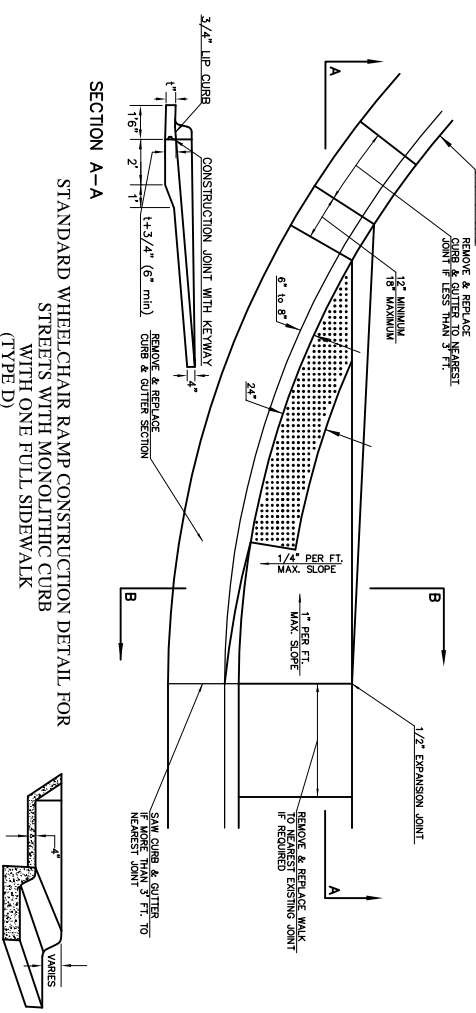

STANDARD WHEELCHAIR RAMP CONSTRUCTION DETAIL FOR STREETS WITH MONOLITHIC CURB AND FULL WALK (TYPE B)

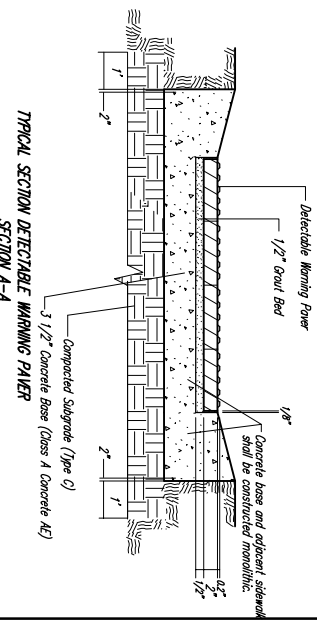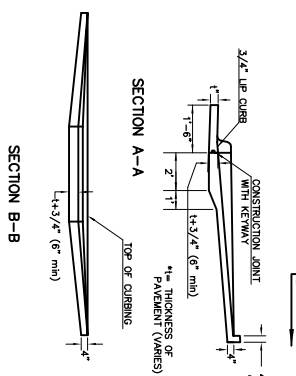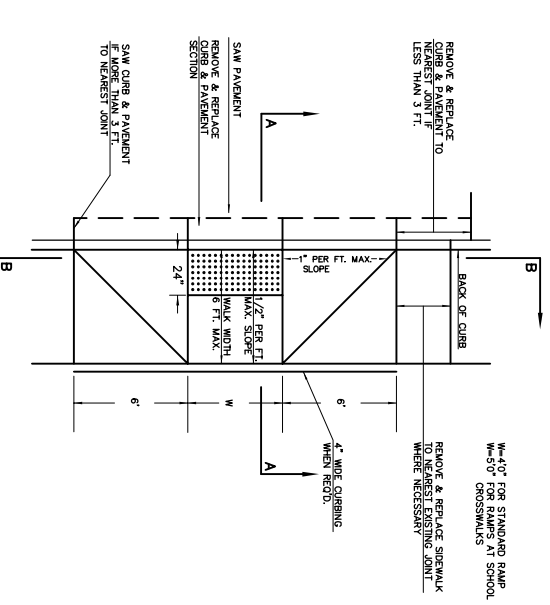

NOTE: HANOVER DETECTABLE WARNING PAPERS (OR AN APPROVED ALTERNATE) SHALL BE USED IN ALL WHEELCHAIR RAMPS. THE 11 3/4\"/>

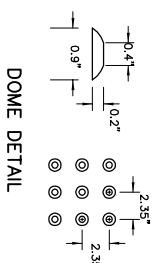

RECORD DRAWING
1/9/2008
MLT

No.	Date	By	Approved	Revision
1	1/9/08	MLT	JPD	Moved Curb Inlet South to New Location

CITY OF WICHITA PUBLIC WORKS ENGINEERING

WHEELCHAIR RAMP DETAILS

CITY ENGINEER
JAMES L. ARMOUR, P.E.

PROJECT NUMBER: 179PPP
O&A NUMBER: 607879
DATE: 03/07

CITY ENGINEER'S OFFICE
CITY HALL - SEVENTH FLOOR
425 NORTH MAIN STREET
WICHITA, KS 67202-4500
(316) 268-4500
(316) 268-4114 FAX

DESIGN: BSKM
DRAWN: BSKM
SHEET: 81 OF 94

FINAL

Designed By: J. Ubert / J. Dickman
Drawn By: M. Tucker
Poe Job No.: 1809
Date: April 2007



POE & ASSOCIATES, INC.
CONSULTING ENGINEERS
5940 E. Central, Suite 200 ■ Wichita, KS 67208-4242
Phone 316/685-4114 ■ FAX 316/685-4444

TERRADYNE WEST ADDITION
STREET & STORM SEWER IMPROVEMENTS
WHEELCHAIR RAMP DETAILS
CITY OF WICHITA, KANSAS
JAMES L. ARMOUR, P.E. - CITY ENGINEER
Private Project # 179PPP OCA# 607879