

# WATER DISTRIBUTION SYSTEM IMPROVEMENTS

TO SERVE

## KEY CONSTRUCTION, INC.

741 W. 2ND STREET


PRIVATE PROJECT NO. 1350 PPW (607853)

## CITY OF WICHITA, KANSAS

JAMES L. ARMOUR, P.E. - CITY ENGINEER

### INDEX OF SHEETS

SHEET NO. 1	TITLE SHEET
SHEET NO. 2	KEY MAP AND GENERAL NOTES
SHEET NO. 3	STANDARD DETAILS
SHEET NO. 4	PLAN/PROFILE
SHEET NO. 5-7	SOIL EROSION BMP DETAILS

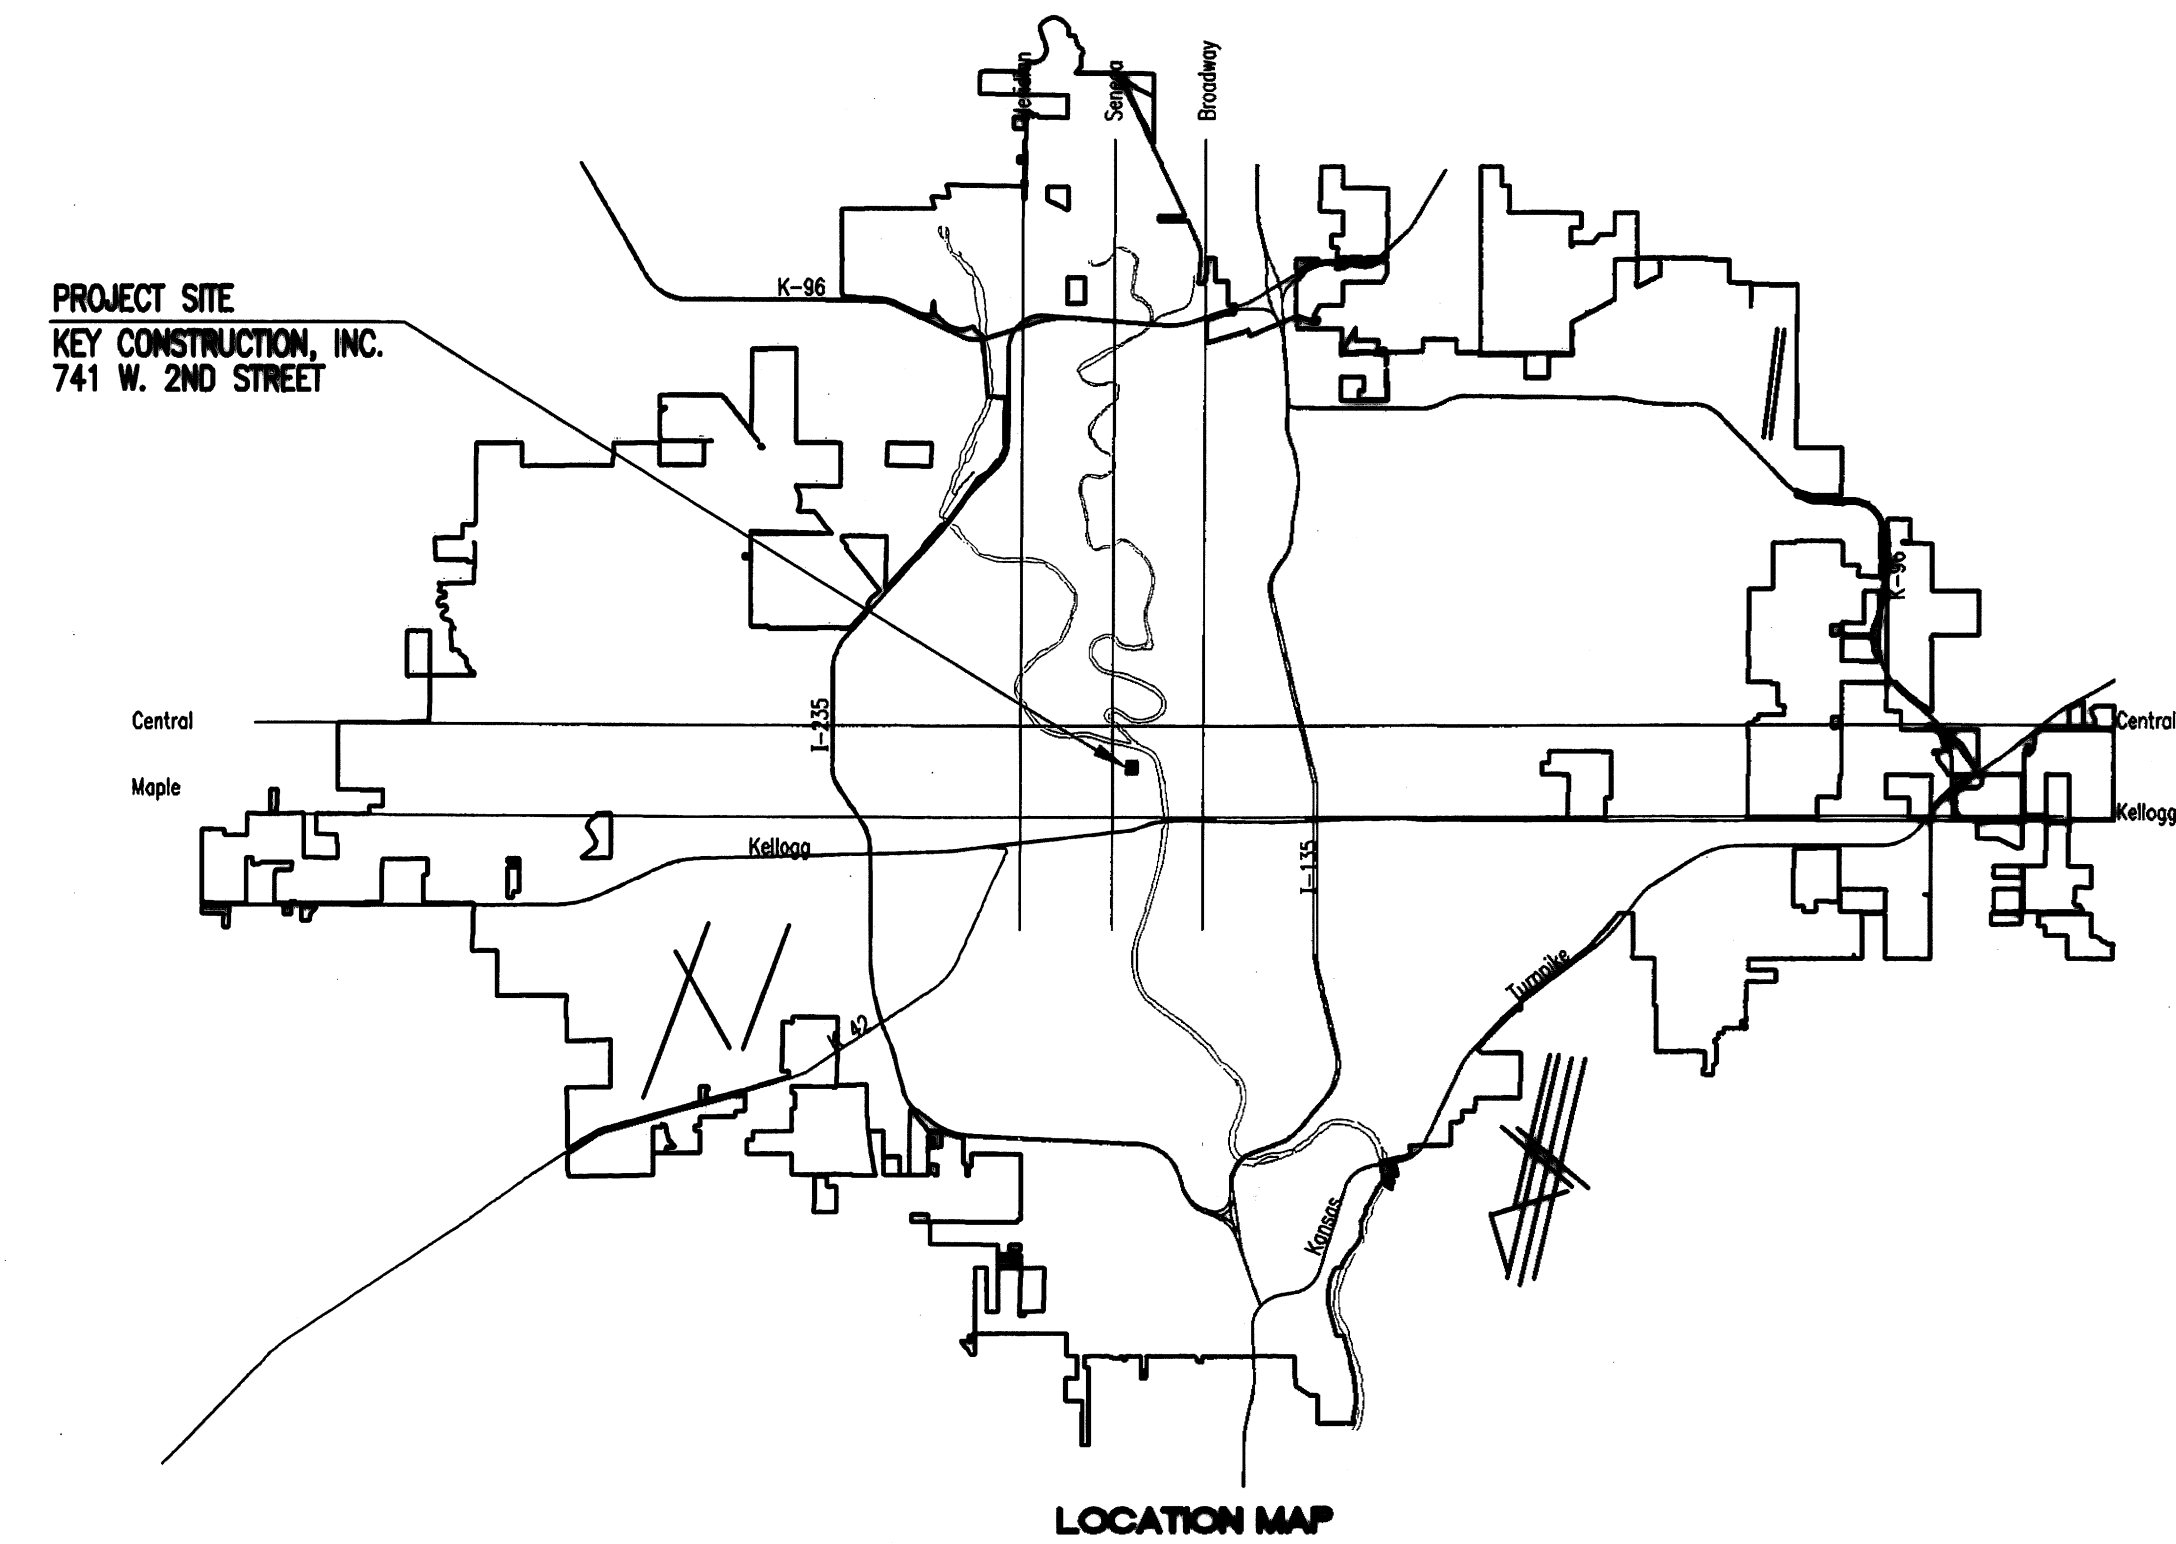

APPROVED AS NOTED  
BY CITY ENGINEER OF WICHITA,  
BY WICHITA WATER & SEWER DEPARTMENT,


Water Mains (Public Works) *[Signature]* 9/18/07  
Water Mains (Water and Sewer Dept.) *[Signature]* 9/19/07

NOTE TO CONTRACTORS

**PUBLIC PROPERTY:**  
Inspection and testing for the waterline is to be provided by a Licensed Consulting Engineering Firm under contract with the Owner/Developer. Said inspection to be in accordance with the City of Wichita standard construction engineering practices and certified by a Licensed Professional Engineer licensed in the State of Kansas. No work shall be performed in dedicated easements or public right-of-way by the Contractor without such inspection nor shall any work be commenced without written authorization by the City Engineer. All Construction and Materials shall comply with the City of Wichita Specifications and Standards (on file and available in the City Engineer's Office).

The contractor shall not start work until the project inspector is assigned to the project and present on the site. Any work done without inspection will be required to be uncovered for inspection.

**As Built Plans:**  
 CONTRACTOR: McCullough Exc.  
 INSPECTOR: Larry Gann, K E Miller Engineering  
 .PDF by: LGG, 1-10-08

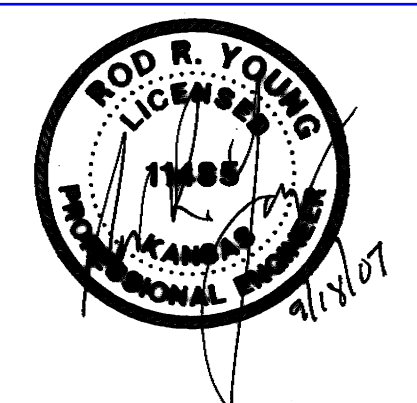

## SEPTEMBER 2007

PLANS PREPARED BY  
**PROFESSIONAL ENGINEERING CONSULTANTS, P.A.**  
 ENGINEERS  
 WICHITA, KANSAS