
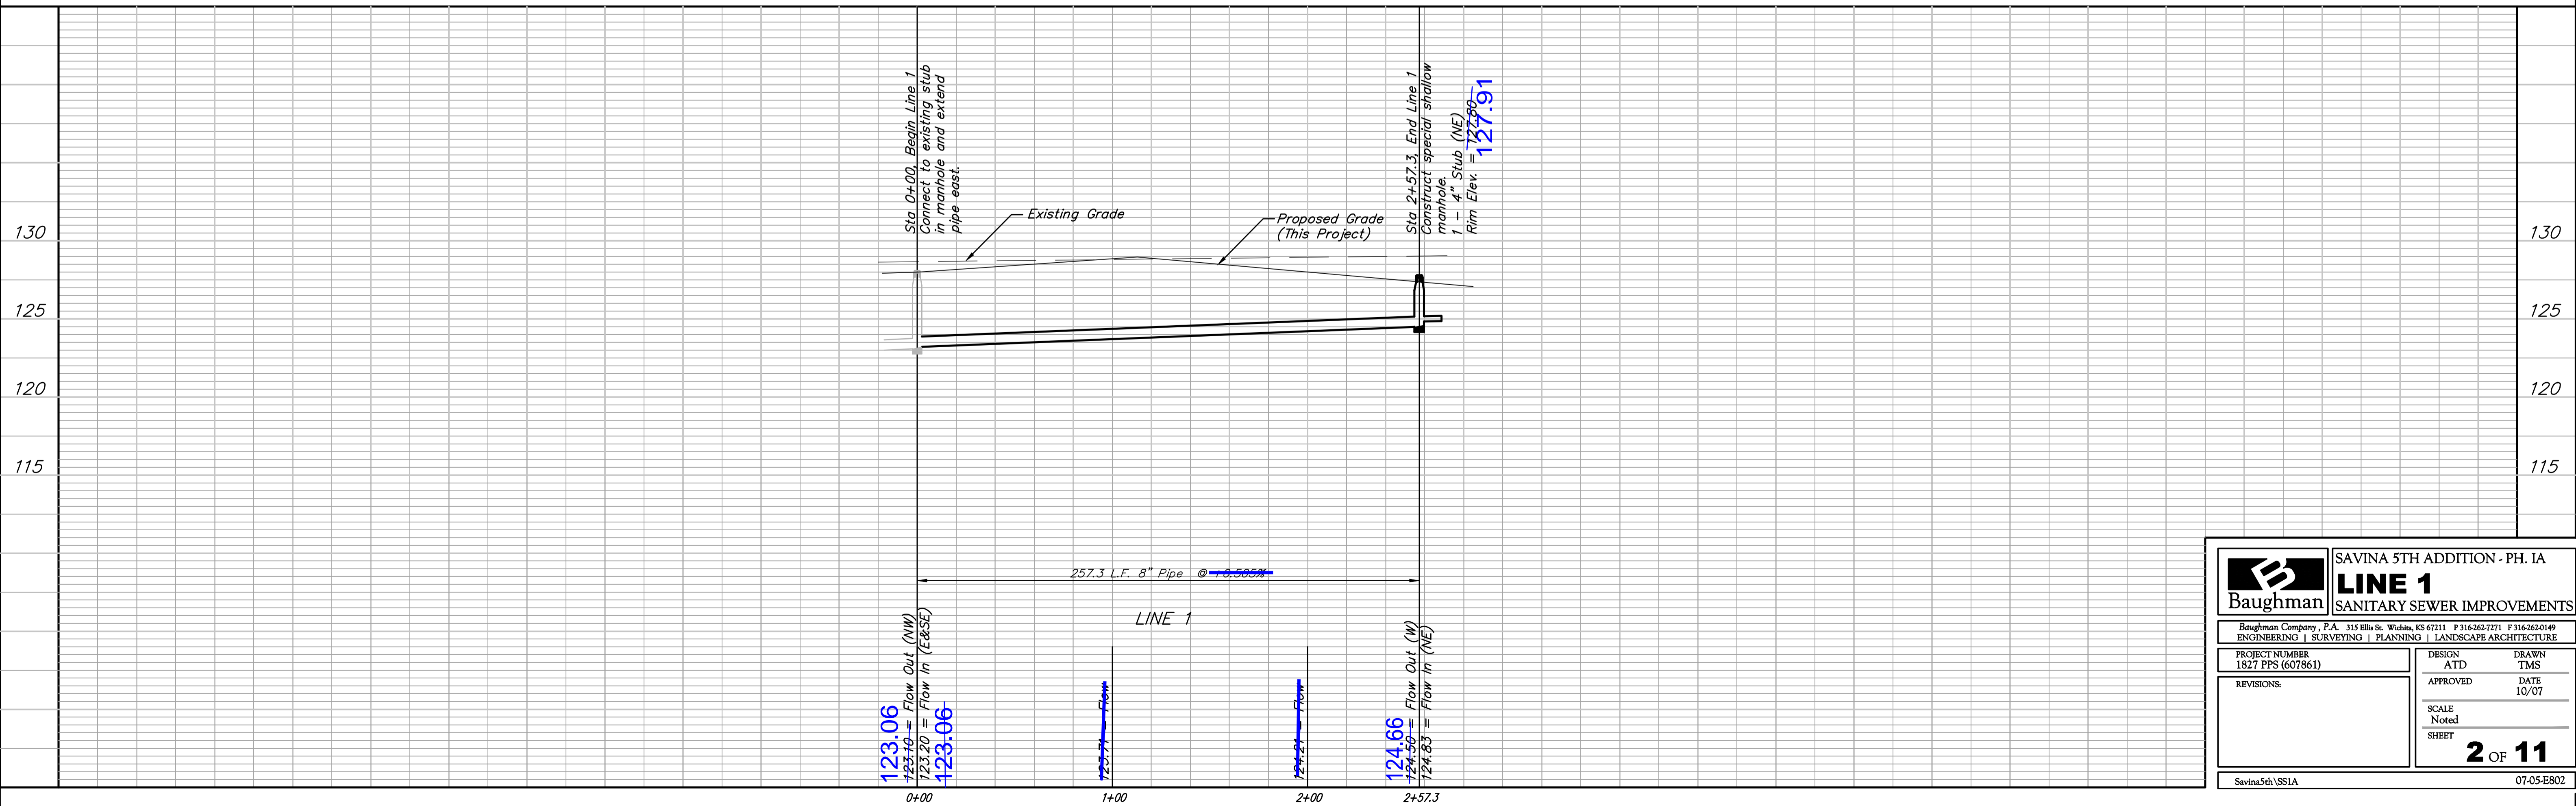


BENCHMARK:
 BM #1: ARKANSAS AND 33RD ST. N.
 C.O.W. BENCHMARK
 32.00 FT SOUTH OF CENTERLINE OF
 33RD ST. GOING EAST
 22.00 FT EAST OF CENTERLINE OF
 ARKANSAS
 ELEV= 1317.21 (NGVD 29)
 ELEV= 129.81 (CITY DATUM)

BM #2: C.O.W. DISK NE BRIDGE
 HEADWALL 33RD AND DRAINAGE
 CANAL
 ELEV= 1320.98 (NGVD29)
 ELEV= 133.58 (CITY DATUM)

Scale: 1" = 40' Horizontal
 1" = 5' Vertical
 • = Iron

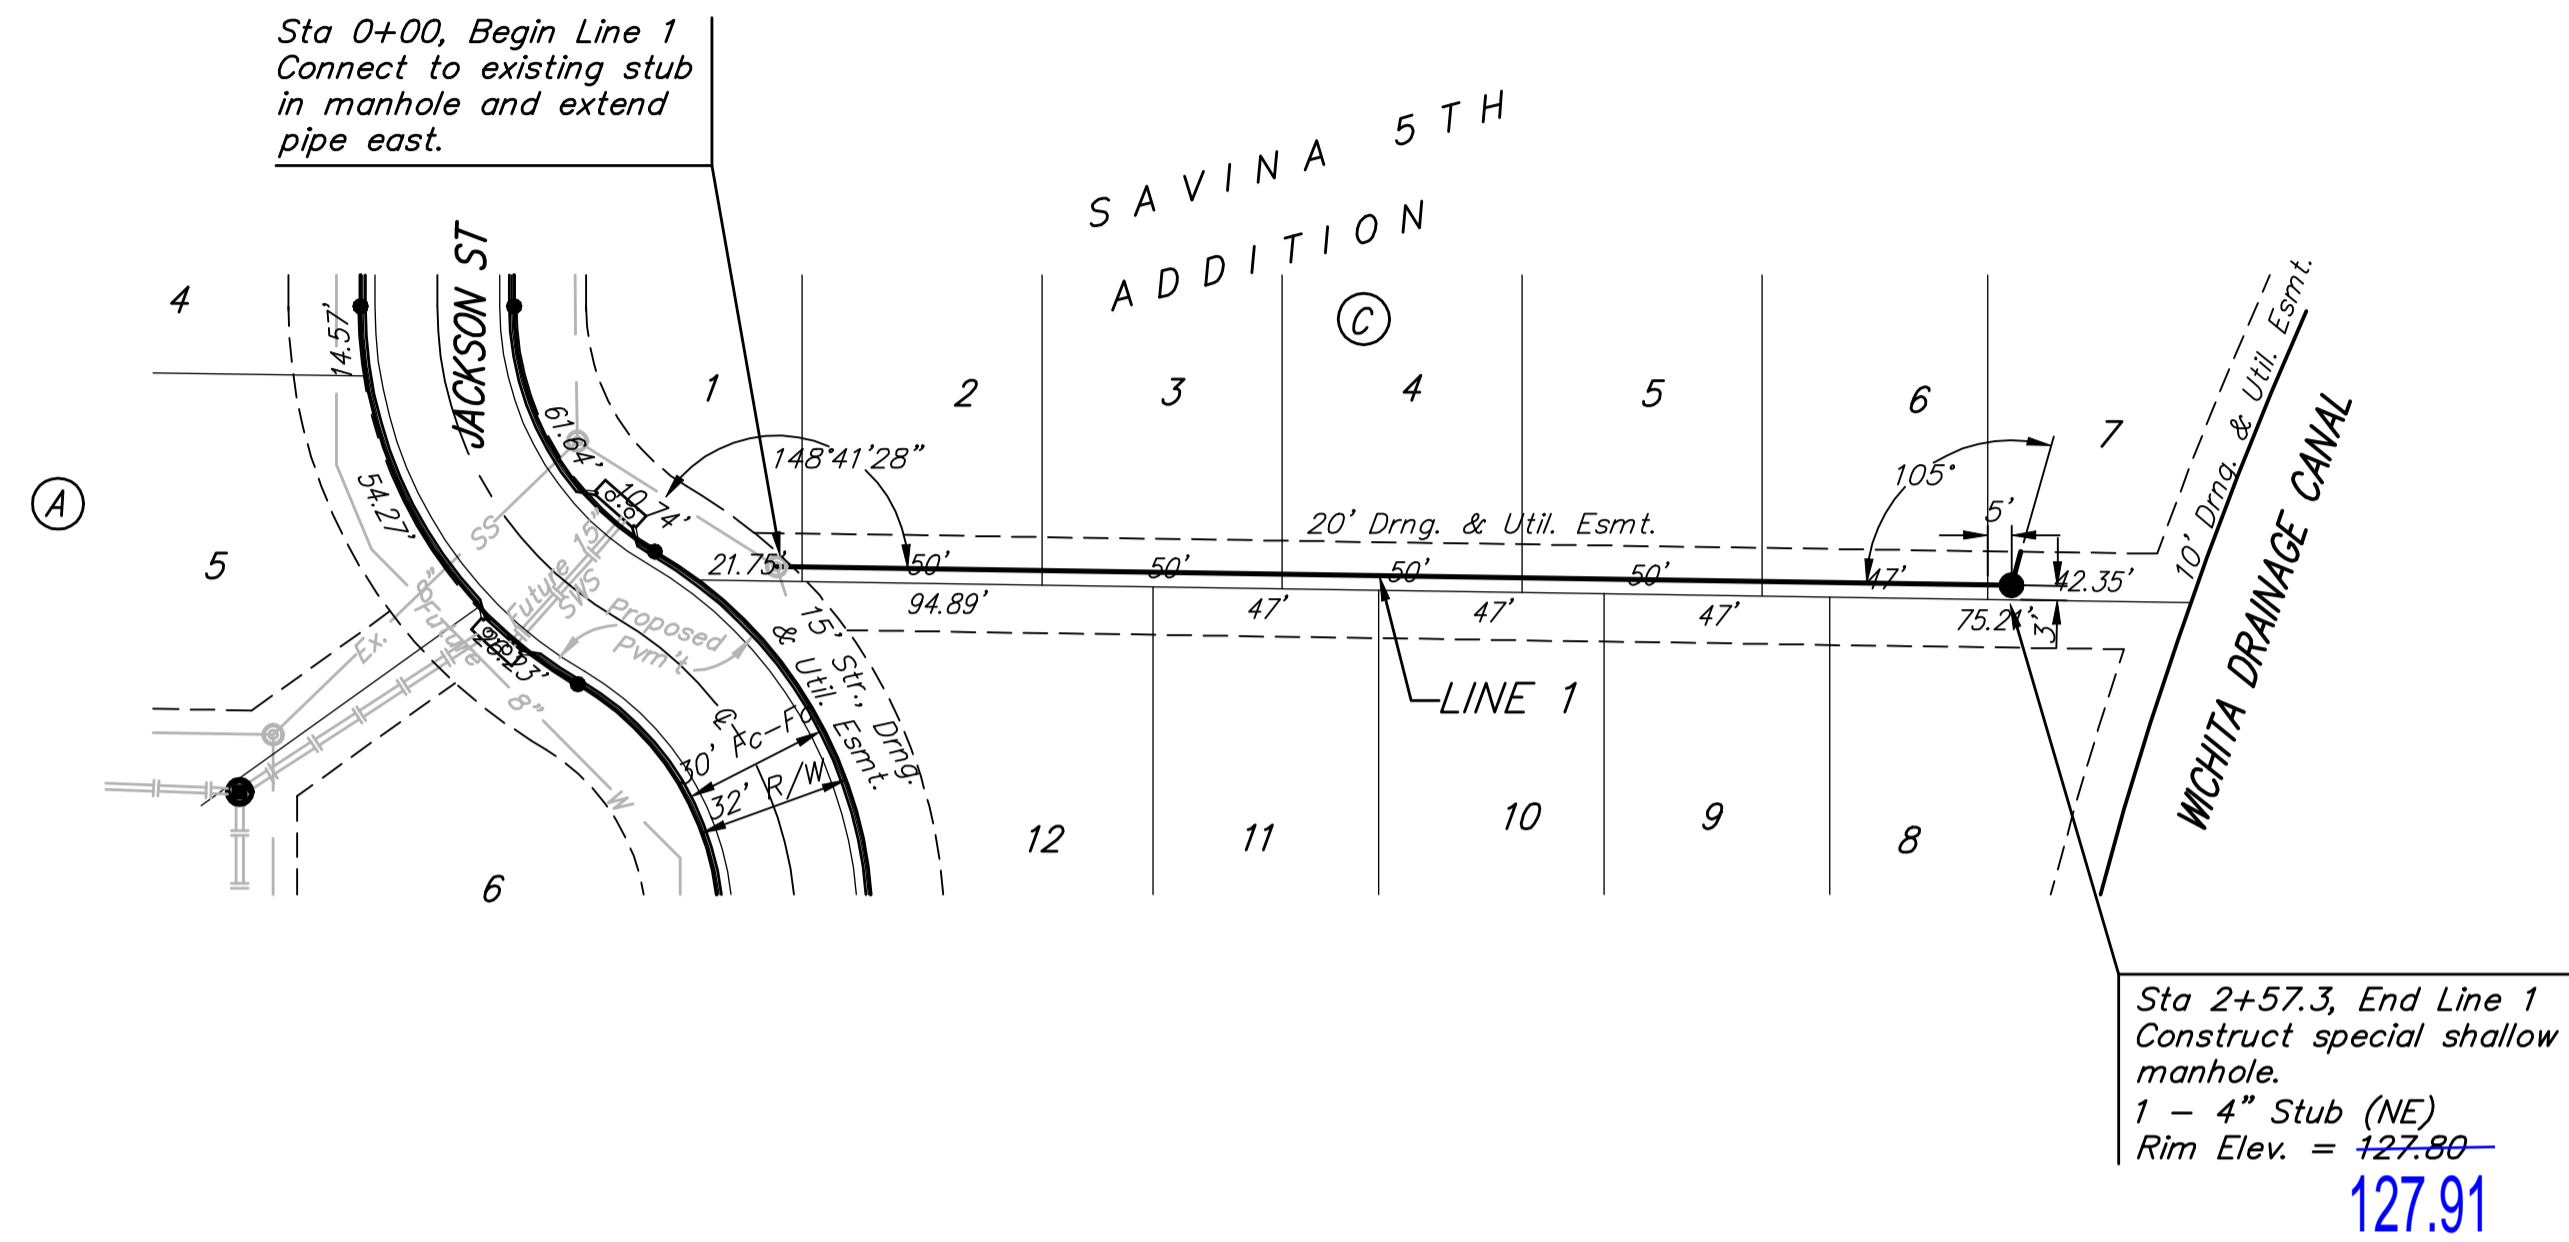

	SAVINA 5TH ADDITION - PH. IA LINE 1 SANITARY SEWER IMPROVEMENTS	
	<small>Baughman Company, P.A. 315 Ellis St. Wichita, KS 67211 P 316-262-7271 F 316-262-0149 ENGINEERING SURVEYING PLANNING LANDSCAPE ARCHITECTURE</small>	
PROJECT NUMBER 1827 PPS (607861)	DESIGN ATD	DRAWN TMS
REVISIONS:	APPROVED	DATE 10/07
SCALE Noted		SHEET 2 OF 11
<small>Savina5th\SS1A</small>		<small>07-05-E802</small>