

MH 1-4
STA 12+05.85 LINE 1
CONSTRUCT STD TYPE P MANHOLE
SEE SHEET 2


TRIM & REMOVE TREES ONLY AS
NECESSARY FOR CONSTRUCTION.
SUBSIDIARY TO "SITE CLEARING
AND RESTORATION".

MH 1-5
STA ~~15+02.53~~ LINE 1
CONSTRUCT STD TYPE P MANHOLE
TOP ELEV. = ~~1338.4~~
1338.09


MH 1-6 19+68.79
STA ~~19+02.53~~ LINE 1
CONSTRUCT STD TYPE P MANHOLE
TOP ELEV. = ~~1337.7~~
1337.86

MH 1-7 22+44.4
STA ~~22+02.53~~ LINE 1
CONSTRUCT STD TYPE P MANHOLE
TOP ELEV. = ~~1338.3~~
1338.44

UNPLATTED

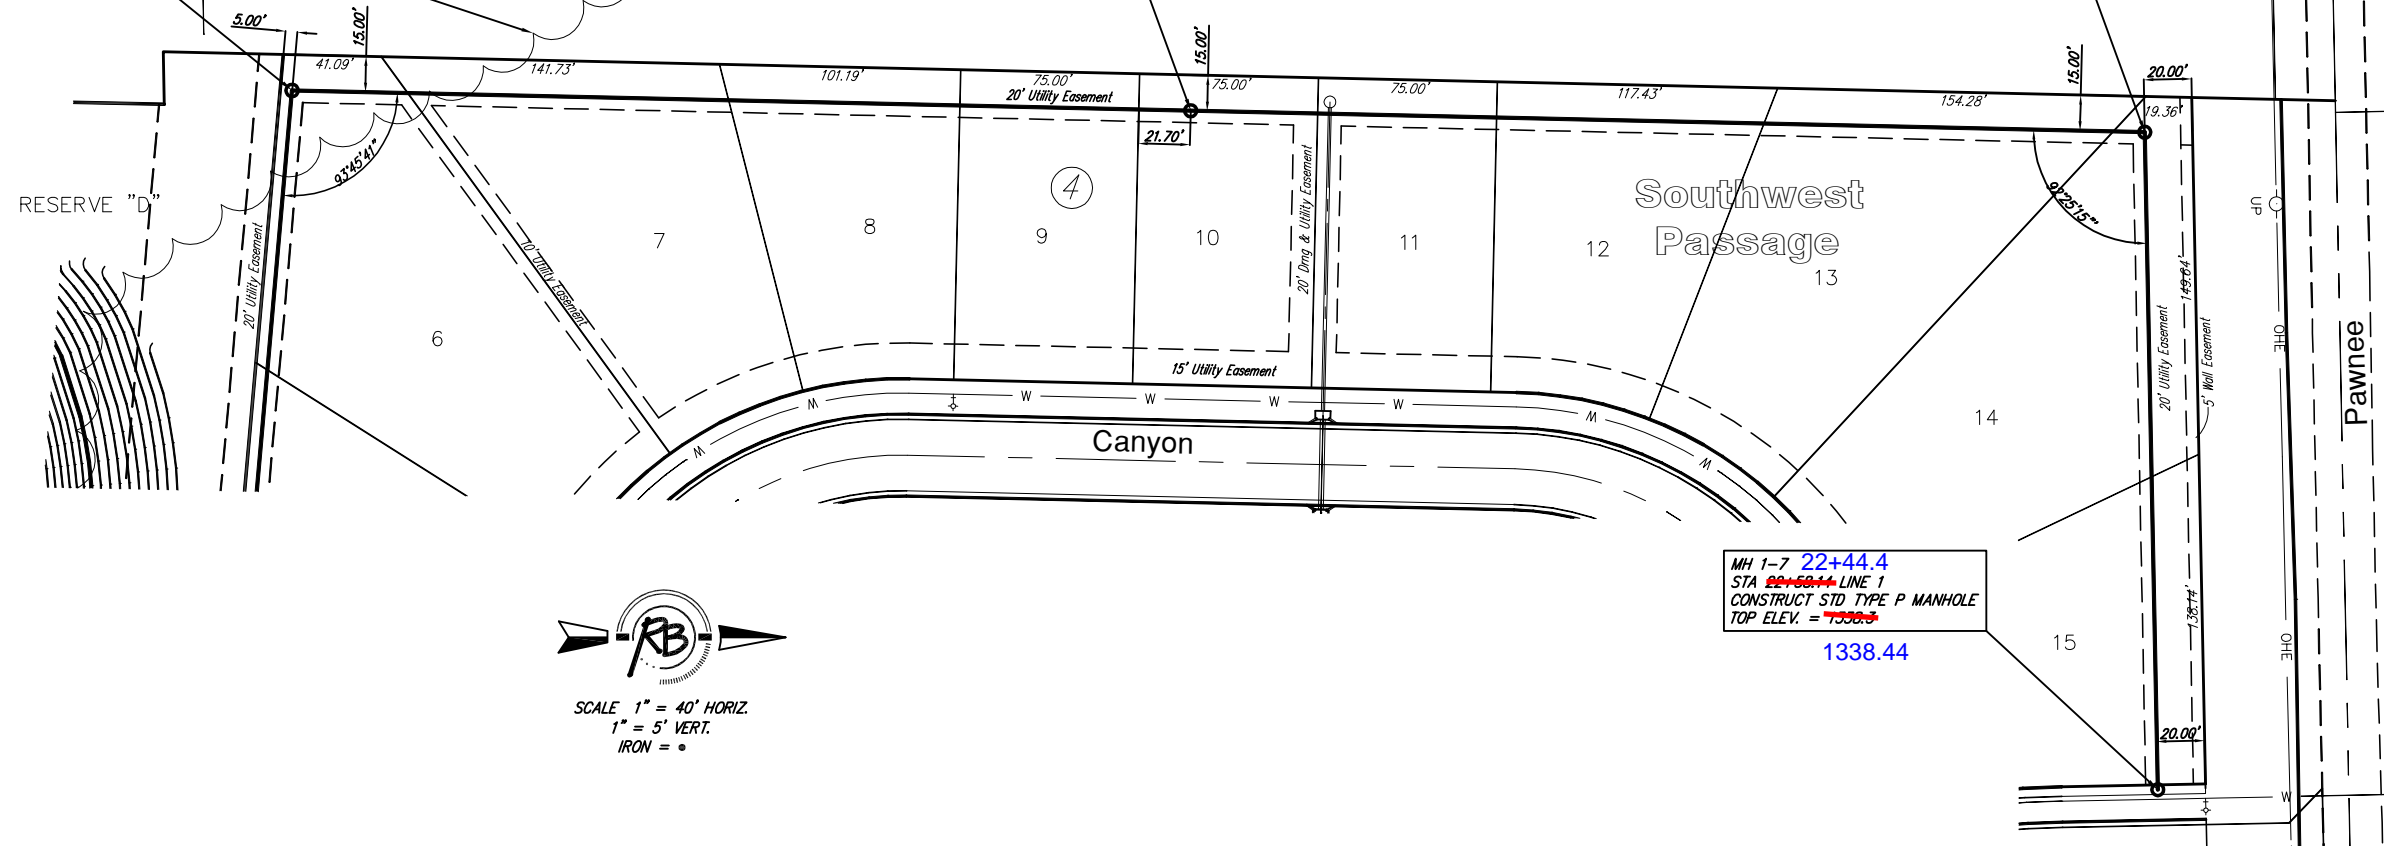

SCALE 1" = 40' HORIZ.
1" = 5' VERT.
IRON = ●

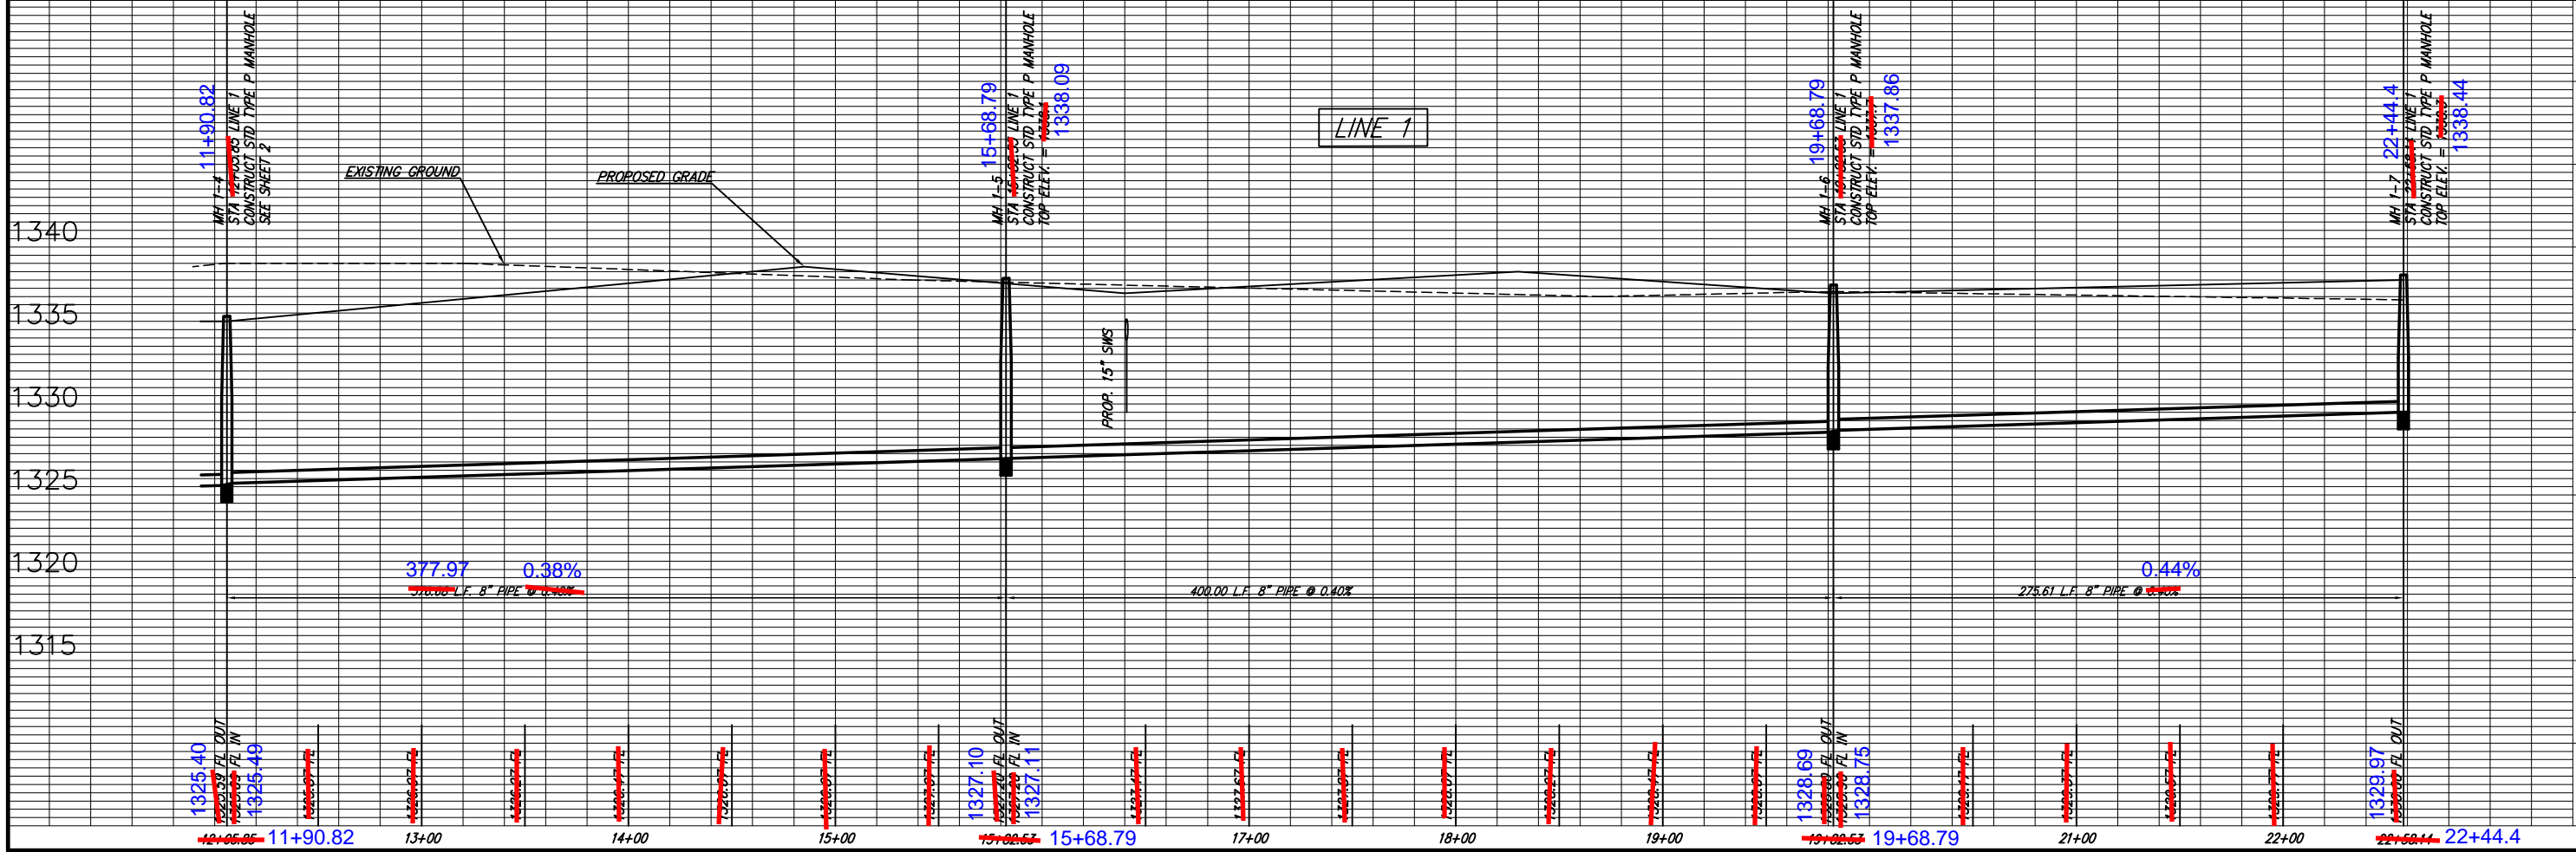

Ruggles & Bohm, P.A.
Engineering, Surveying, Land Planning
1000 West Main Street
Wichita, Kansas 67202
www.rugglesandbohm.com

PROJECT NUMBER 468-84228	DESIGN KWL	DRAWN JDM	REVIEW JDM
DRAWING FILE Sanitary Sewer [LINE 1A]	UTILITY	DATE Oct. 16, 2006	REVIEW
SOUTHWEST PASSAGE PHASE 1 Sanitary Sewer WICHITA, KANSAS			
RB JOB 2927E	SHEET 16		