



TAP-Y LOCATIONS	
STATION	DIRECTION
2+95	NORTH
4+08	EAST
4+33	WEST
4+53	WEST
4+57	EAST
4+85	EAST
5+05	WEST
5+50	WEST
6+24	WEST
6+27	EAST
6+69	WEST
6+70.5	EAST
7+15	WEST
7+19	WEST
7+21	EAST
8+19	EAST

SITE 1


1990 S.S. RECORDS PH I
 958-82000 030426
 AS BUILT


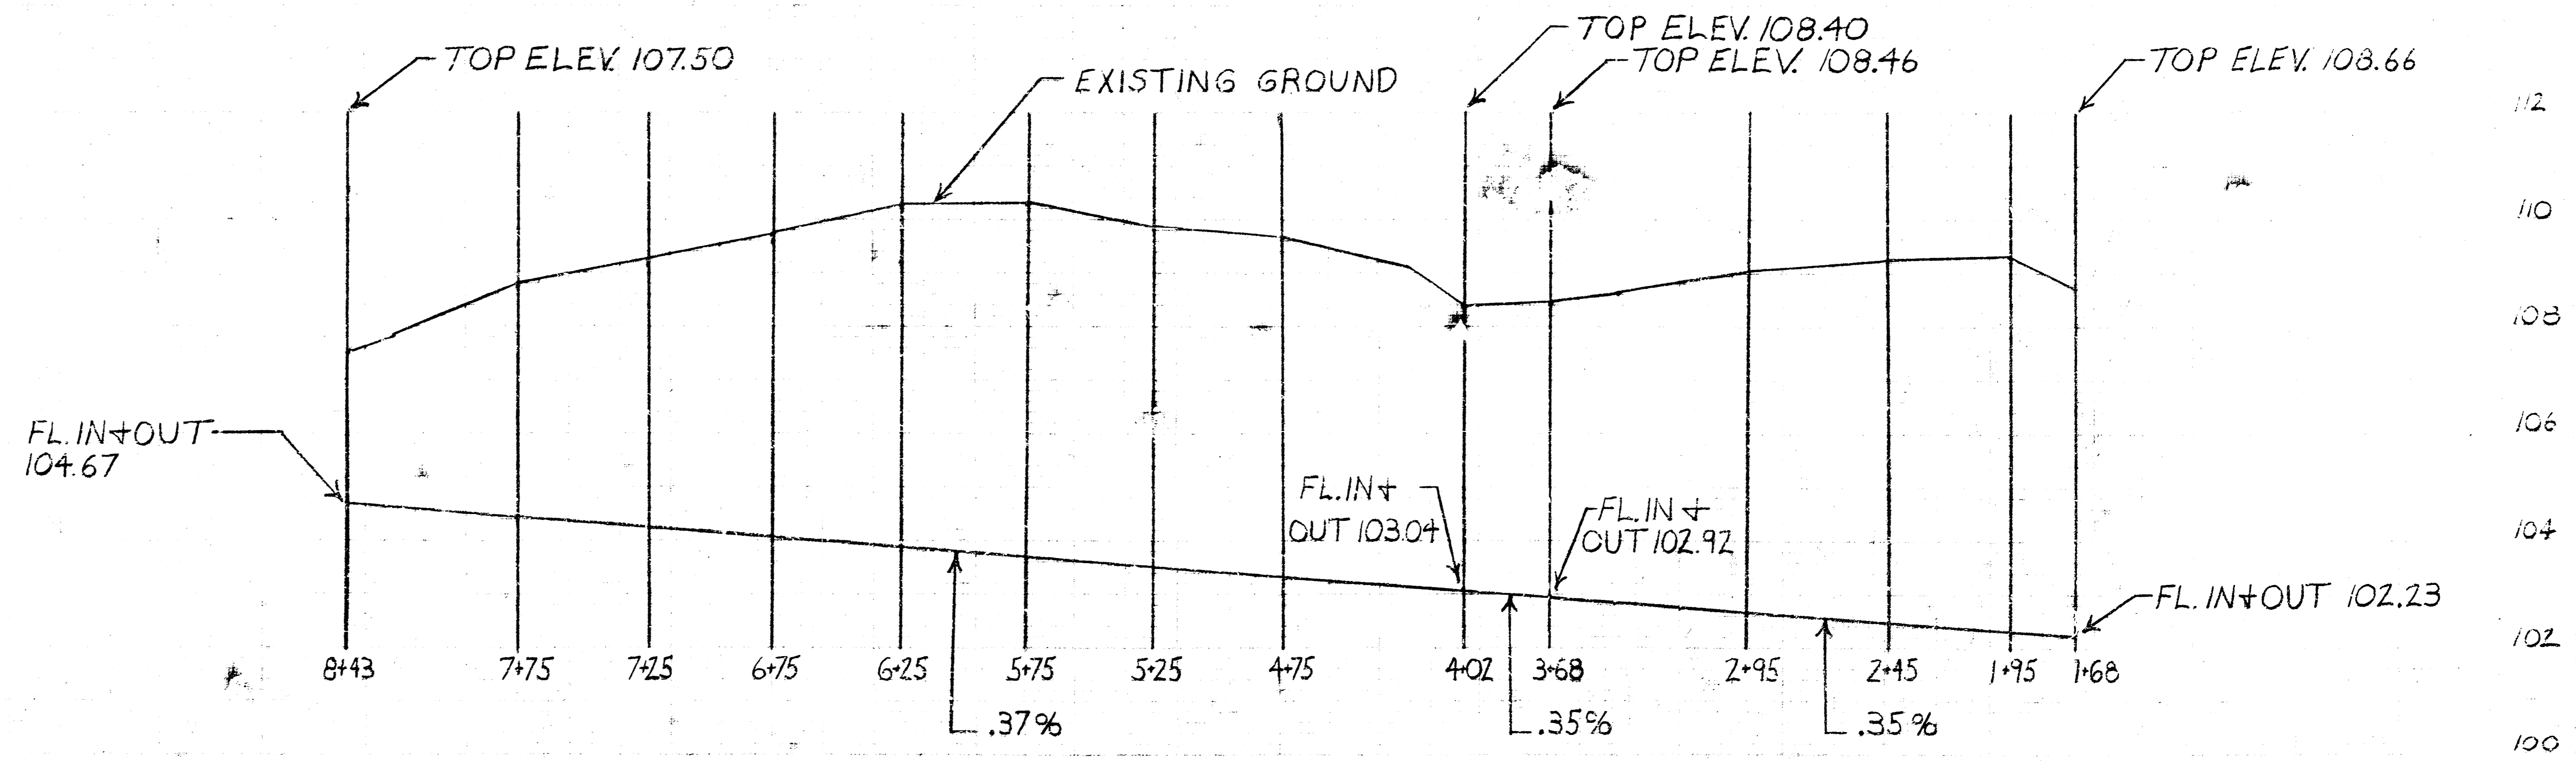


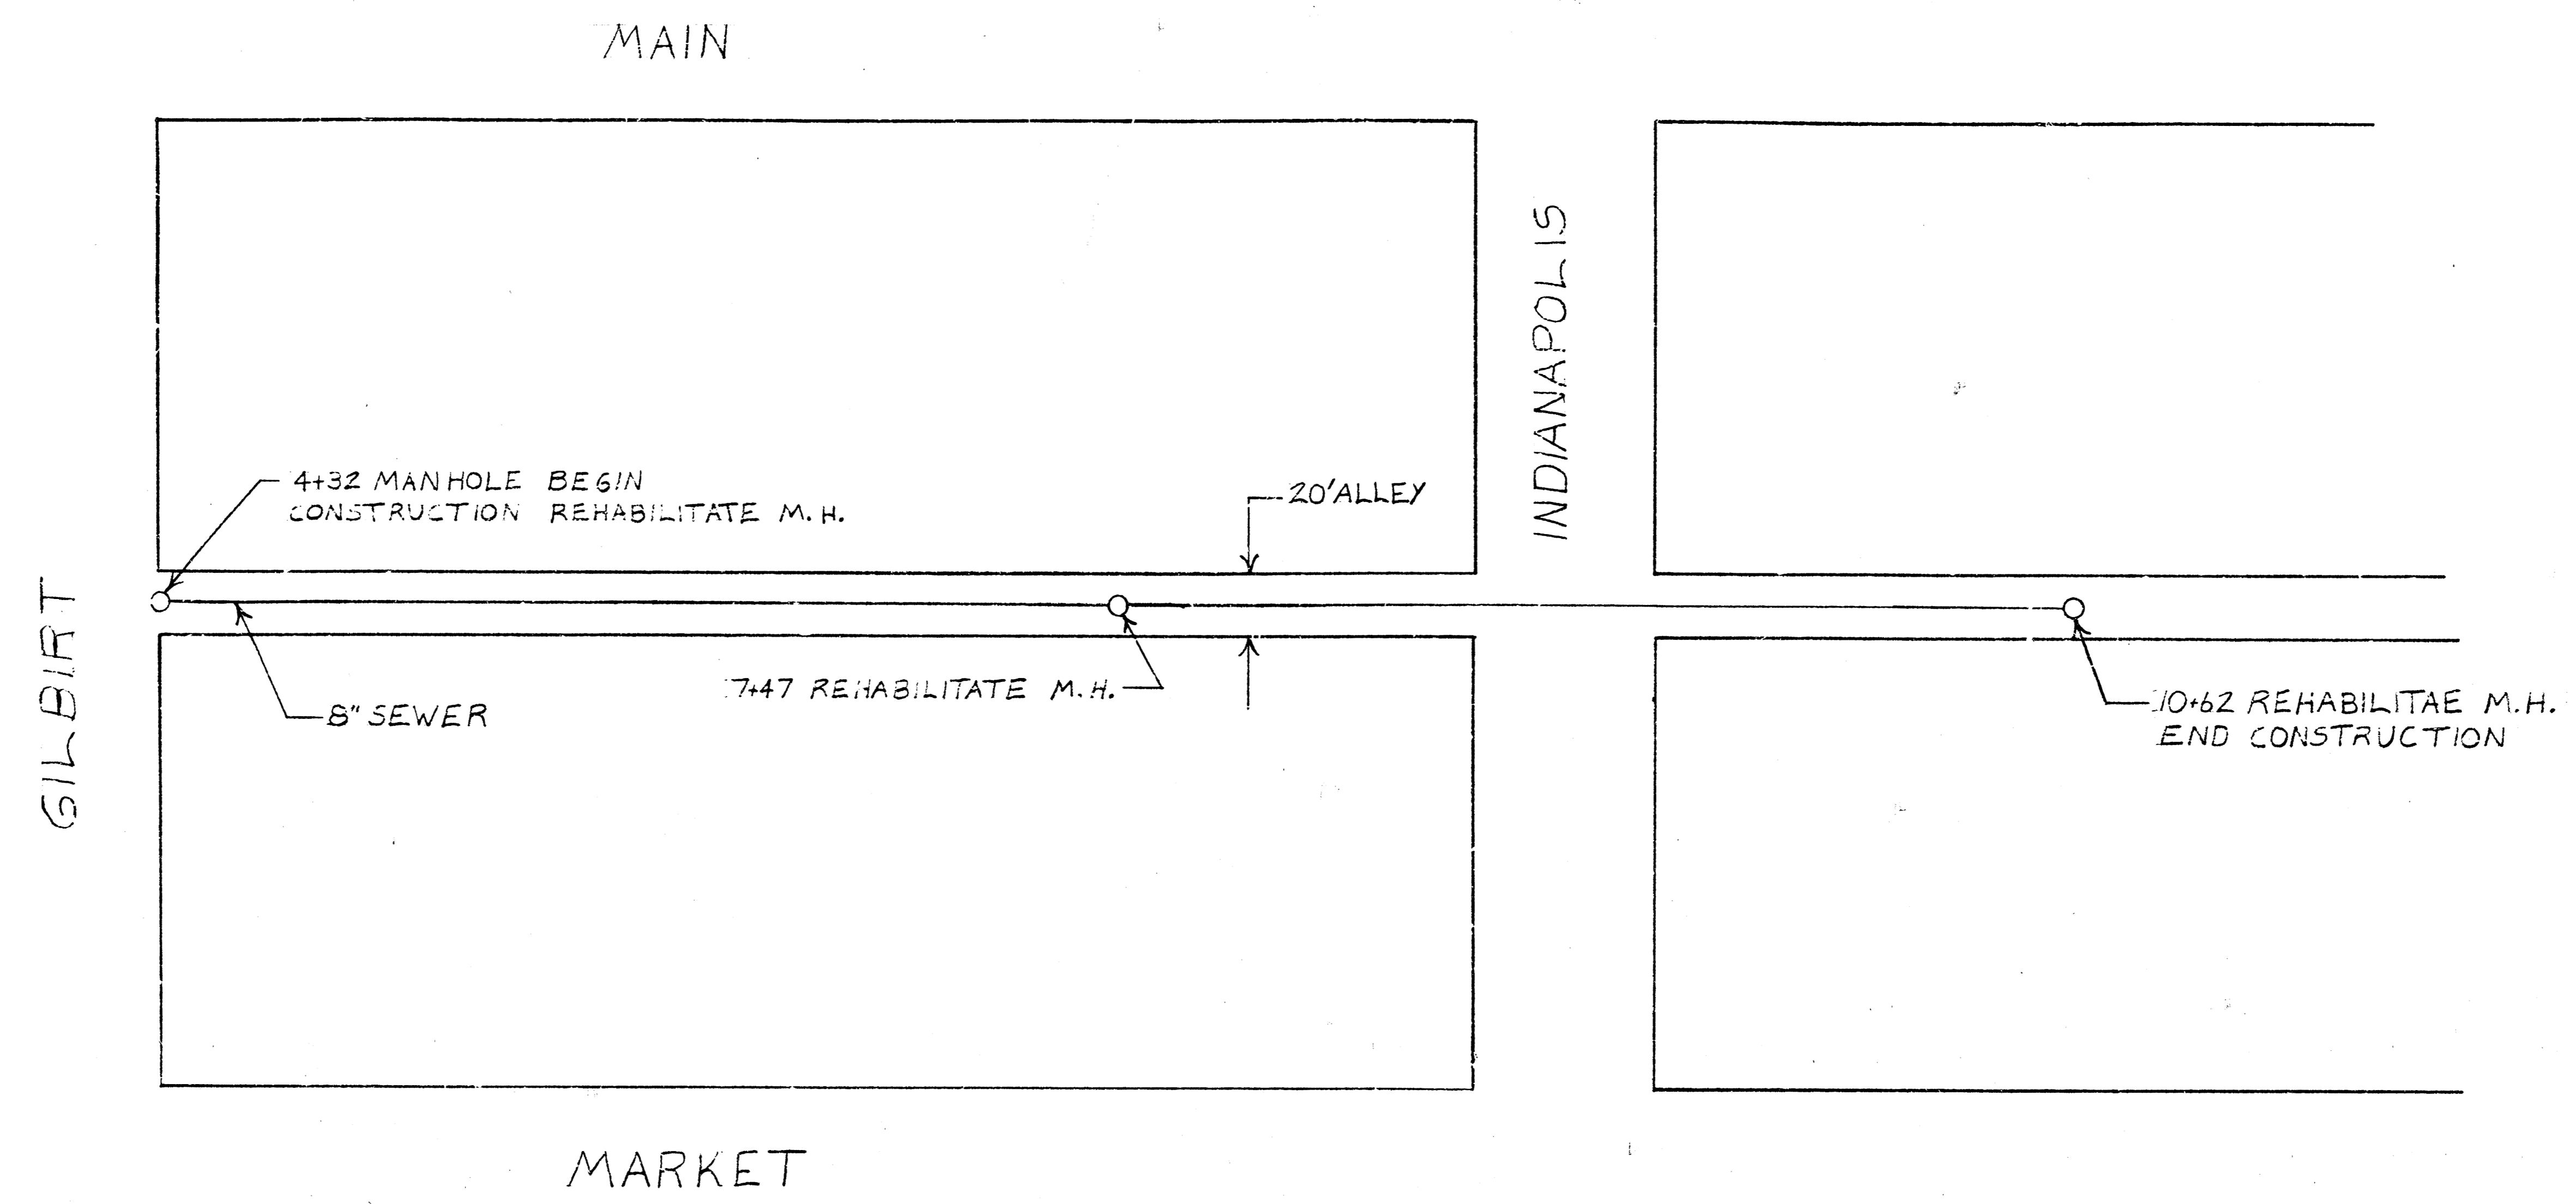

TAP+Y	LOCATIONS
STATION	DIRECTION
10+23.5	WEST
10+21.5	EAST
10+18	WEST
10+11	WEST
9+67	EAST
8+26	EAST
8+02.6	EAST
7+78.5	EAST
7+76.8	WEST
7+50	WEST
6+96.2	WEST
6+24.5	WEST
6+01	WEST
5+54.6	WEST
5+05	WEST
4+82	WEST
4+37	WEST
3+39	EAST


SITE 2

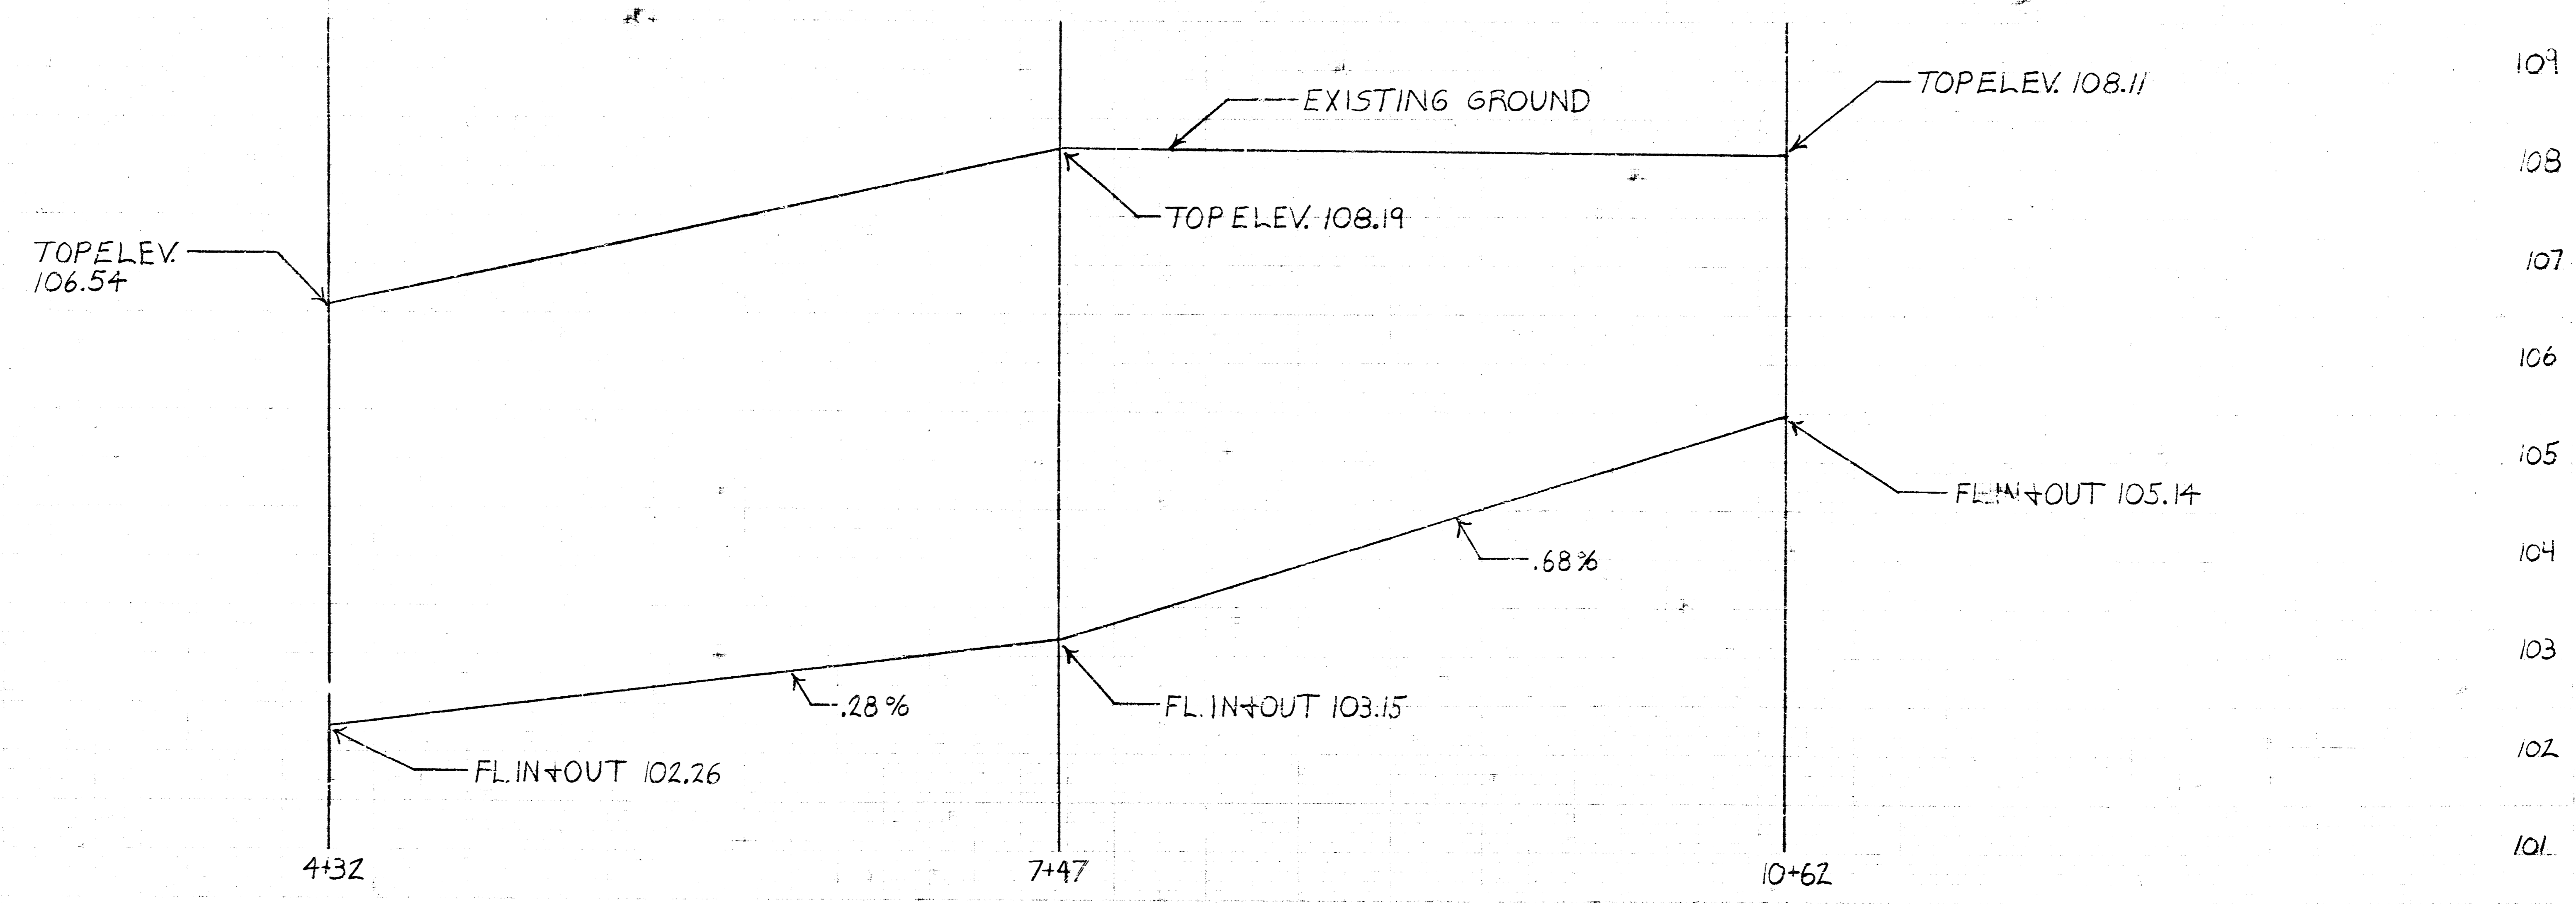


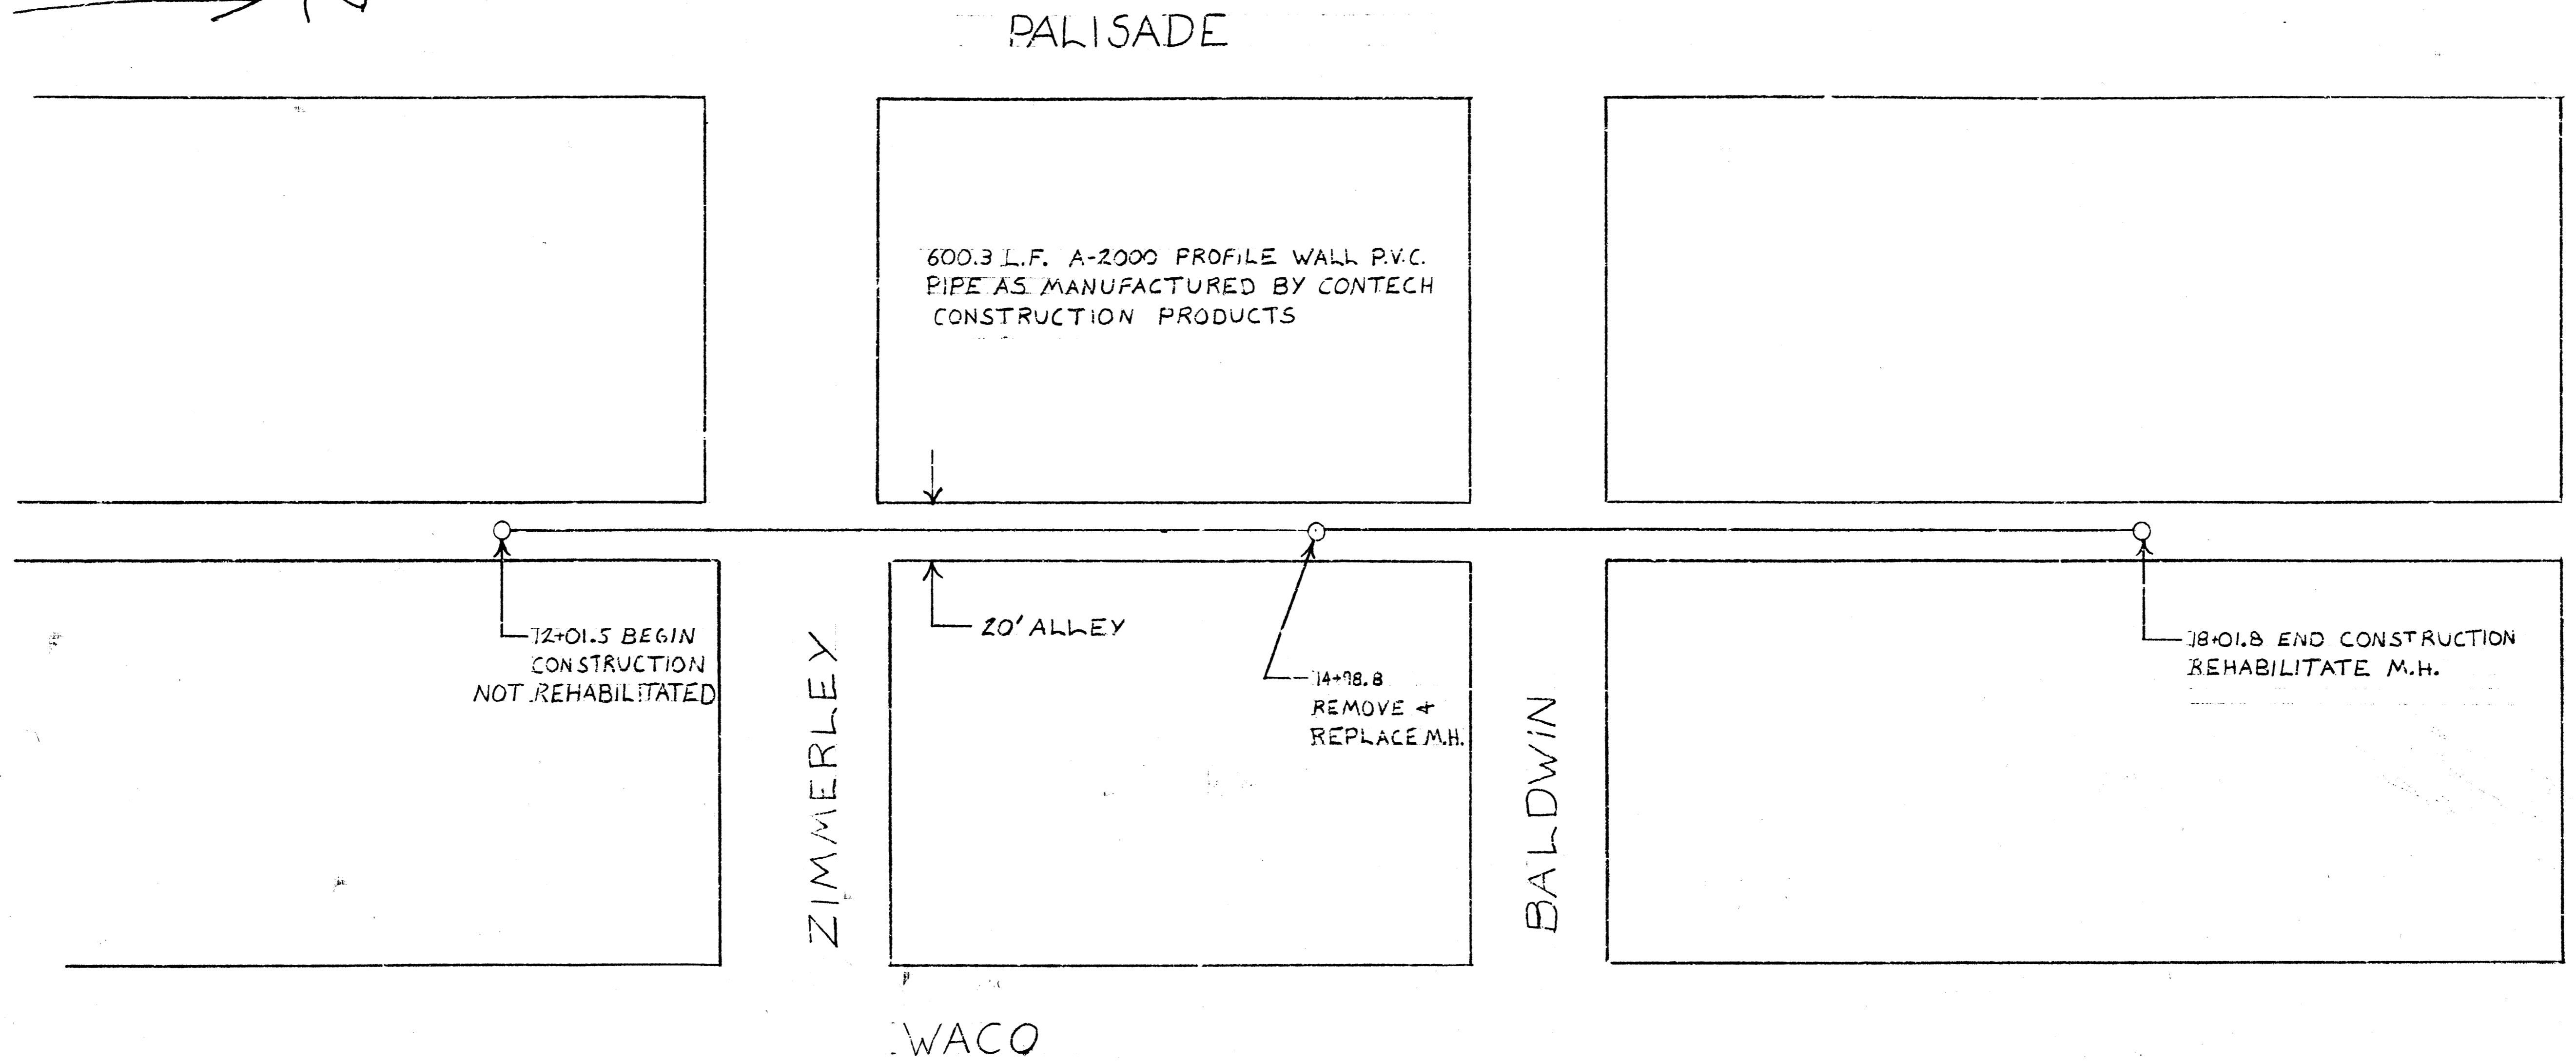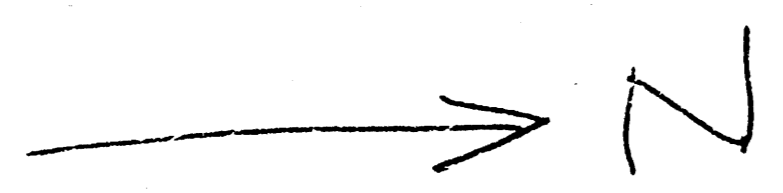


TAP+Y LOCATIONS	
STATION	DIRECTION
12+17	EAST
12+20	WEST
12+32.5	WEST
12+34	WEST
12+35.5	EAST
13+87	EAST
14+33	WEST
14+55	EAST
15+06	EAST
15+16	WEST
15+37	EAST
16+50	EAST
16+52	WEST
17+04	EAST
17+02	WEST
17+47	EAST
17+50	WEST
18+02	EAST
17+97	WEST

SITE 3

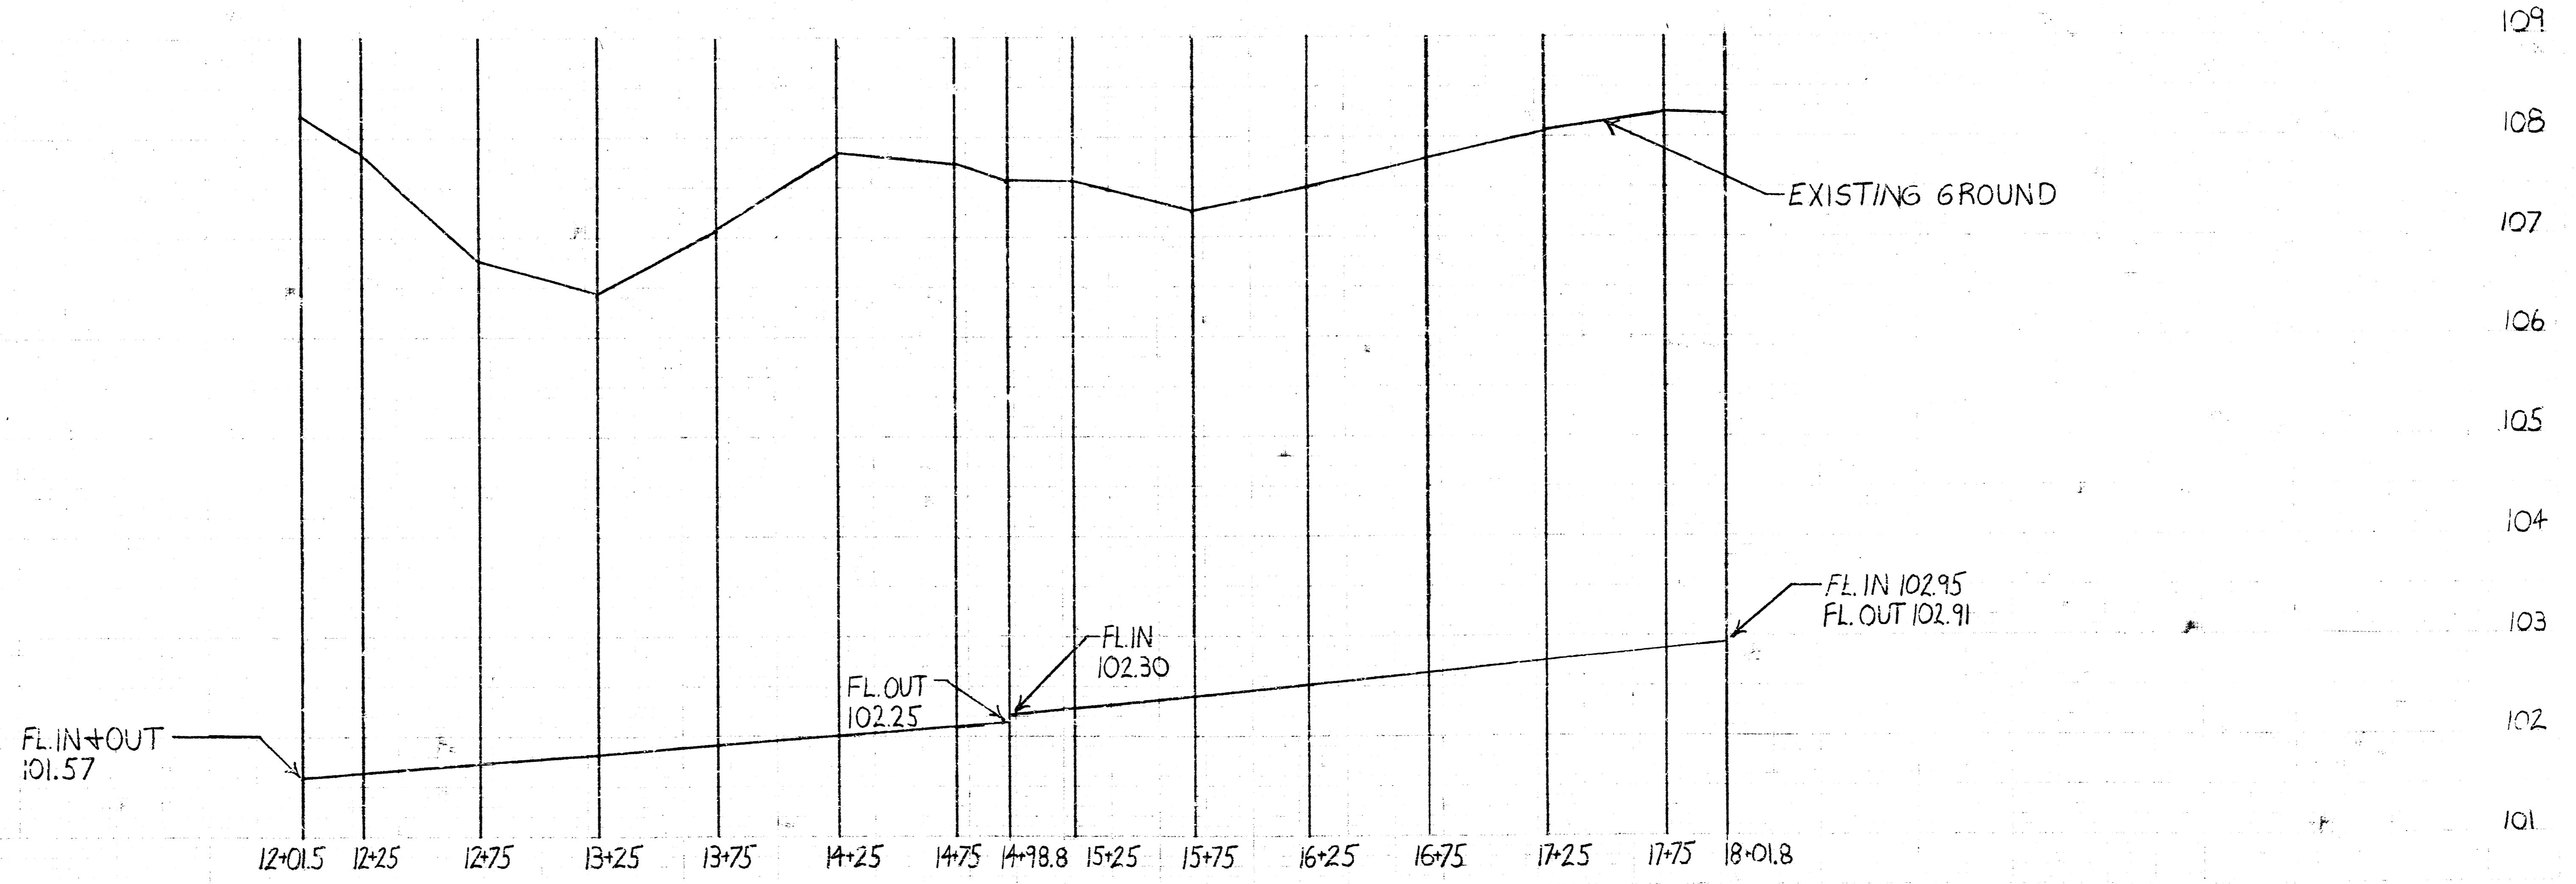

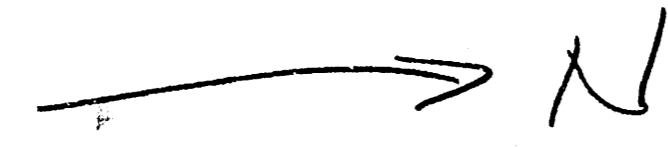


TOPEKA

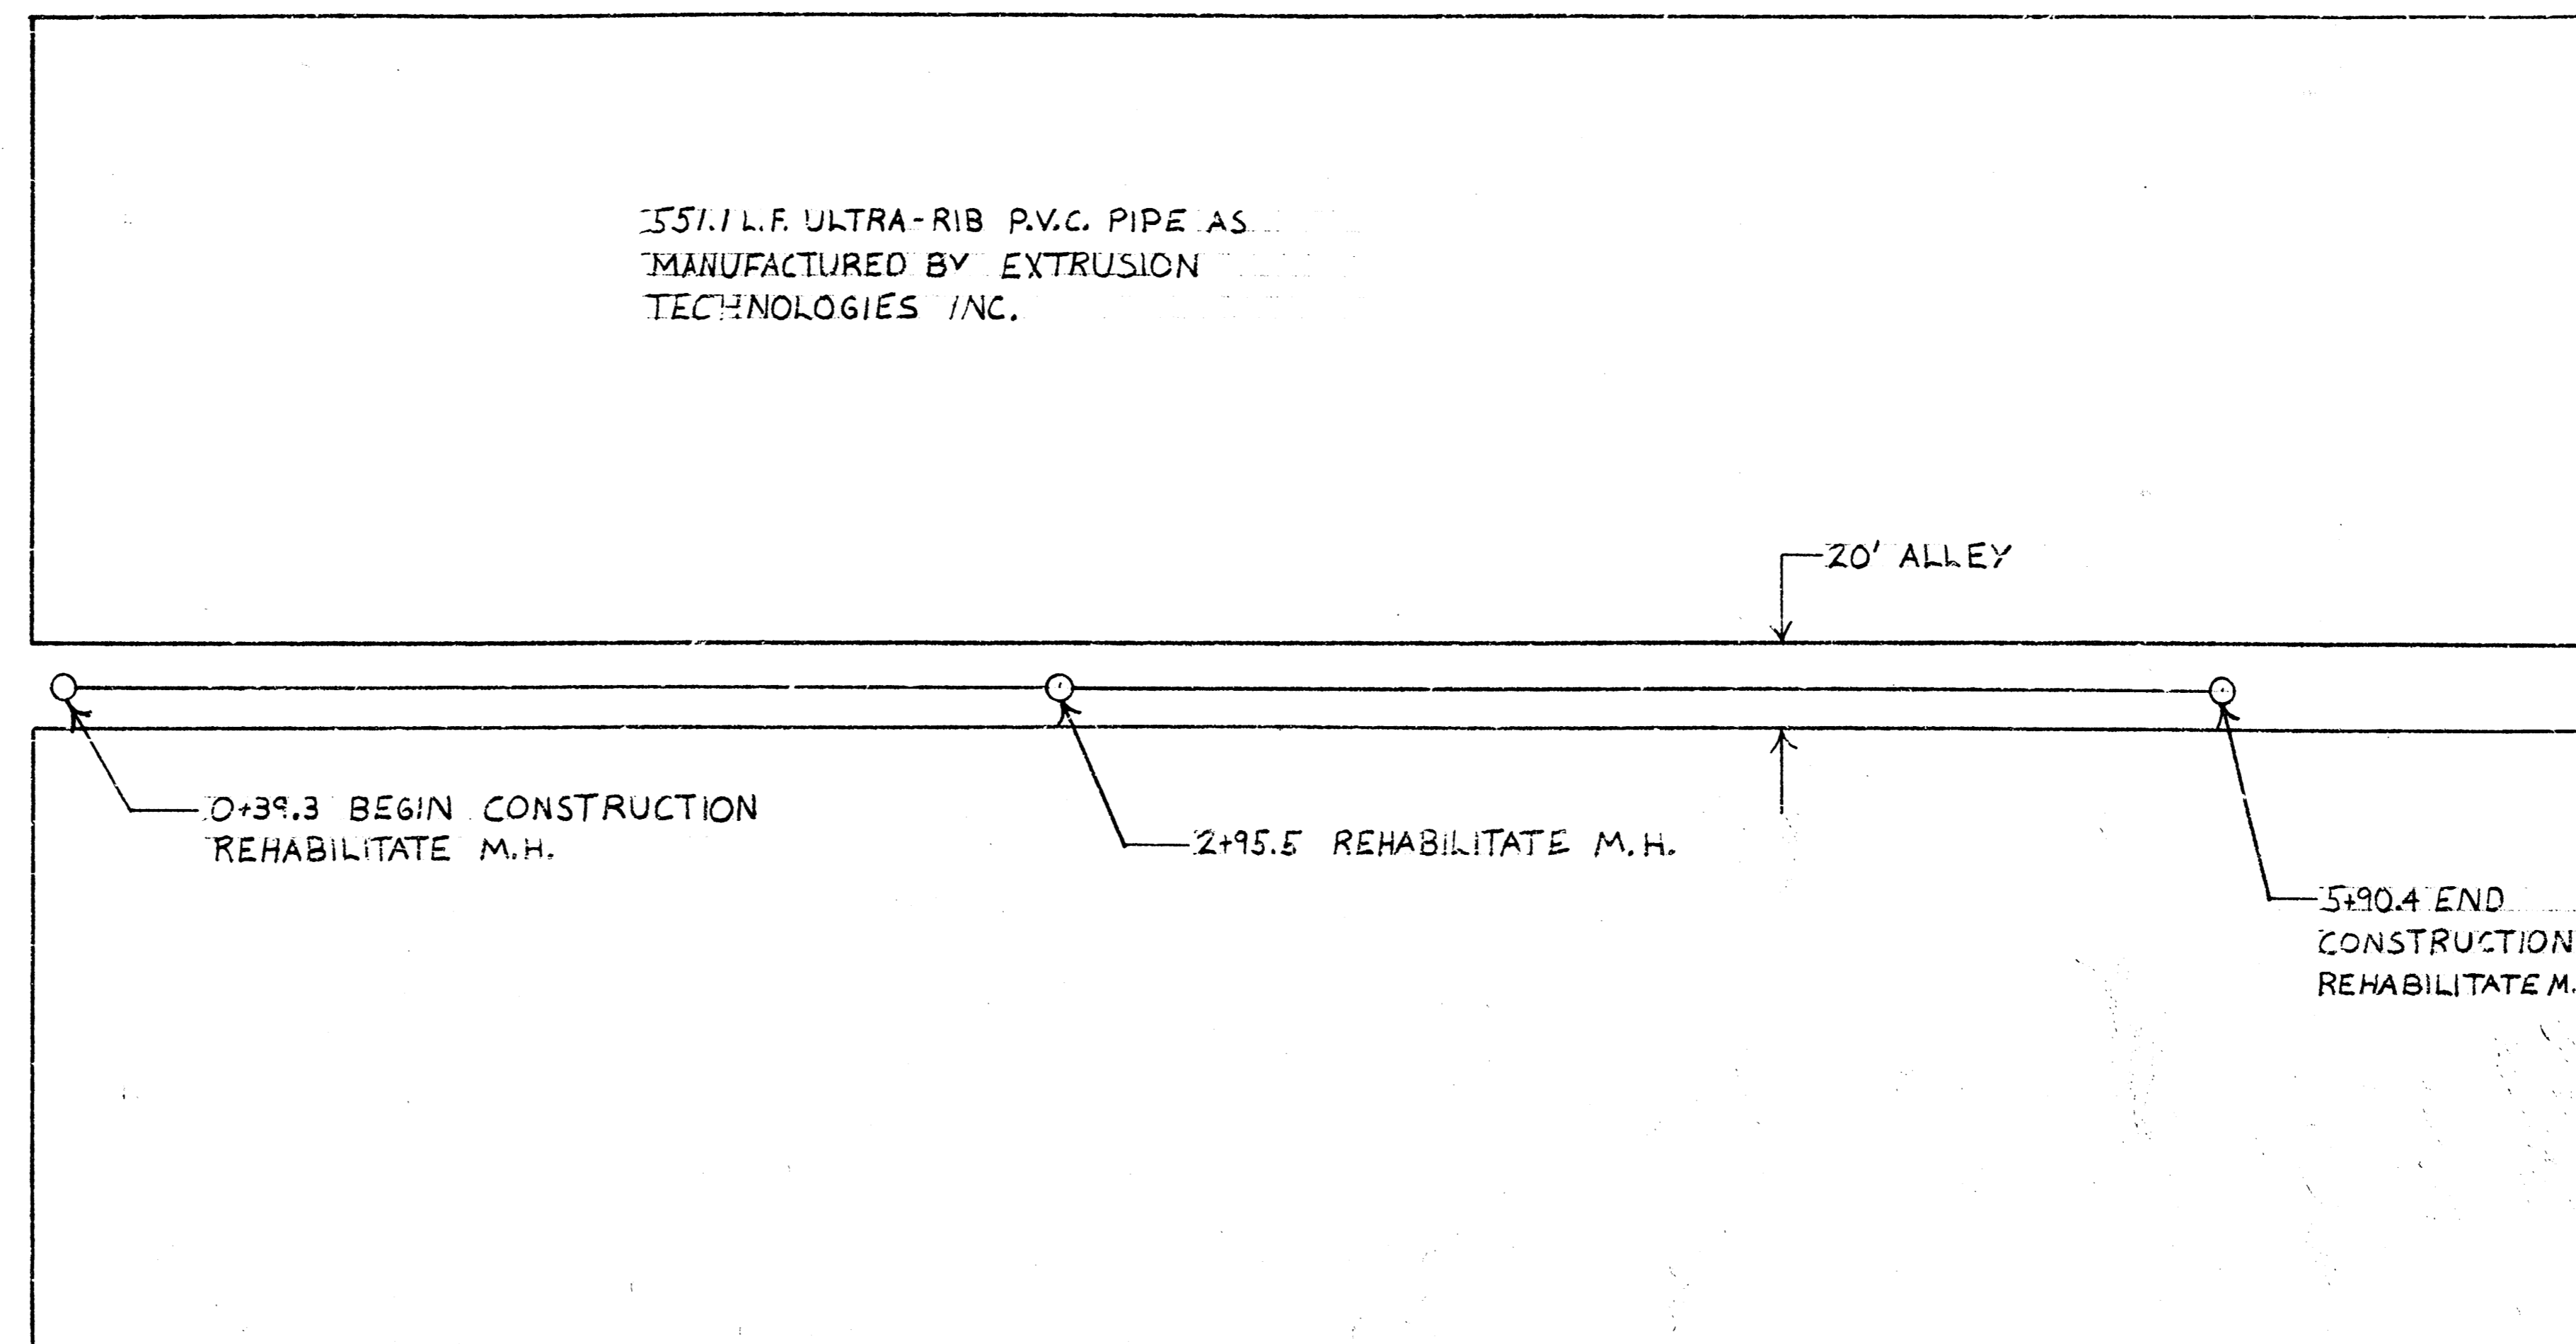



TAP+Y LOCATIONS	
STATION	DIRECTION
0+49	EAST
0+73	WEST
1+50	EAST
1+77	EAST
2+02	WEST
2+22	EAST
2+34	WEST
2+75	WEST
3+02	EAST
3+22	EAST
3+25	WEST
3+55	EAST
3+76	WEST
4+06	EAST
4+21	EAST
4+47	WEST
4+74	EAST
4+76	WEST
4+98	EAST
5+27	WEST
5+48	EAST
5+74	EAST
5+76	WEST


SITE 5

EMPORIA

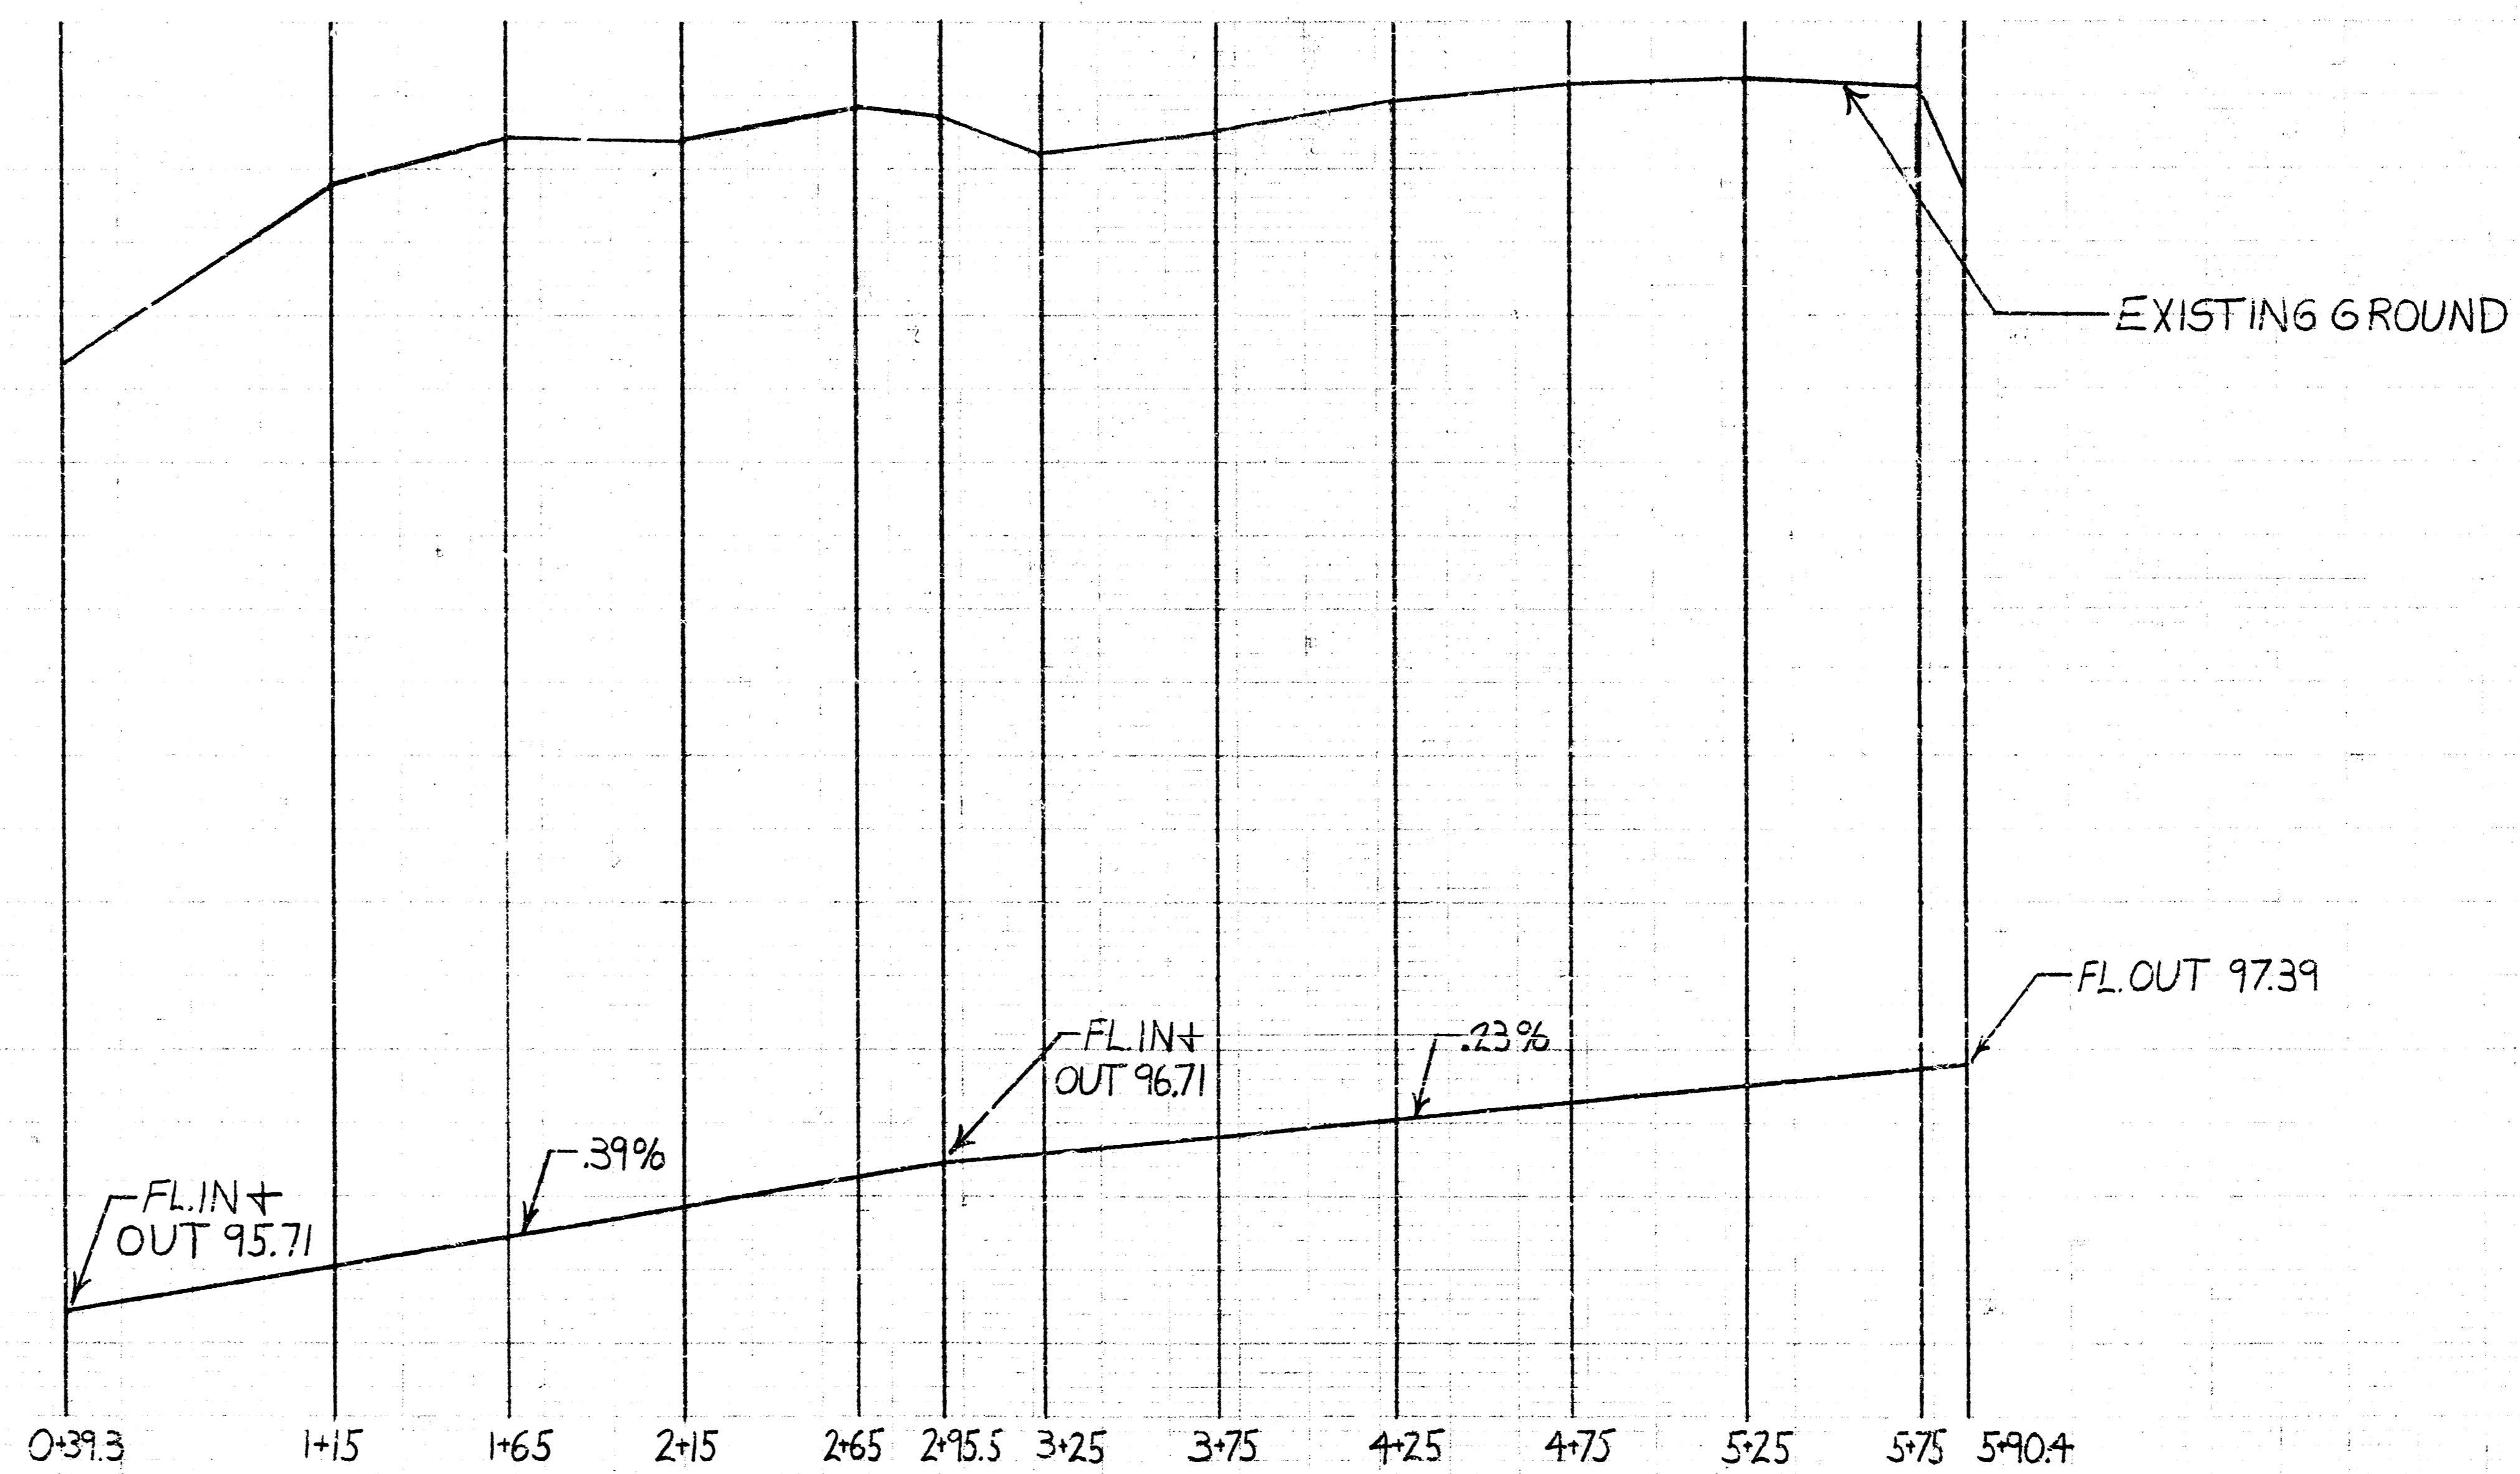


104
103
102
101
100
99
98
97
96
95

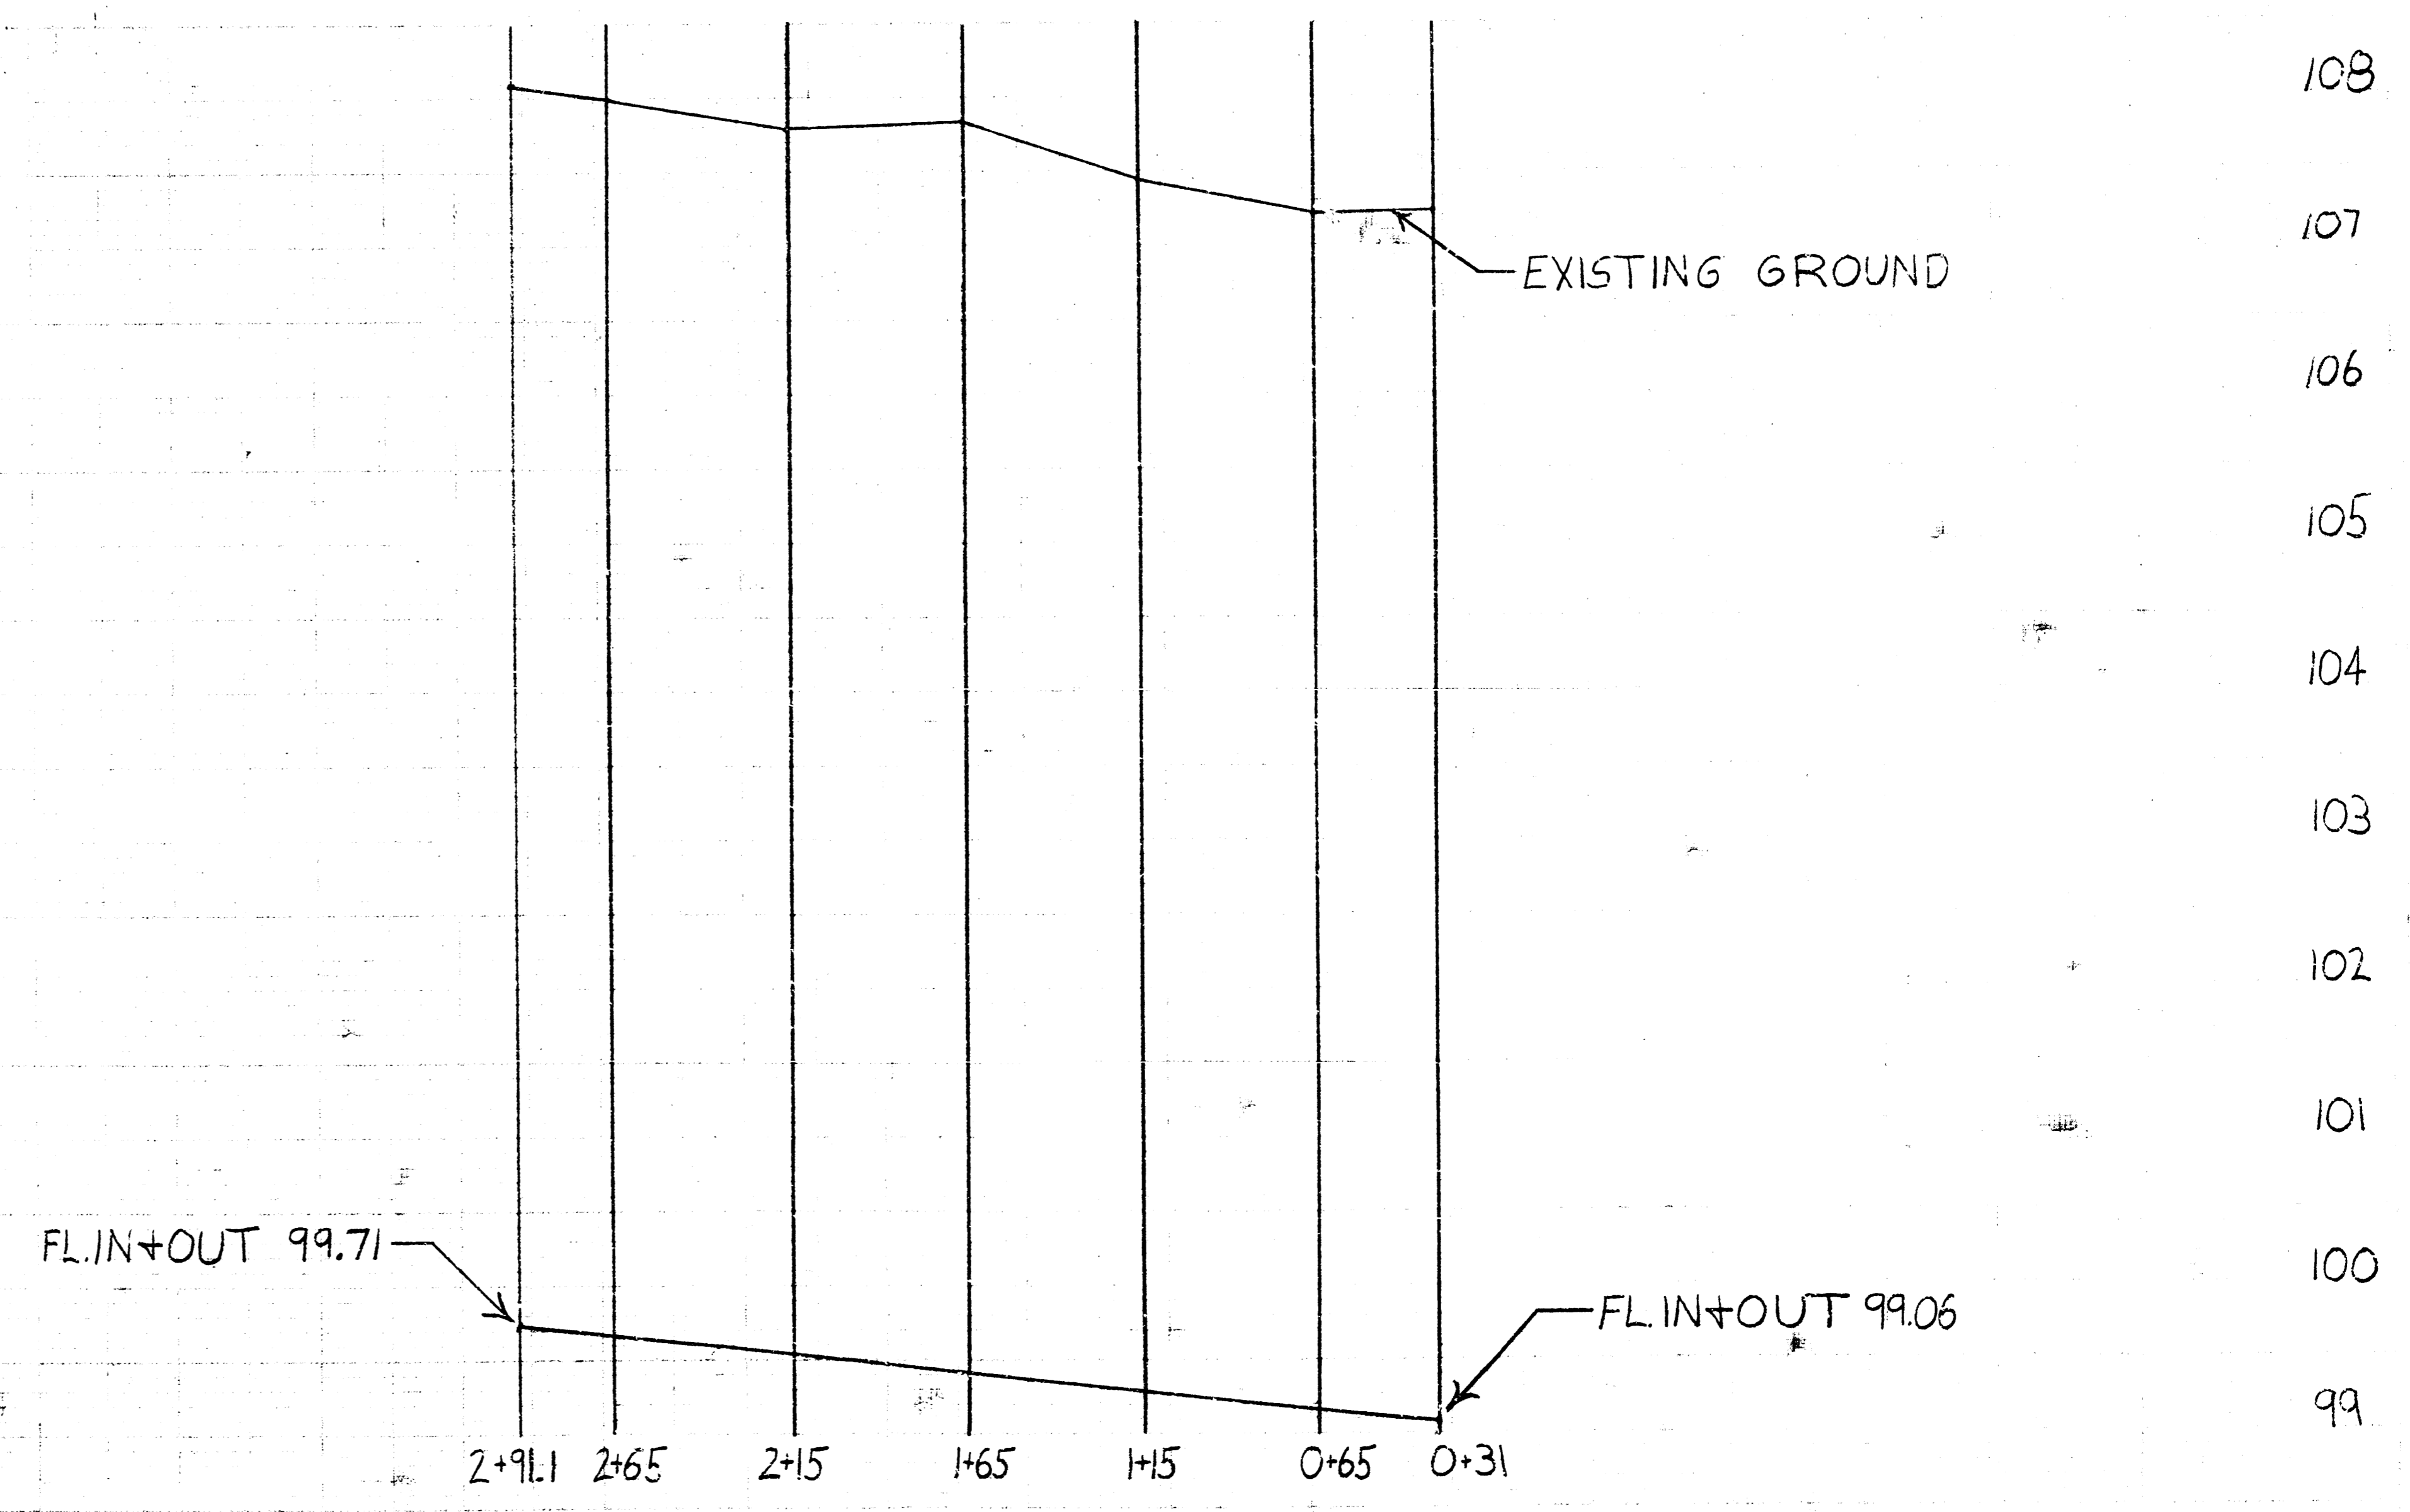
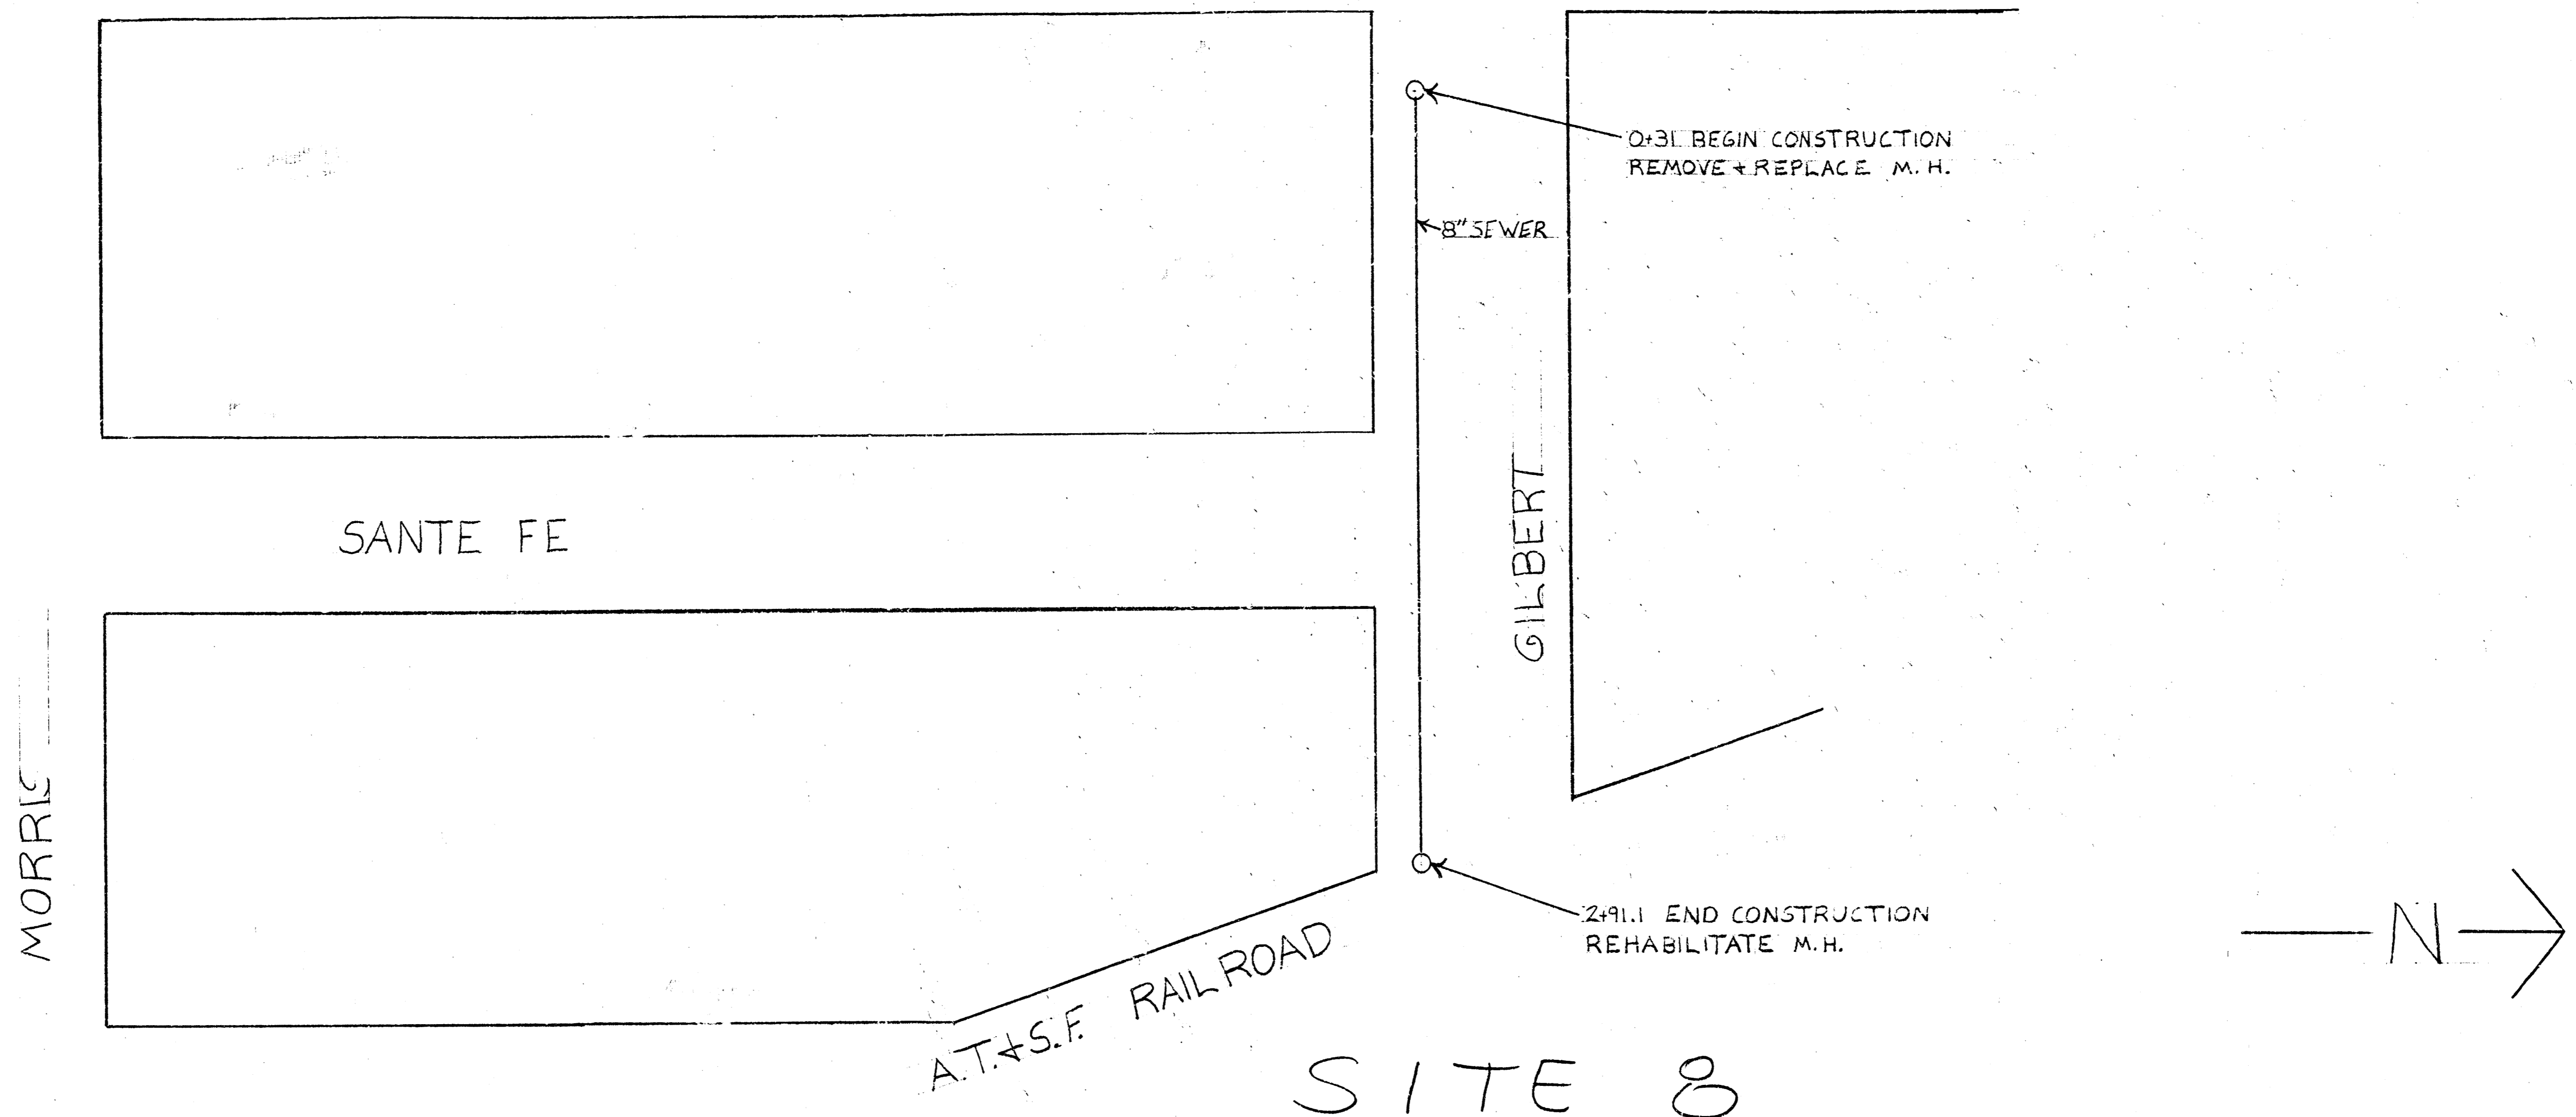


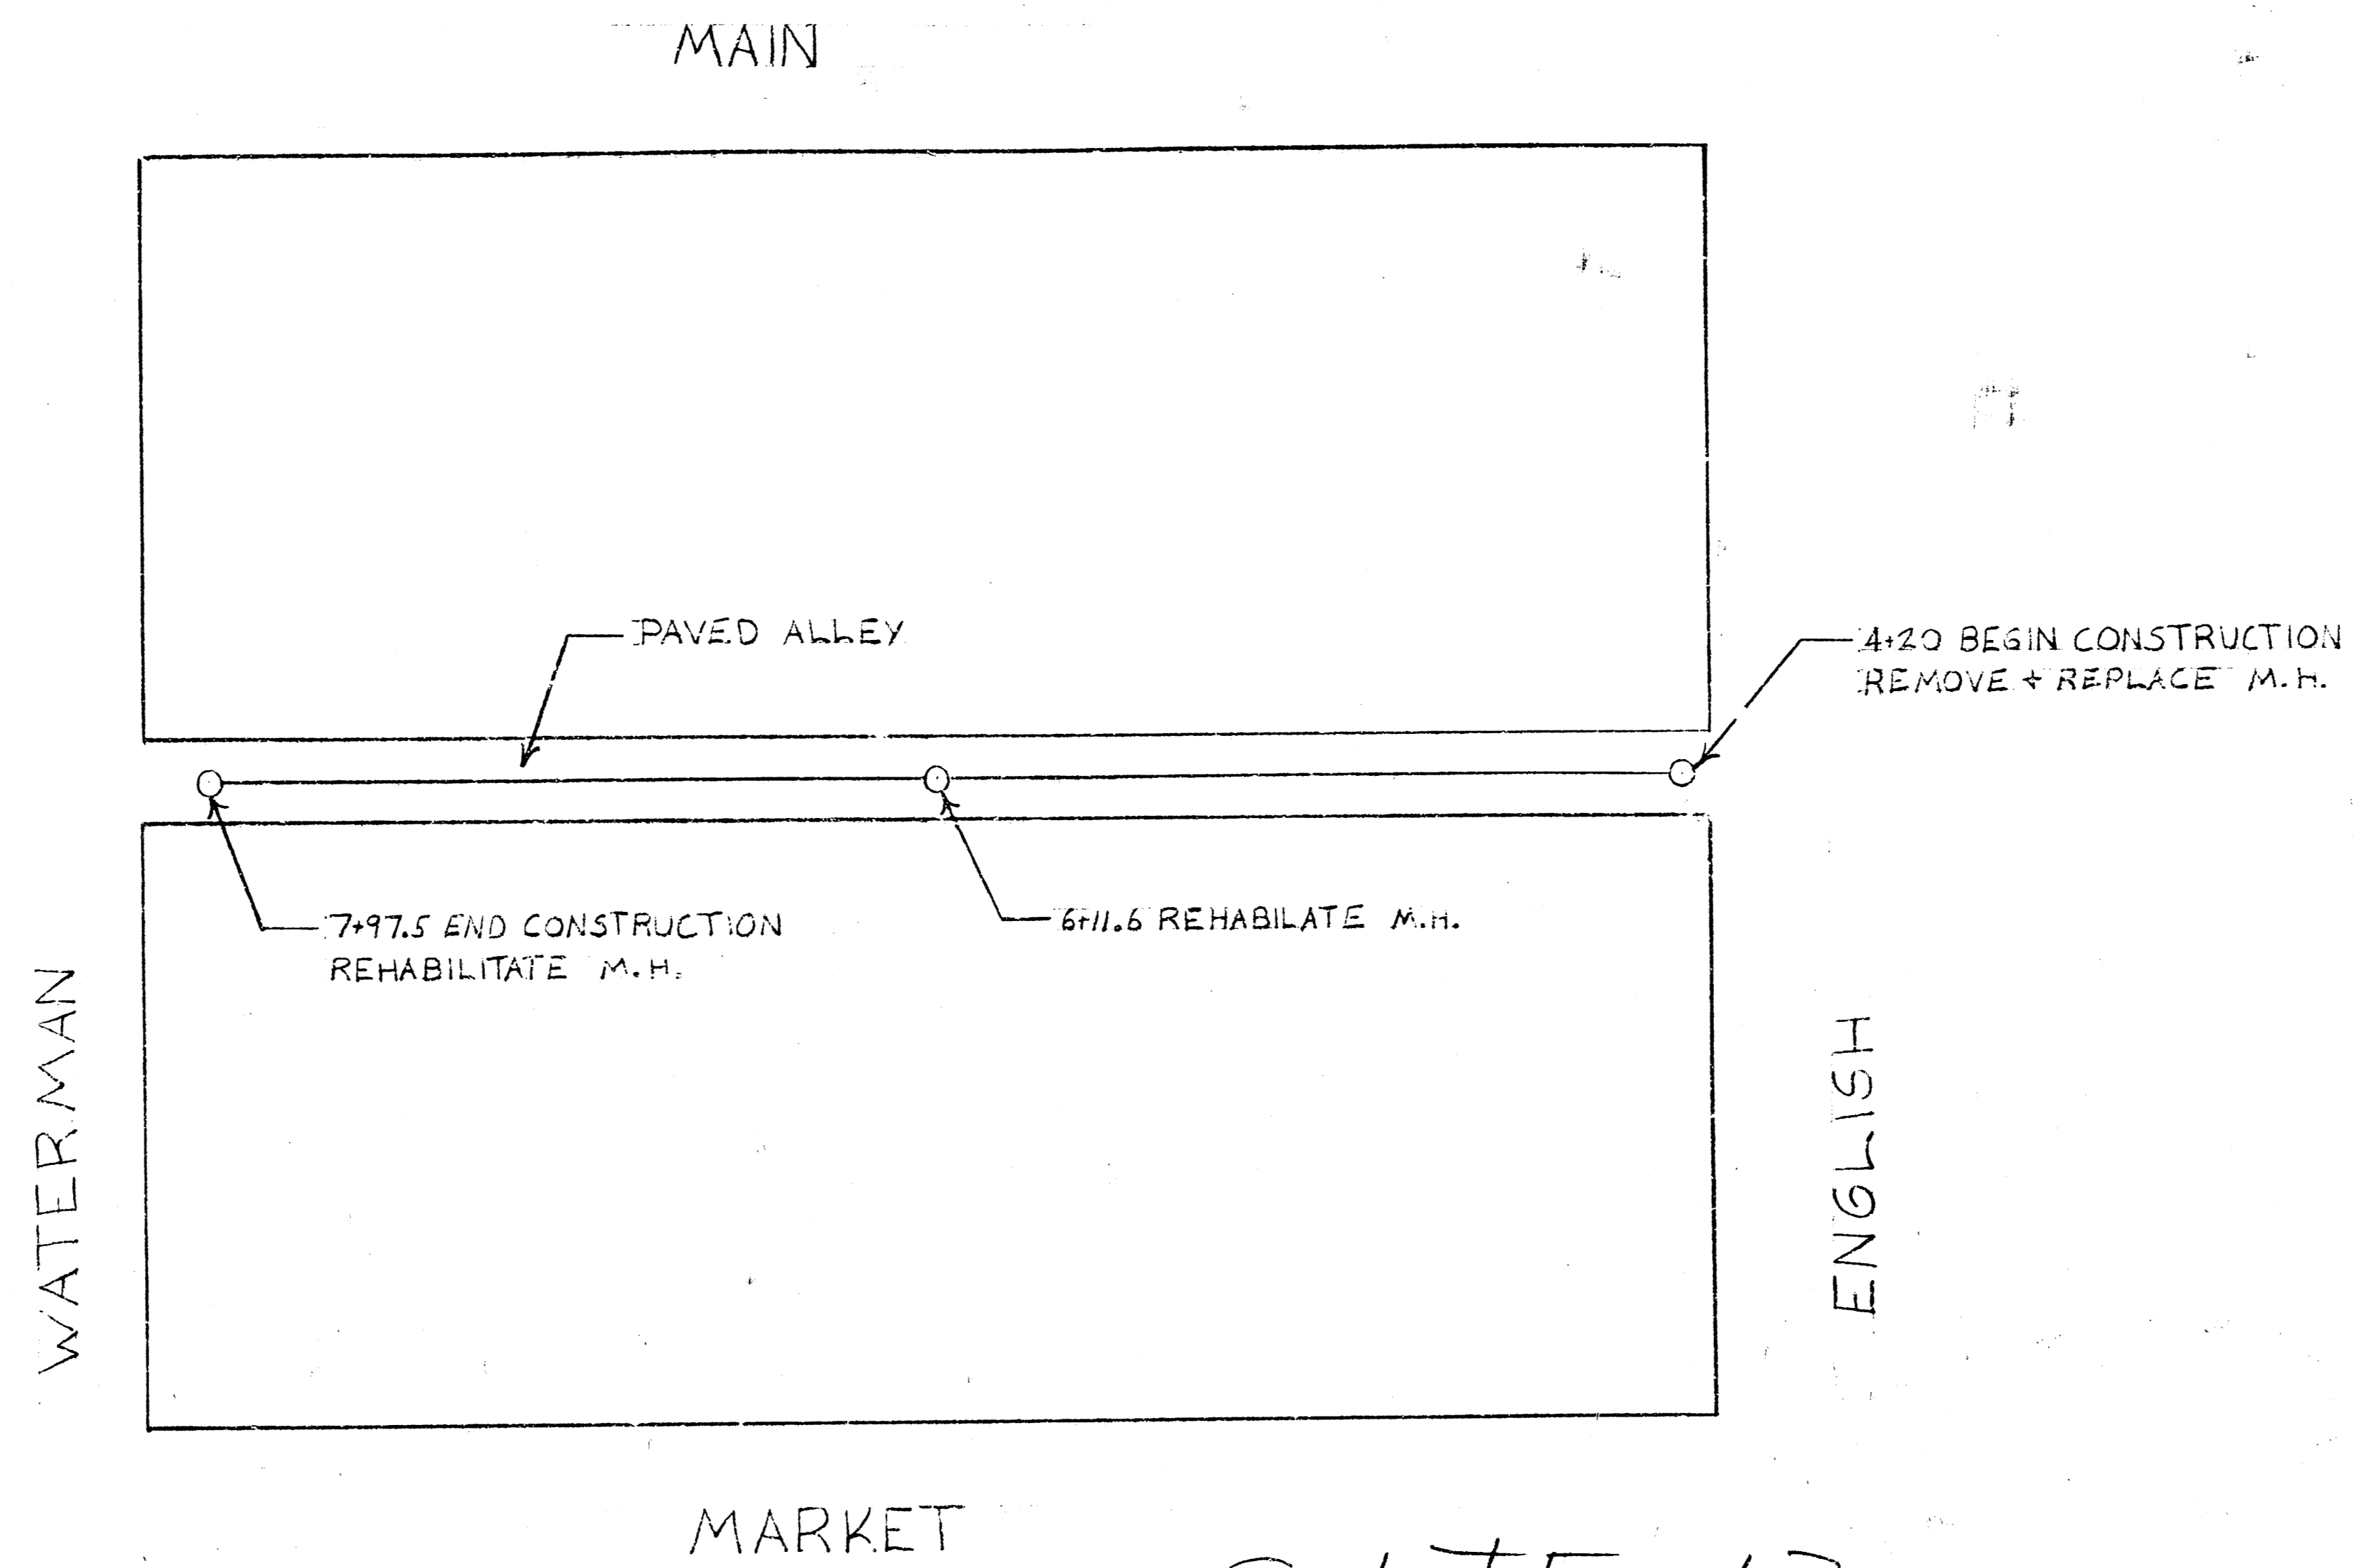


TAP + Y LOCATIONS	
STATION	DIRECTION
4+35	EAST
5+08	EAST
5+13	WEST
5+50	EAST
6+37	WEST
7+13	WEST
7+22	WEST

SITE 12

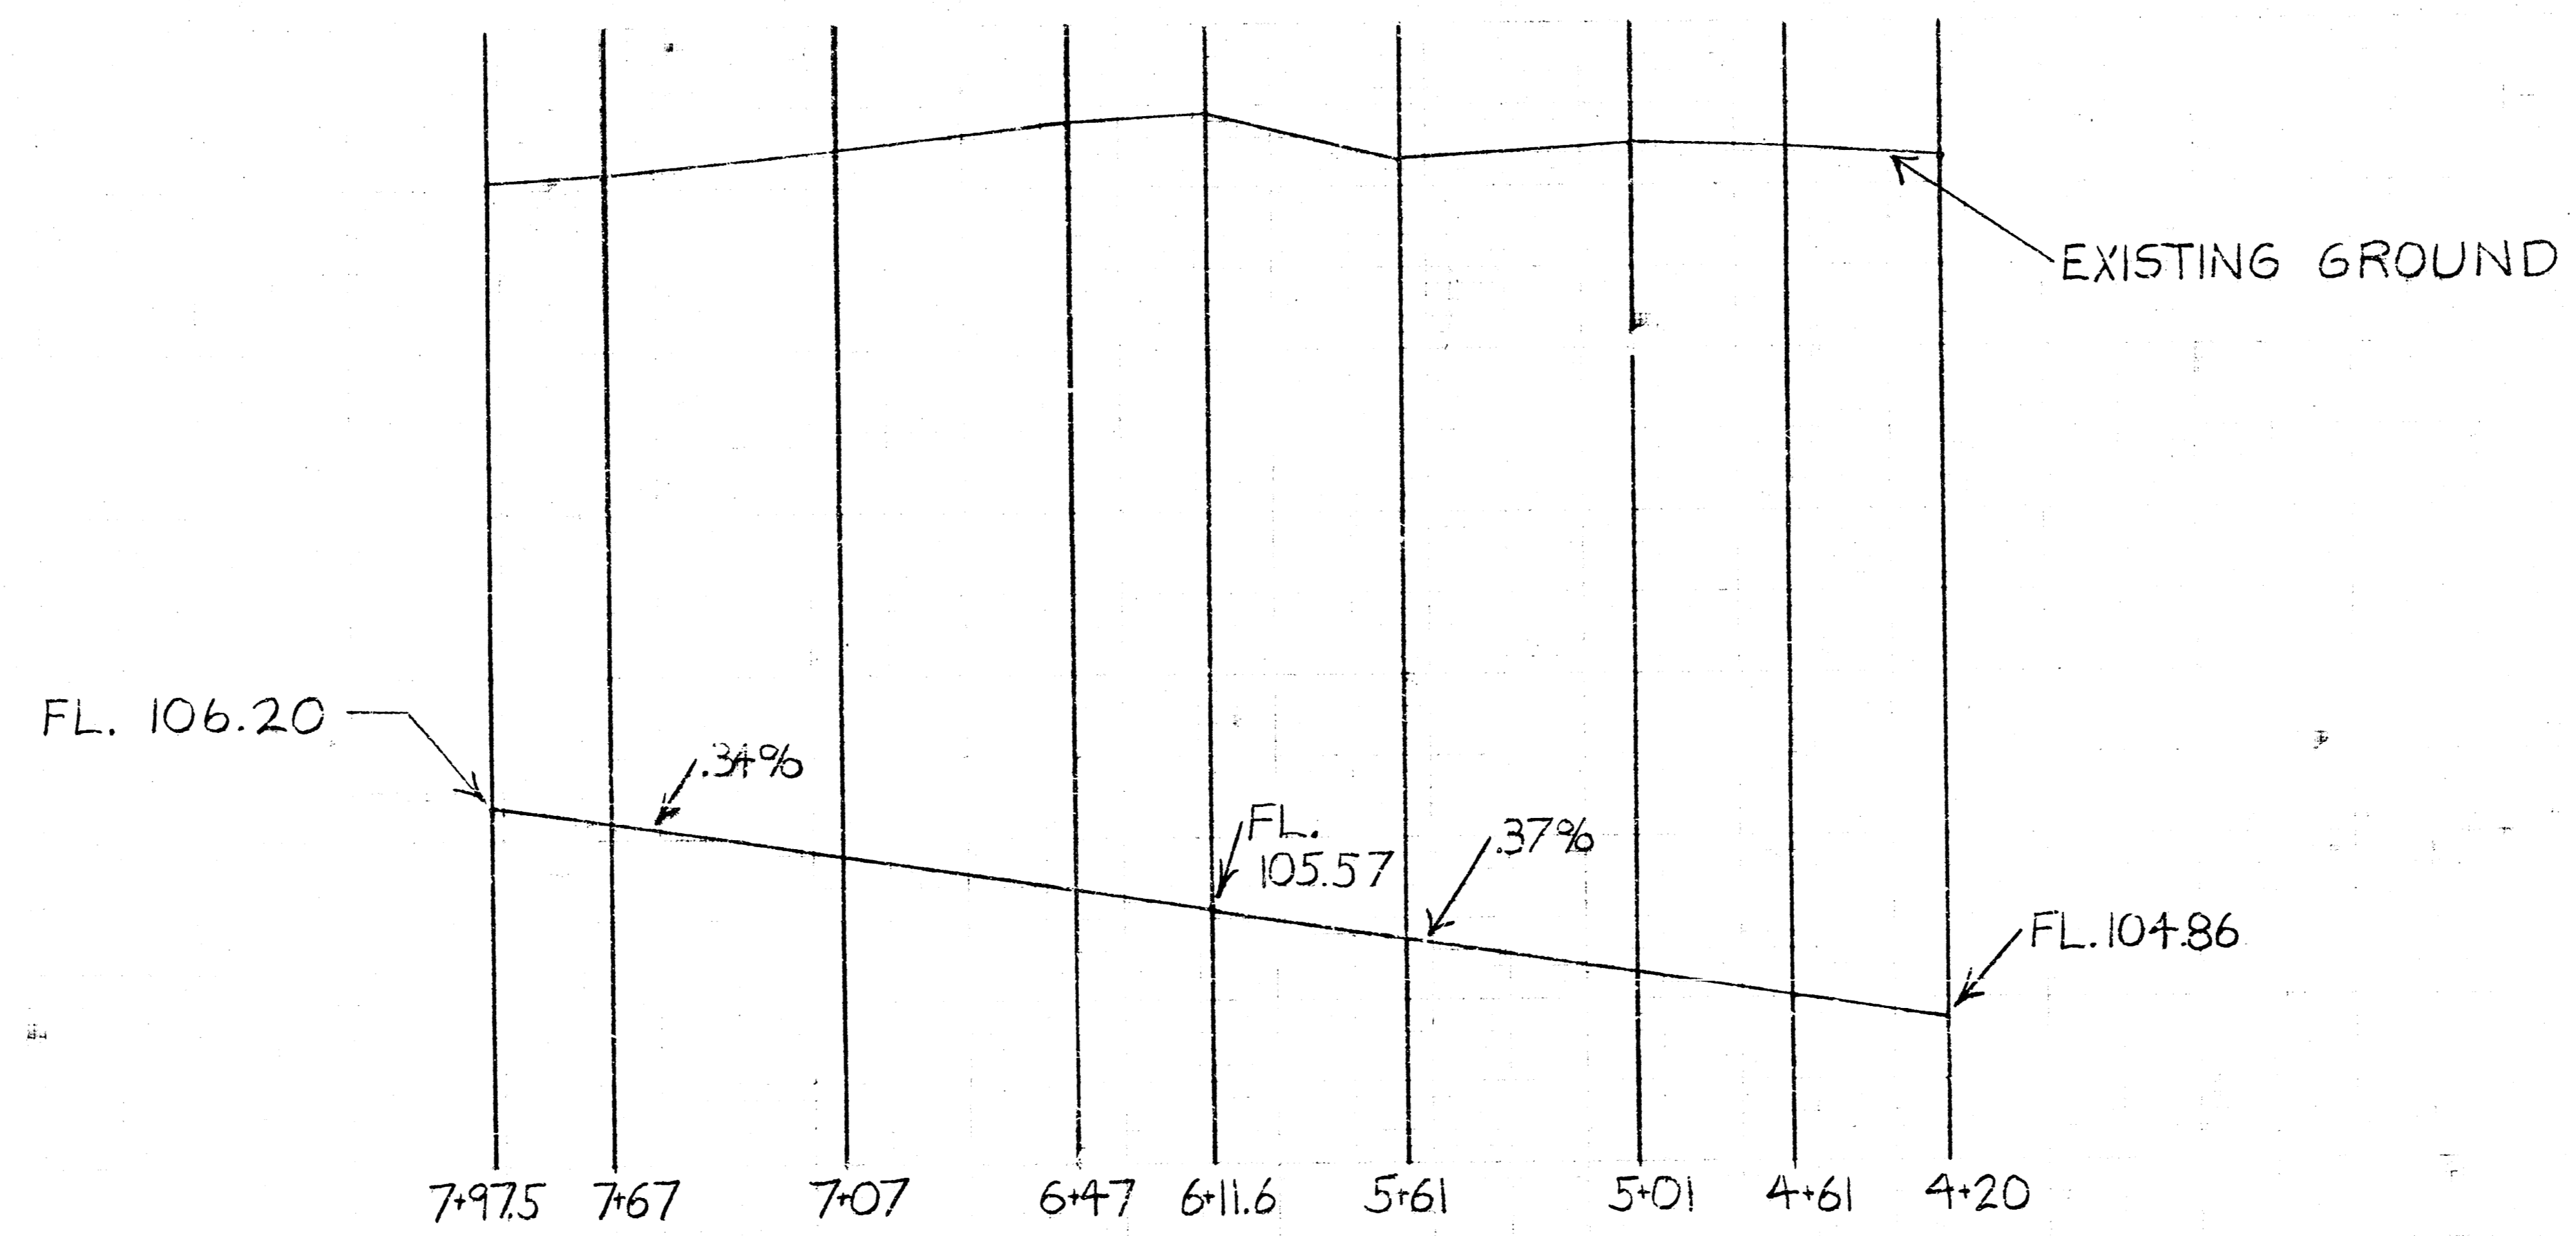

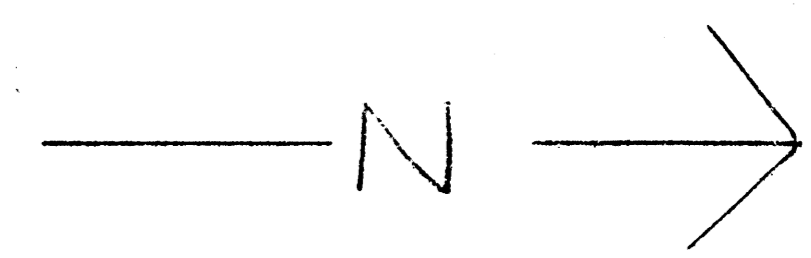
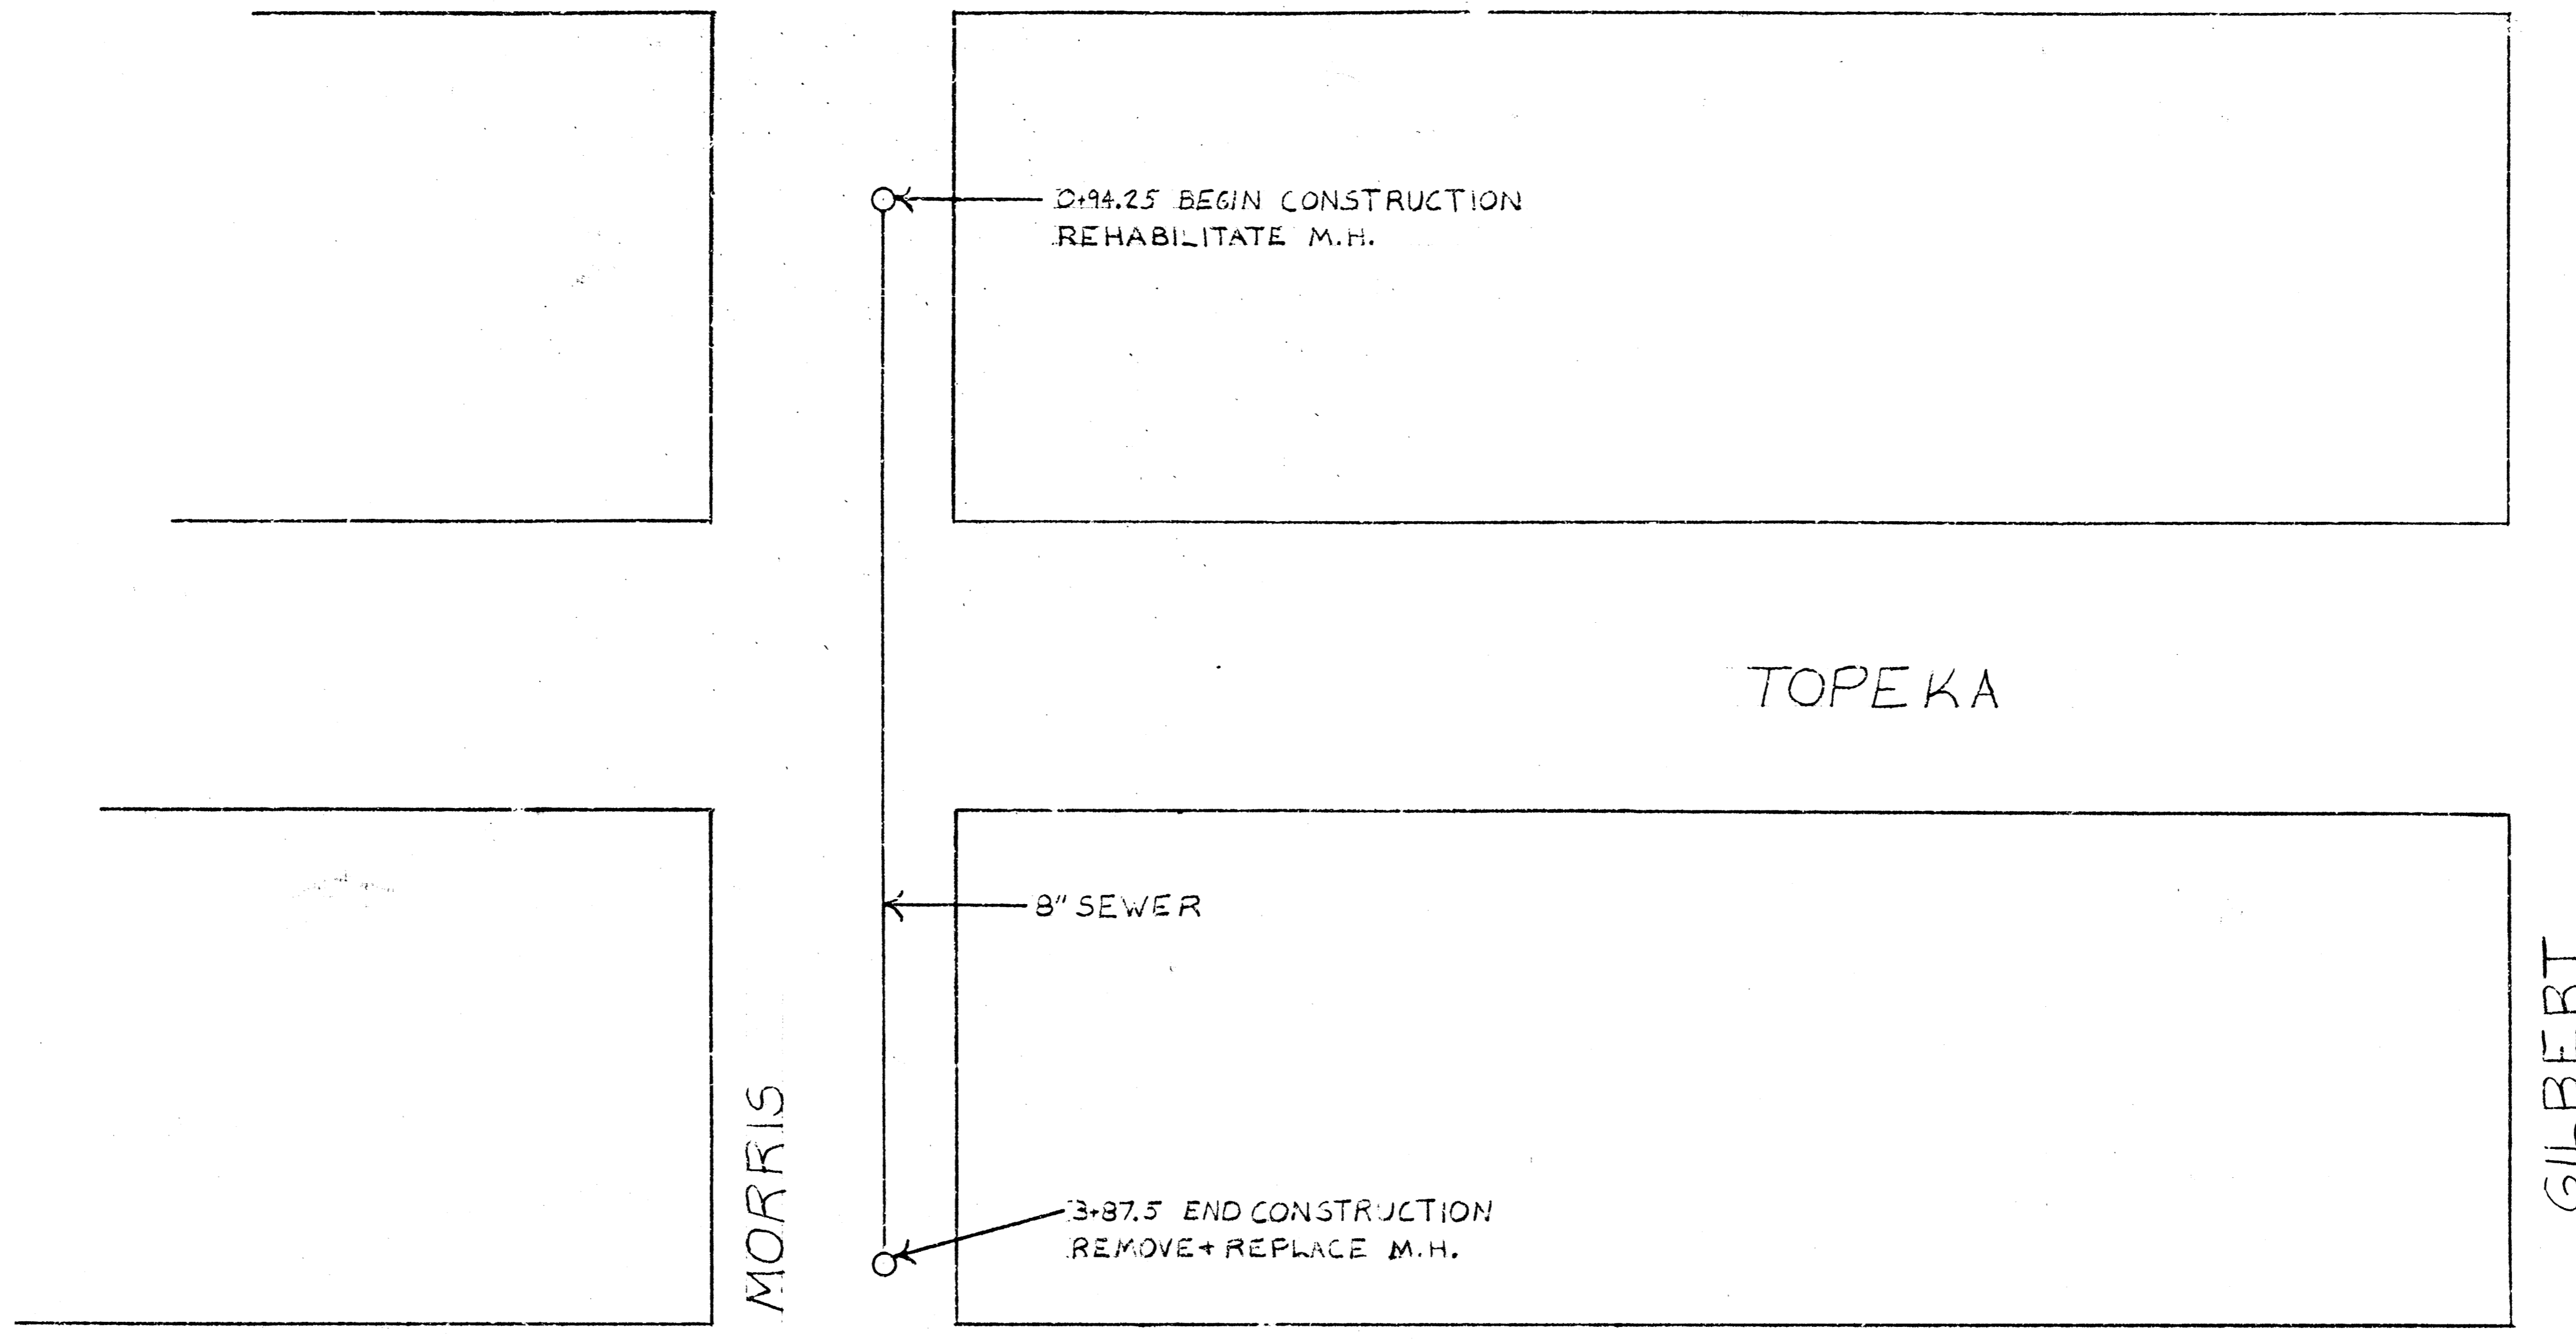


SITE 15

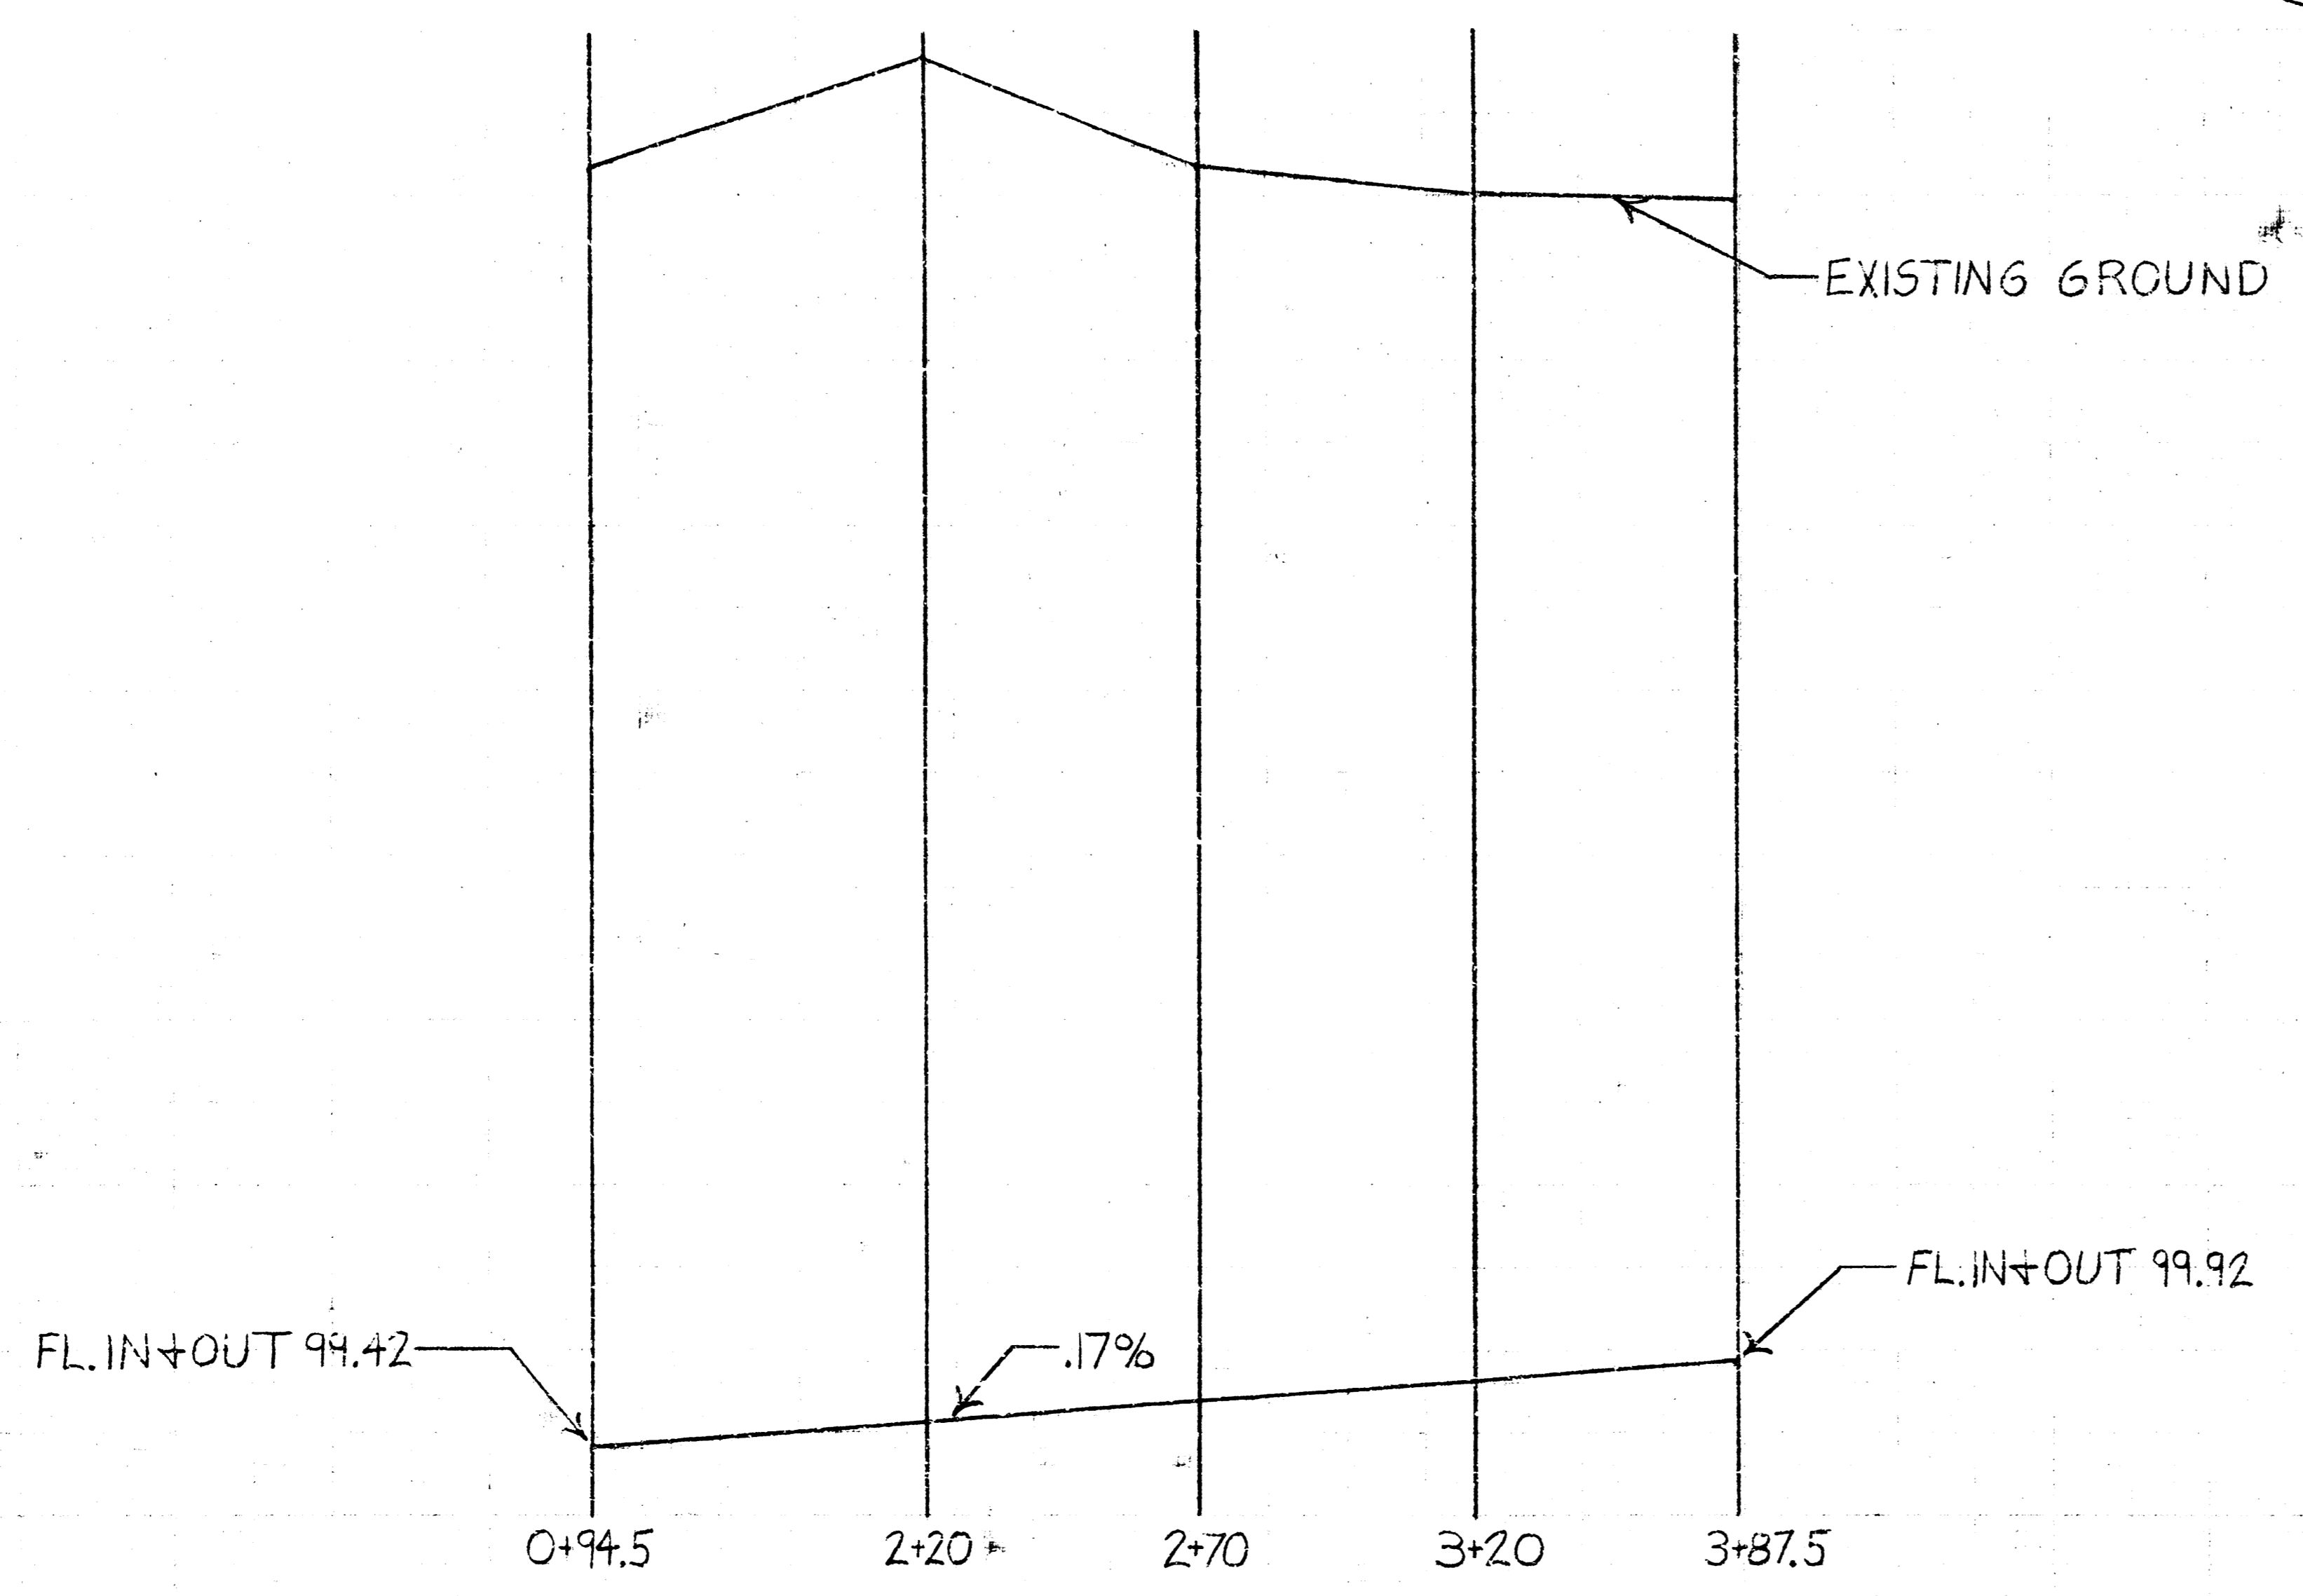


107
106
105
104
103
102
101
100
99


TAP+Y LOCATIONS	
STATION	DIRECTION
4+29	WEST
4+38	EAST
4+59	WEST
5+02	EAST
5+40	EAST
5+63	WEST
5+65	EAST
6+07	EAST
6+65	EAST
6+84	WEST
7+10	EAST
7+15	WEST
7+34	EAST
7+38	WEST
7+91	WEST
8+10	EAST
8+35	WEST
8+35	WEST
8+60	EAST

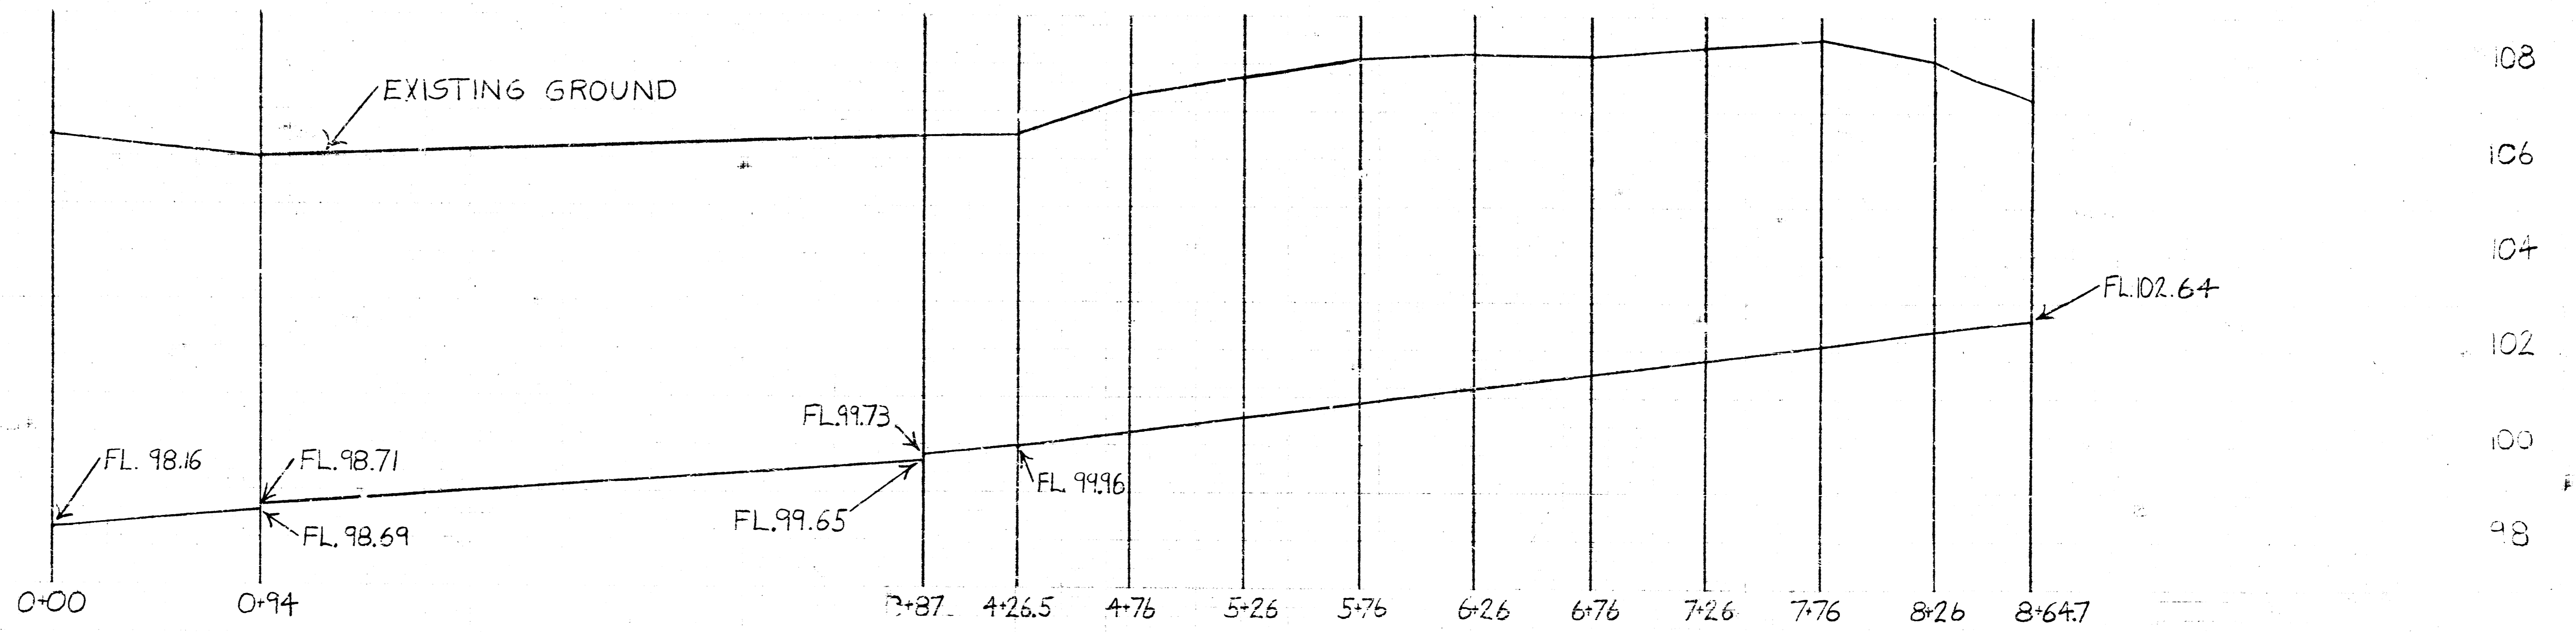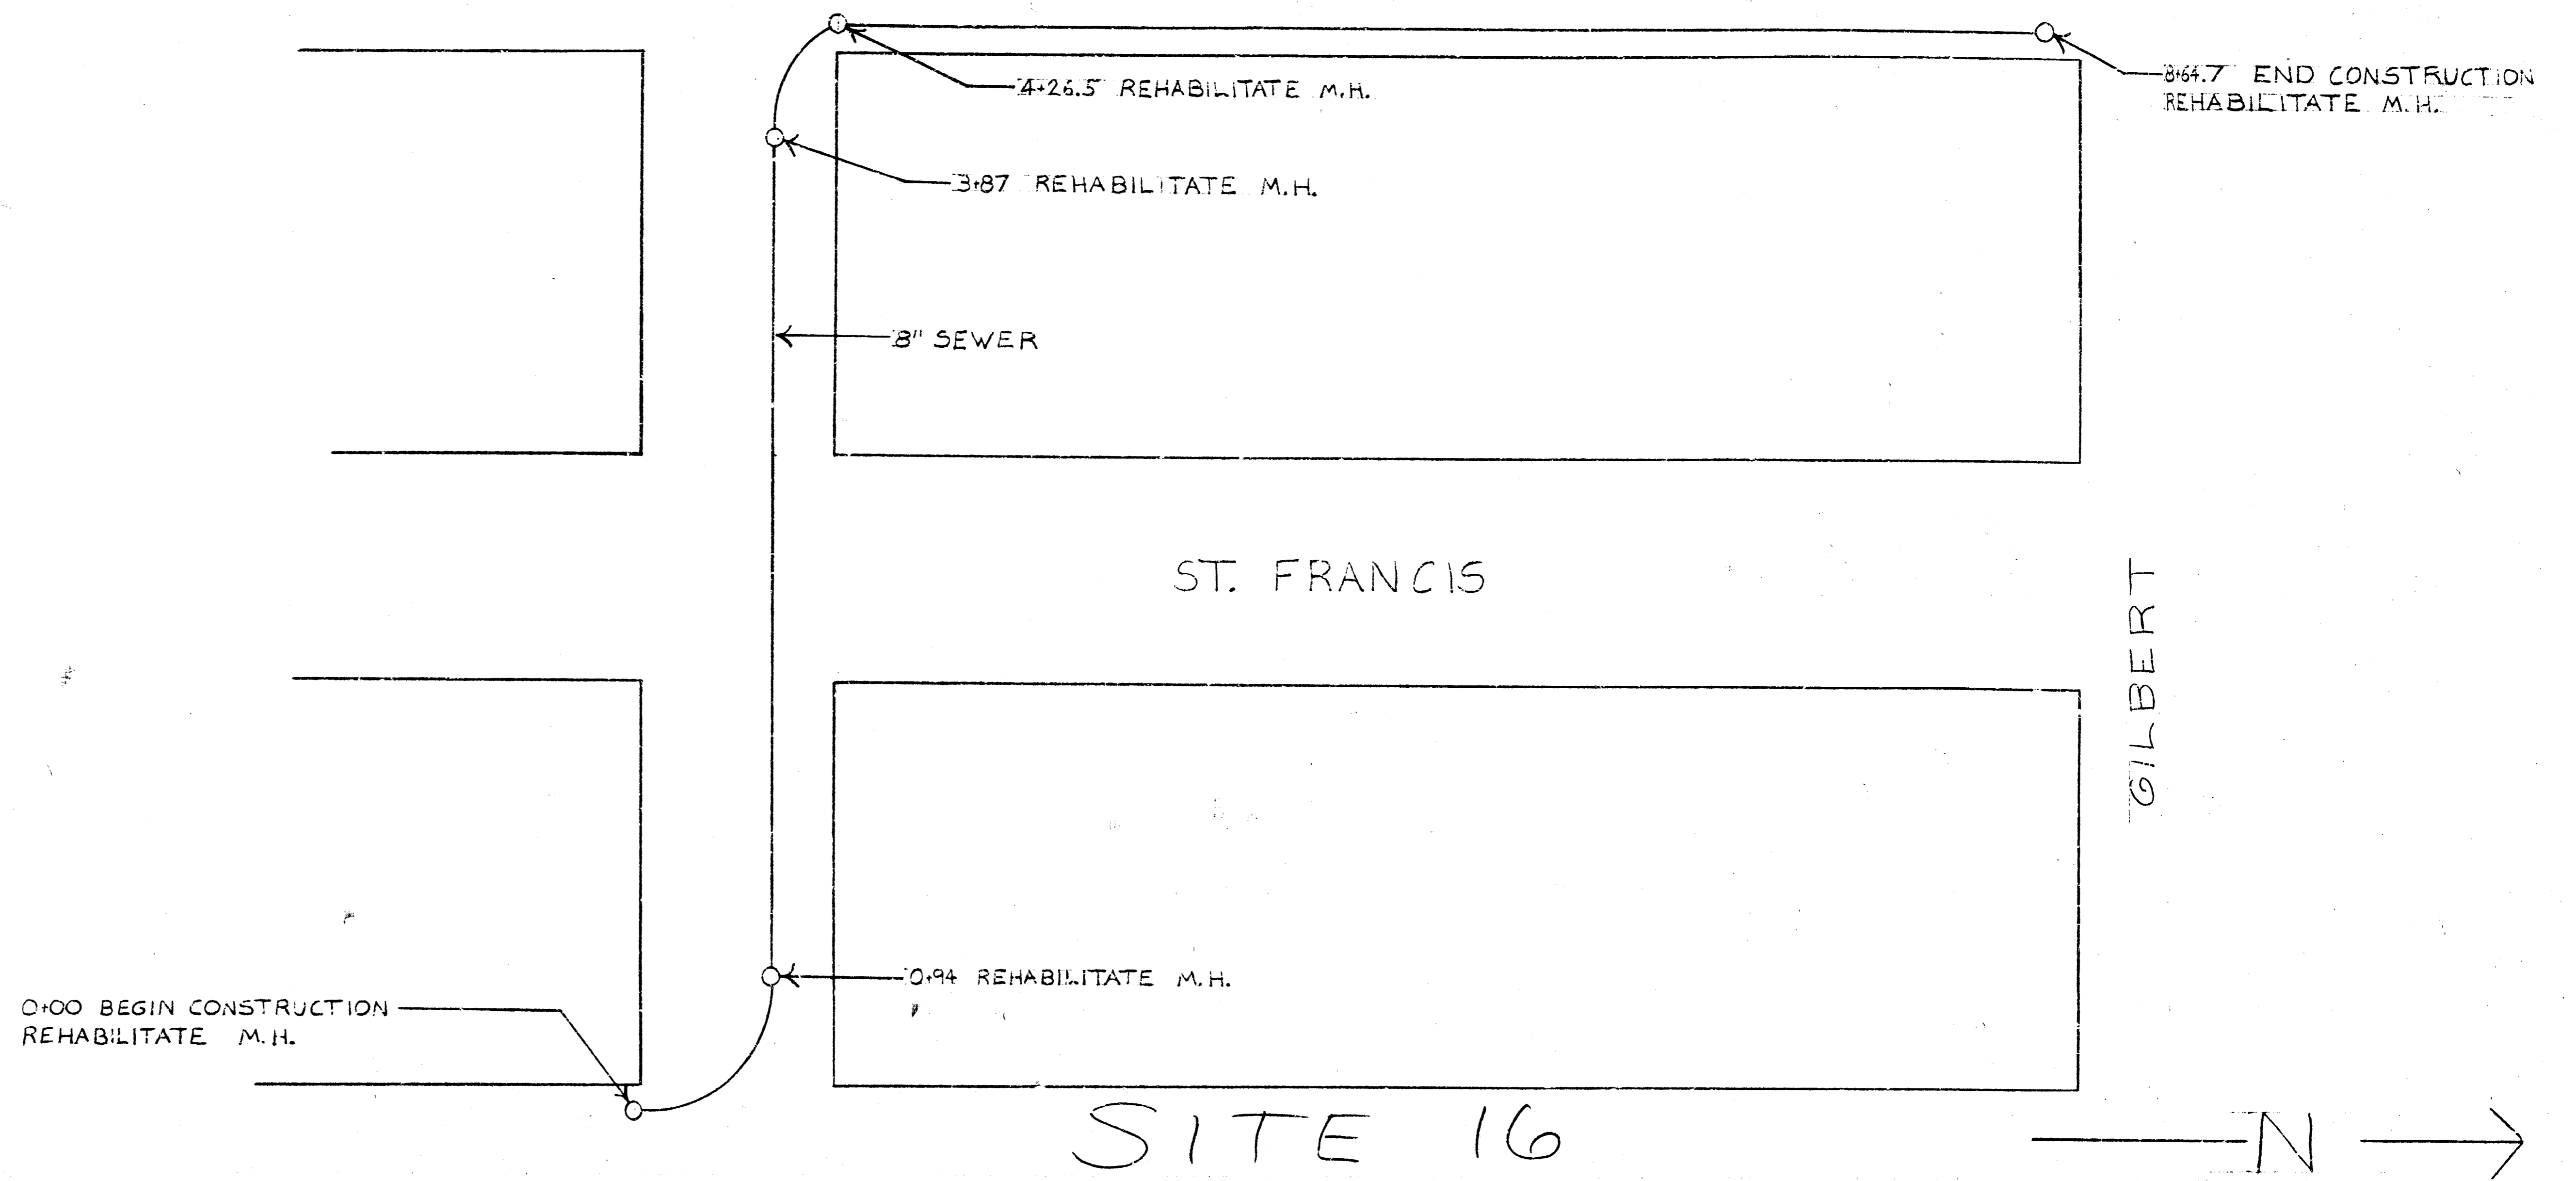


WASHINGTON

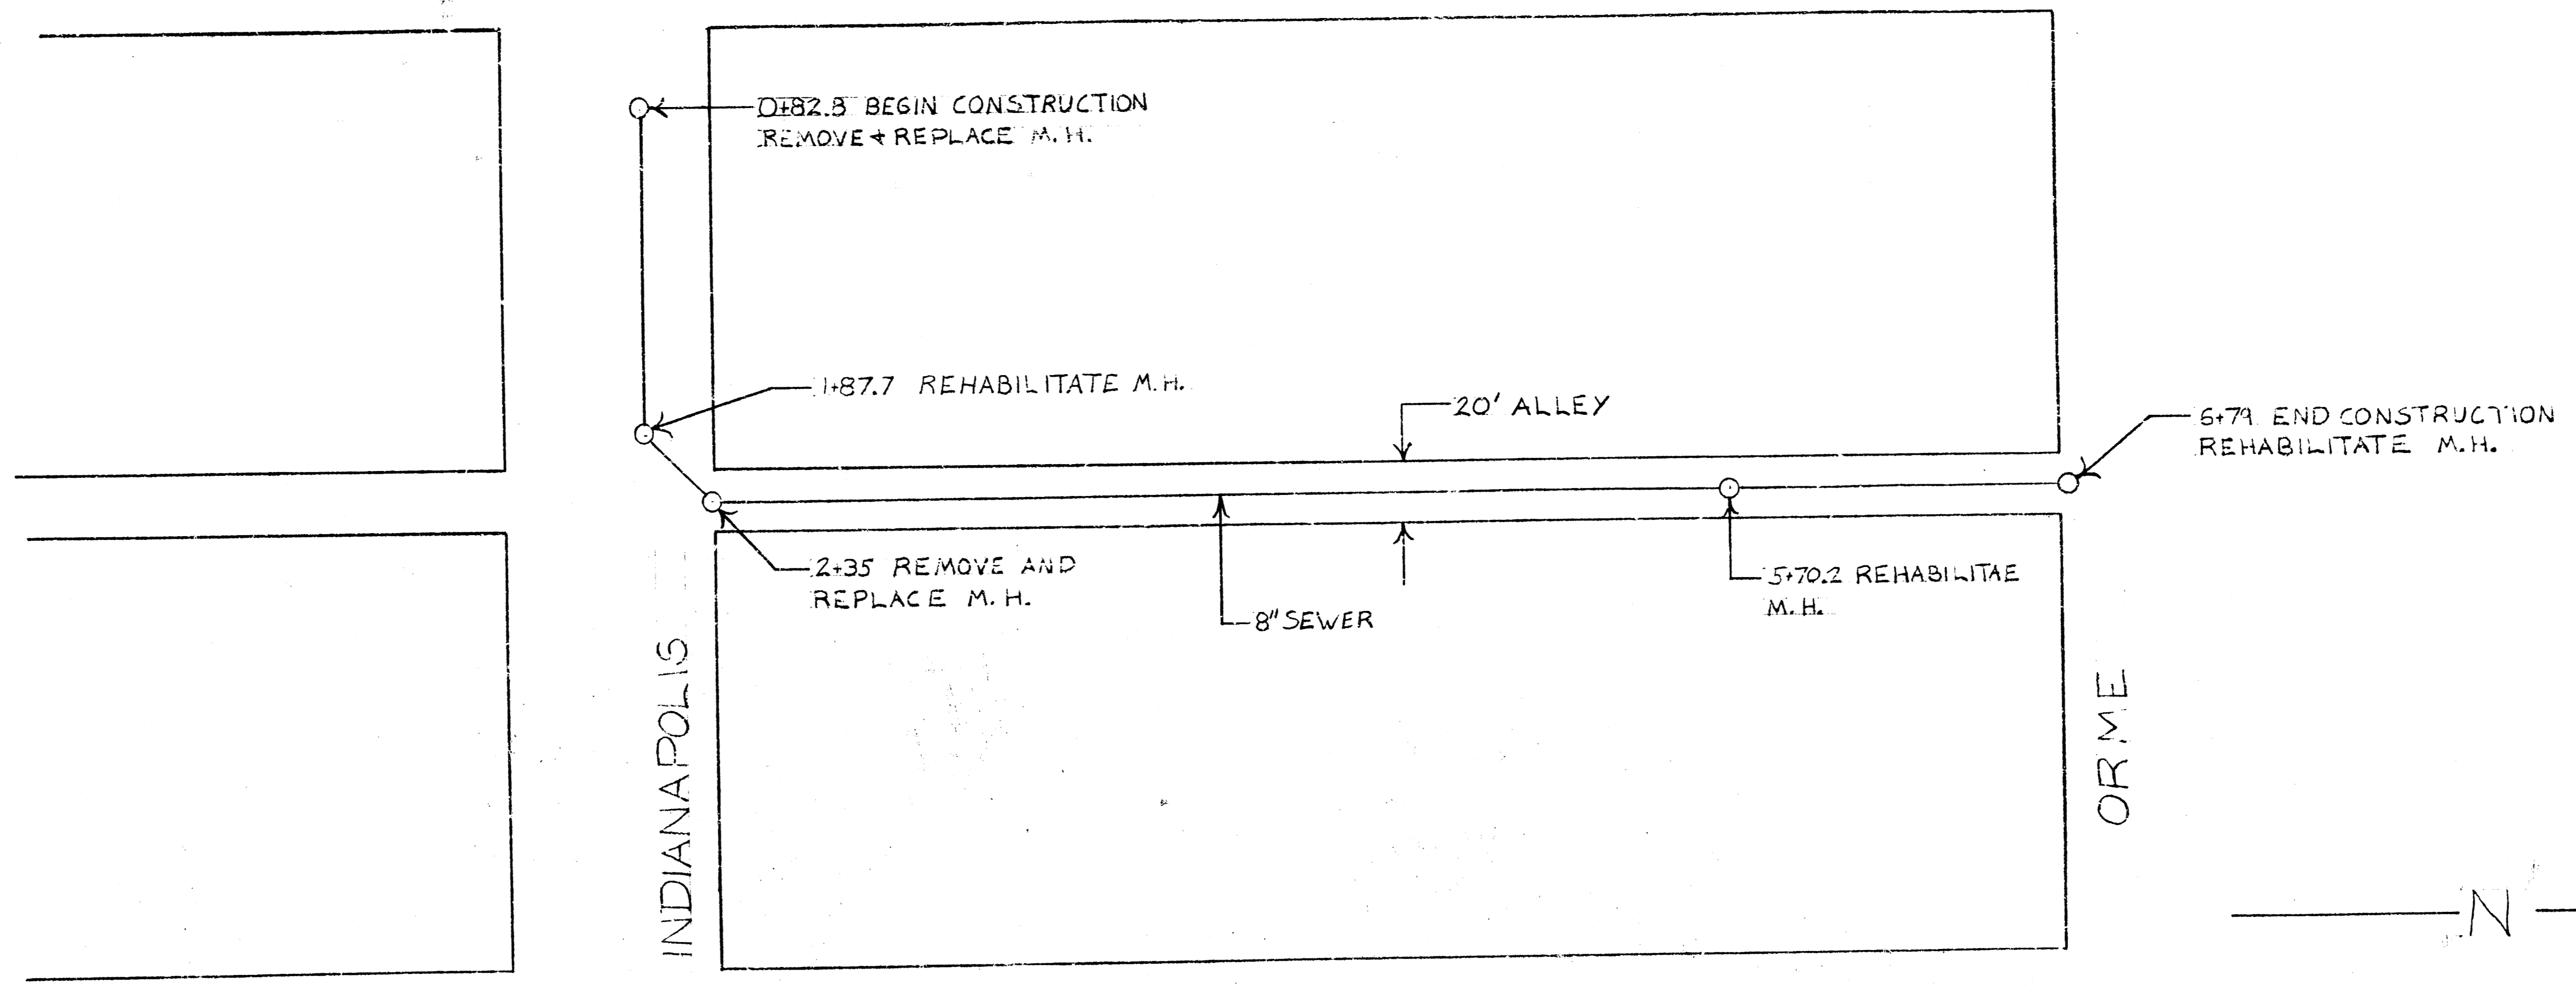

TAP & Y LOCATIONS	
STATION	DIRECTION
4+17.5	EAST
5+66	WEST
5+38.7	EAST
5+13.7	EAST
4+67.5	WEST
4+65	EAST
3+91.20	WEST
3+89.50	EAST
3+65.50	WEST
3+40.30	EAST
3+17	WEST
2+85.5	WEST
2+67.5	WEST
2+34	EAST

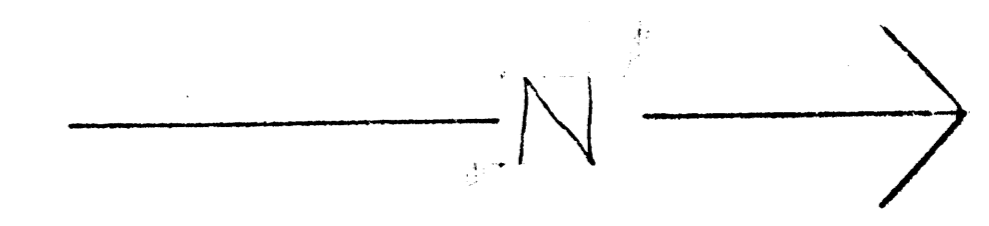

SITE 24

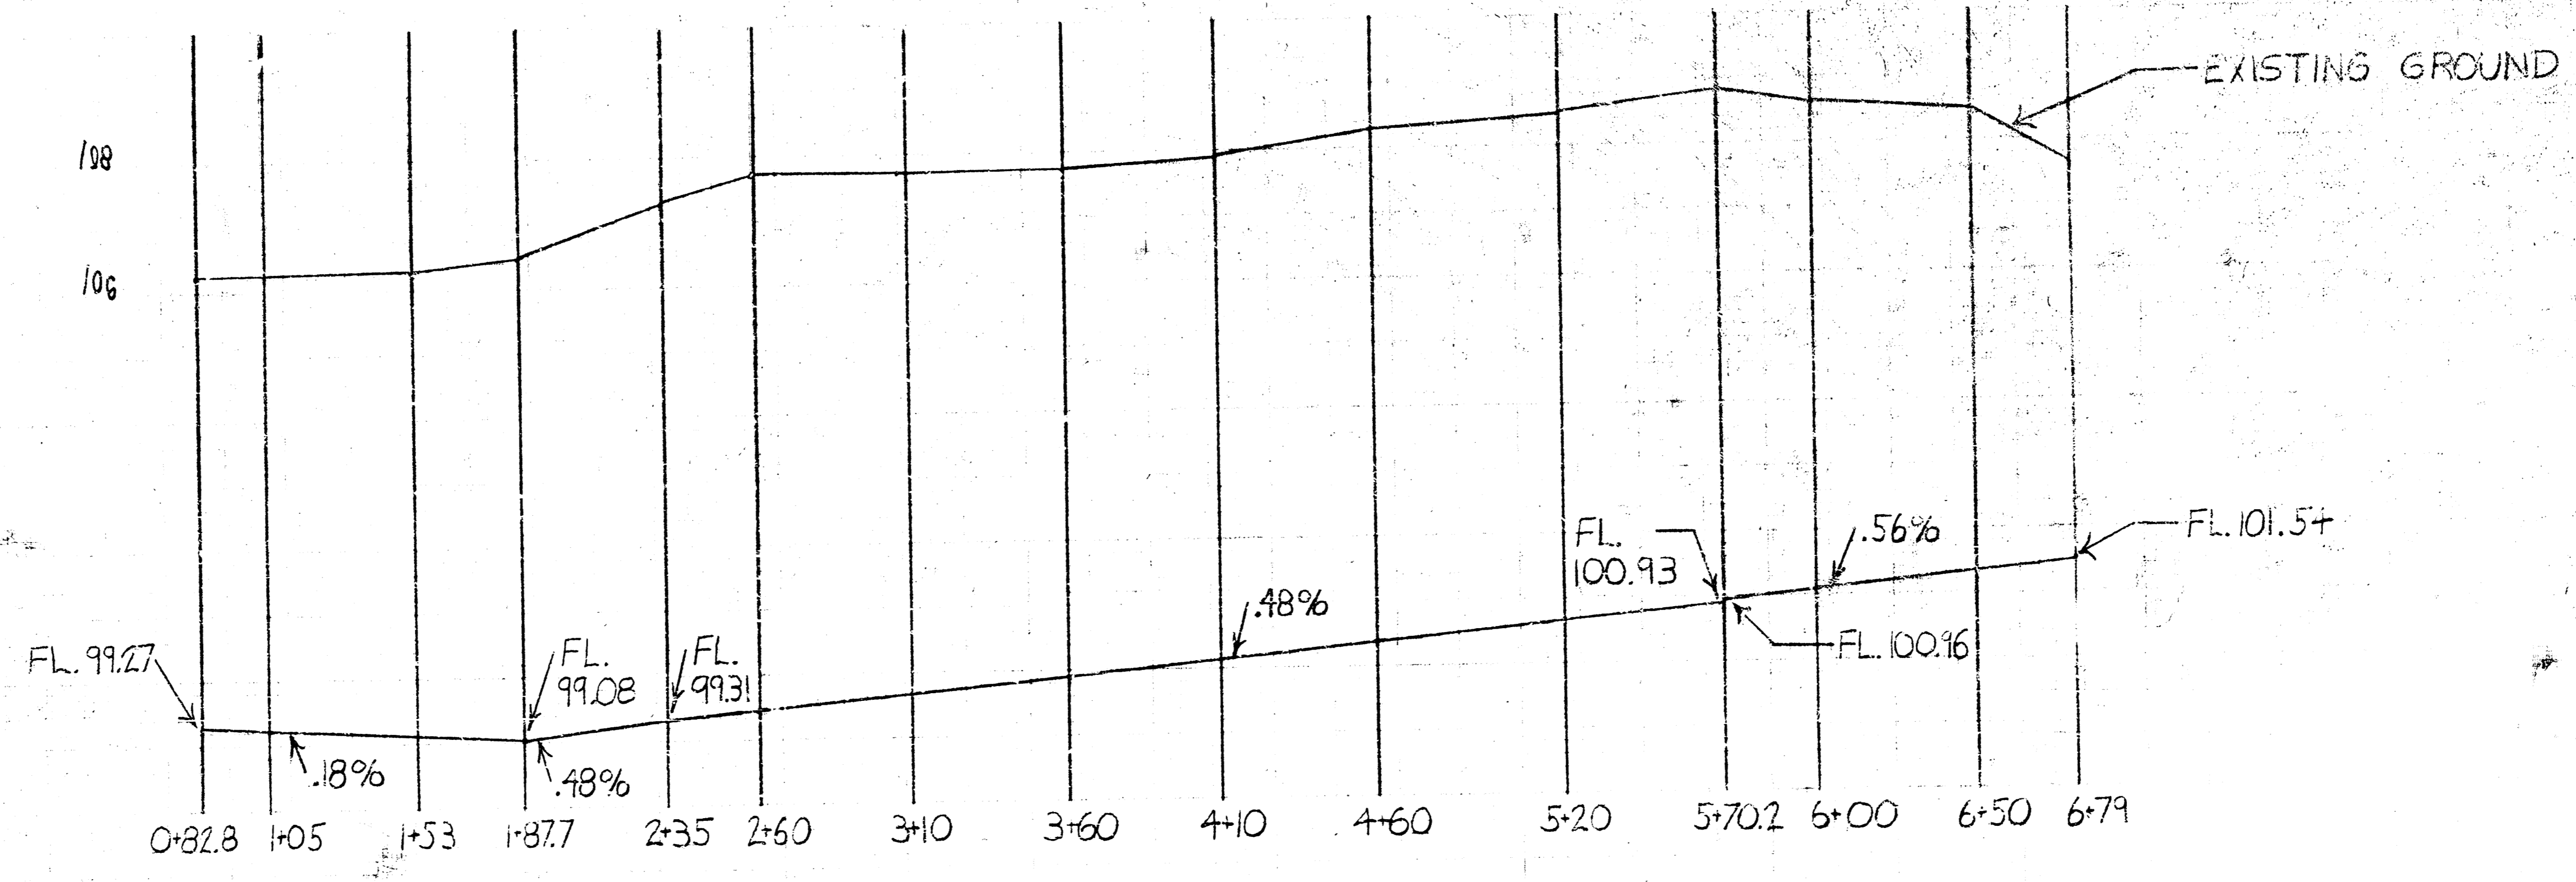

09

107

105

103

101

99