

SHEET NO.	TOTAL SHEETS
1	2

CITY OF WICHITA

SEDGWICK COUNTY, KANSAS

SANITARY SEWER RECONSTRUCTION AT MARKET STREET BRIDGE ACROSS WEST DRAIN OF CHISHOLM CREEK


PROJECT NO. 468-76-245-81227-000-000-001

1983

INDEX OF SHEETS

SHEET	TITLE SHEET
1	PLAN / PROFILE
2	

As Built
JL
6-8-1

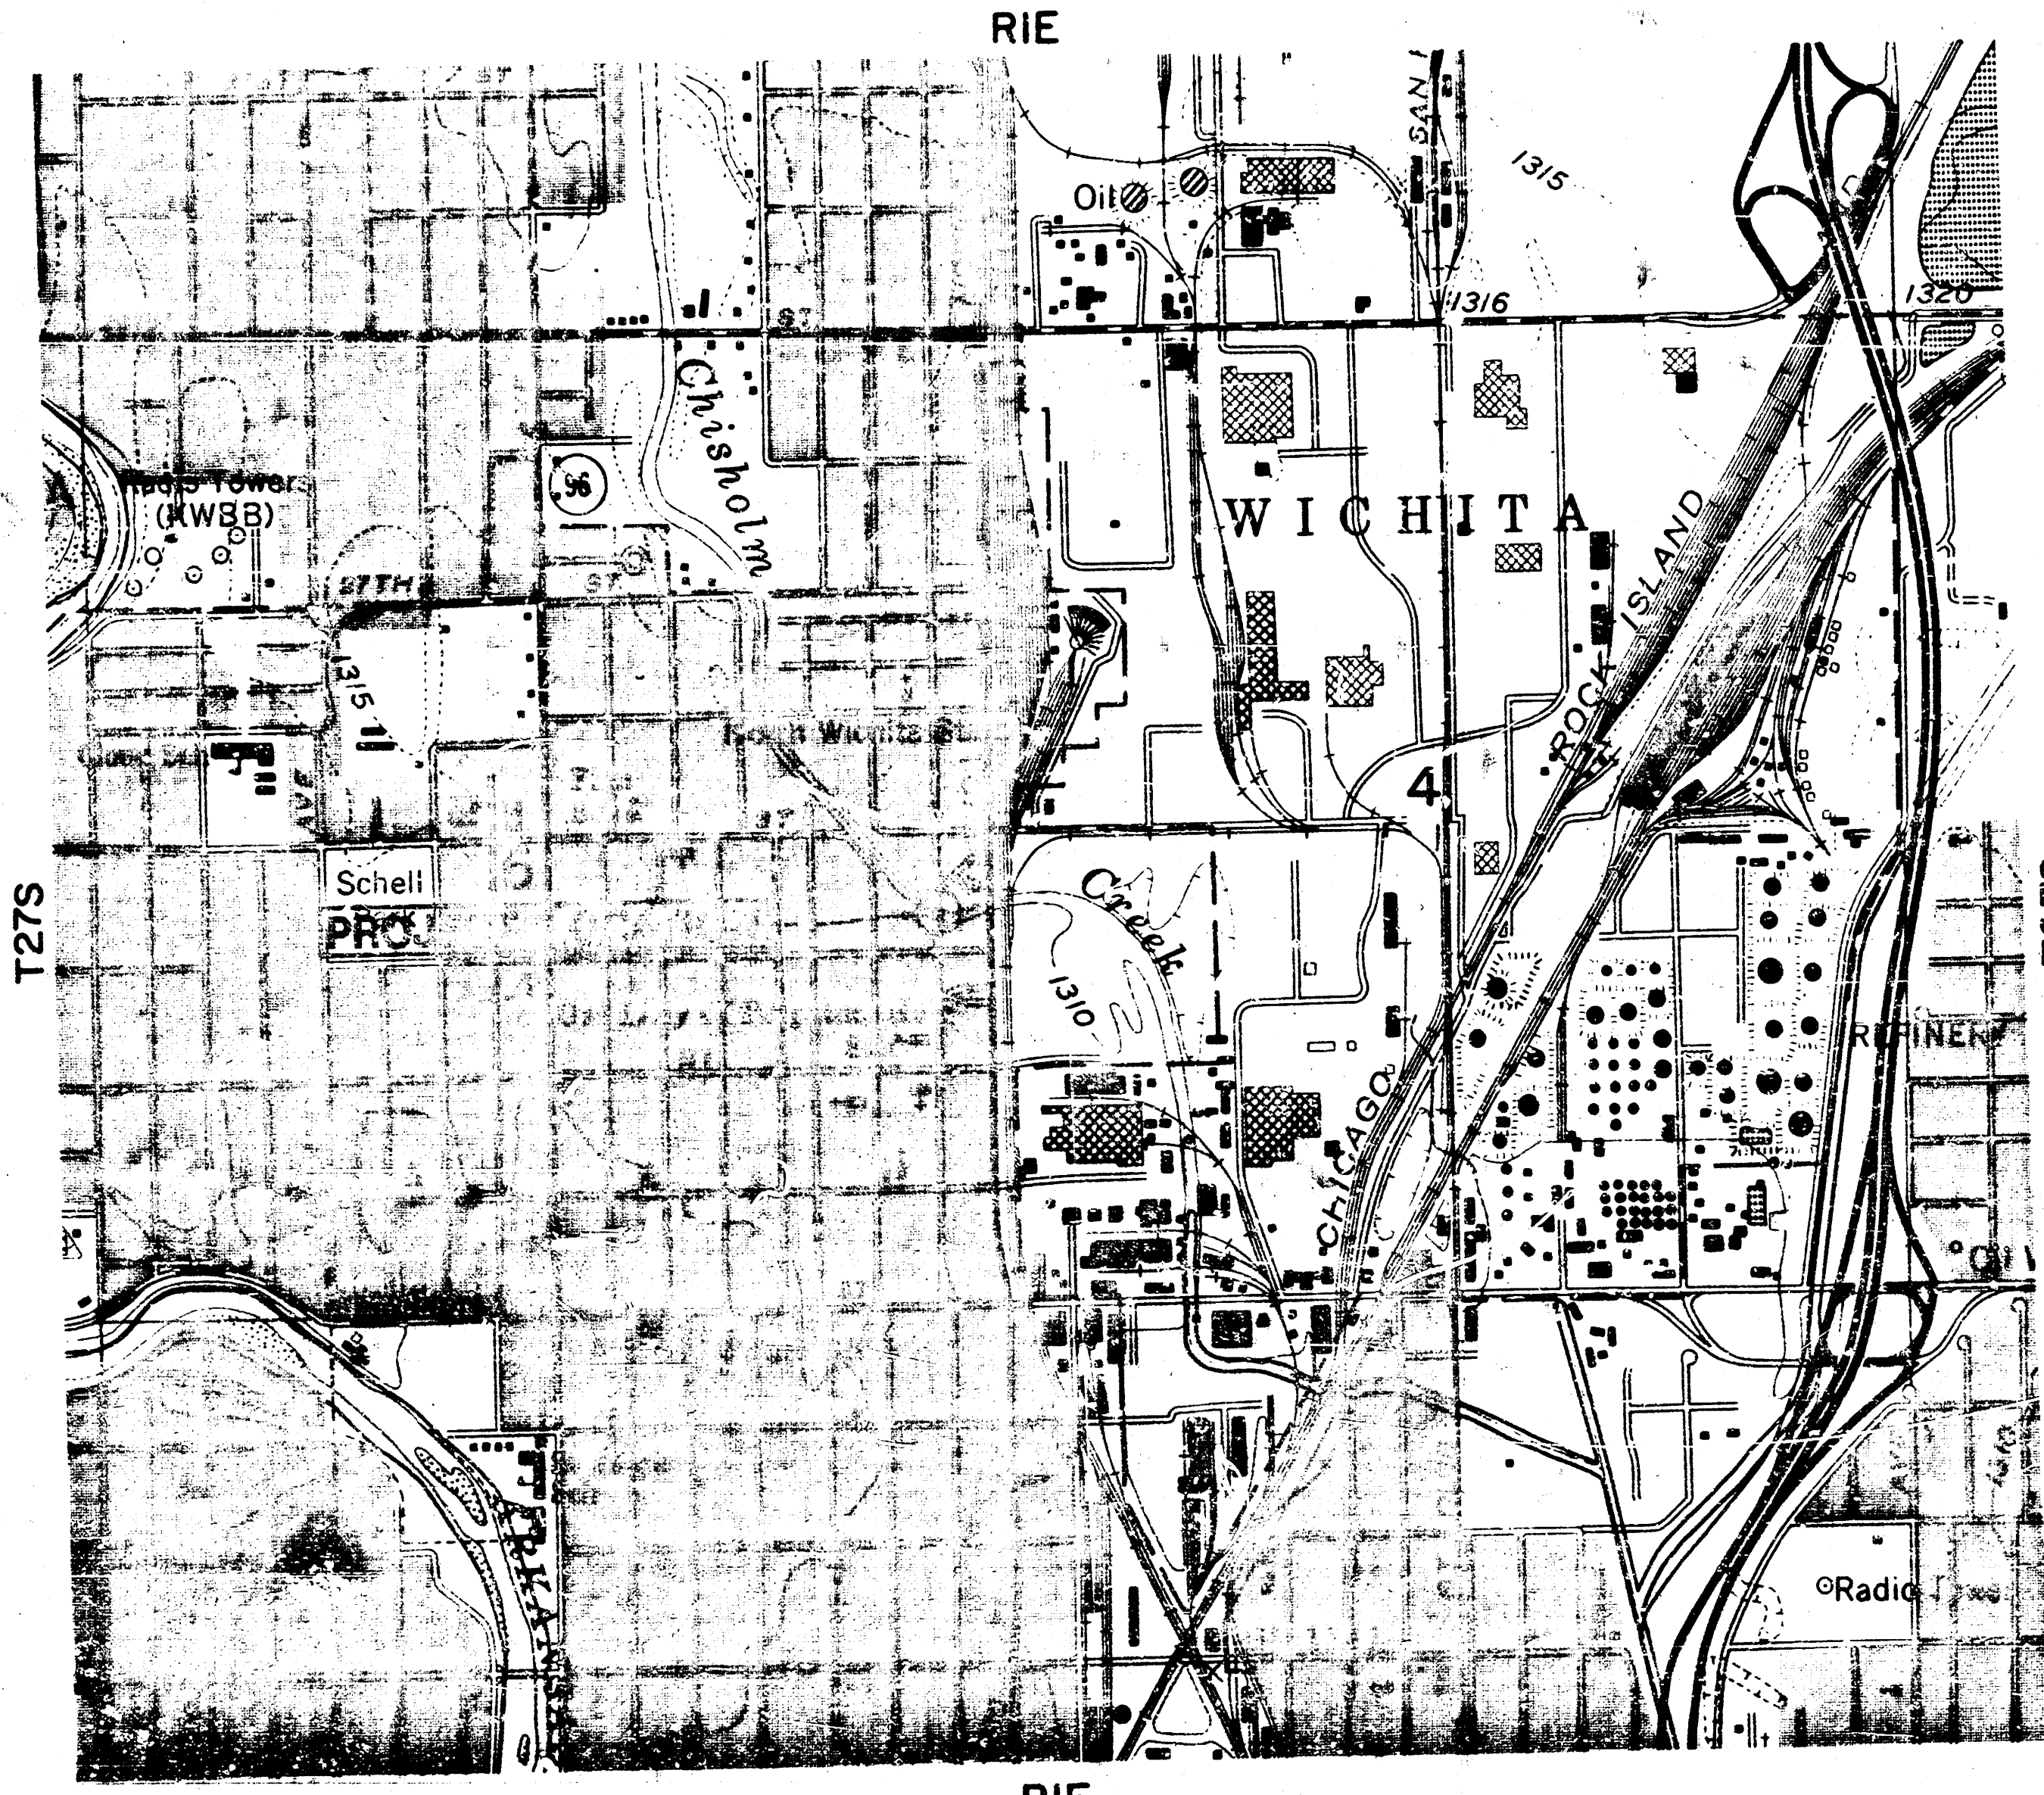

CONVENTIONAL SIGNS	
SECTION LINE	Exist. RW
RIGHT-OF-WAY	Prop. RW
FENCE LINE	
CENTER LINE OF PROJECT	15 6
POWER POLE	
UNGD. TEL. CABLE	Ungd. Tel. Cable M.H.
GAS LINE	0
WATER LINE & WATER VALVE	20" Water Line M.H.
STORM SEWER & MANHOLE	5" Sewer M.H.
SAN. SEWER & MANHOLE	San. Sewer M.H.
TREES	8' 0"

- GENERAL NOTES
- ALL CONSTRUCTION AND MATERIALS TO COMPLY WITH CITY OF WICHITA SPECIFICATIONS AND STANDARDS.
 - ALL ELEVATIONS SHOWN ARE CITY OF WICHITA DATUM (USGS-1187.4 = CITY DATUM).
 - THE CONTRACTOR SHALL LIMIT THE EXTENT OF TRENCH TO REMAIN OPEN OVER-NIGHTS AND WEEKENDS TO LESS THAN 50 FEET.
 - AT LEAST 24 HOURS PRIOR TO BEGINNING EXCAVATION (EXCLUDING WEEKENDS AND HOLIDAYS), THE CONTRACTOR SHALL CONTACT THE UTILITY LOCATION SERVICE "KAN-U-DIG-IT" AT (316) 267-2889 TO REQUEST THE FOLLOWING UTILITY COMPANIES TO LOCATE ANY EXISTING LINES WITHIN THE PROJECT AREA: GAS SERVICE COMPANY, K.S.B.E., SOUTHWESTERN BELL TELEPHONE COMPANY, THE WICHITA WATER DEPARTMENT, AND AIR CAPITAL CABLEVISION. THE CONTRACTOR SHALL ALSO CALL THE UTILITIES LISTED BELOW AT LEAST 72 HOURS PRIOR TO BEGINNING EXCAVATING (EXCLUDING WEEKENDS AND HOLIDAYS) TO REQUEST LOCATION OF EXISTING UTILITIES WITHIN THE PROJECT AREA.

ARKLA GAS COMPANY
1630 SOUTH BAEHR
WICHITA, KANSAS 67209
(316) 942-8350
MR. HERSHEL HUNTON
 - WHERE REMOVAL OF EXISTING FENCES PARALLEL TO THE CONSTRUCTION IS DEEMED NECESSARY BY THE CONTRACTOR, THE CONTRACTOR SHALL COORDINATE REMOVAL WITH THE ENGINEER. REMOVAL AND RESETTling OF FENCES SHALL NOT BE PAID FOR SEPARATELY, BUT SHALL BE CONSIDERED AS SUBSIDIARY TO THE OTHER ITEMS OF WORK.
 - TREES REMOVED, TREE TRIMMINGS, FENCES AND OTHER DEBRIS SHALL BE HAULED FROM THE SITE BY THE CONTRACTOR AND WASTED AS DIRECTED BY THE ENGINEER AT NO ADDITIONAL COST TO THE OWNER.
 - THE CONTRACTOR SHALL RESTORE ALL DITCHES, SWALES, ROAD SHOULDERS, ENTRANCES, AND BANK LINES TO THEIR ORIGINAL SLOPES AND GRADES EXCEPT WHERE INDICATED OTHERWISE IN THE PLANS.
 - THE CONTRACTOR SHALL BE RESPONSIBLE FOR MAINTAINING CONTINUOUS FLOW OF SEWAGE THROUGH CONSTRUCTION. CONTRACTOR'S PROPOSED METHOD FOR MAINTAINING SEWAGE FLOW SHALL BE APPROVED BY THE ENGINEER. CONTRACTOR MAY CONSTRUCT ADDITIONAL MANHOLES TO FACILITATE HANDLING OF SEWAGE FLOW. TYPE AND LOCATION OF EXTRA MANHOLES TO FACILITATE HANDLING OF SEWAGE SHALL BE APPROVED BY THE ENGINEER. COST OF MAINTAINING FLOW OF SEWAGE THROUGH CONSTRUCTION WILL NOT BE PAID FOR DIRECTLY AND THIS COST SHALL BE CONSIDERED AS SUBSIDIARY TO THE OTHER ITEMS OF WORK. NO PAYMENT WILL BE MADE FOR EXTRA MANHOLES CONSTRUCTED BY THE CONTRACTOR TO FACILITATE HANDLING SEWAGE THROUGH CONSTRUCTION AS THIS COST SHALL BE CONSIDERED SUBSIDIARY TO THE OTHER ITEMS OF WORK.
 - THE CONTRACTOR SHALL BE RESPONSIBLE FOR PRESERVING PROPERTY IRONS. THE CONTRACTOR SHALL BE REQUIRED TO RE-ESTABLISH ANY PROPERTY IRONS WHICH ARE DAMAGED OR DESTROYED BY HIS CONSTRUCTION OPERATIONS. SUCH IRONS SHALL BE RE-ESTABLISHED BY A LICENSED LAND SURVEYOR OR A LICENSED PROFESSIONAL ENGINEER IN ACCORDANCE WITH STATE LAWS. ALL COST FOR THIS WORK SHALL BE SUBSIDIARY TO THE OTHER ITEMS OF WORK.
 - THE CONTRACTOR SHALL DEPOSIT ALL EXCESS EXCAVATED SOIL WITHIN THE BOUNDARIES PROVIDED BY THE DEVELOPER.
 - ALL SANITARY SEWER PIPE SHALL BE DUCTILE IRON PIPE WITH LINER.

PLANS PREPARED BY
PROFESSIONAL ENGINEERING CONSULTANTS, P.A.
ENGINEERS
WICHITA, KANSAS



APPROVED	DATE
M. E. LINDESAK - CITY ENGINEER WICHITA, KANSAS PROJ. NO. 468-76-245-81227-000-000-001	

REVISED OCT. 20, 1983

FILMED FROM THE BEST
AVAILABLE COPY

