

NOTE: ALL OF LOT 11 IS A SANITARY SEWER EASEMENT

7-20-76
APPROVED AS NOTED
 By CITY ENGINEER OF WICHITA
 Sanitary Sewers A.E.B.
 Storm Sewers _____
 Driveway Approaches _____


NOTE TO CONTRACTOR
 This project will be constructed under the supervision of the CITY ENGINEER and conforming to the SPECIFICATIONS of the CITY OF WICHITA. The CONTRACTOR will reimburse the City of Wichita for all cost of Engineering, Plans, and Inspection.

REVISED
 11-0-78

WEST WAREHOUSE ADD
 SANITARY SEWER
 CONNECTION
 UTILITY CONTRACTORS
 7-13-76
 RLF
 WEST WAREHOUSE ADDITION

14 UT60 01

SEWER EASEMENT

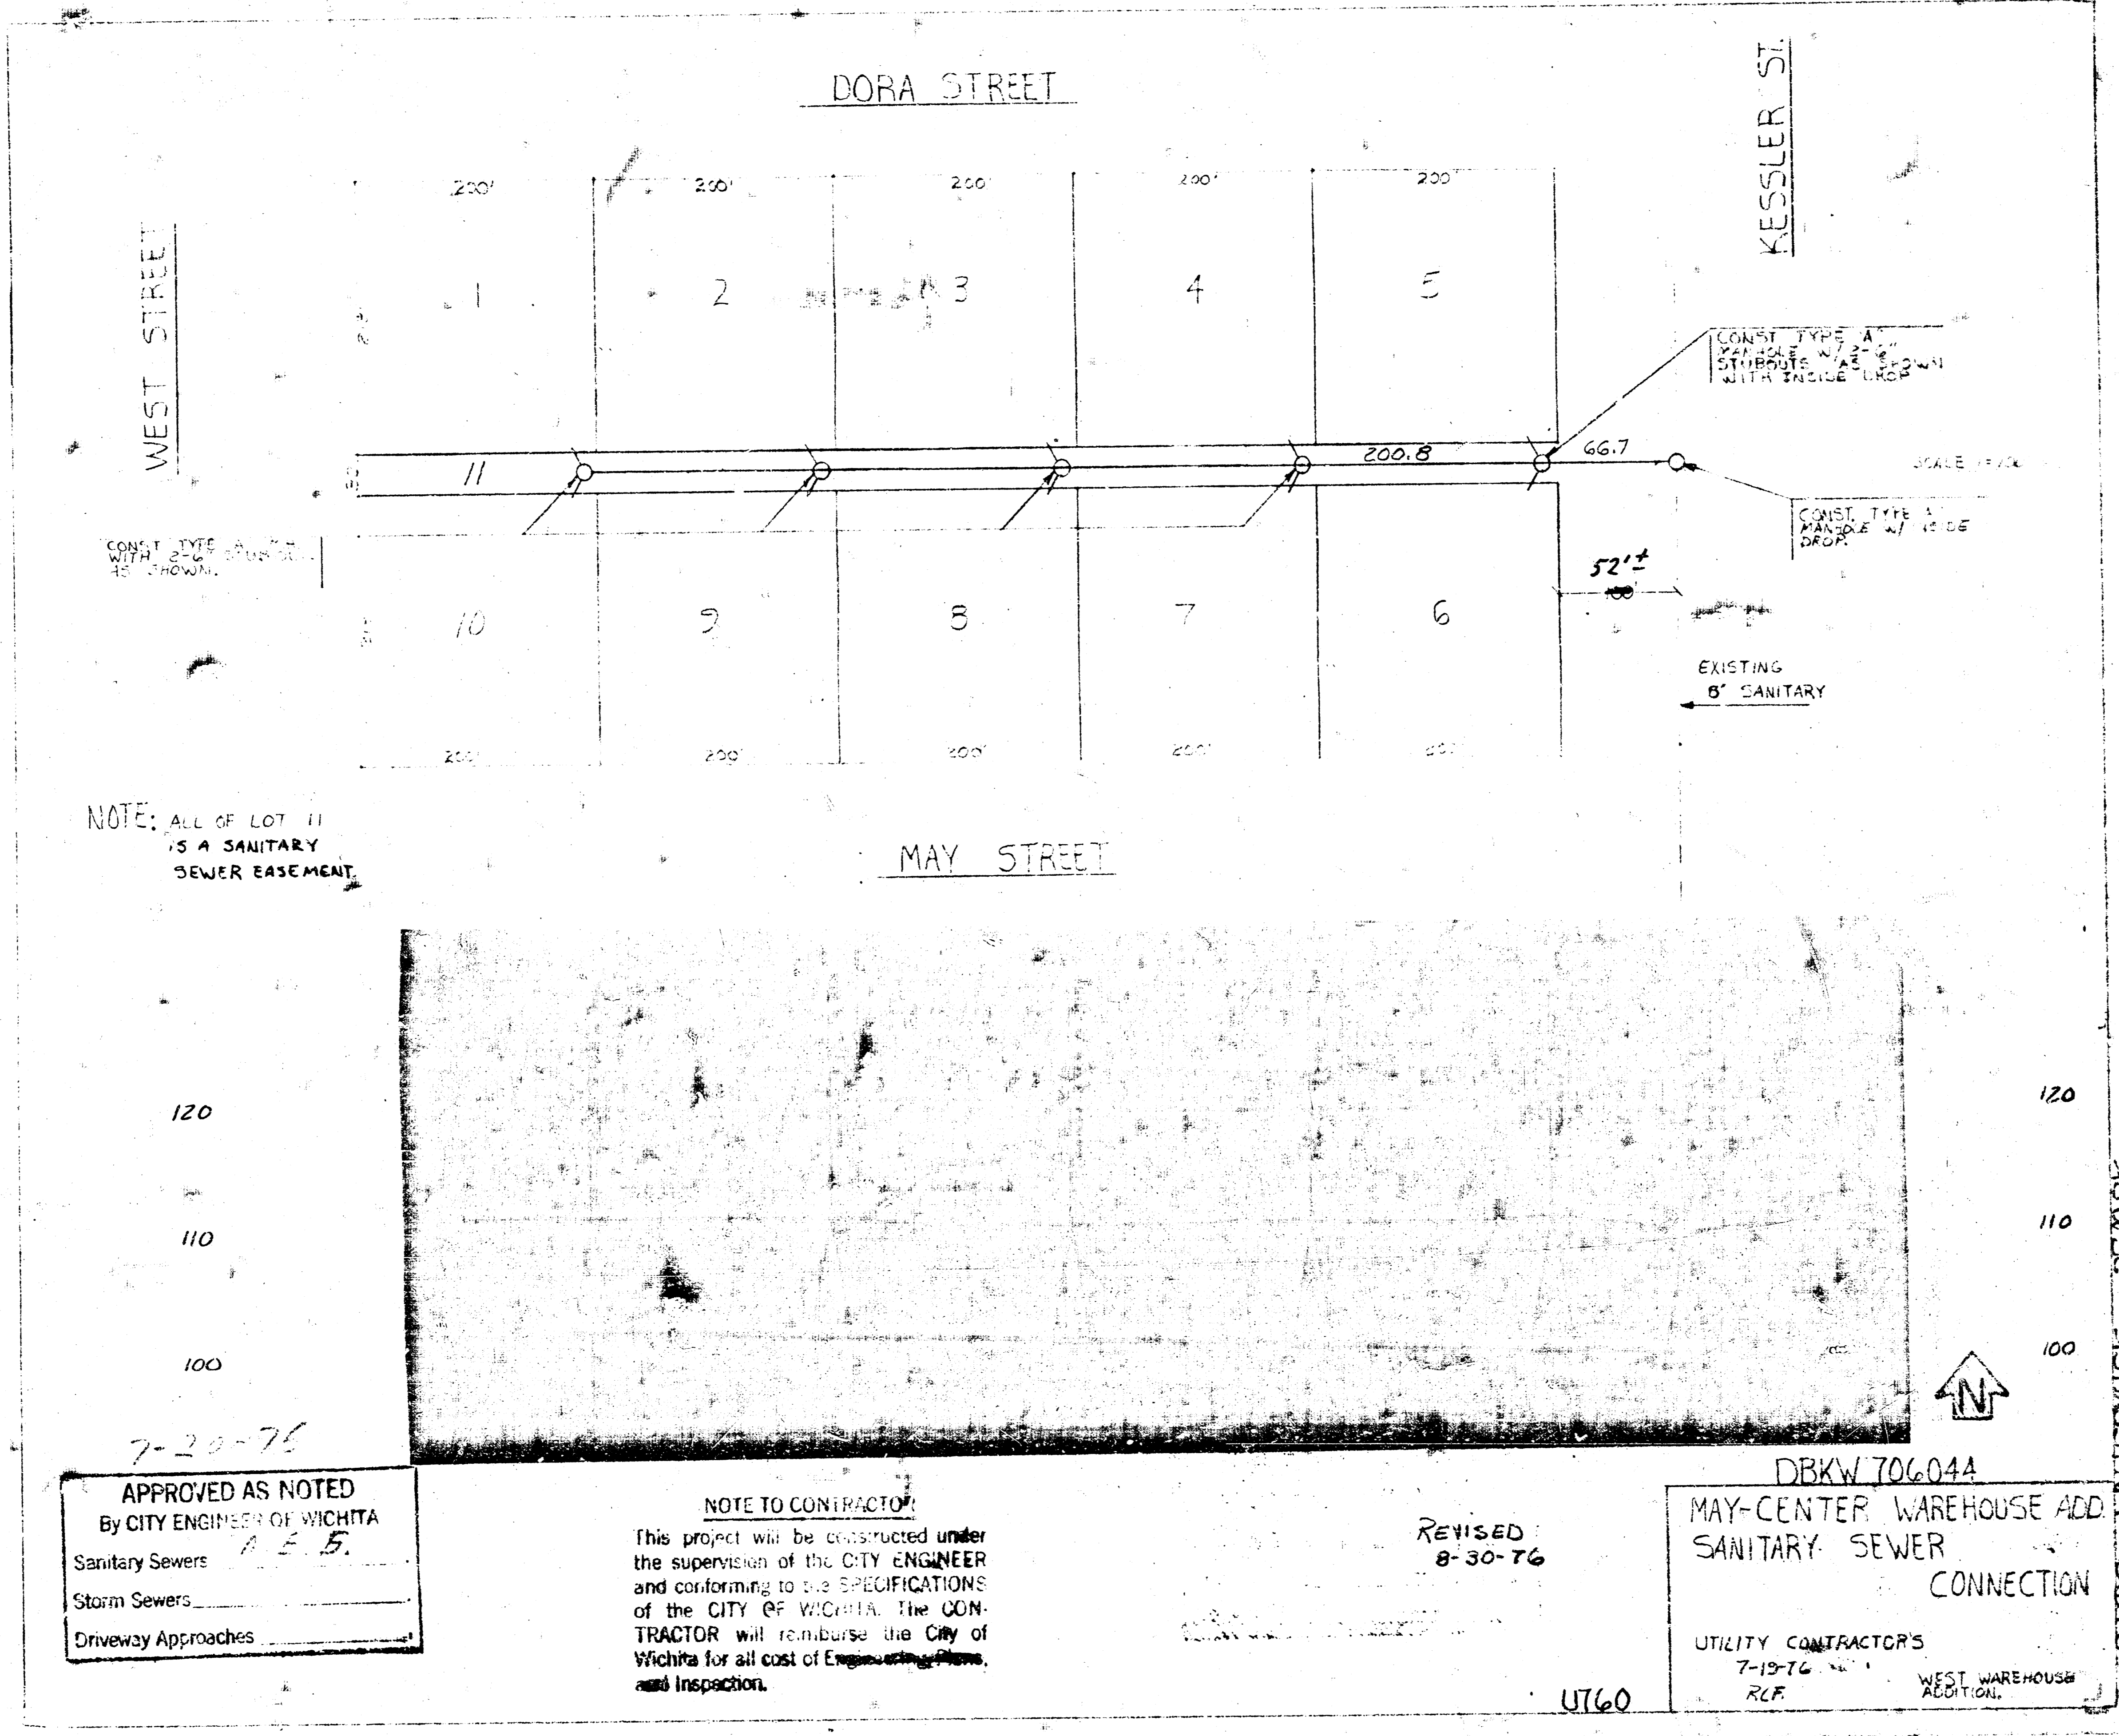

NOTE: ALL OF LOT 11 IS A SANITARY SEWER EASEMENT.

7-20-76
APPROVED AS NOTED
 By CITY ENGINEER OF WICHITA
 Sanitary Sewers A.E.S.
 Storm Sewers _____
 Driveway Approaches _____

NOTE TO CONTRACTOR:
 This project will be constructed under the supervision of the CITY ENGINEER and conforming to the SPECIFICATIONS of the CITY OF WICHITA. The CONTRACTOR will reimburse the City of Wichita for all cost of Engineering, Plans, and Inspection.

REVISED
 8-30-76

DBKW 706044
MAY-CENTER WAREHOUSE ADD. SANITARY SEWER CONNECTION
 UTILITY CONTRACTOR'S
 7-19-76
 R.C.F. WEST WAREHOUSE SECTION

UT60

1100 W. WAREHOUSE SECTION