



SANITARY SEWER PROFILE
SCALE: 1"=50' HORIZ.
1"=5' VERT.

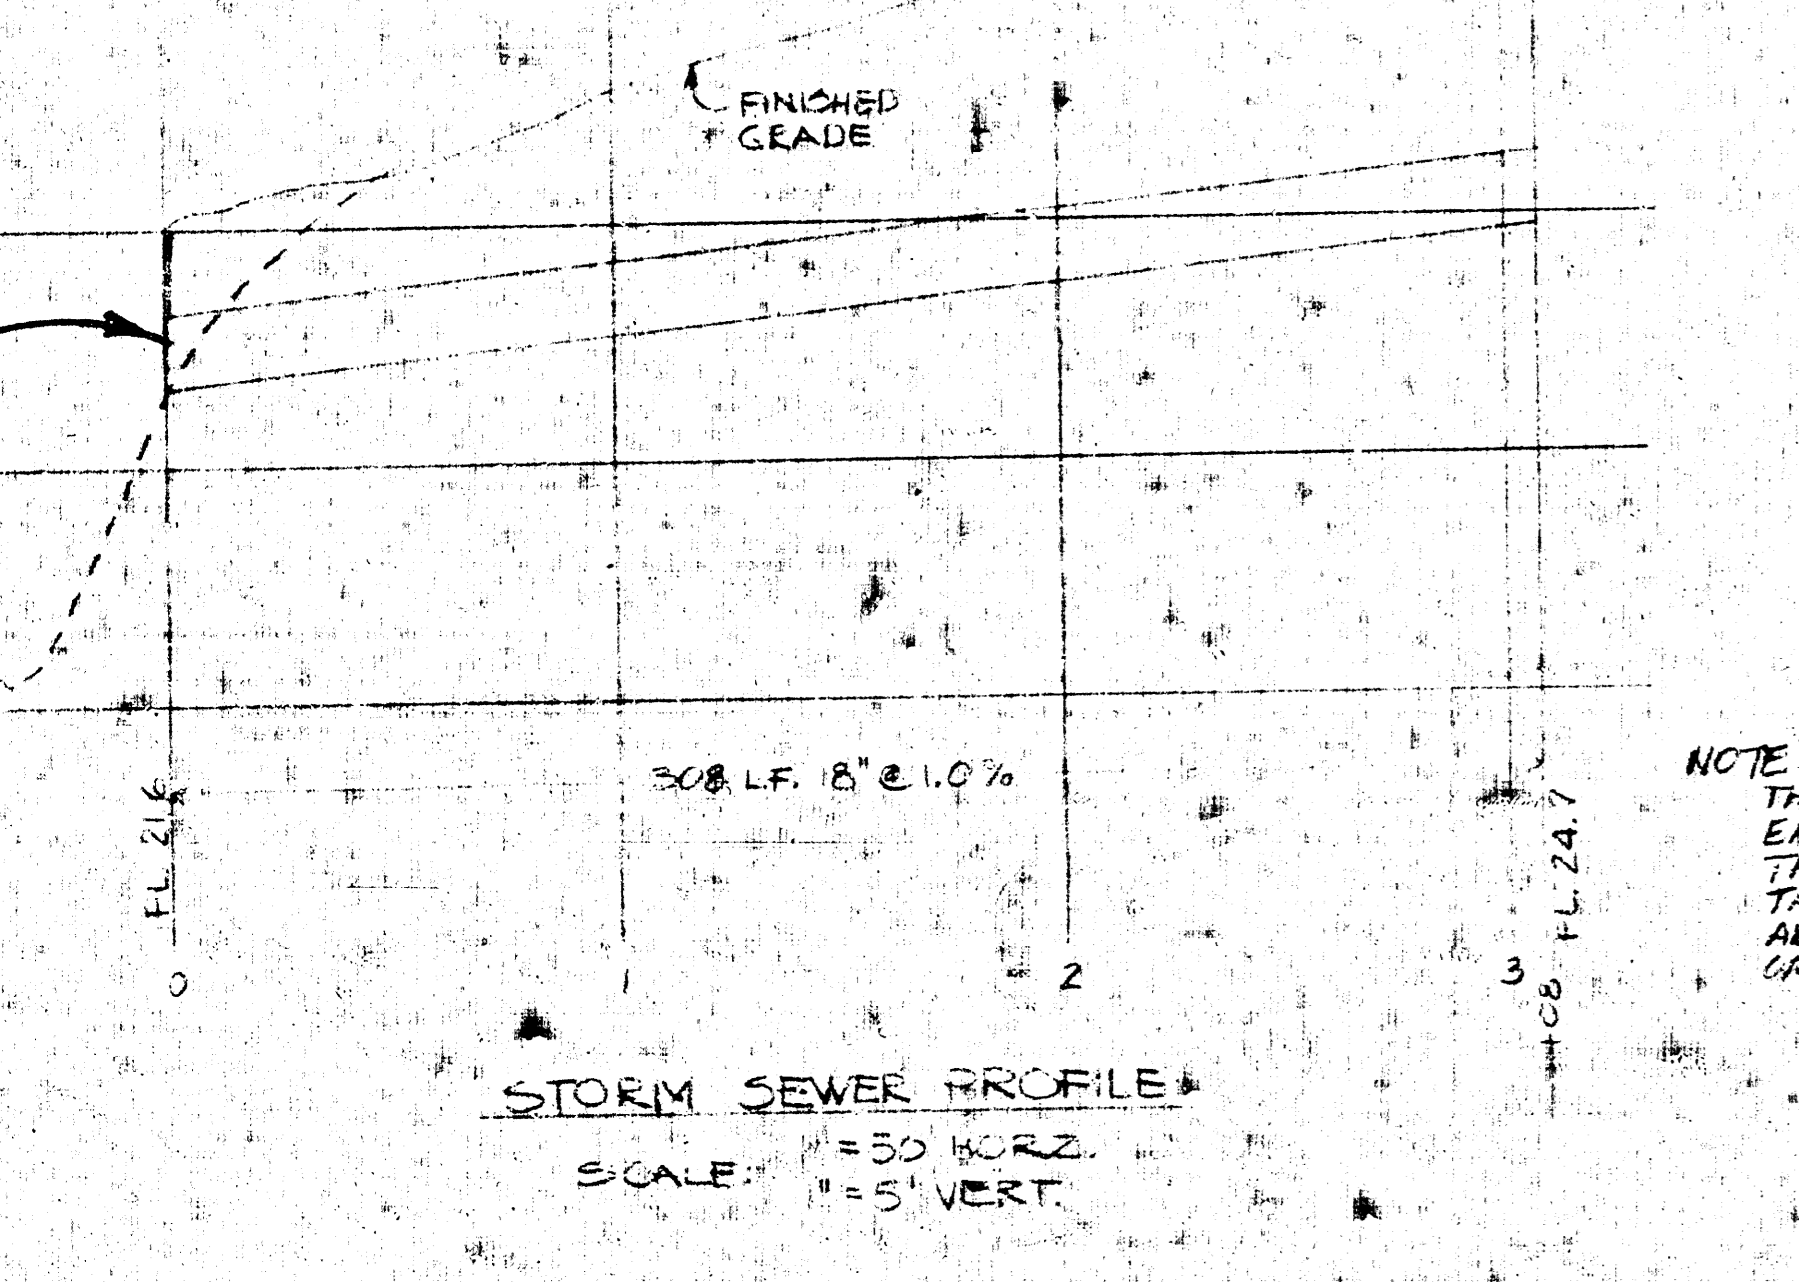

STORM SEWER PROFILE
SCALE: 1"=50' HORIZ.
1"=5' VERT.

NOTE: IT IS THE INTENT OF THESE DRAWINGS THAT TOTAL EARTH FILL EQUAL TOTAL EARTH EXCAVATION. GRADE ELEVATIONS IN THIS GENERAL AREA MAY BE ADJUSTED BY THE CONTRACTOR, AS APPROVED BY THE ARCHITECT, TO COMPENSATE FOR EXCESS OR INADEQUATE FILL.

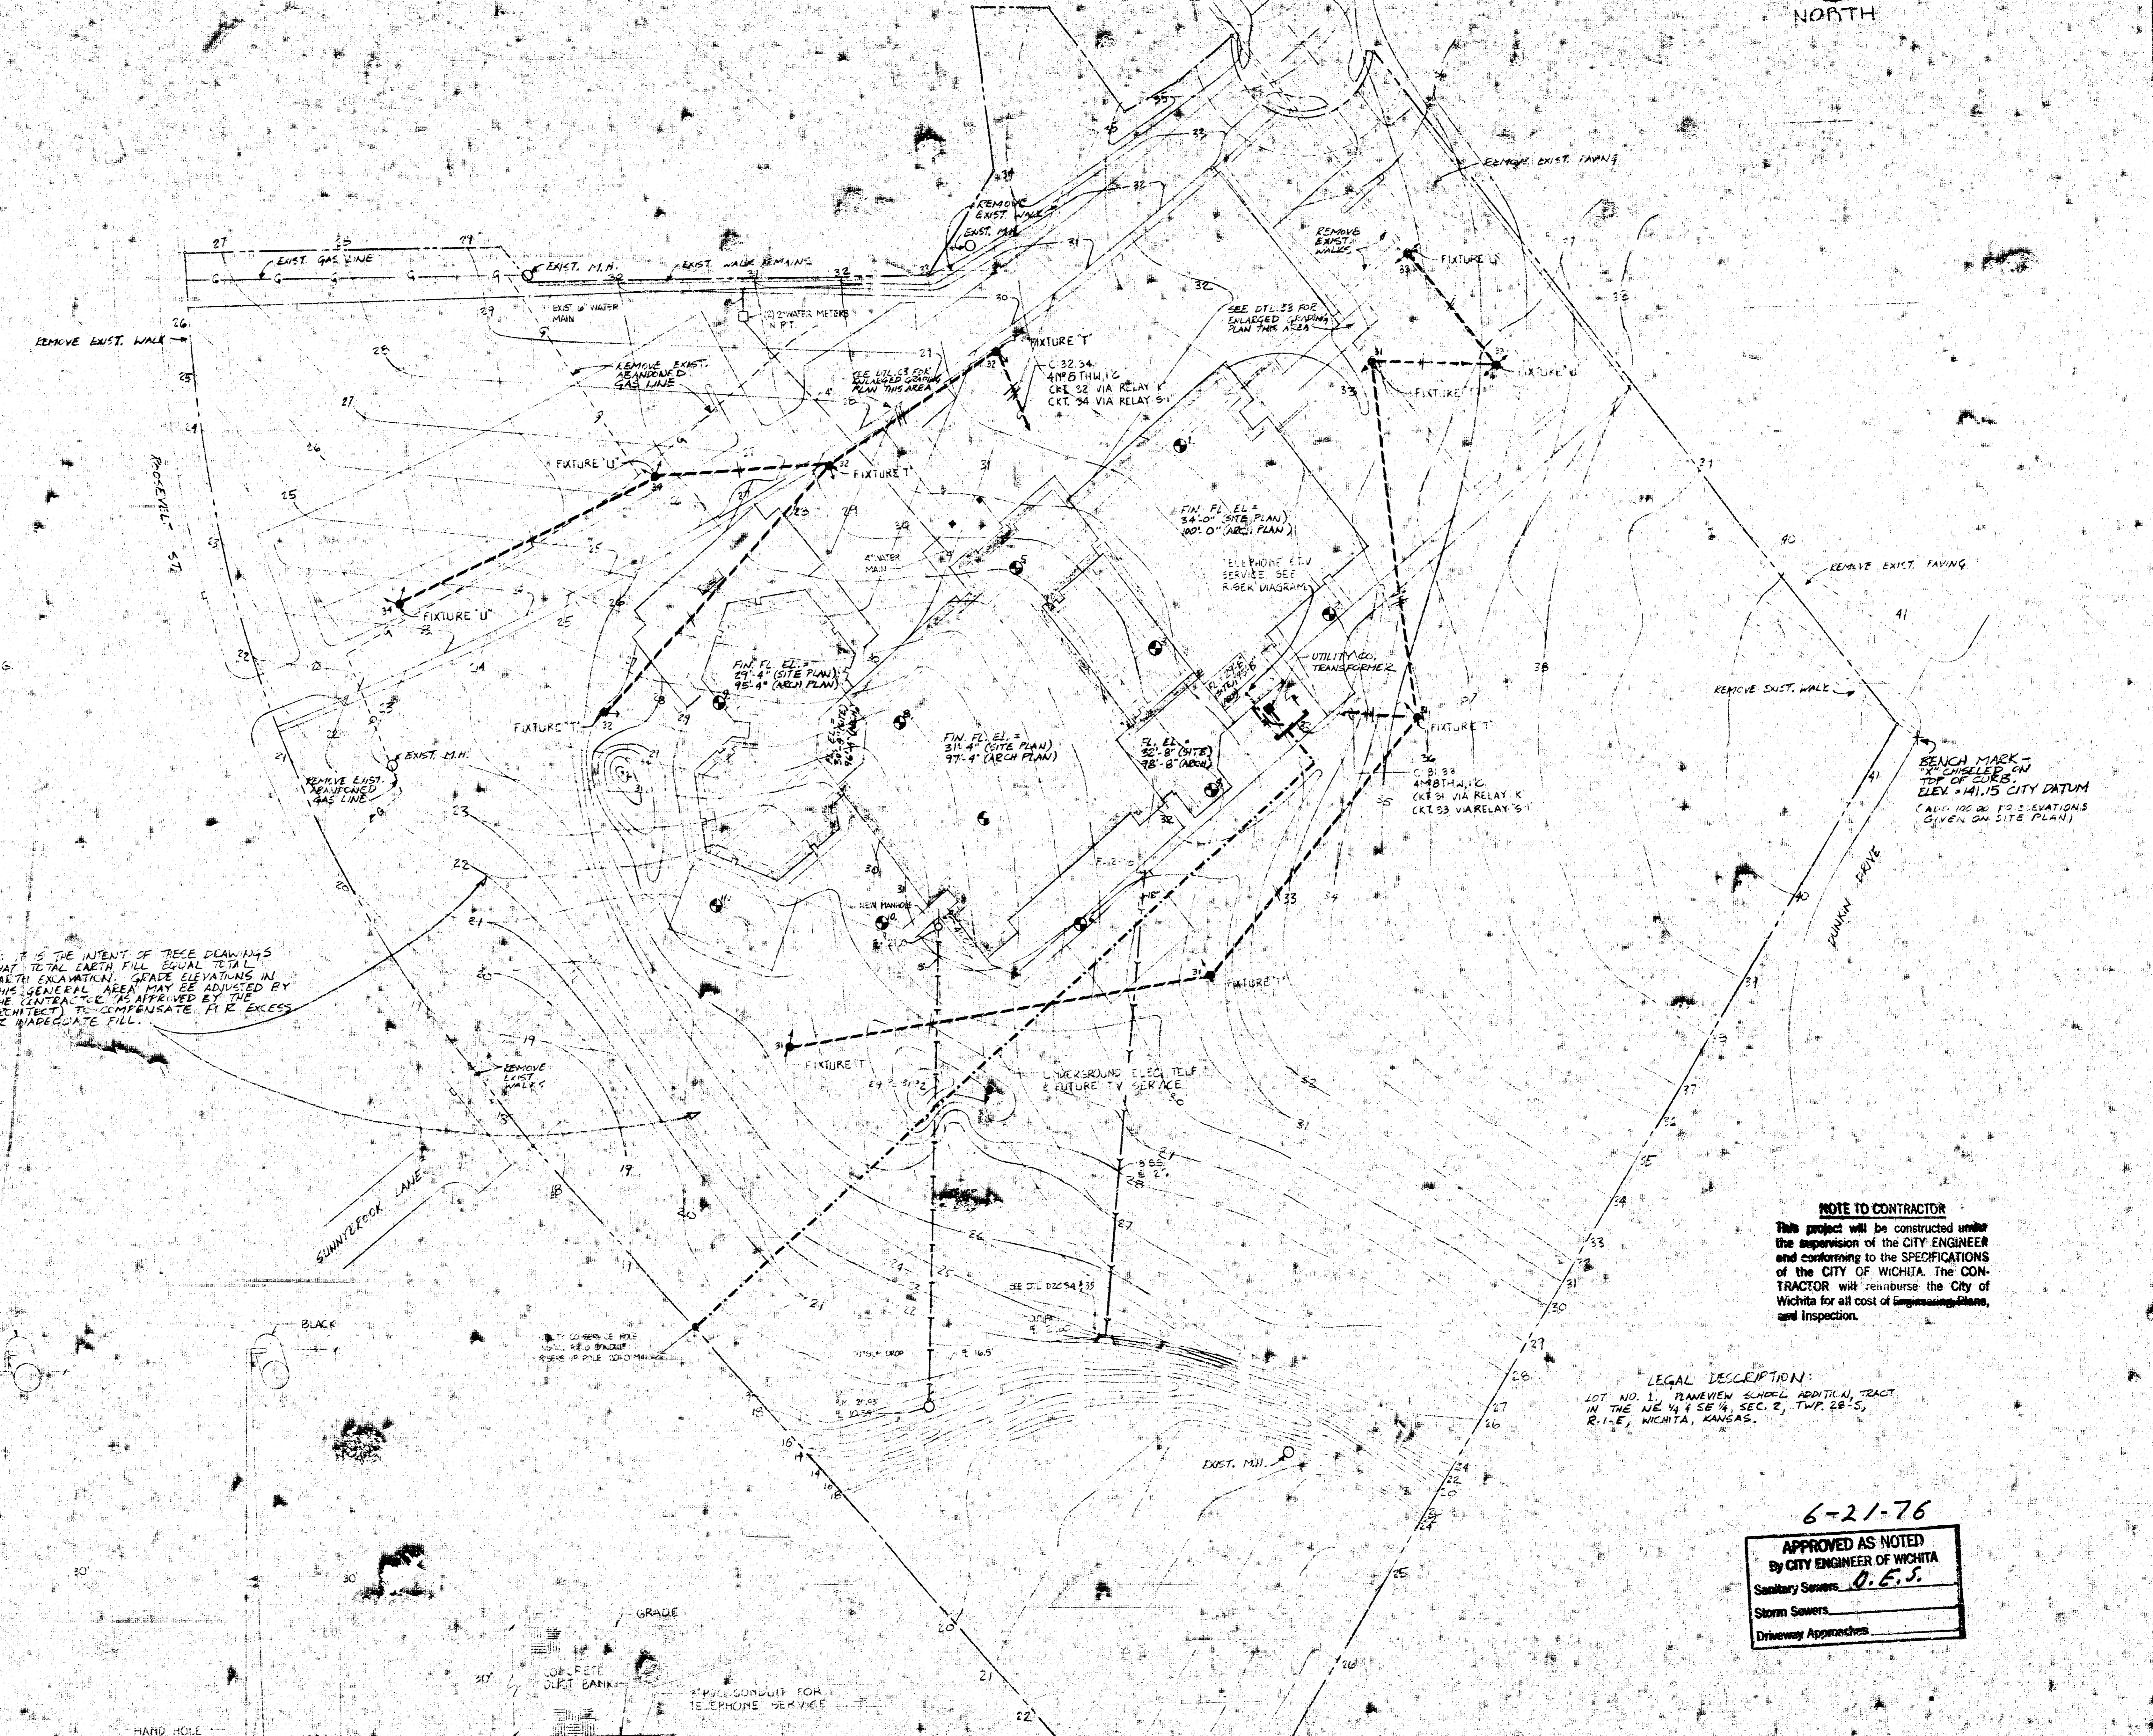

NOTE TO CONTRACTOR
This project will be constructed under the supervision of the CITY ENGINEER and conforming to the SPECIFICATIONS of the CITY OF WICHITA. The CONTRACTOR will reimburse the City of Wichita for all cost of Engineering, Plans, and Inspection.

LEGAL DESCRIPTION:
LOT NO. 1, PLANEVIEW SCHOOL ADDITIONAL TRACT IN THE NE 1/4 & SE 1/4, SEC. 2, TWP. 28-S, R. 1-E, WICHITA, KANSAS.

6-21-76
APPROVED AS NOTED
By CITY ENGINEER OF WICHITA
Sanitary Sewers **O.E.S.**
Storm Sewers
Driveway Approaches

A SITE GRADING & UTILITIES

NOTE: SEE PLAN A3 FOR SPOT ELEVATIONS ON PAVING WALKS AND GRADE AT BUILDING CORNERS.

by Flood Control

PLANEVIEW ELEMENTARY SCHOOL AND COMMUNITY SERVICE CENTER