



2

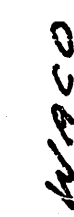


FAIRVIEW

D. Krog
R. Loomis

9-277

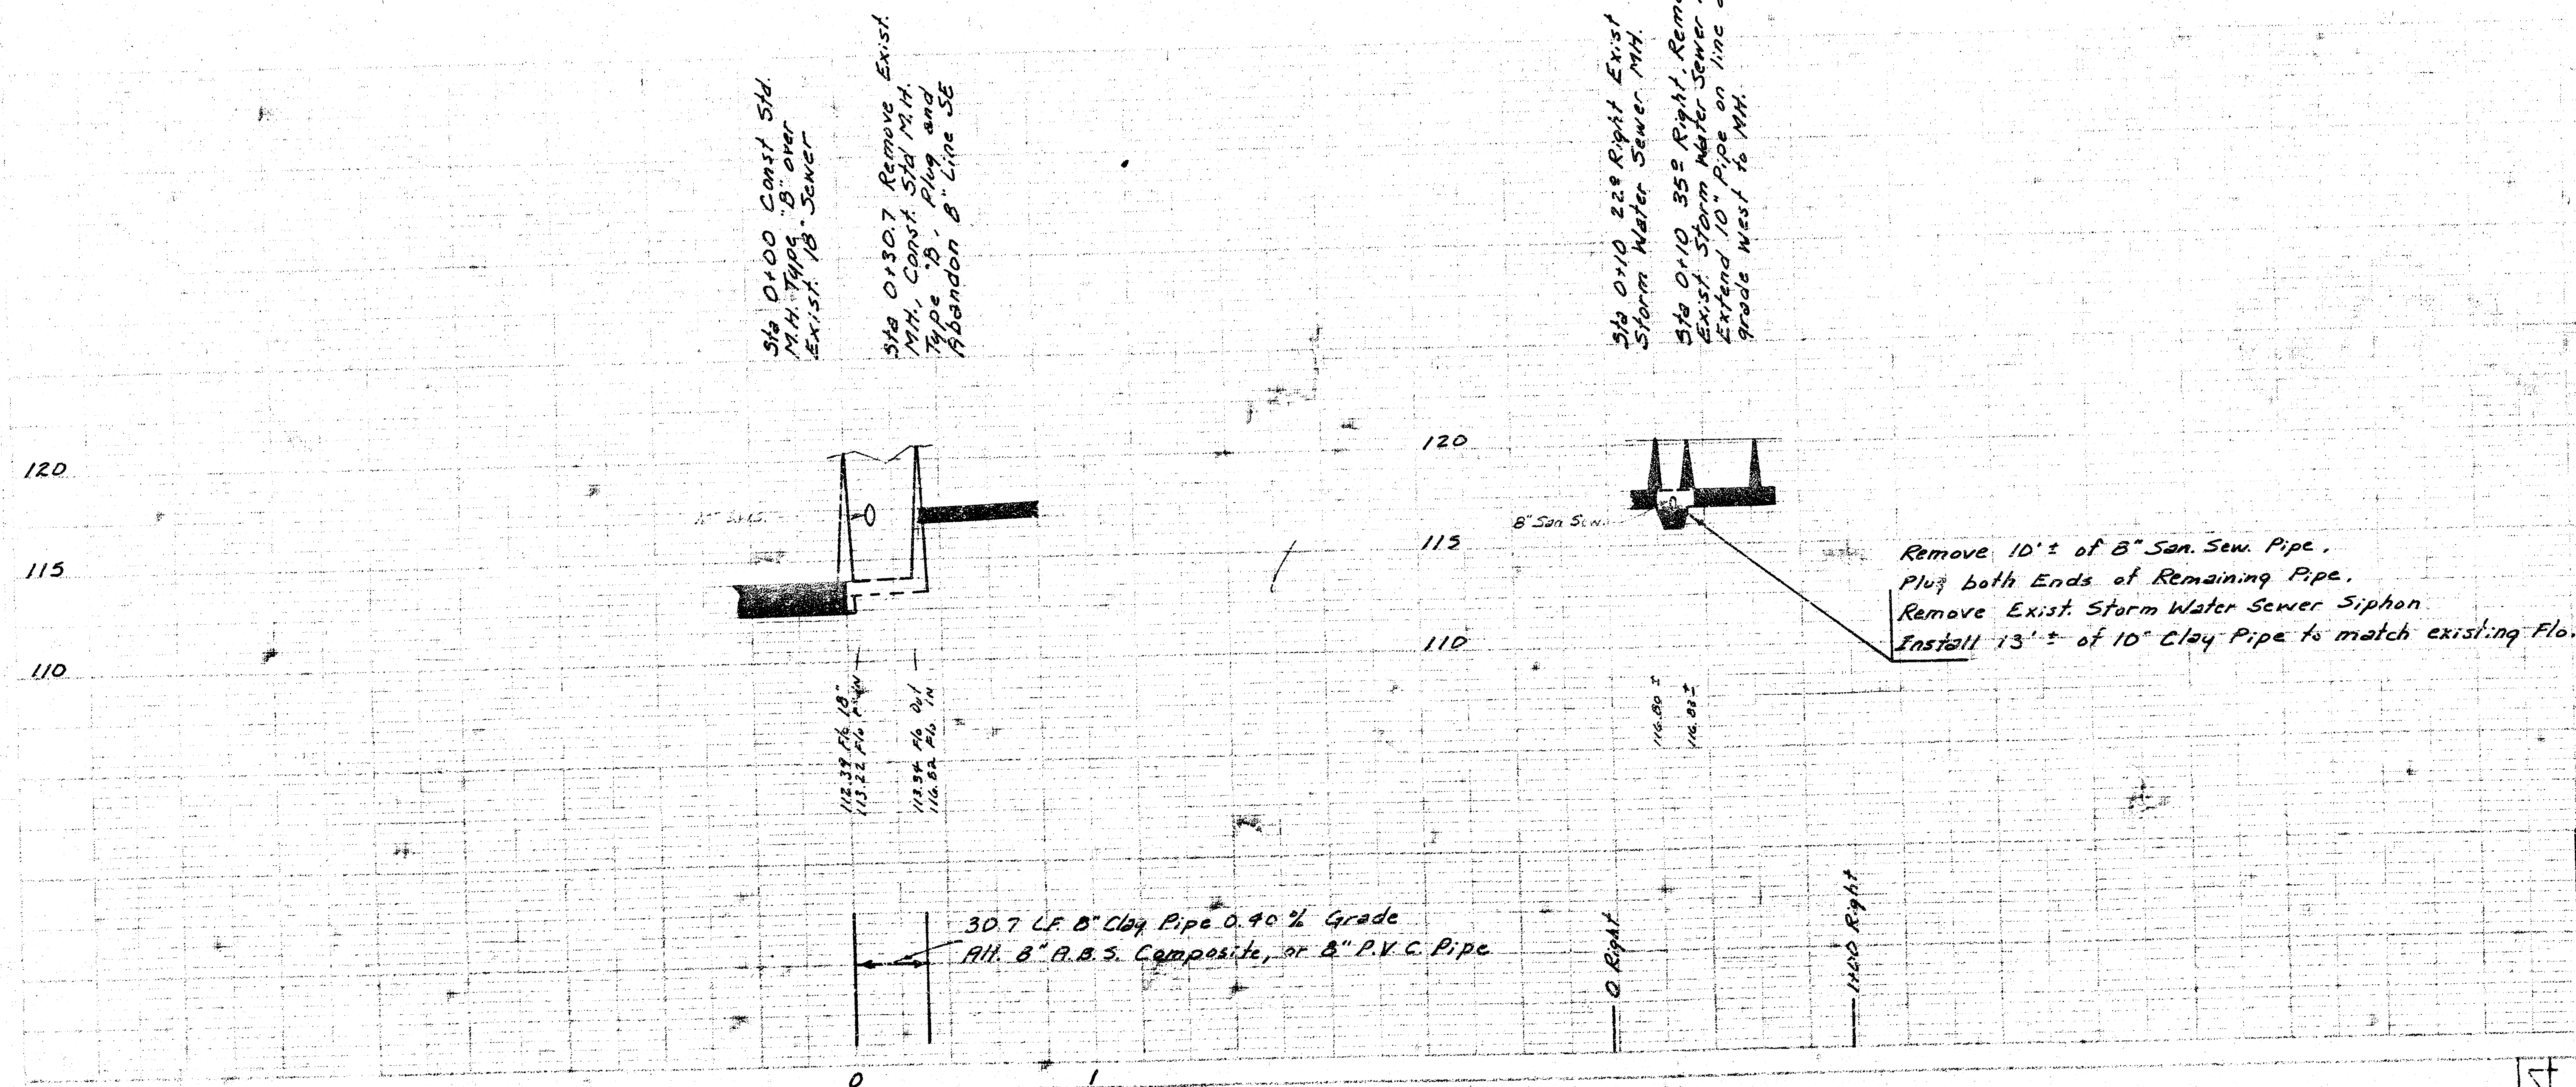

As Built
8/81

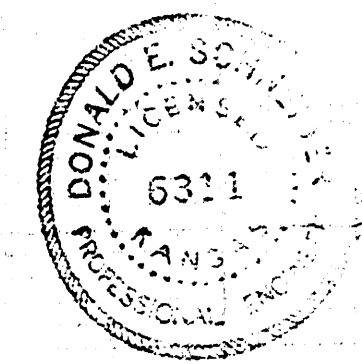

RECONSTRUCTION OF A PORTION OF S.S. #1
BETWEEN WACO AND FAIRVIEW AT 15TH ST. NO.
CITY OF WICHITA, KANSAS
R.W. BRUGGEMAN
DIRECTOR OF ENGINEERING - CITY ENGINEER
PROJ. NO. 542-80-245-80034-000-000-001

FILMED FROM THE BEST
AVAILABLE COPY