



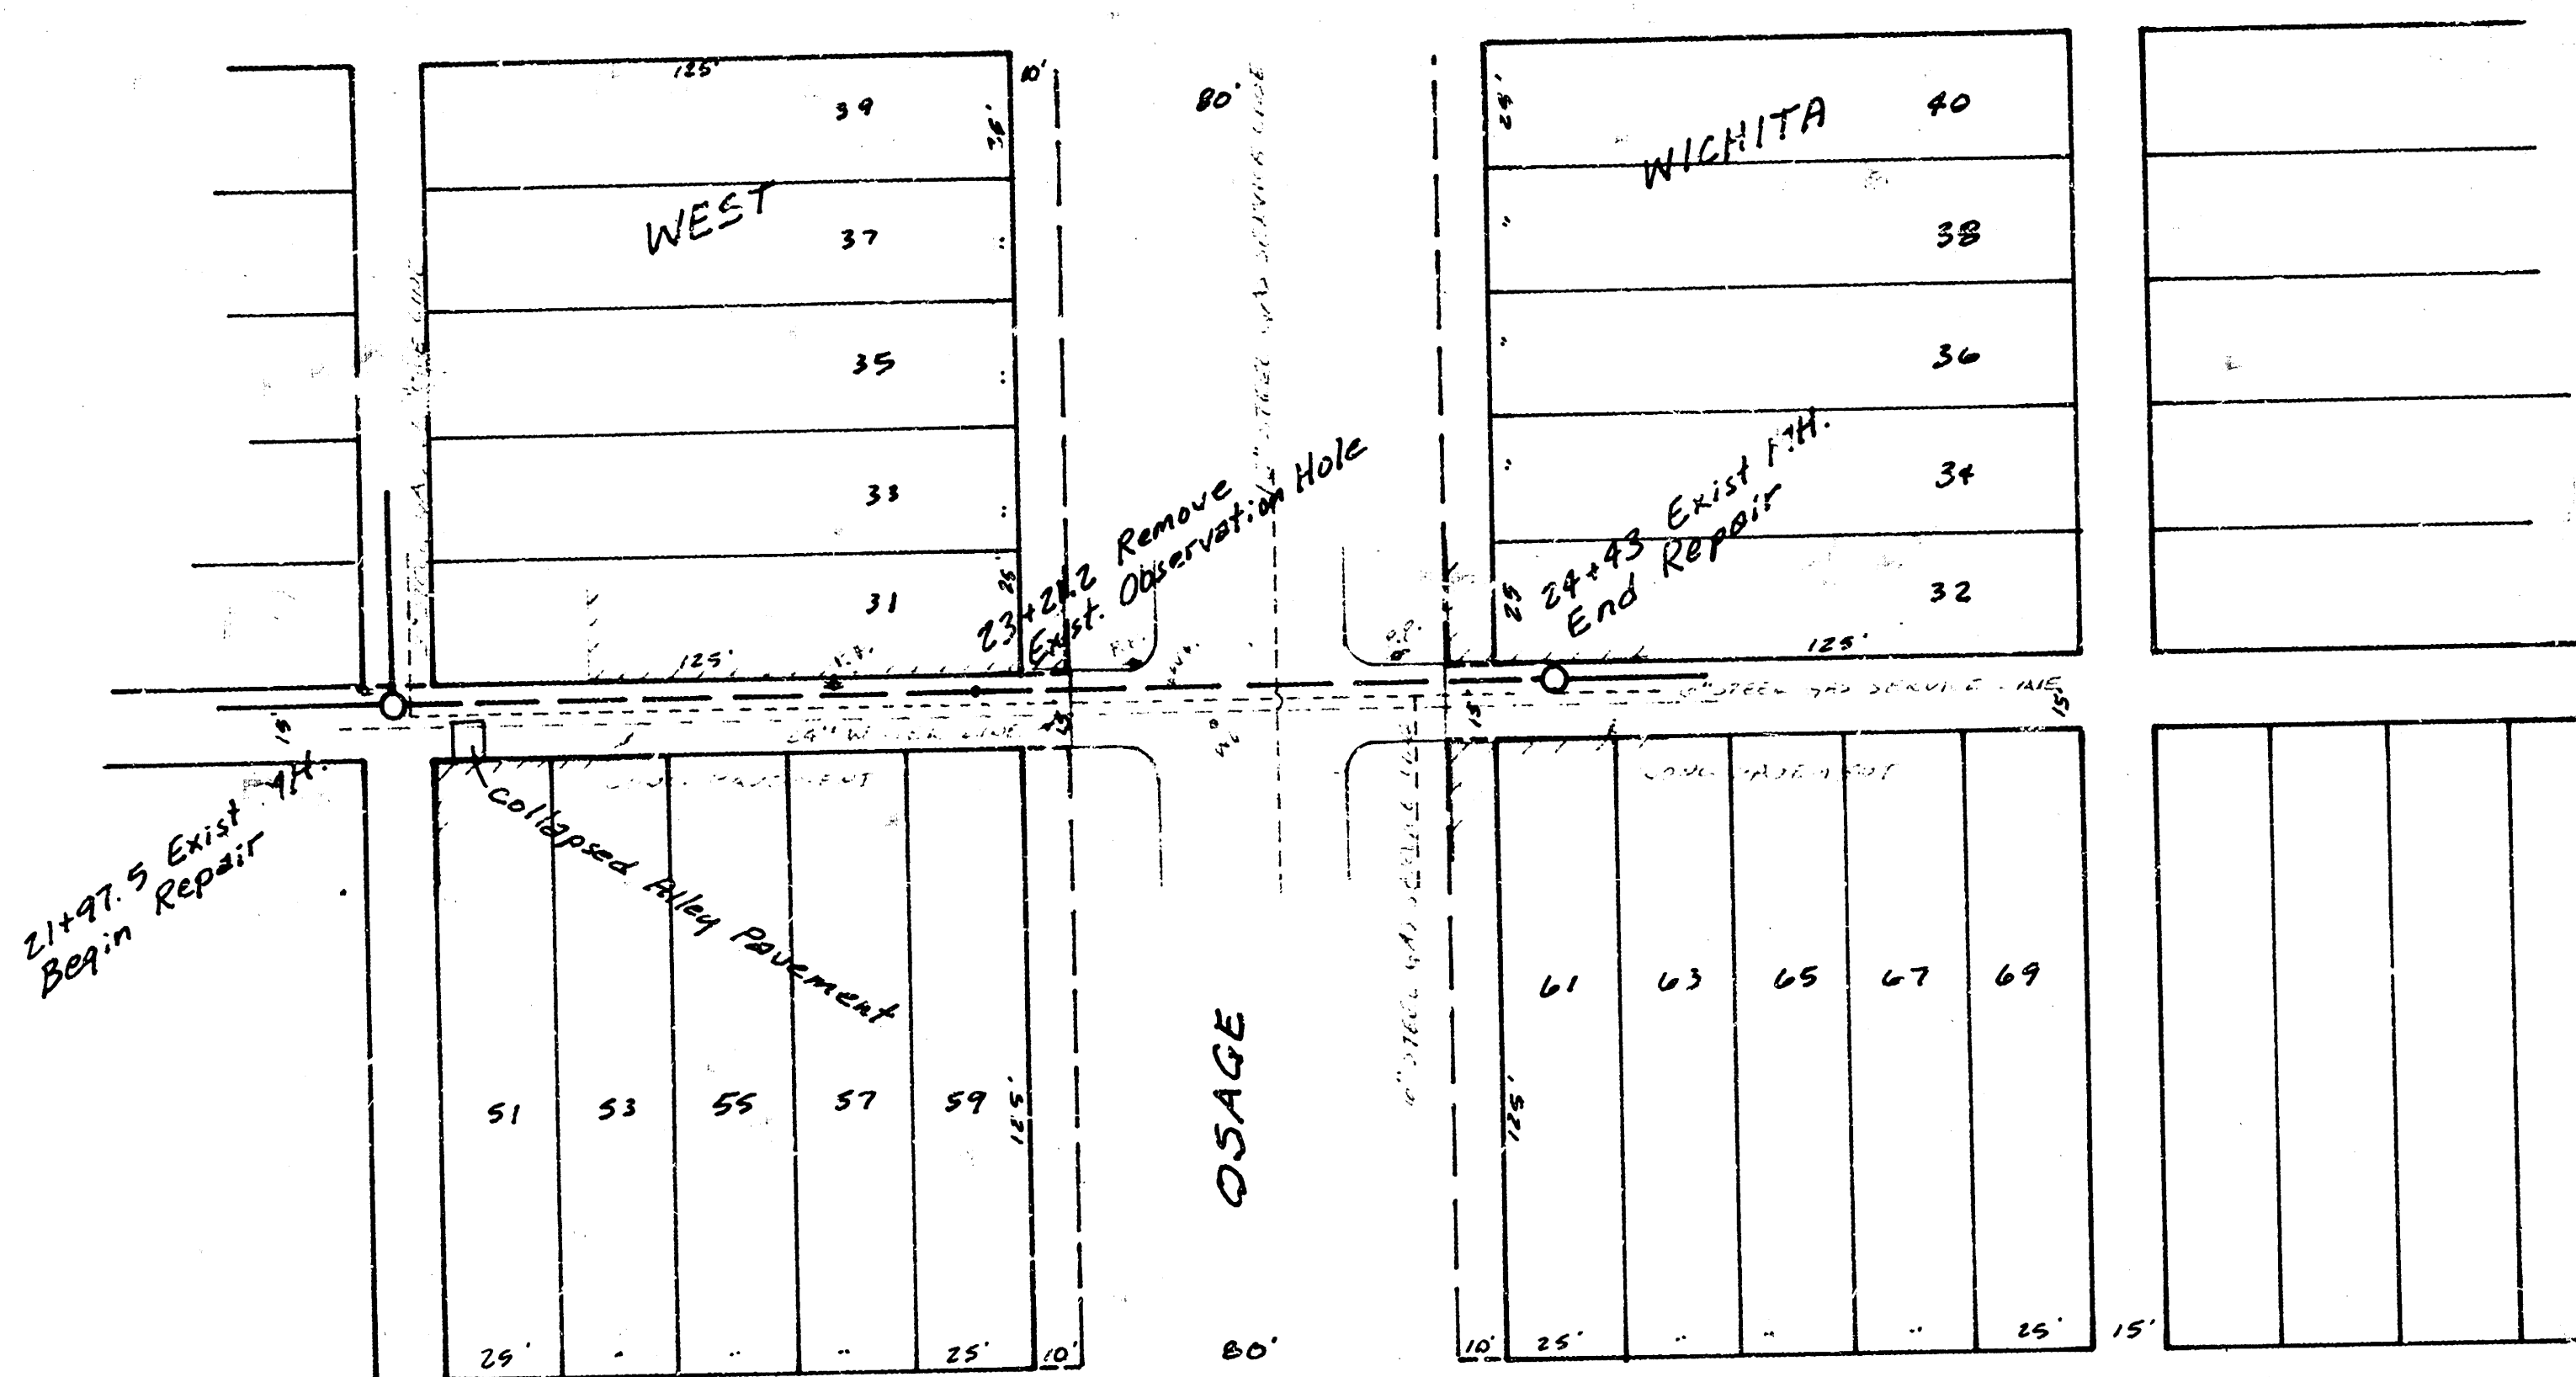

Scale Plan 1" = 40'
Profile 1" = 40' Horiz.
1" = 5' Vert.

B.M. 114.077 EXPOSITION & MISSOURI PACIFIC R.R. TRACK.
USCGG STANDARD DISC. STAMPED B210 1934, 30.7' N.
OF CENTERLINE OF MAIN TRACK AND 10' W. OF MILE
POST #86.

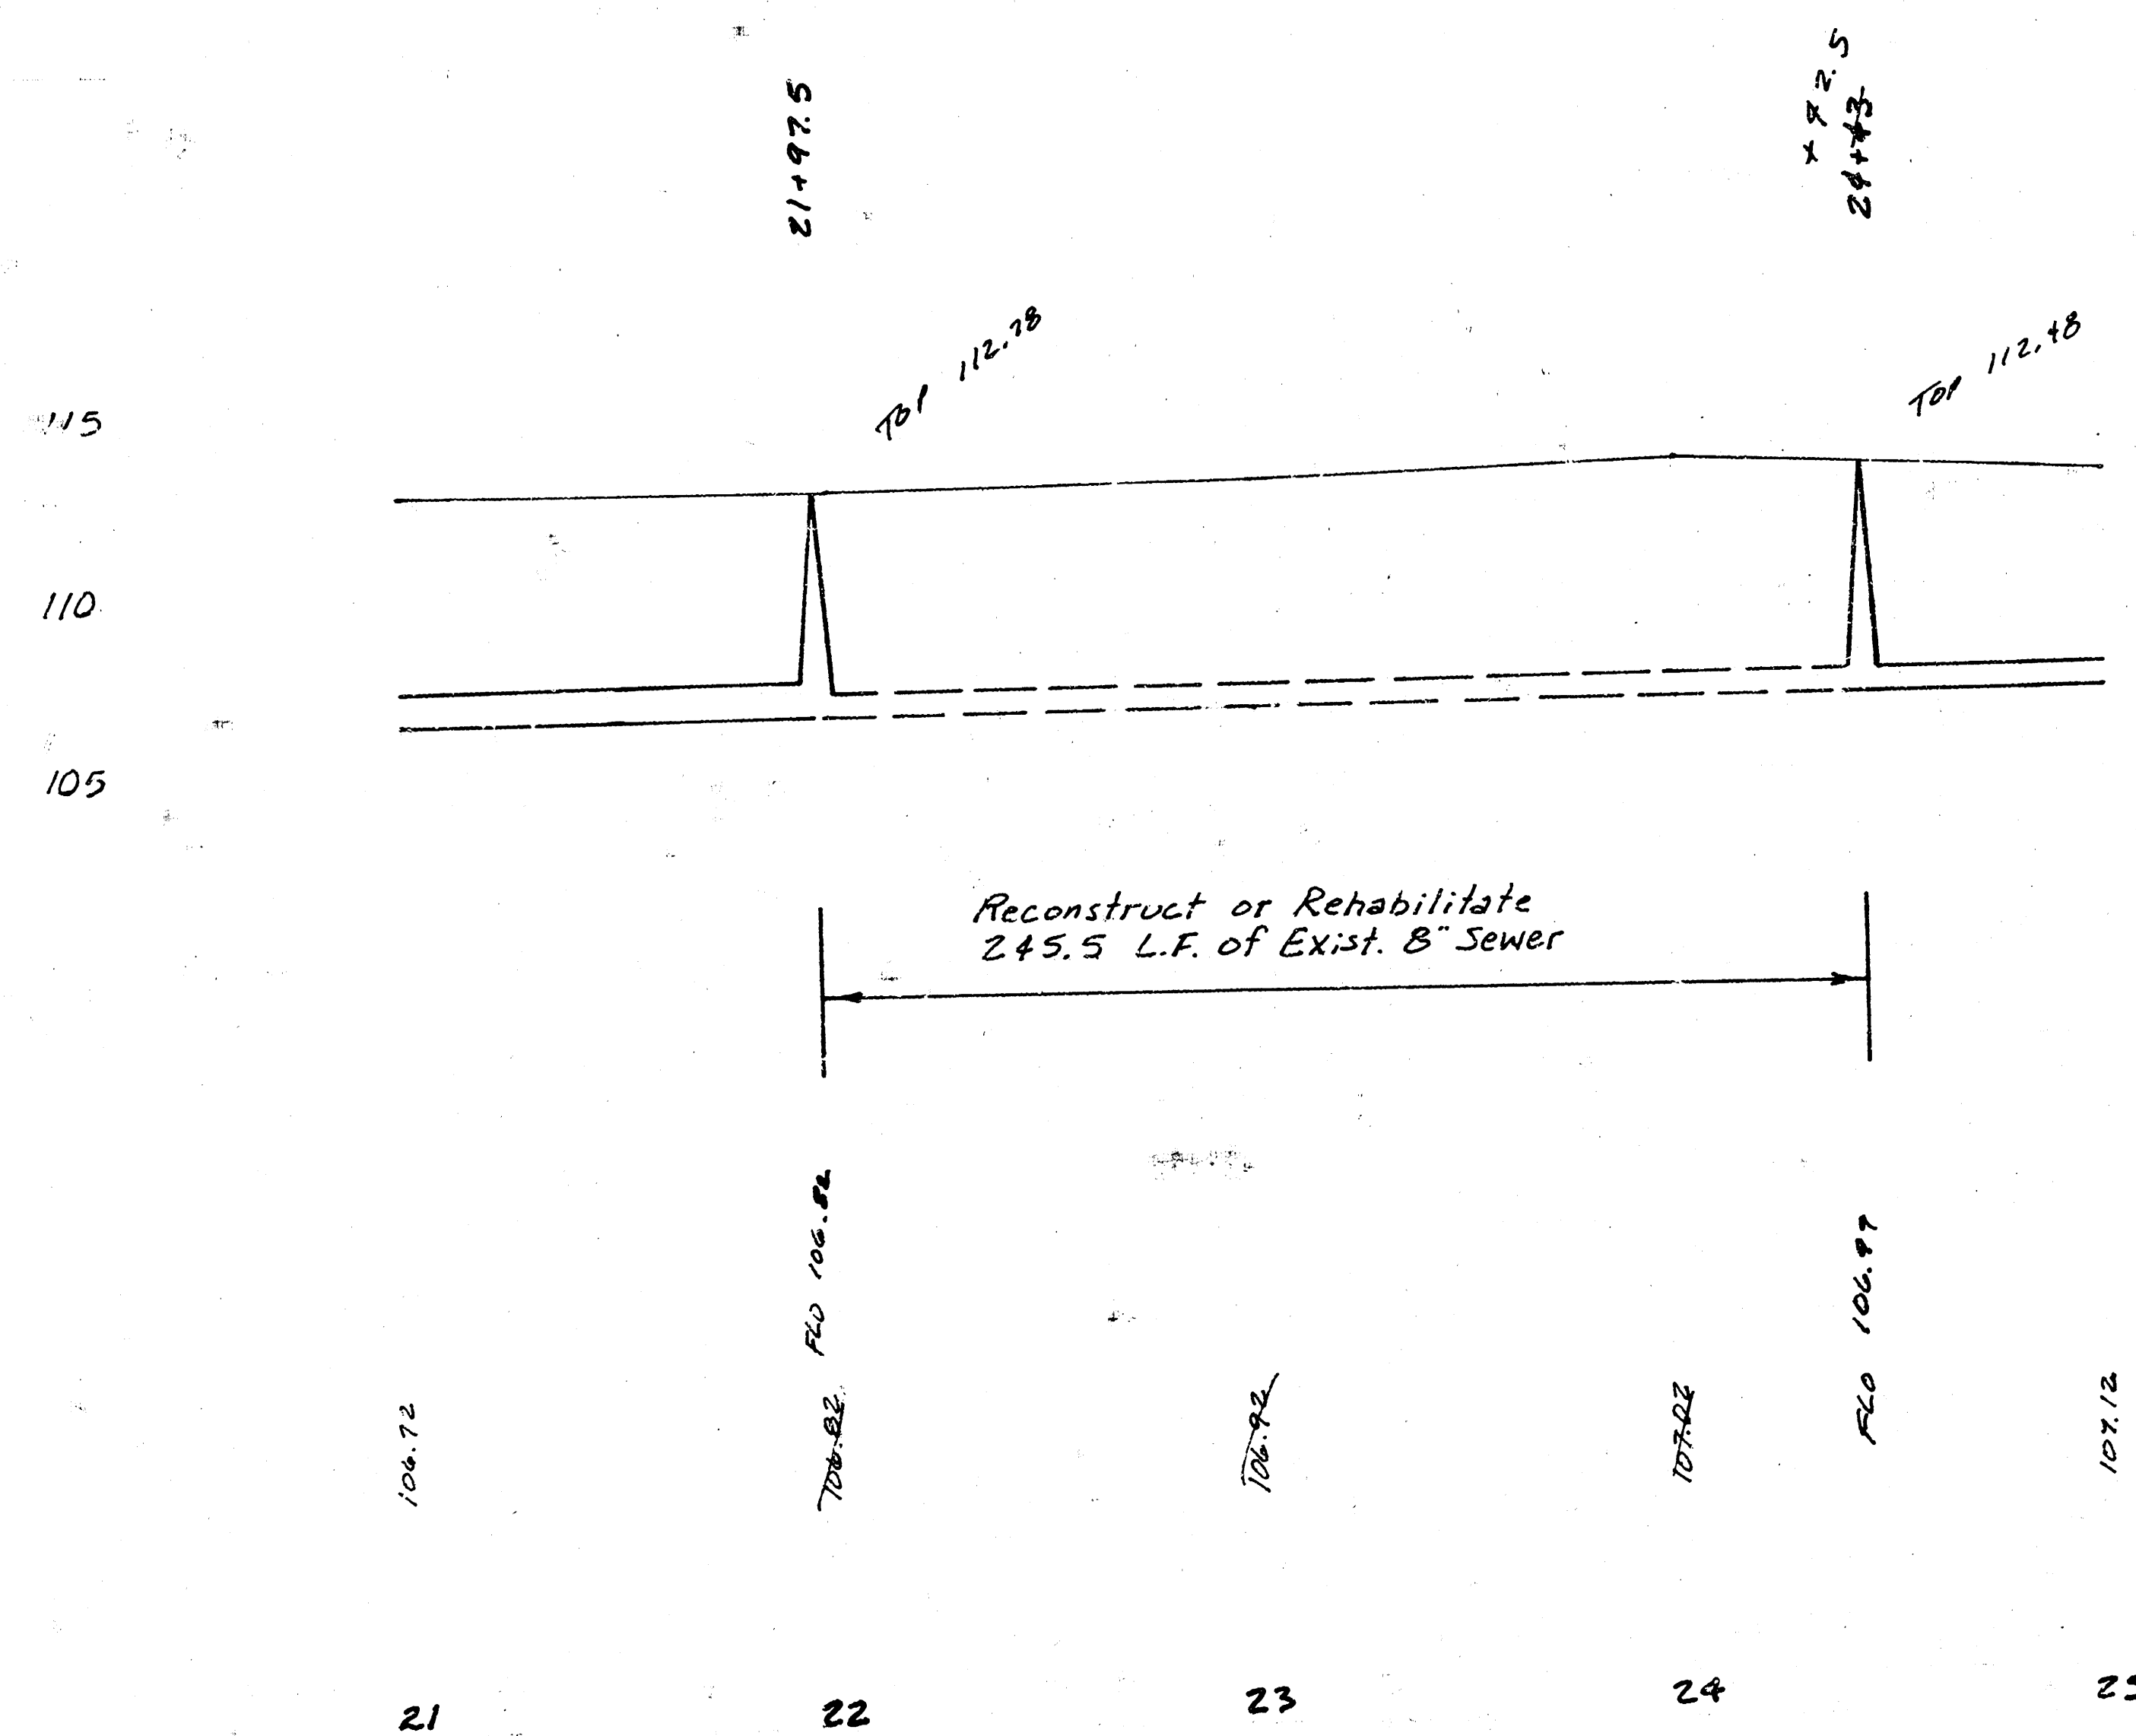

As built
R/L
6" 8"

M. E. LINDEBAK — CITY ENGINEER WICHITA, KANSAS
ALTER, REPAIR, RECONSTRUCT OR CONSTRUCT A PORTION OF SANITARY SEWER NO. 8 IN THE ALLEY NORTH OF DOUGLAS, FROM EAST OF OSAGE TO WEST OF OSAGE
PROJECT NUMBER 468-76-245-81559-000-000-001

FILMED FROM THE BEST
AVAILABLE COPY.....