



Scale Plan 1" = 40'  
 Profile 1" = 40' Horiz.  
 1" = 5' Vert.

THE CONTRACTOR SHALL BE RESPONSIBLE FOR PRESERVING PROPERTY RIGHTS. THE CONTRACTOR SHALL BE REQUIRED TO RE-ESTABLISH ANY PROPERTY RIGHTS THAT ARE DAMAGED OR DESTROYED BY HIS CONSTRUCTION OPERATIONS. SUCH RIGHTS SHALL BE RE-ESTABLISHED BY A LICENSED SURVEYOR OR A LICENSED PROFESSIONAL ENGINEER IN ACCORDANCE WITH STATE LAWS.

B.M. 151.61 City Std. on NE Corner of RCBC at Pinecrest and E. Fork of Dry Creek.

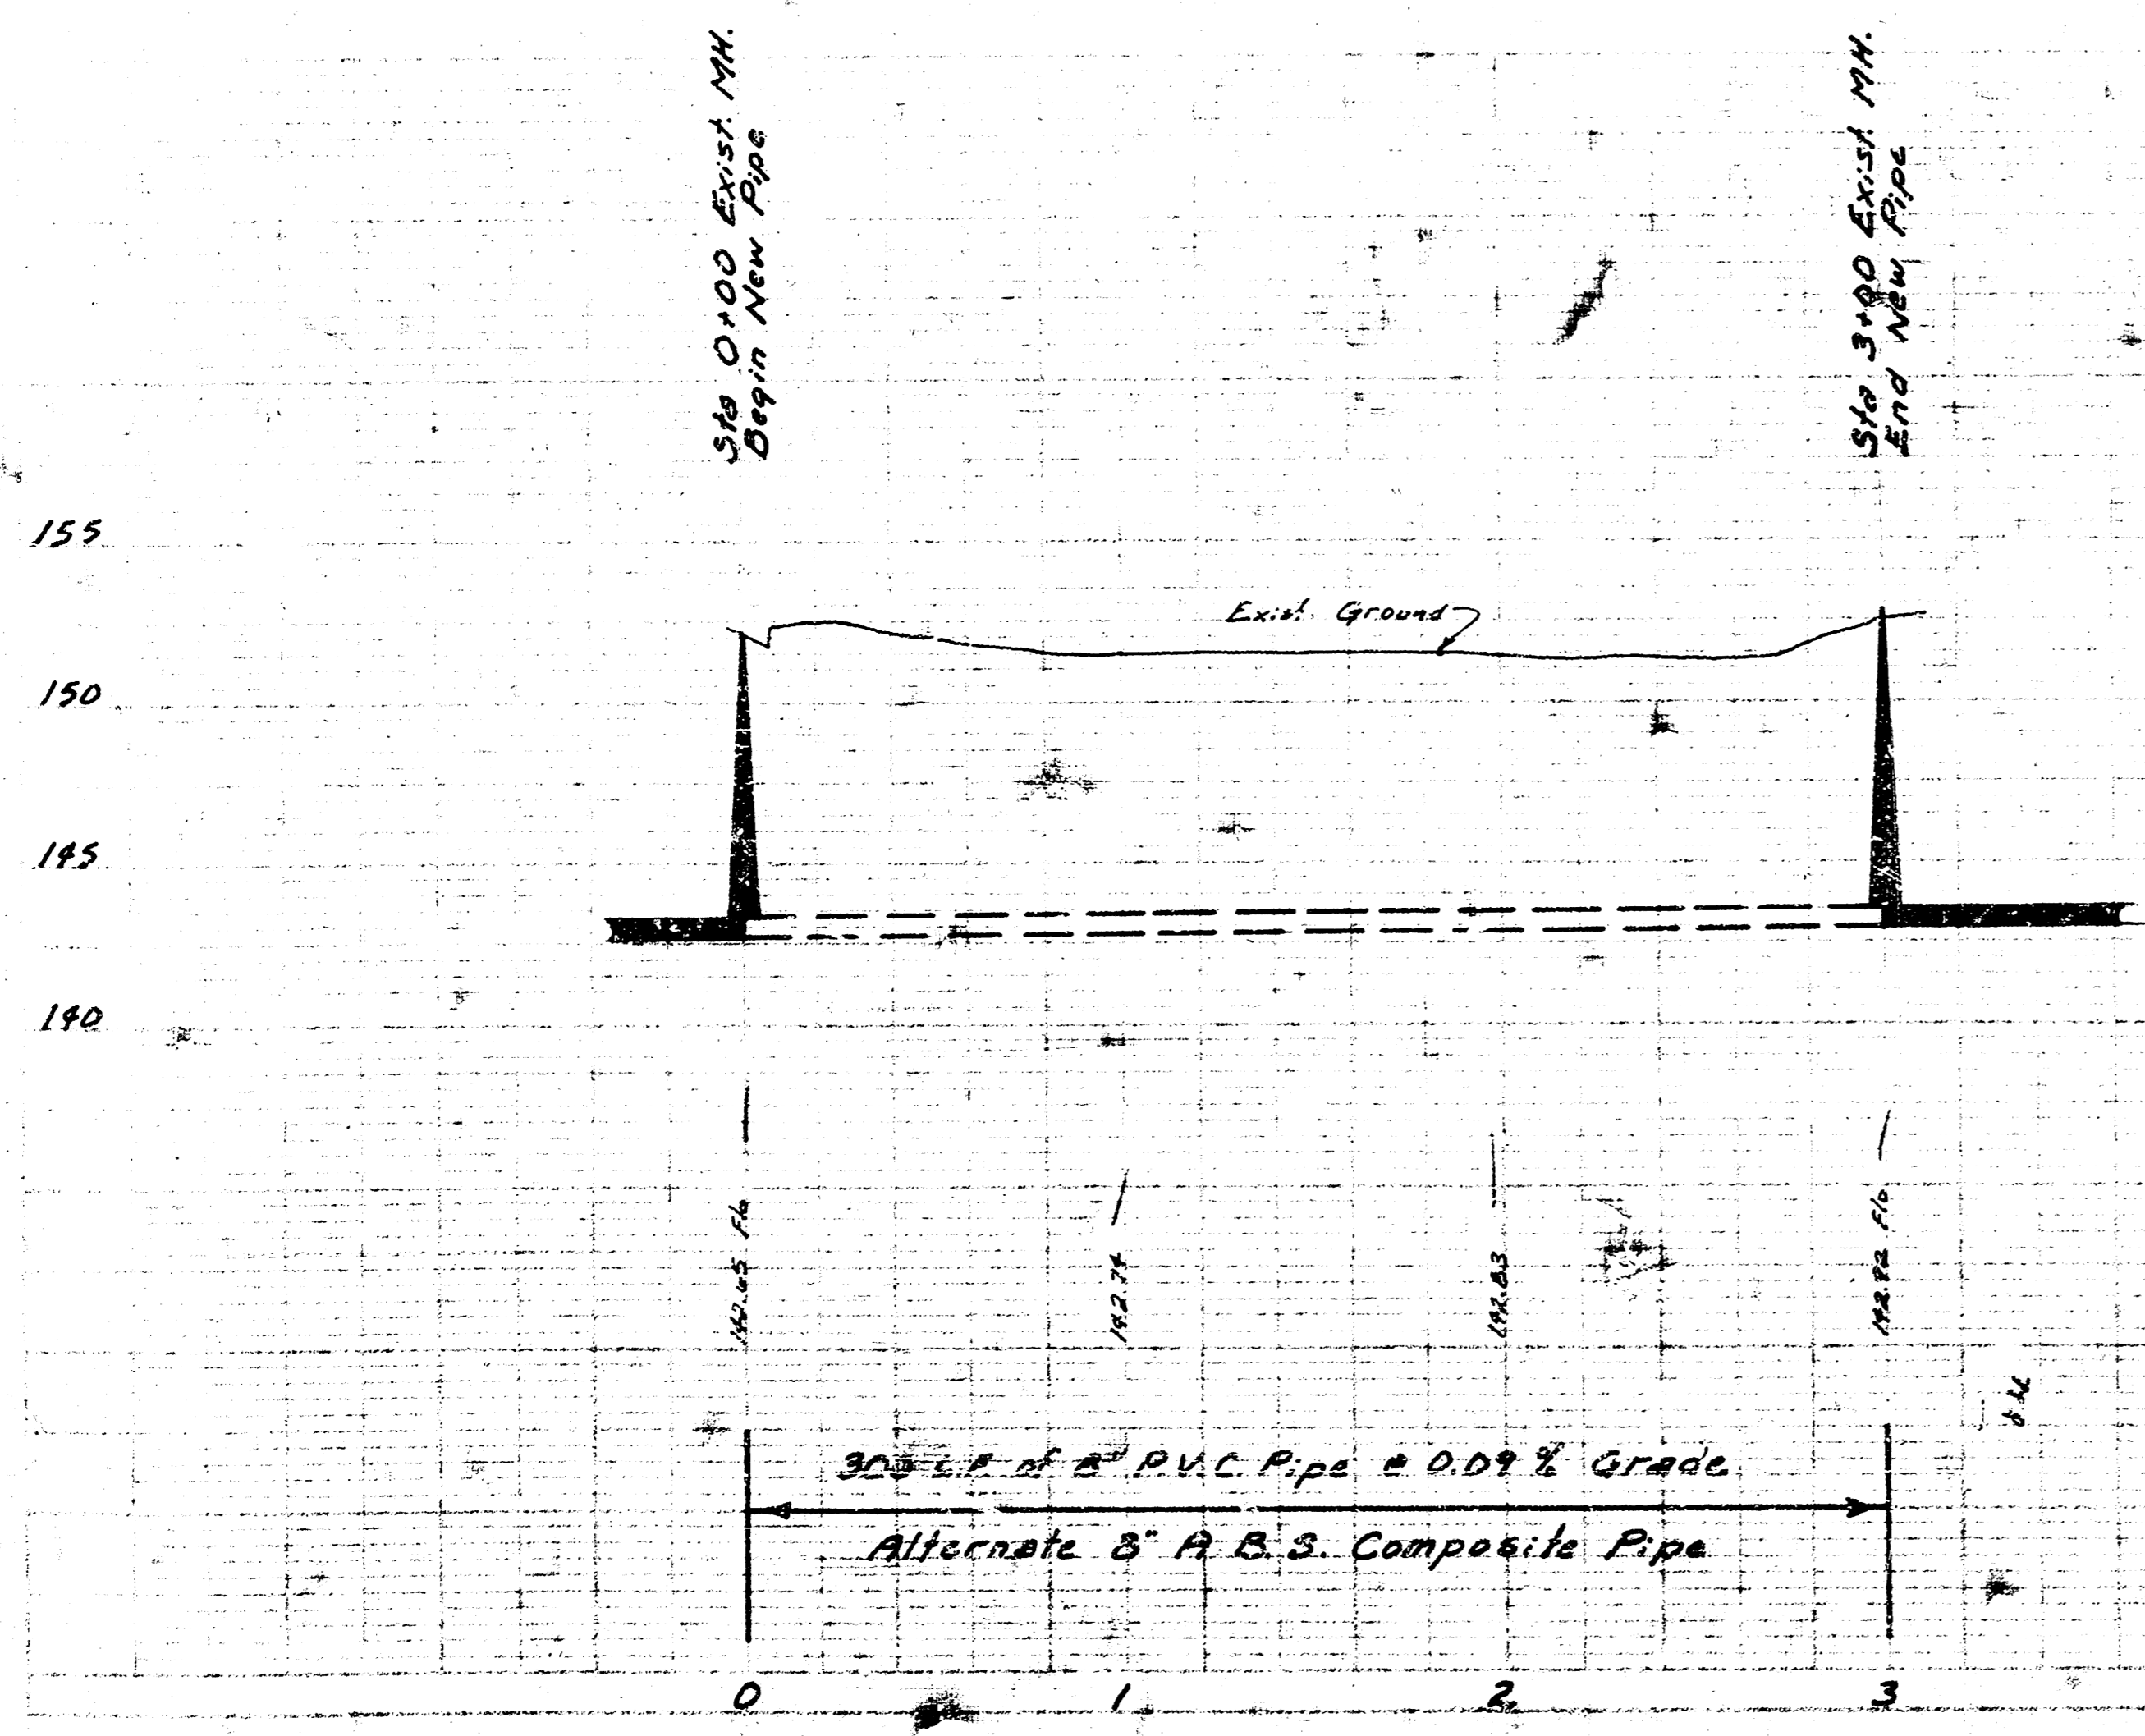

As Built  
 J & J  
 1/82

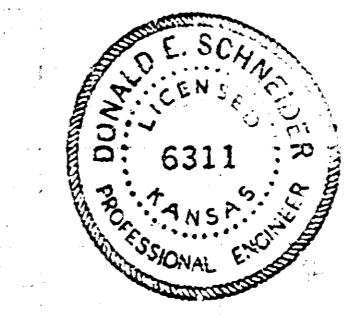

REPAIR OF A PORTION OF LAT 38, DRY-CREEK SEWER, S. S. #12 BETWEEN ELPYCO AND BLECKLEY ON THE NORTH SIDE OF ORME  
 CITY OF WICHITA, KANSAS  
 R.W. BRUGGEMAN  
 DIRECTOR OF ENGINEERING / CITY ENGINEER  
 PROJ. NO. 468-76-245-81080-000-001

FILMED FROM THE BEST