




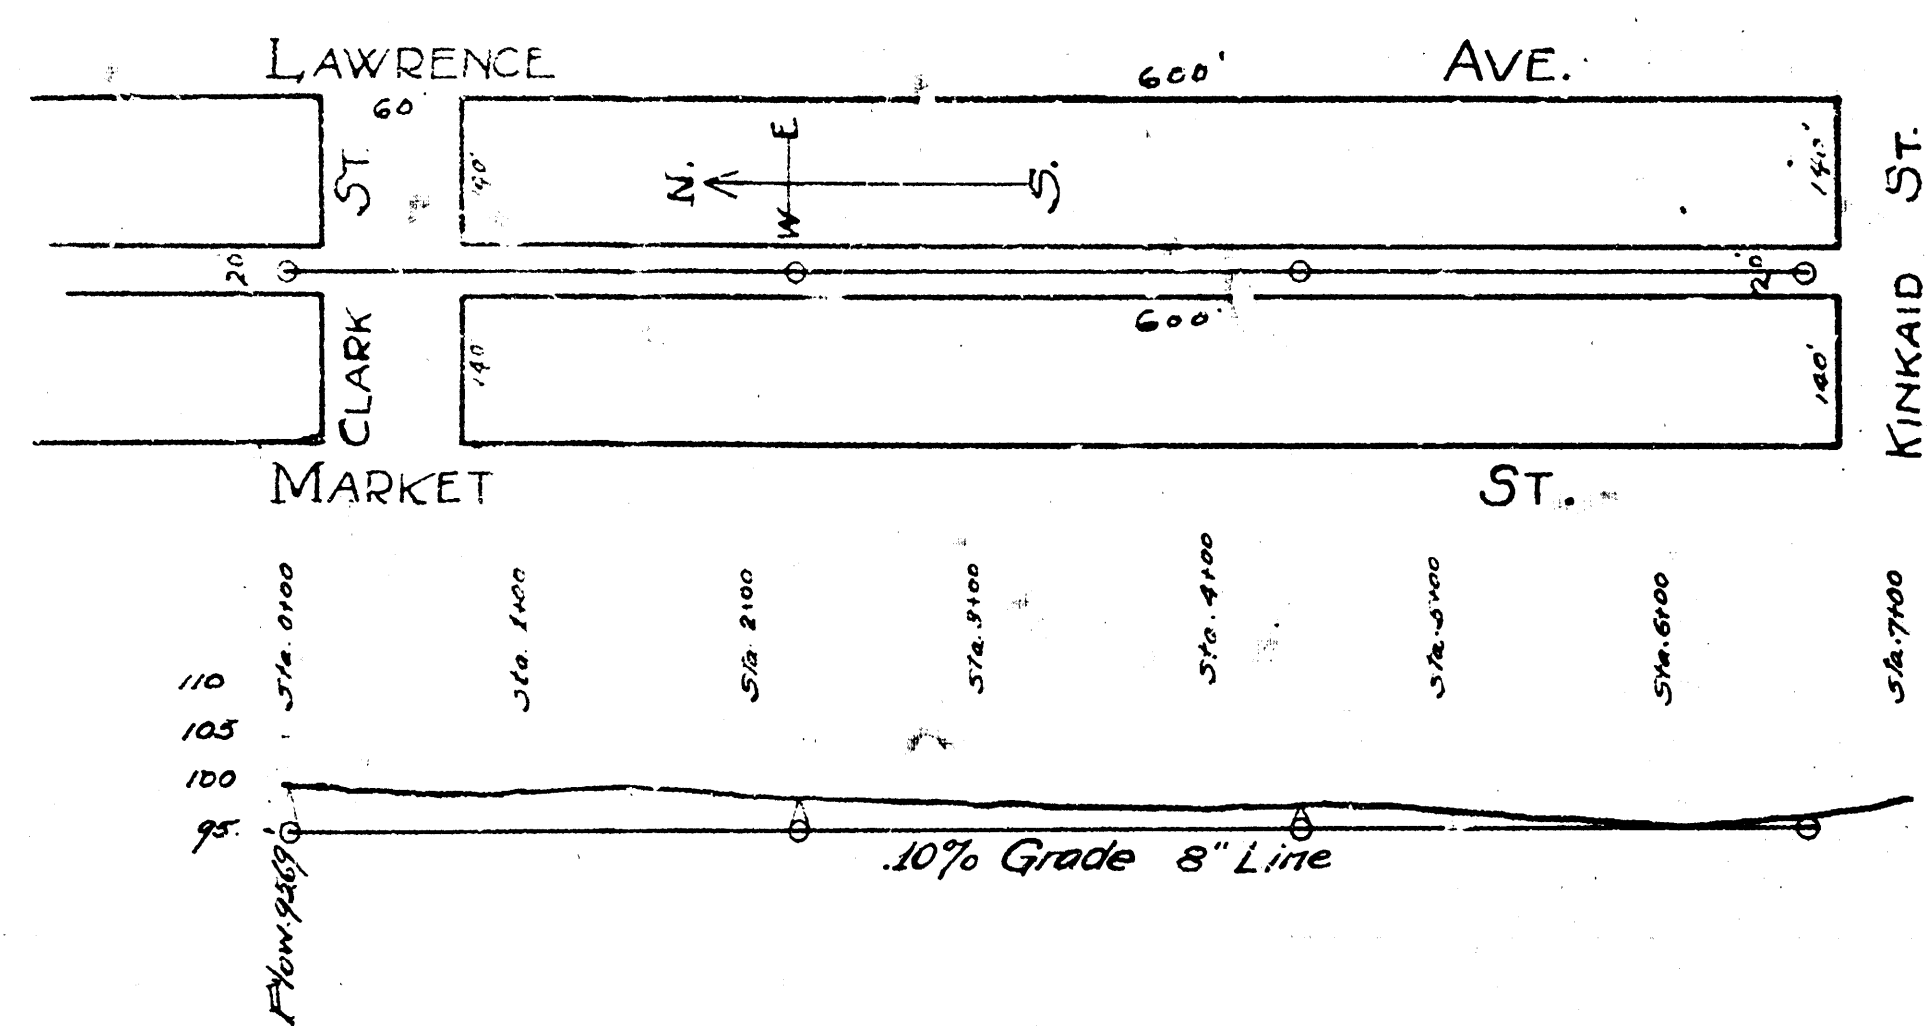


Lateral '1' District 'C'
Sanitary Sewer No. 20

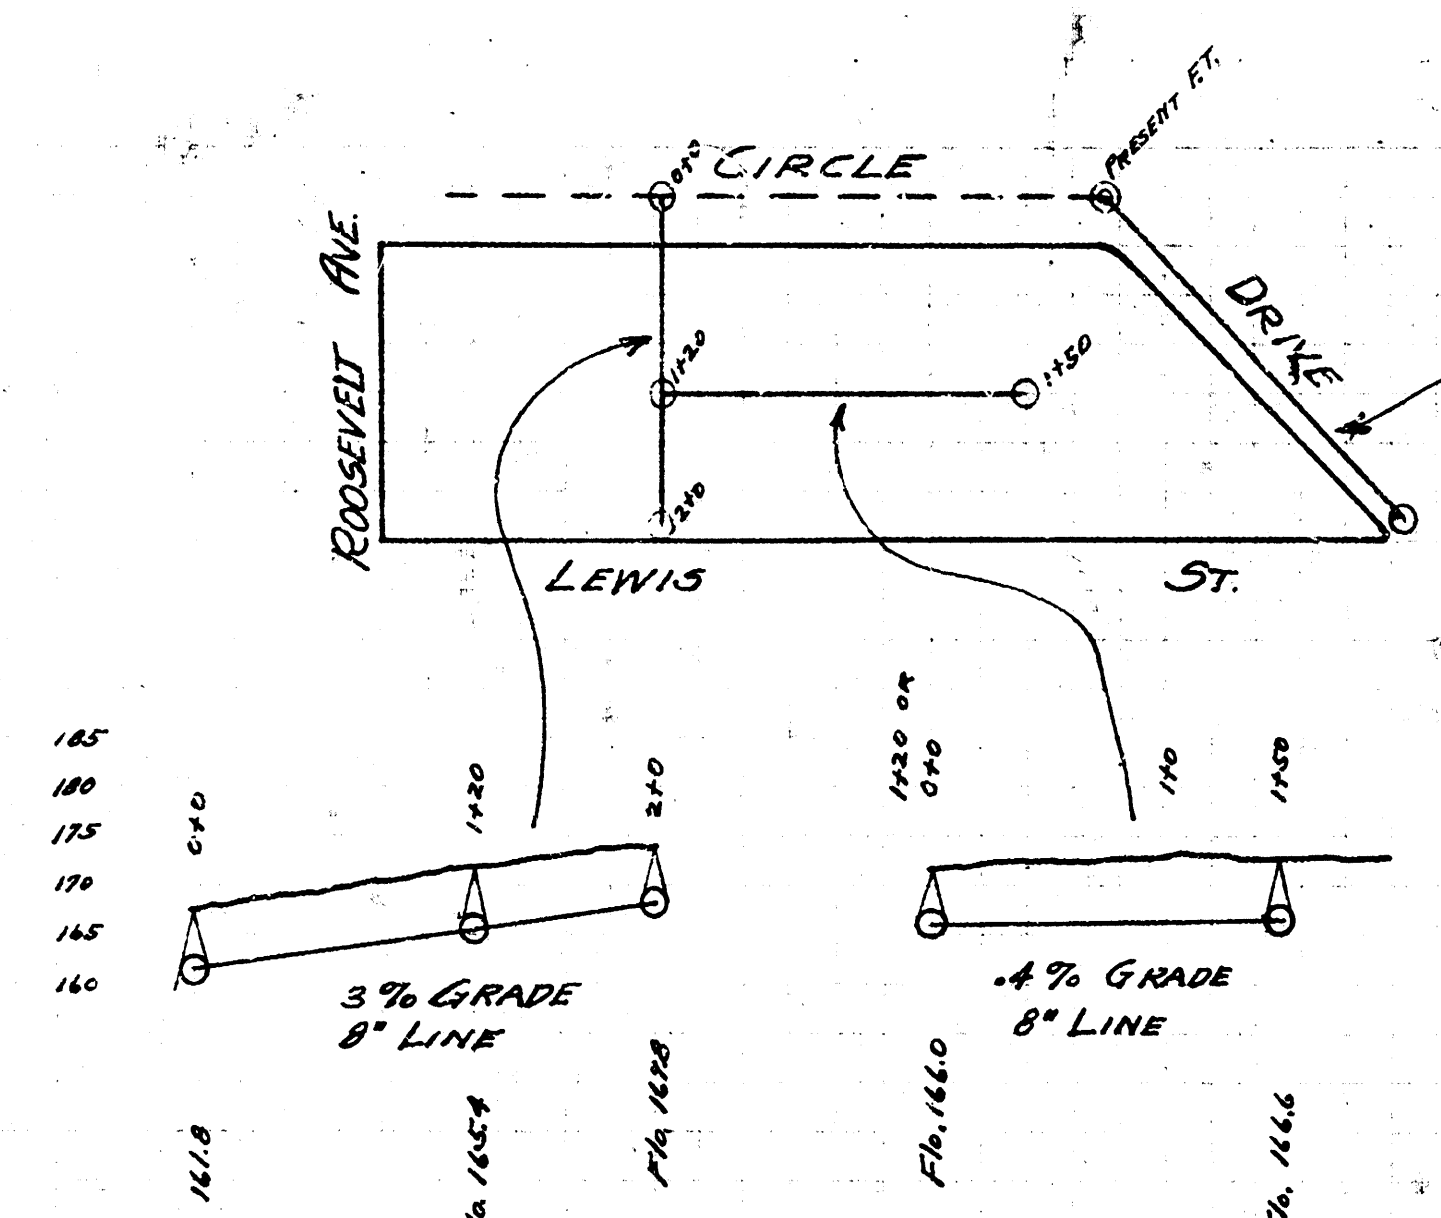

LAT. 16 - DIST. 'A'
S.S. No. 12

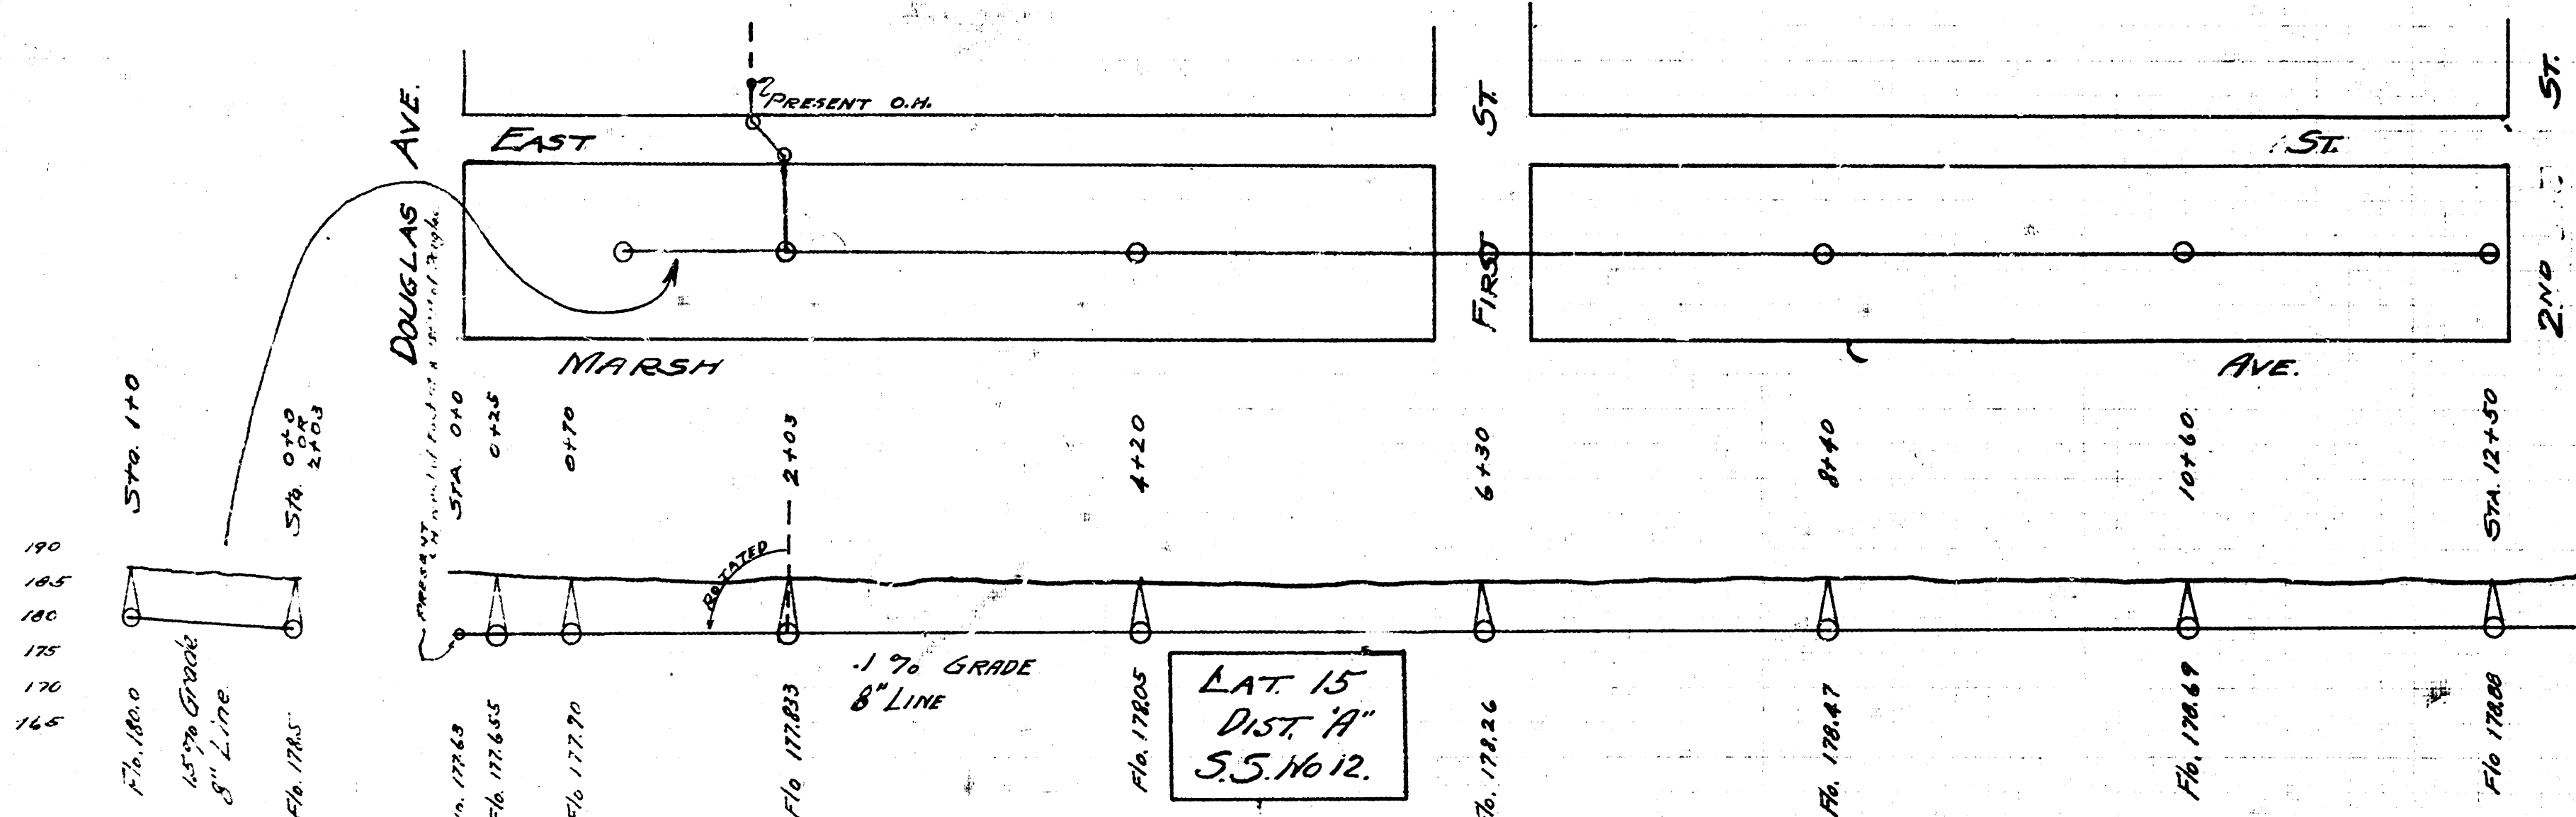


LAT. 15
DIST. 'A'
S.S. No. 12


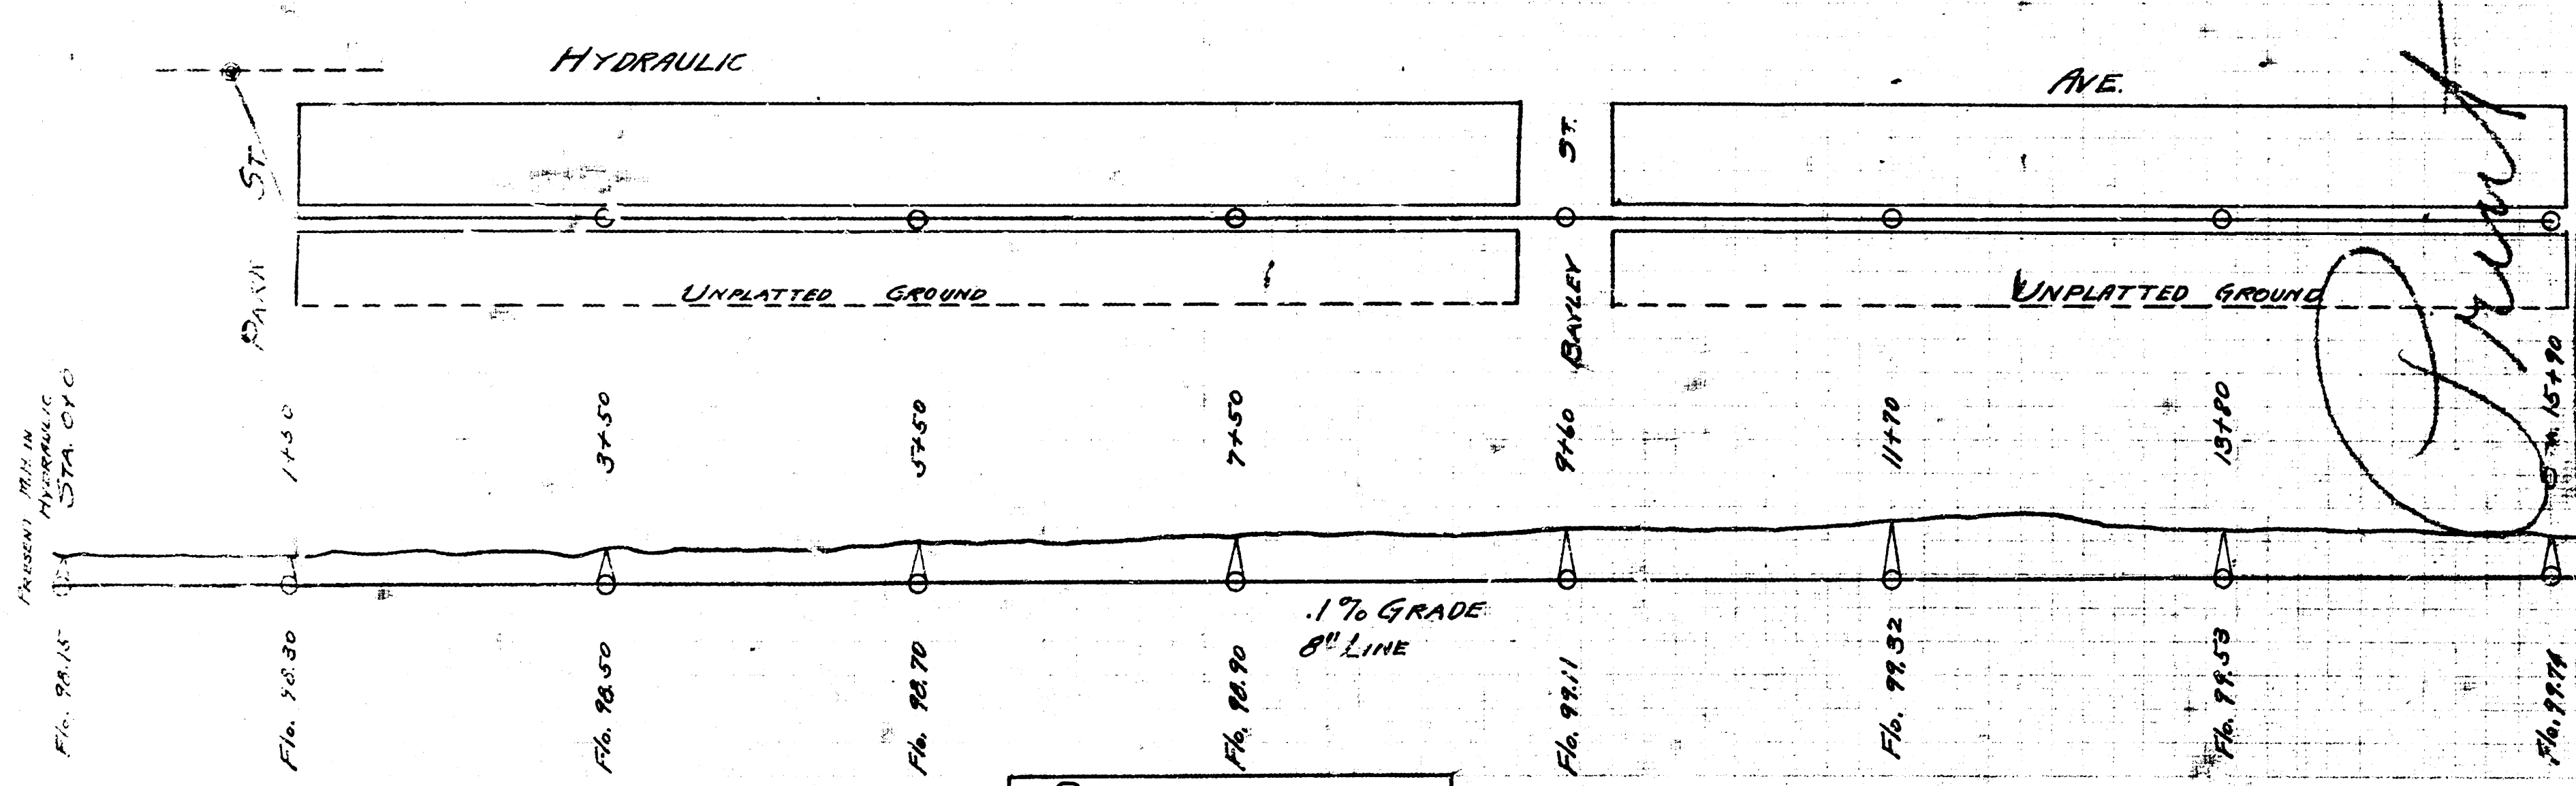


DIST. 1 S.S. No. 20

Front to right of this line only

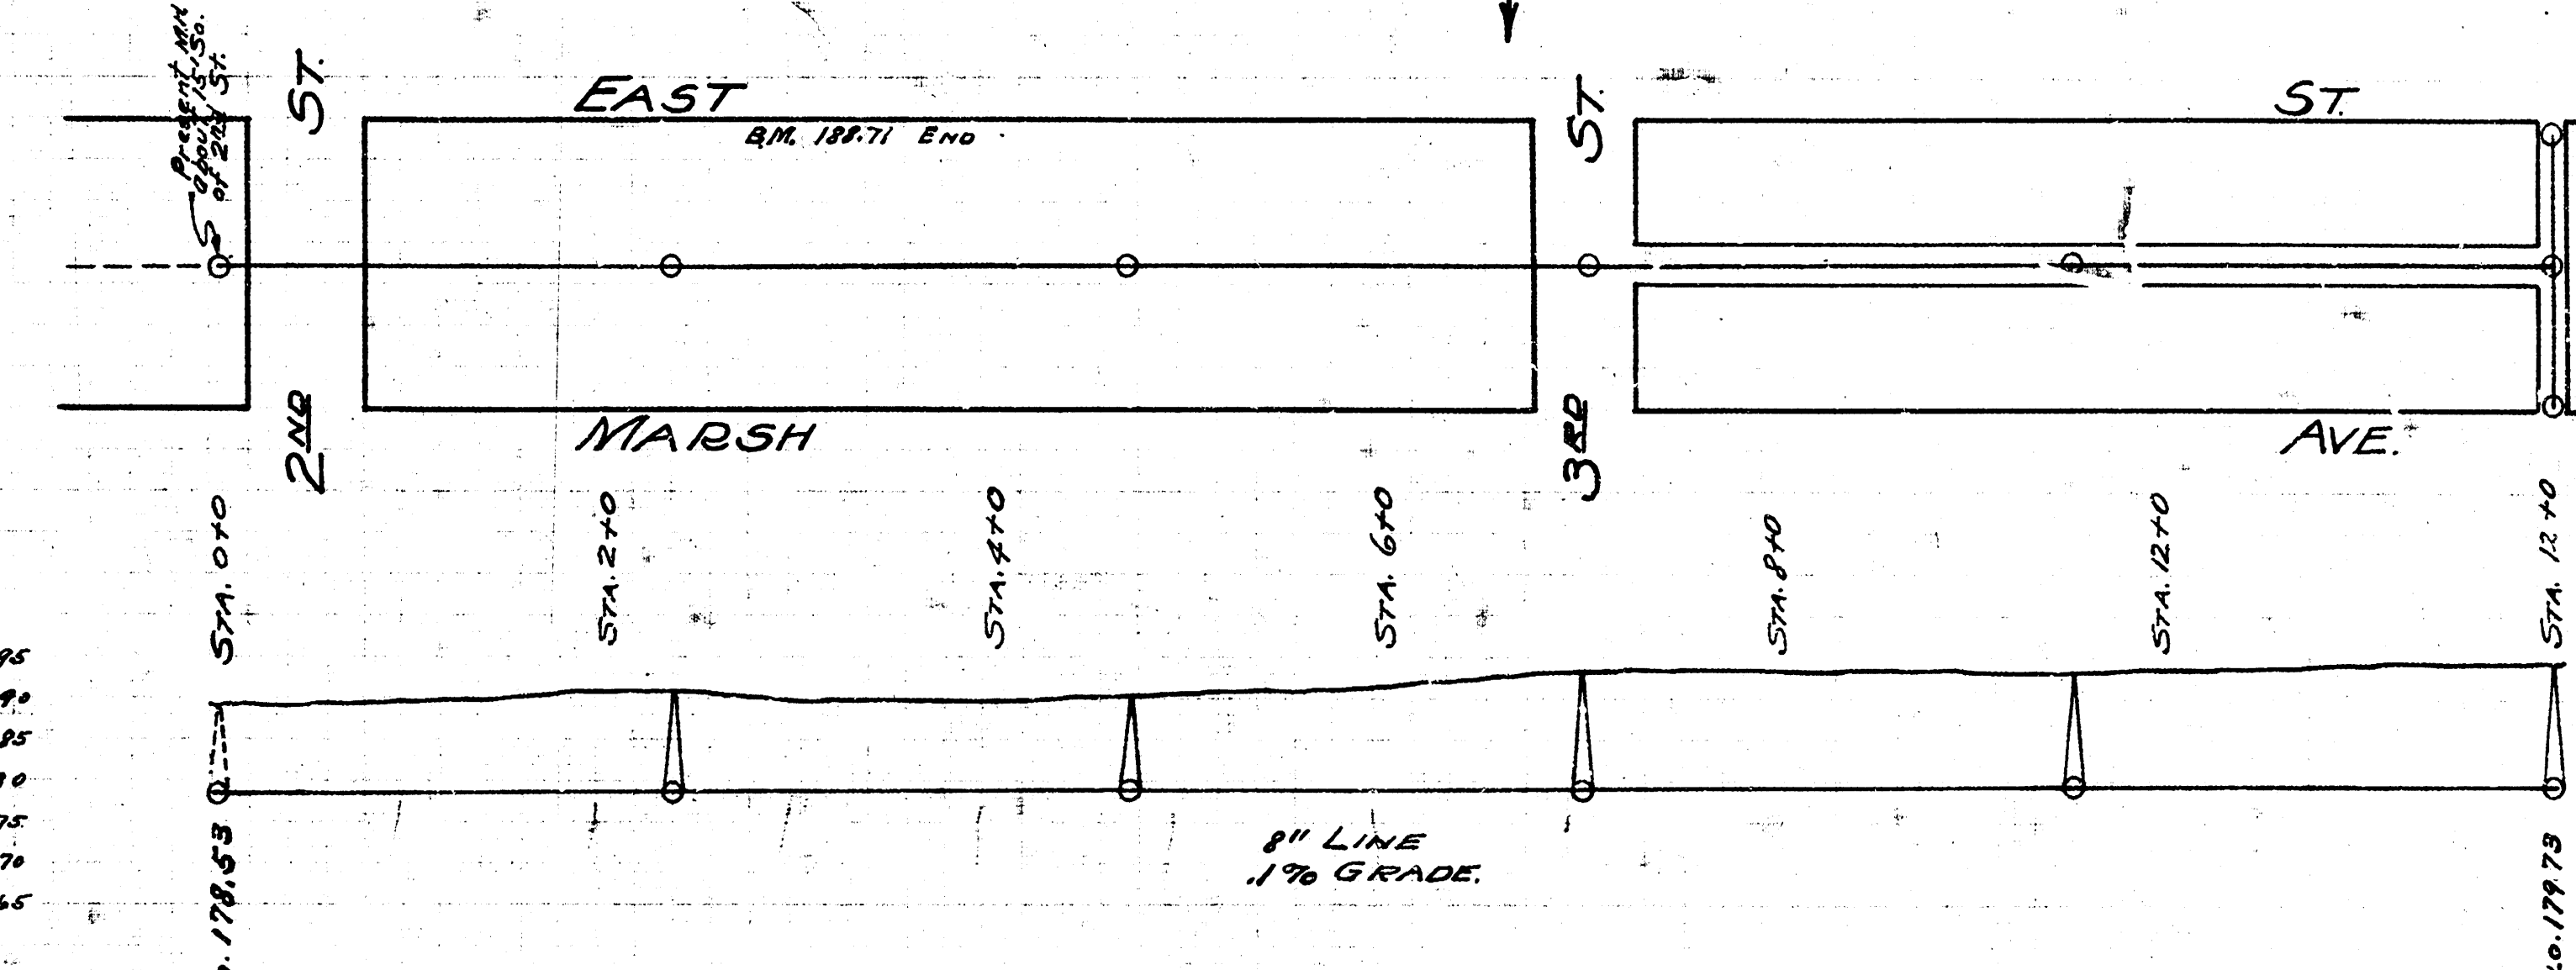

LAT. 2
DIST. N-O
S.S. No. 20

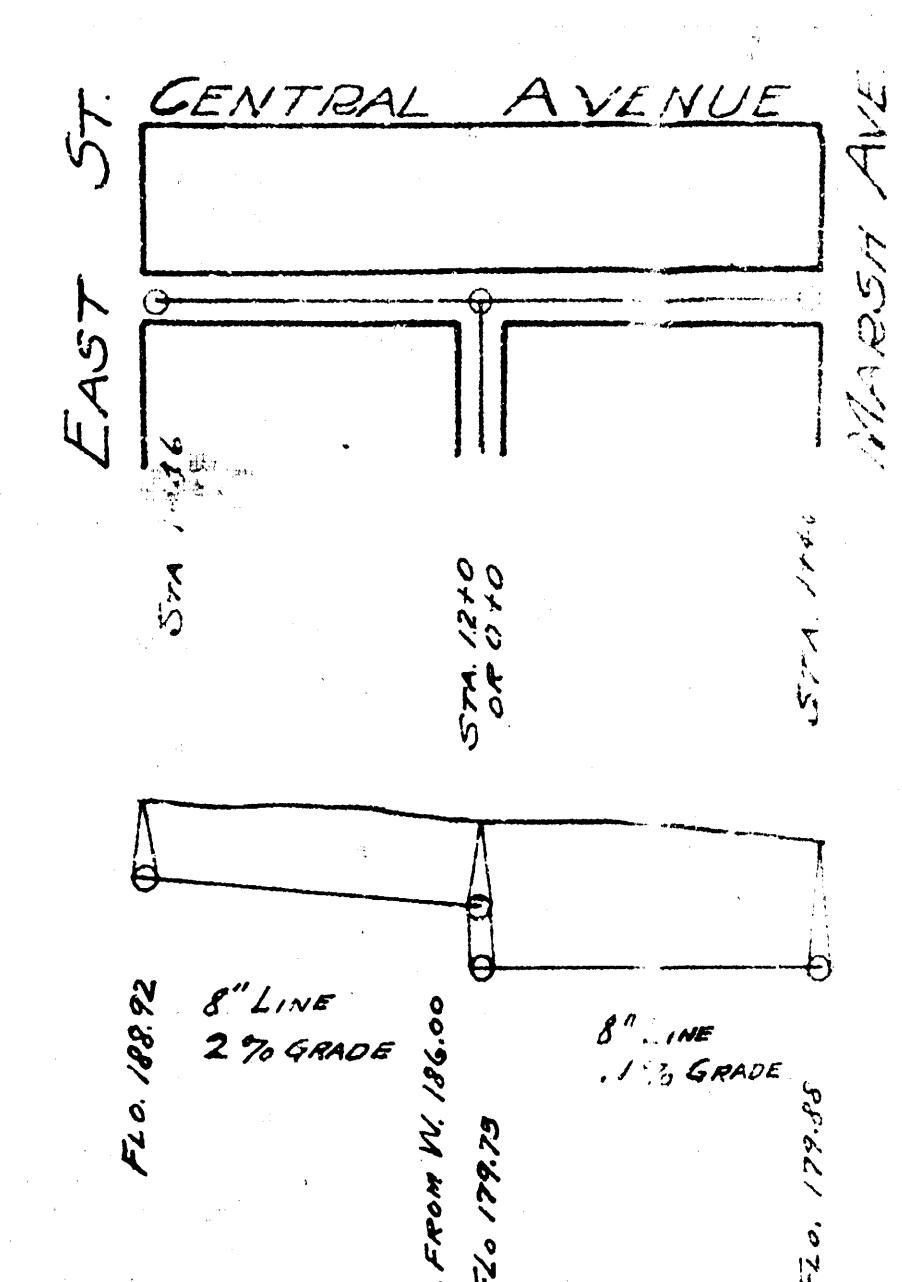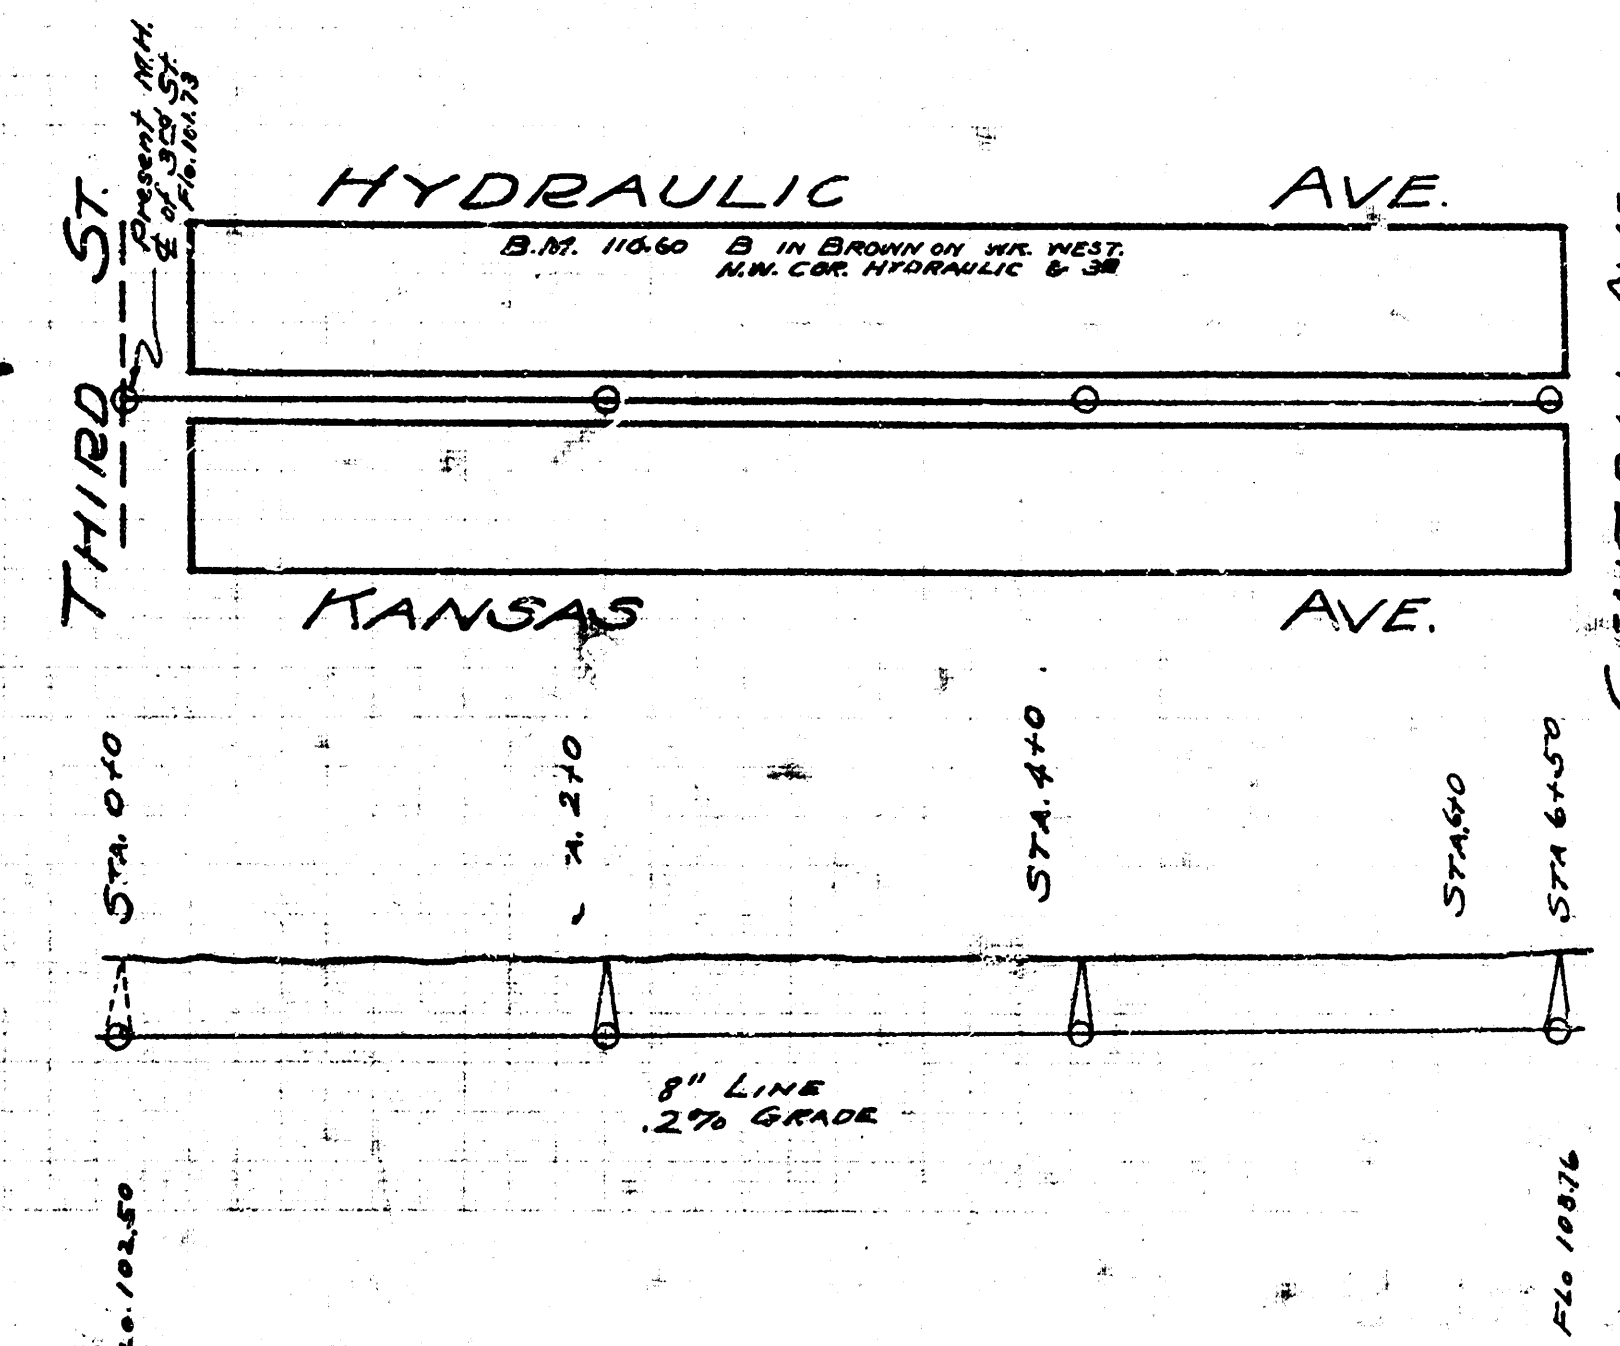

SEE ABOVE FOR S.S. No. 12