



SCALE PLAN 1" = 40'
 PROFILE 1" = 40' HORZ.
 1" = 5' VERT.

B.M. 178.38 R.R. SPIKE E. FC. P.P. N. SIDE
 1ST ST. FIRST POLE W. OF PERSHING
 B.M. 181.81 R.R. SPIKE E. FC. P.P. S. SIDE
 DOUGLAS AVE SECOND P.P. E. OF
 TERRACE EXT. S.

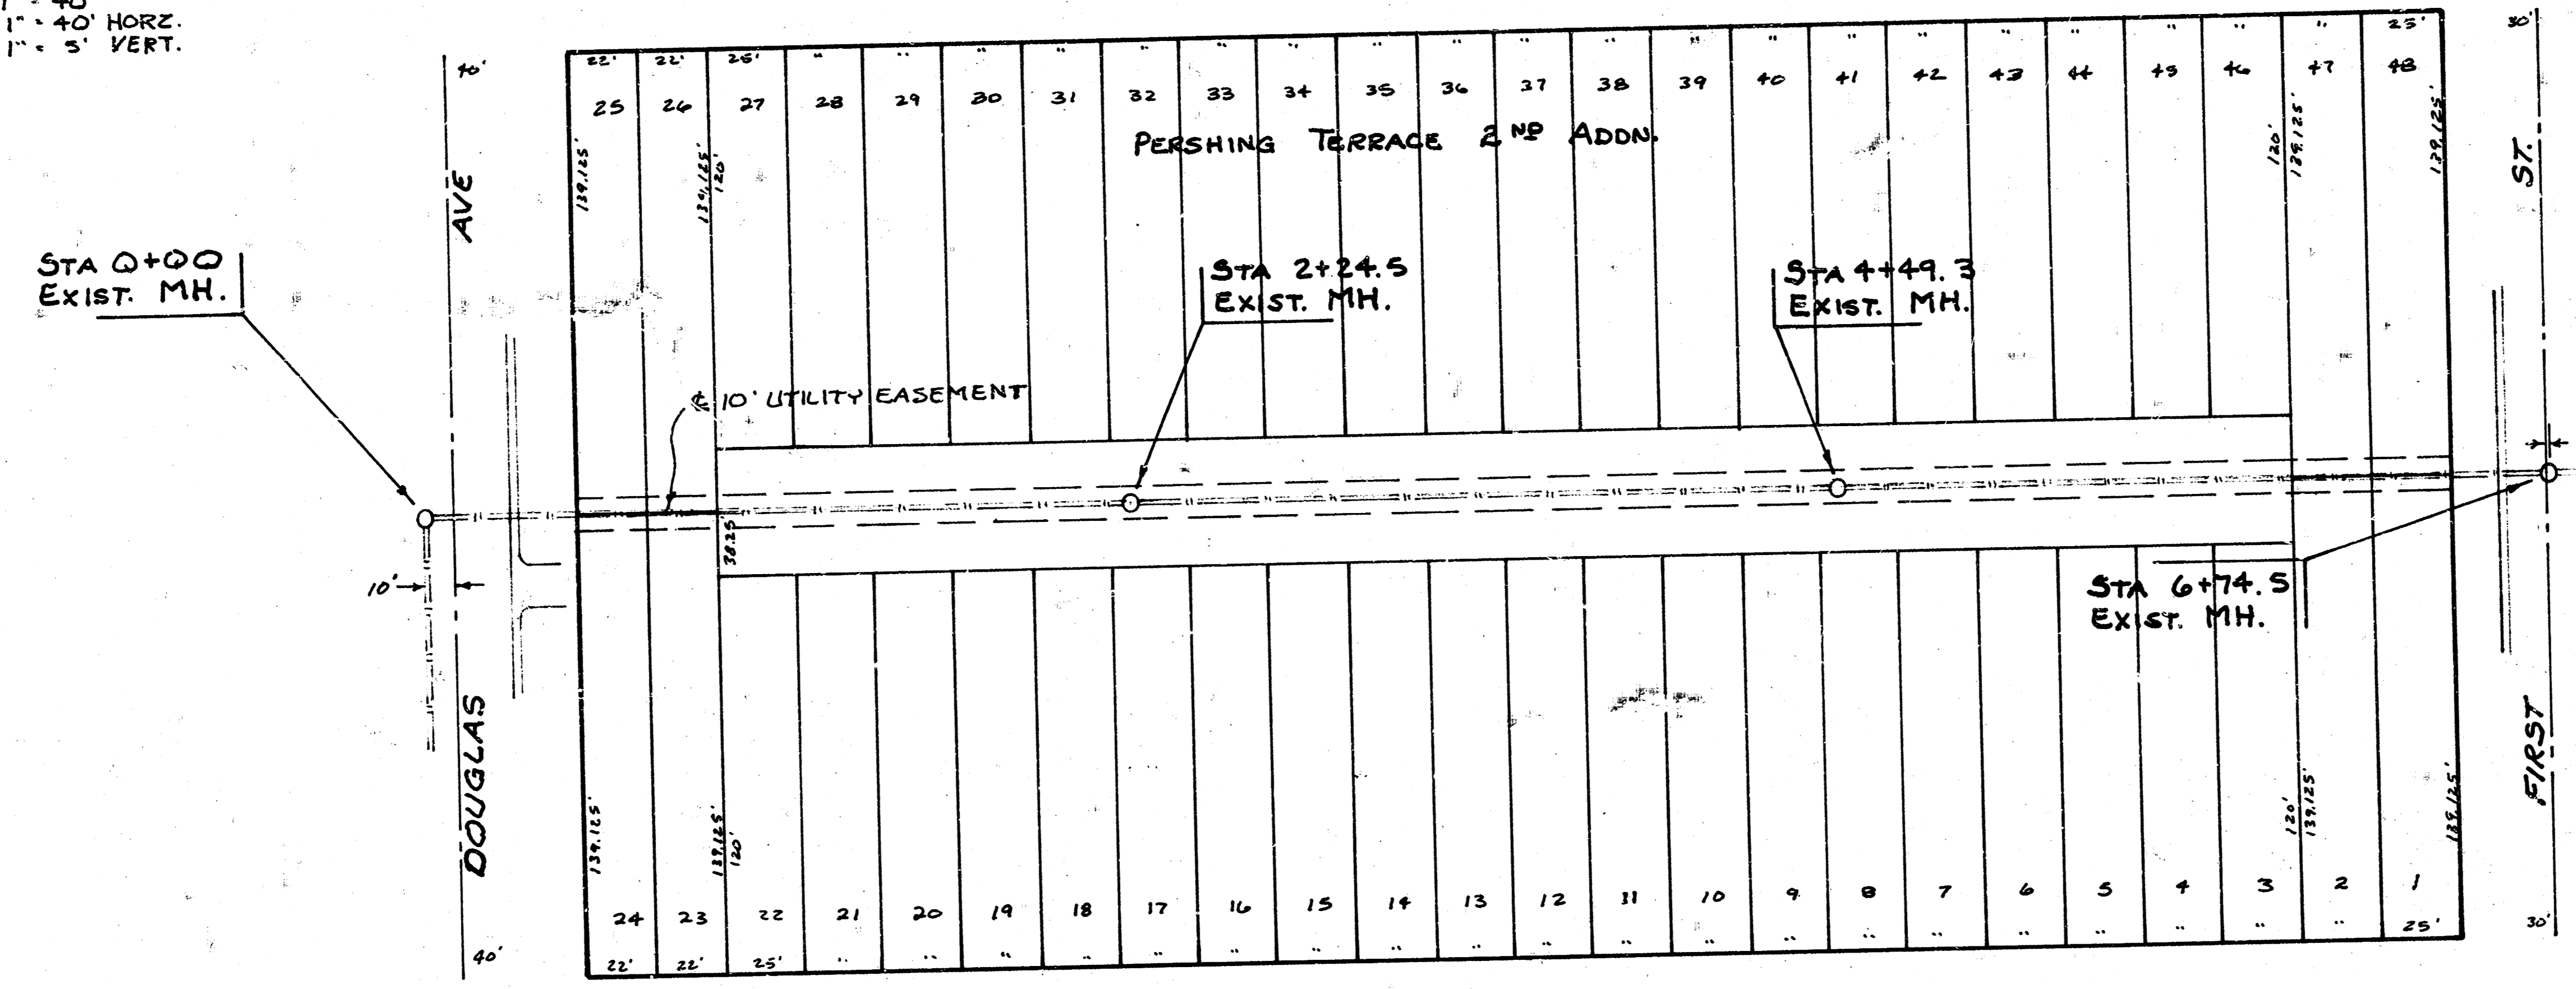


As Built
1st
2-54
 ~NOTES~

Contractor shall give all property owners and/or tenants directly affected by the construction of this project a minimum advance notice of 7 days prior to starting construction.

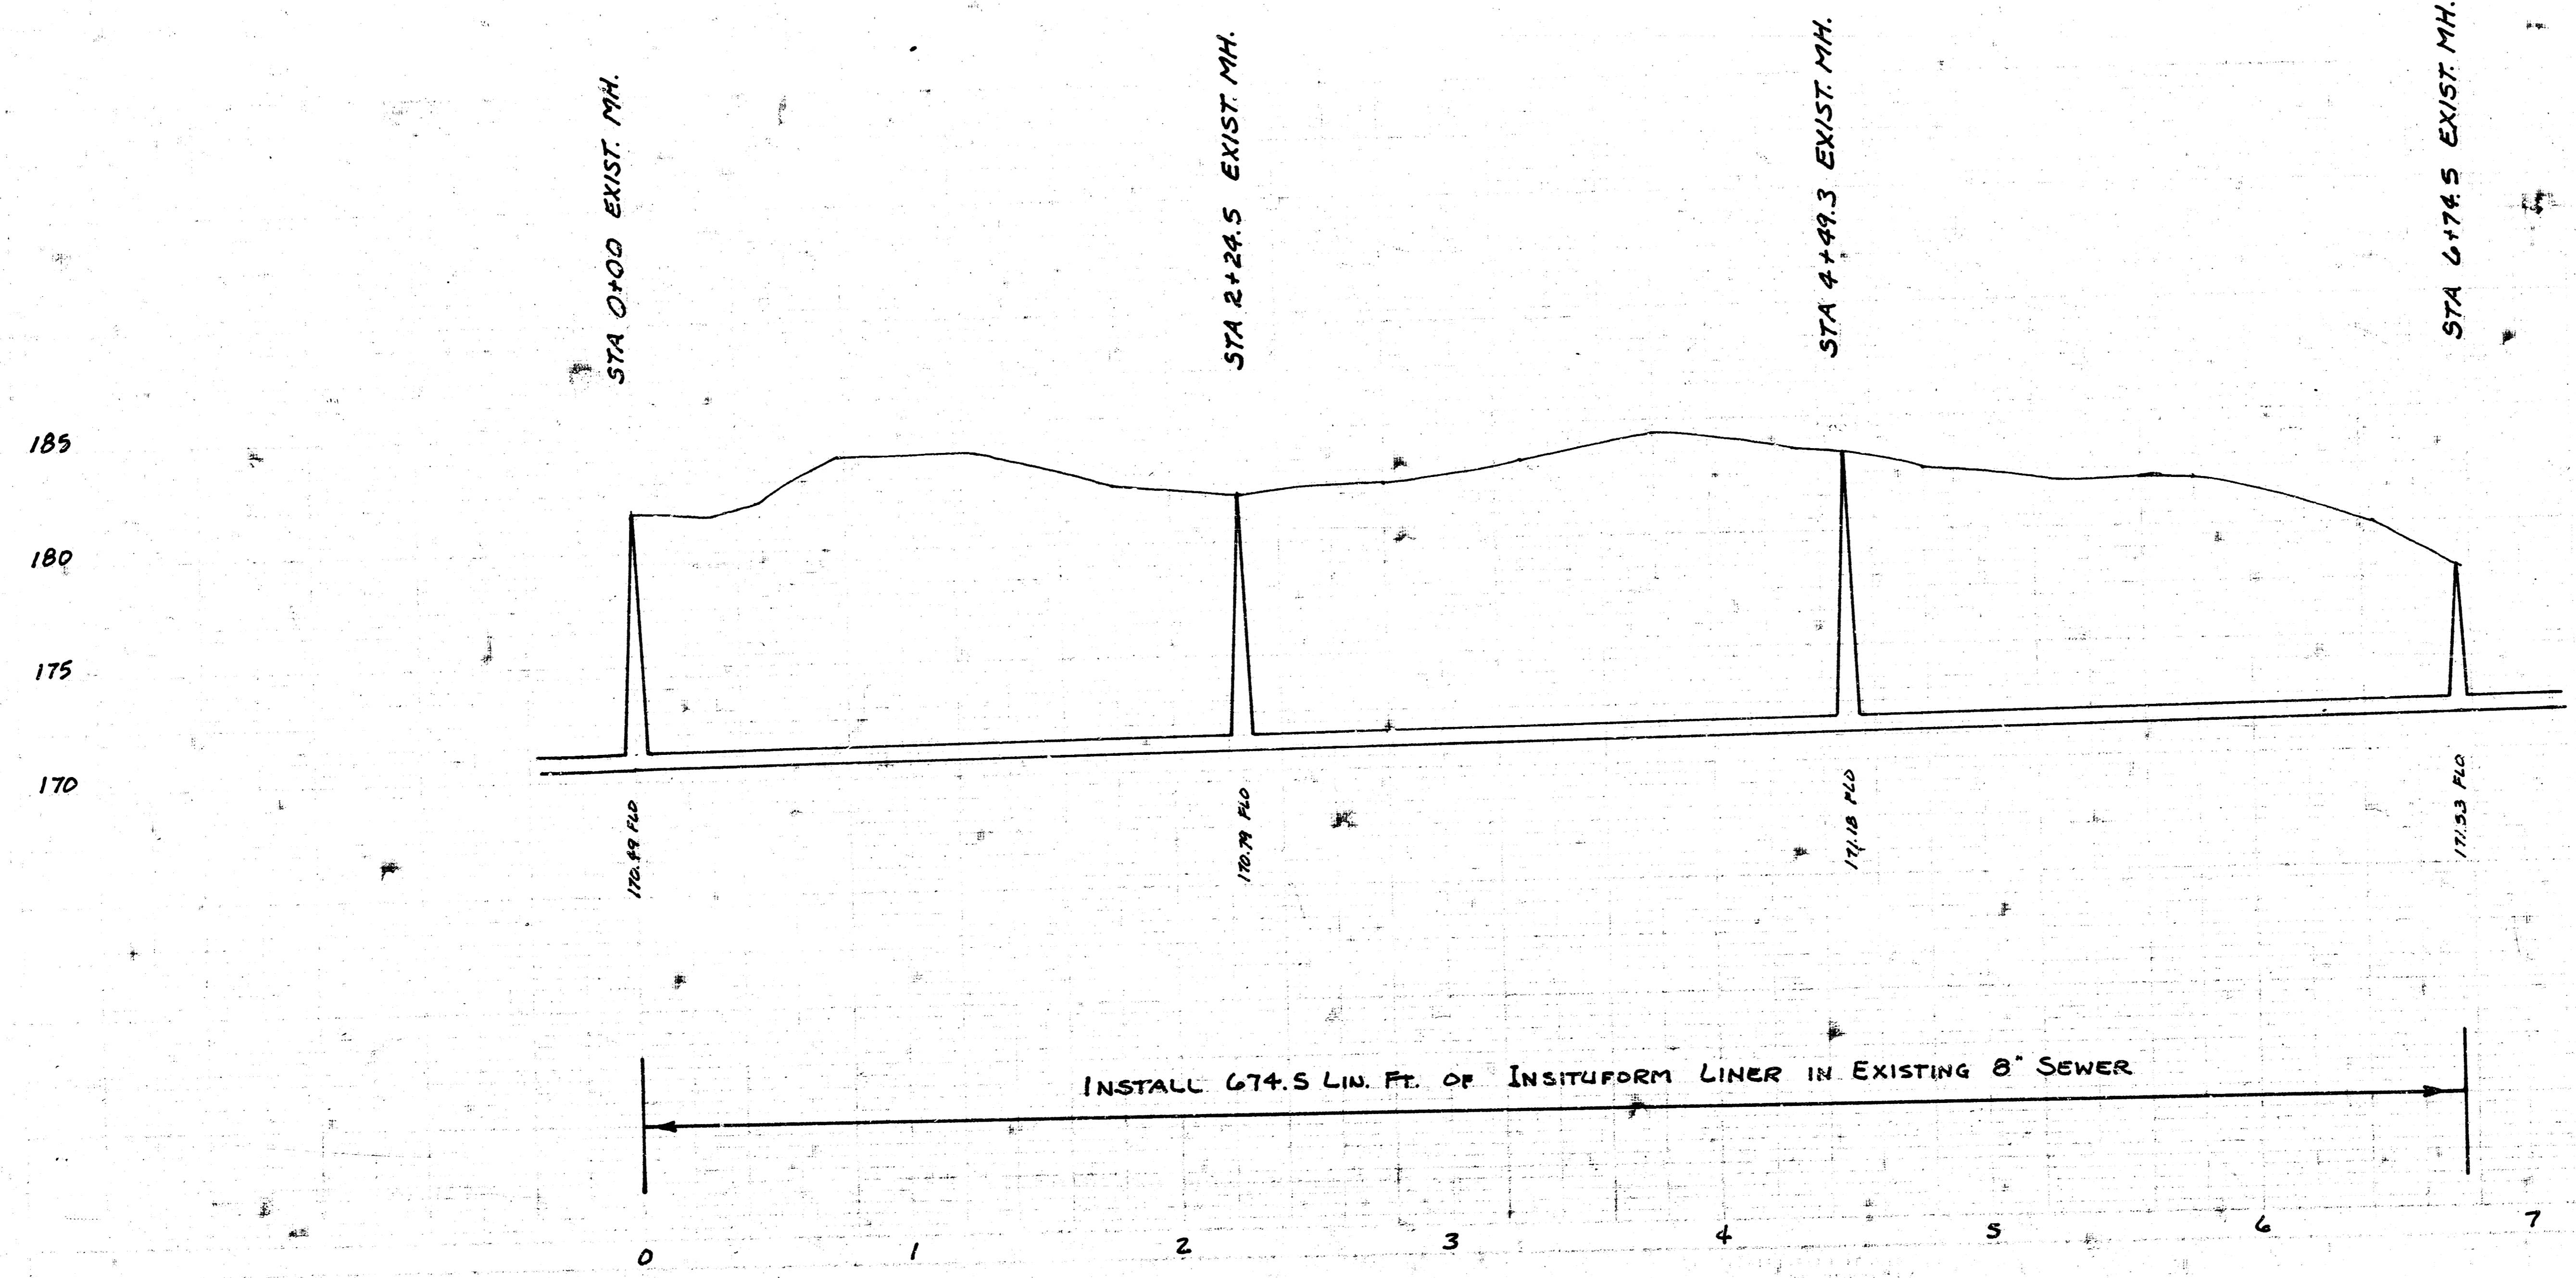

INSTALL 674.5 LIN. FT. OF INSITUFORM LINER IN EXISTING 8" SEWER

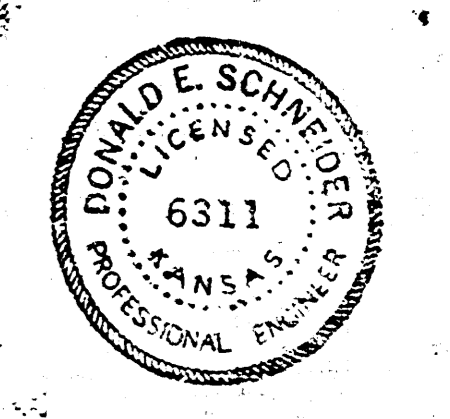

PROJECT DESCRIPTION		
RECONSTRUCT A PORTION OF LAT. 22, DIST. A, S.S. # 12 BETWEEN TERRACE AND PERSHING FROM 1ST TO DOUGLAS		
PROJECT NUMBER		
468-76-245-81302-000-000-001		
BOOK NO. MG-41	APPROVED BY	DATE 9-83
DRAWN BY LCOMIS	REVISION	
CITY OF WICHITA		
DEPARTMENT OF ENGINEERING		
DIRECTOR OF ENG./CITY ENGINEER		SCALE
R. W. BRUGSEMAN		1/1

12 0 3 8