

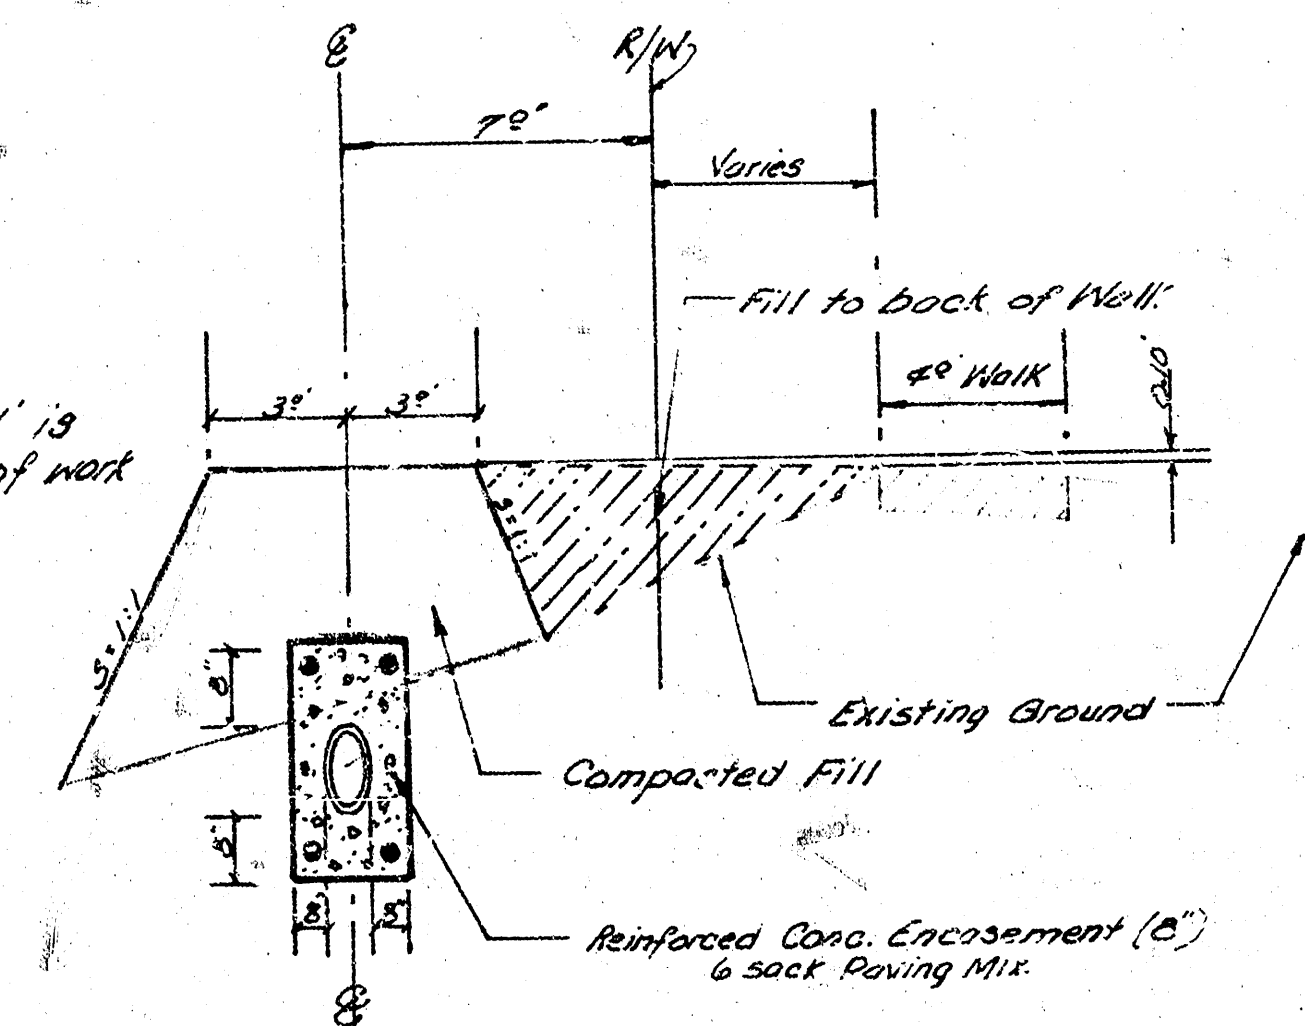
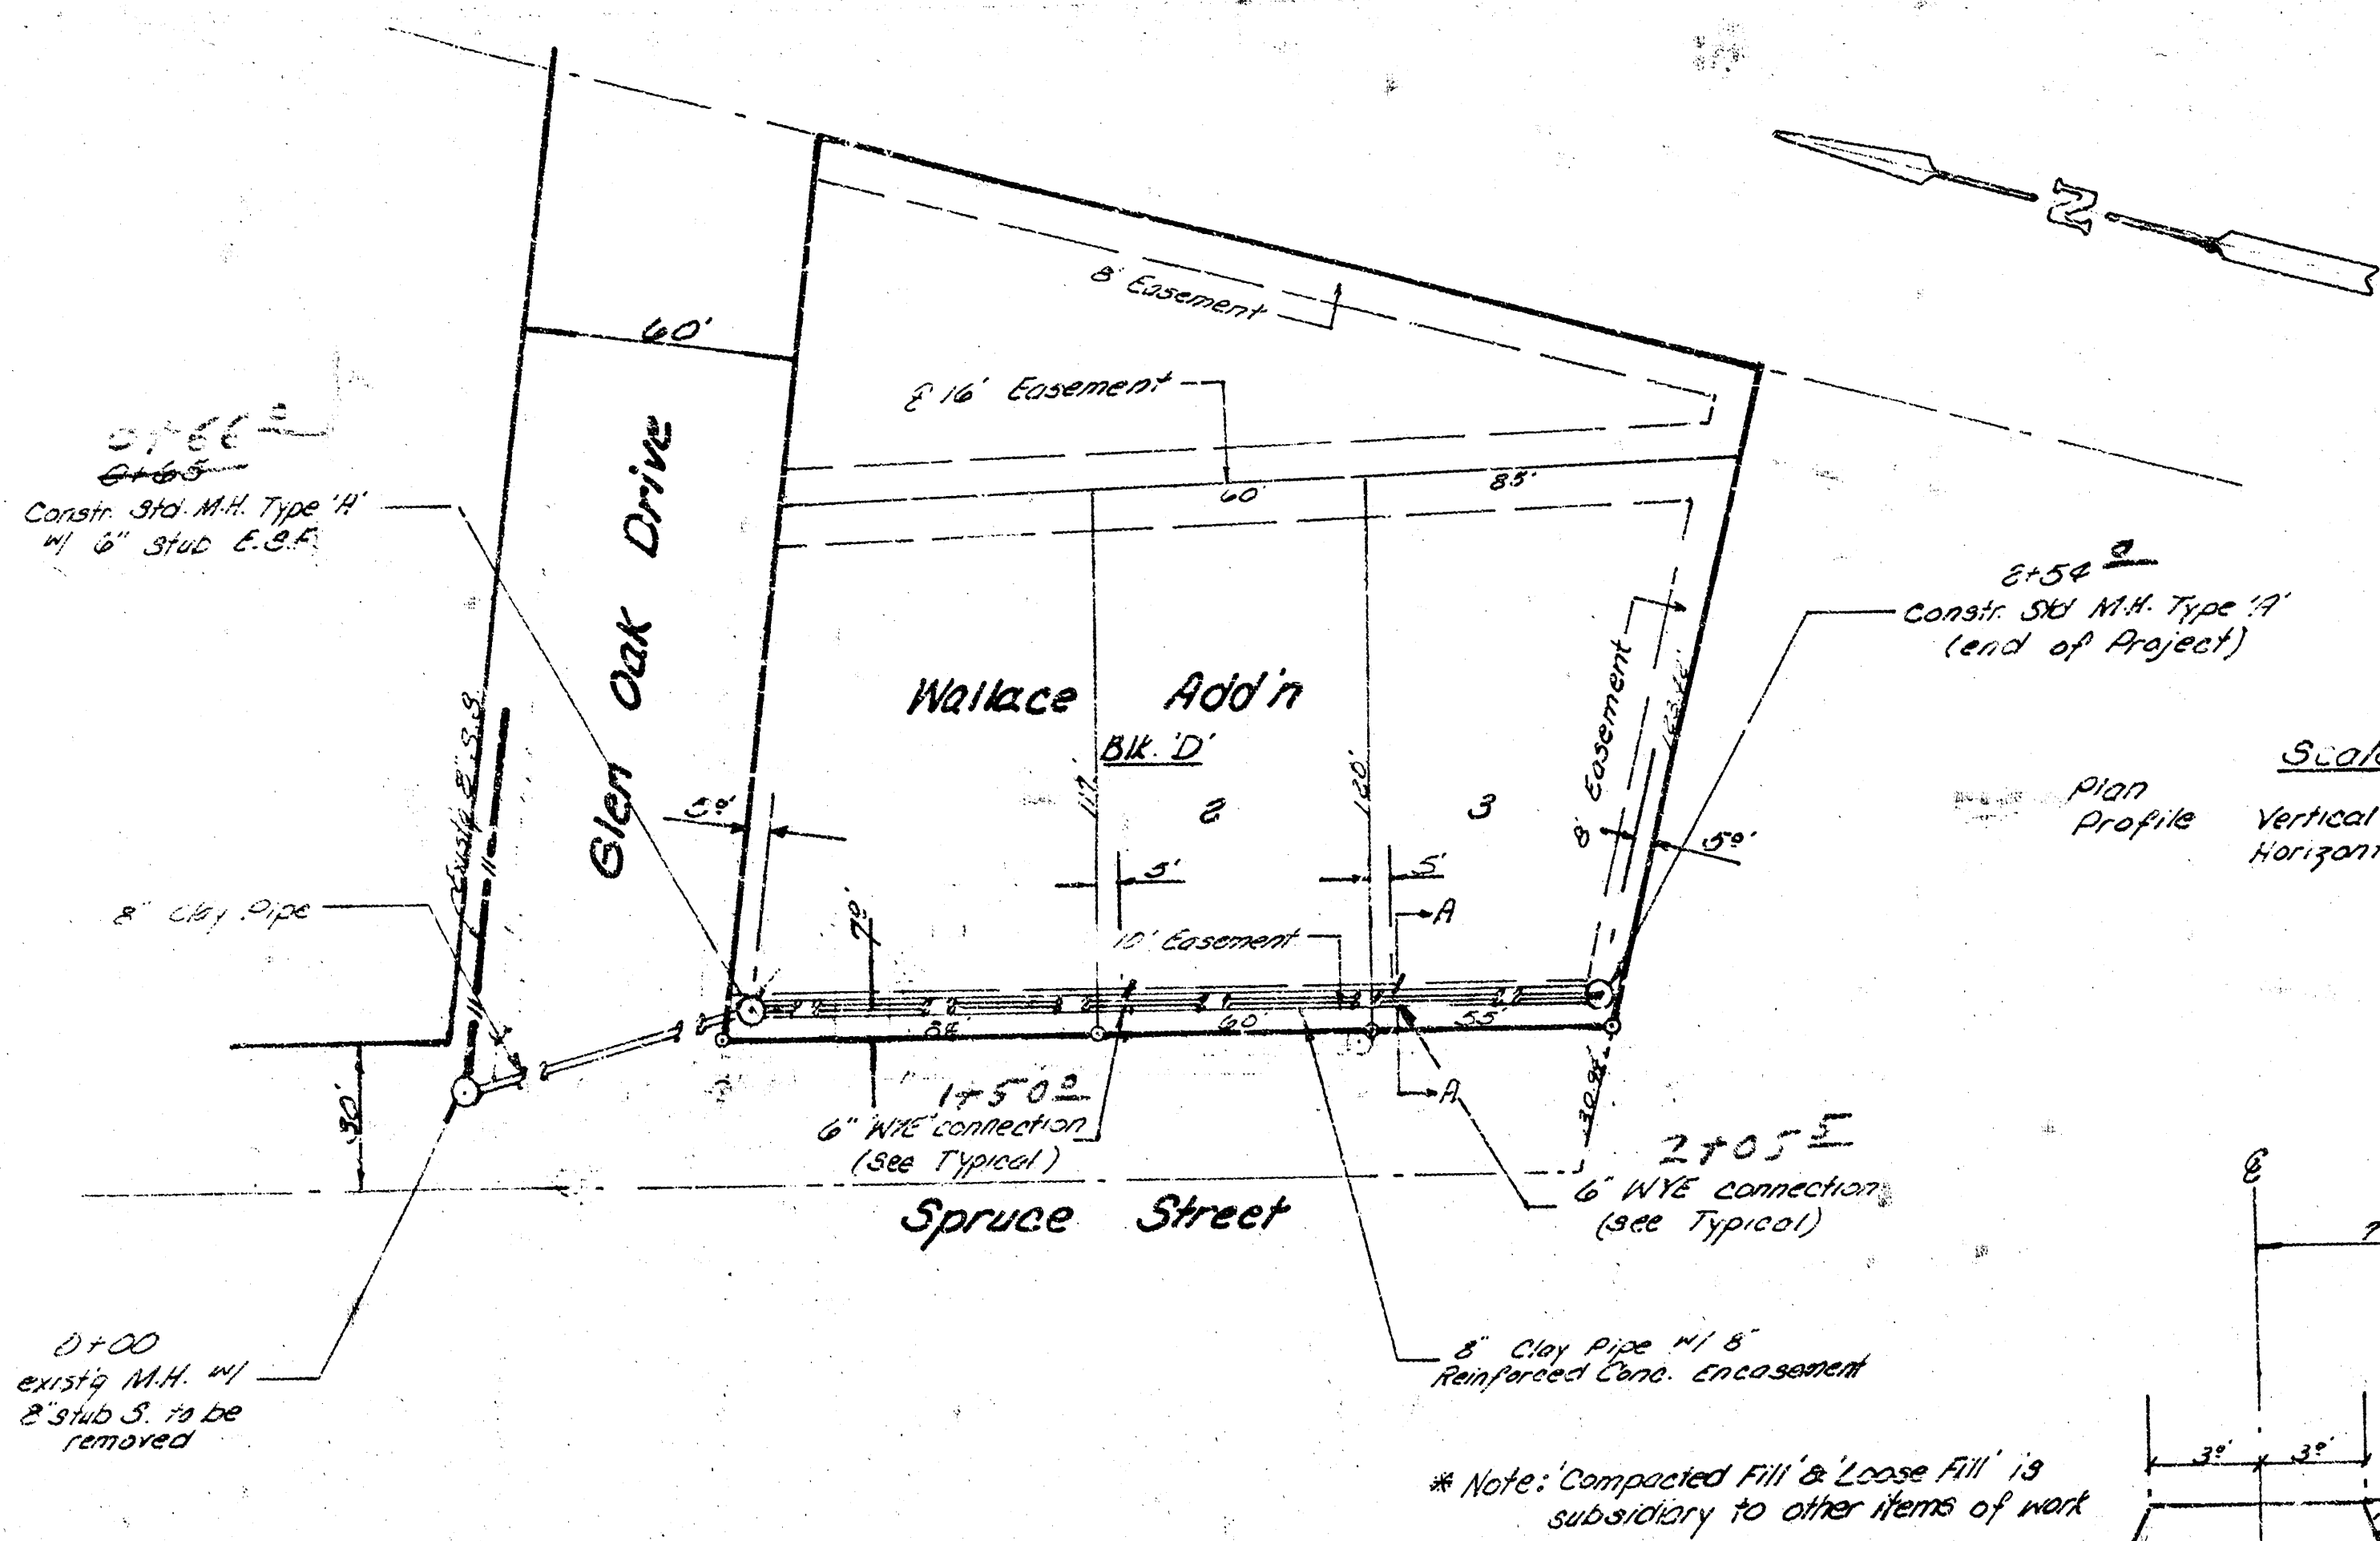


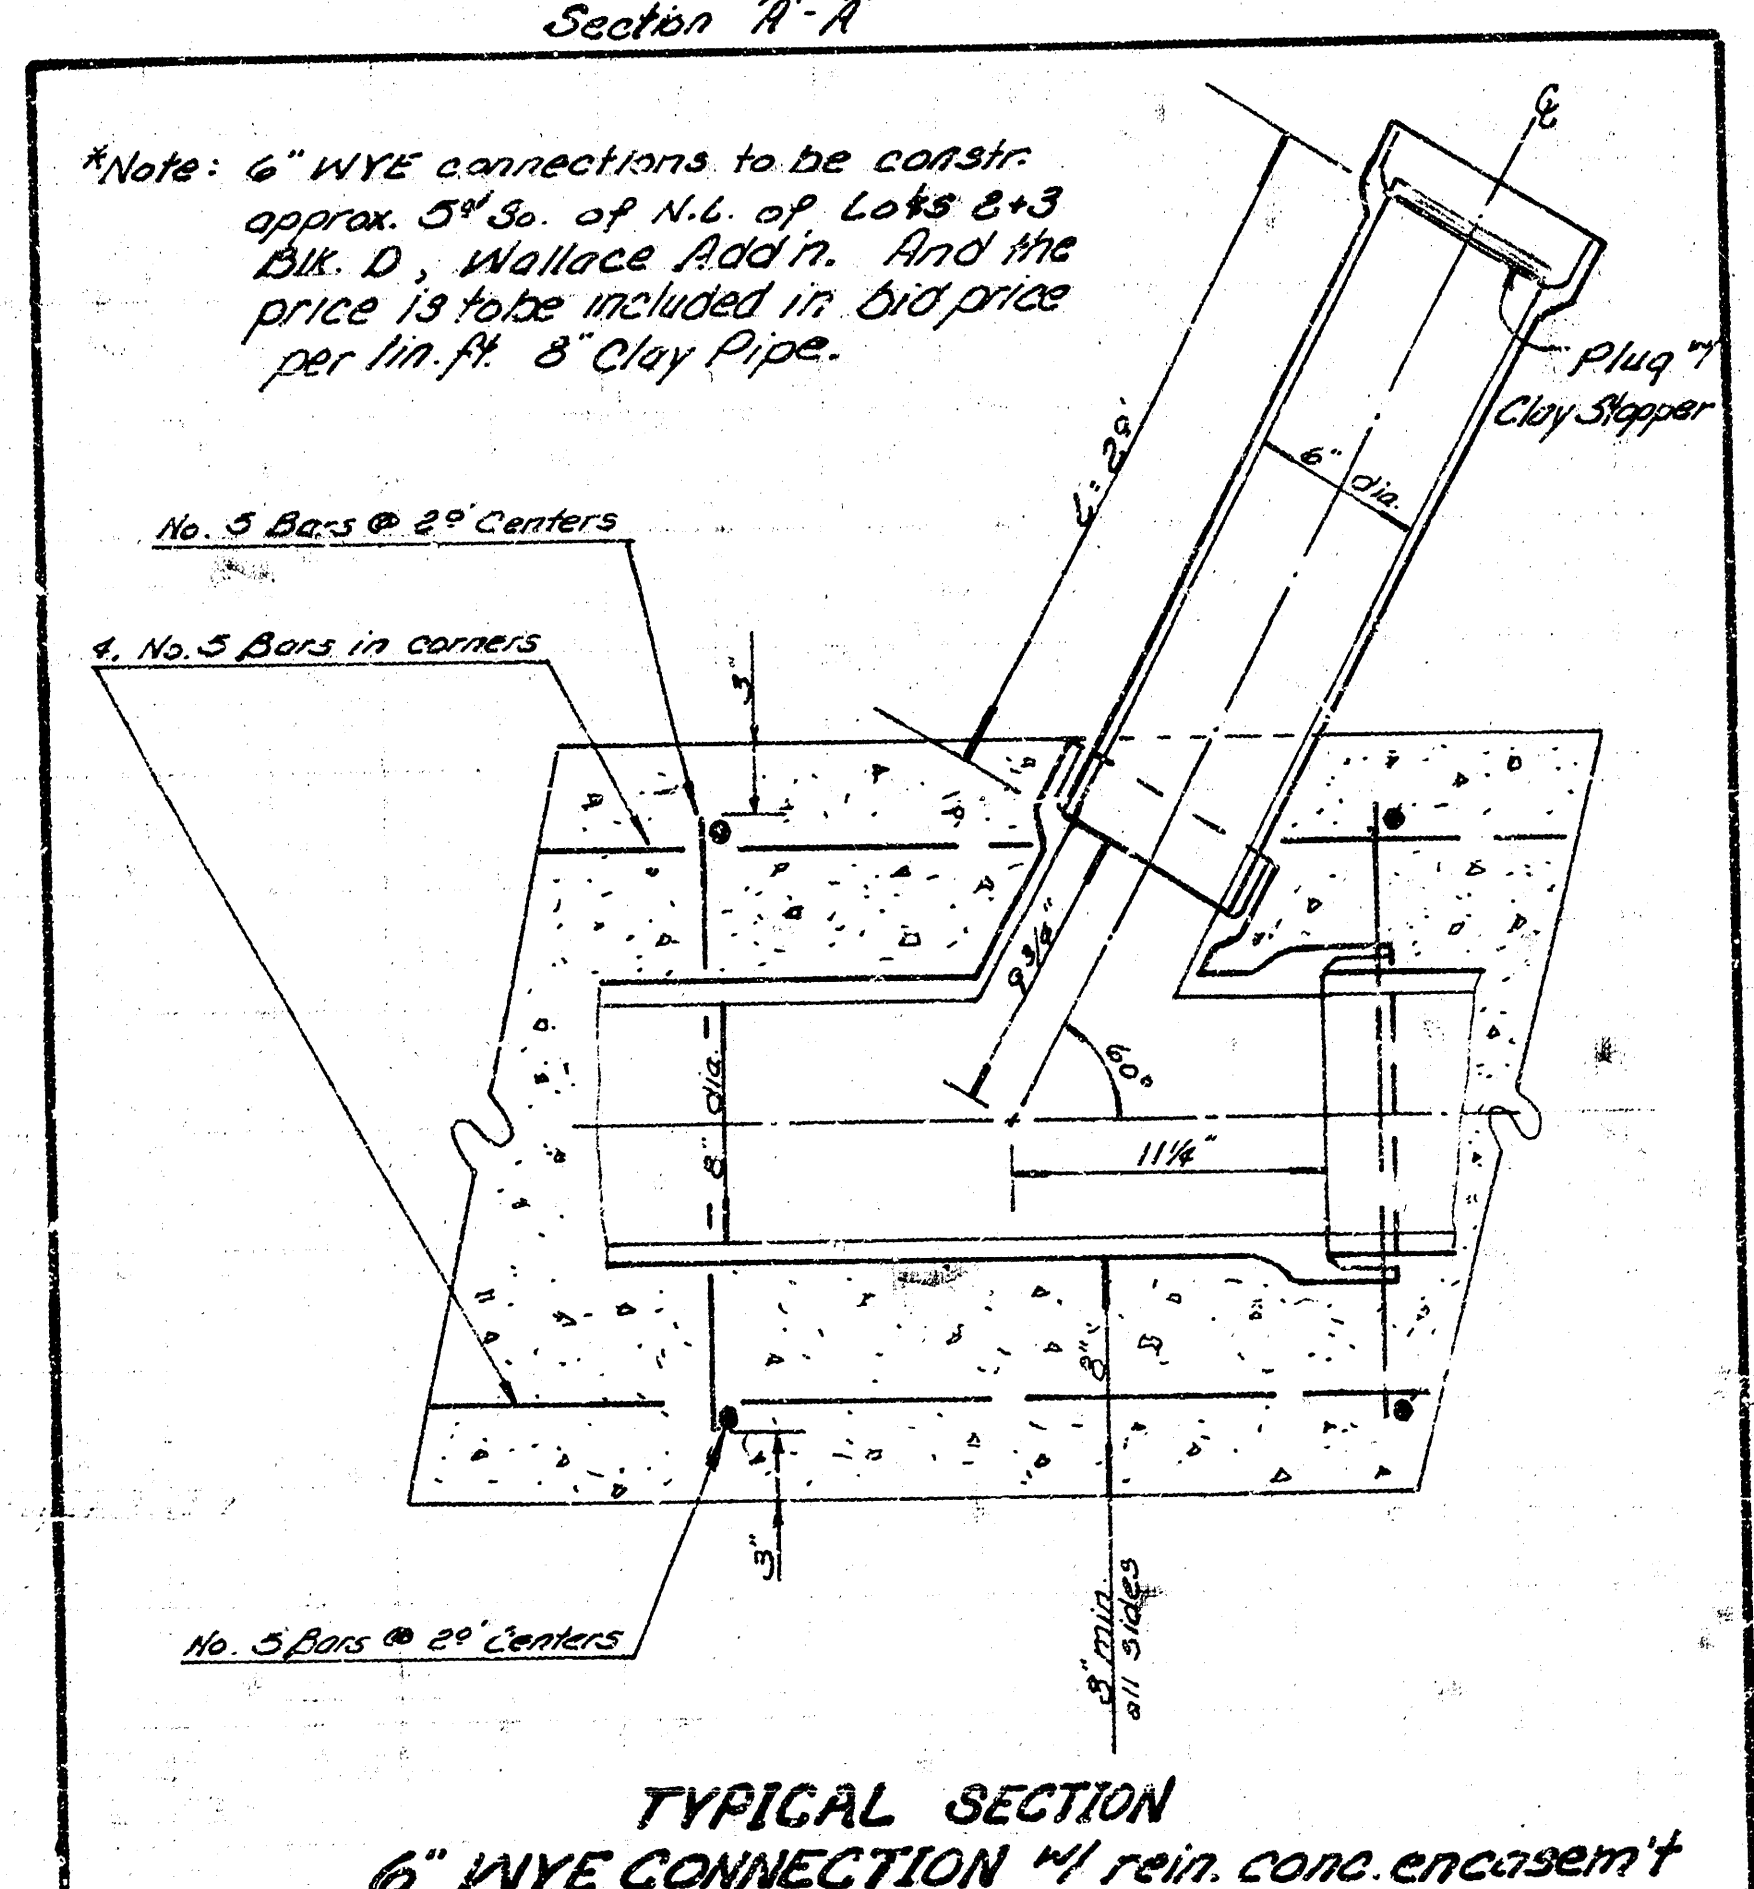

B.M. 94.76 R.R. Spk. W.S. R.P. & S.W. cor. Lot 2, Bldg. Wallace Add'n.

Field Engineer to make 'ties' to all property lines, any lines disturbed or destroyed are to be replaced. Trees are not to be removed.

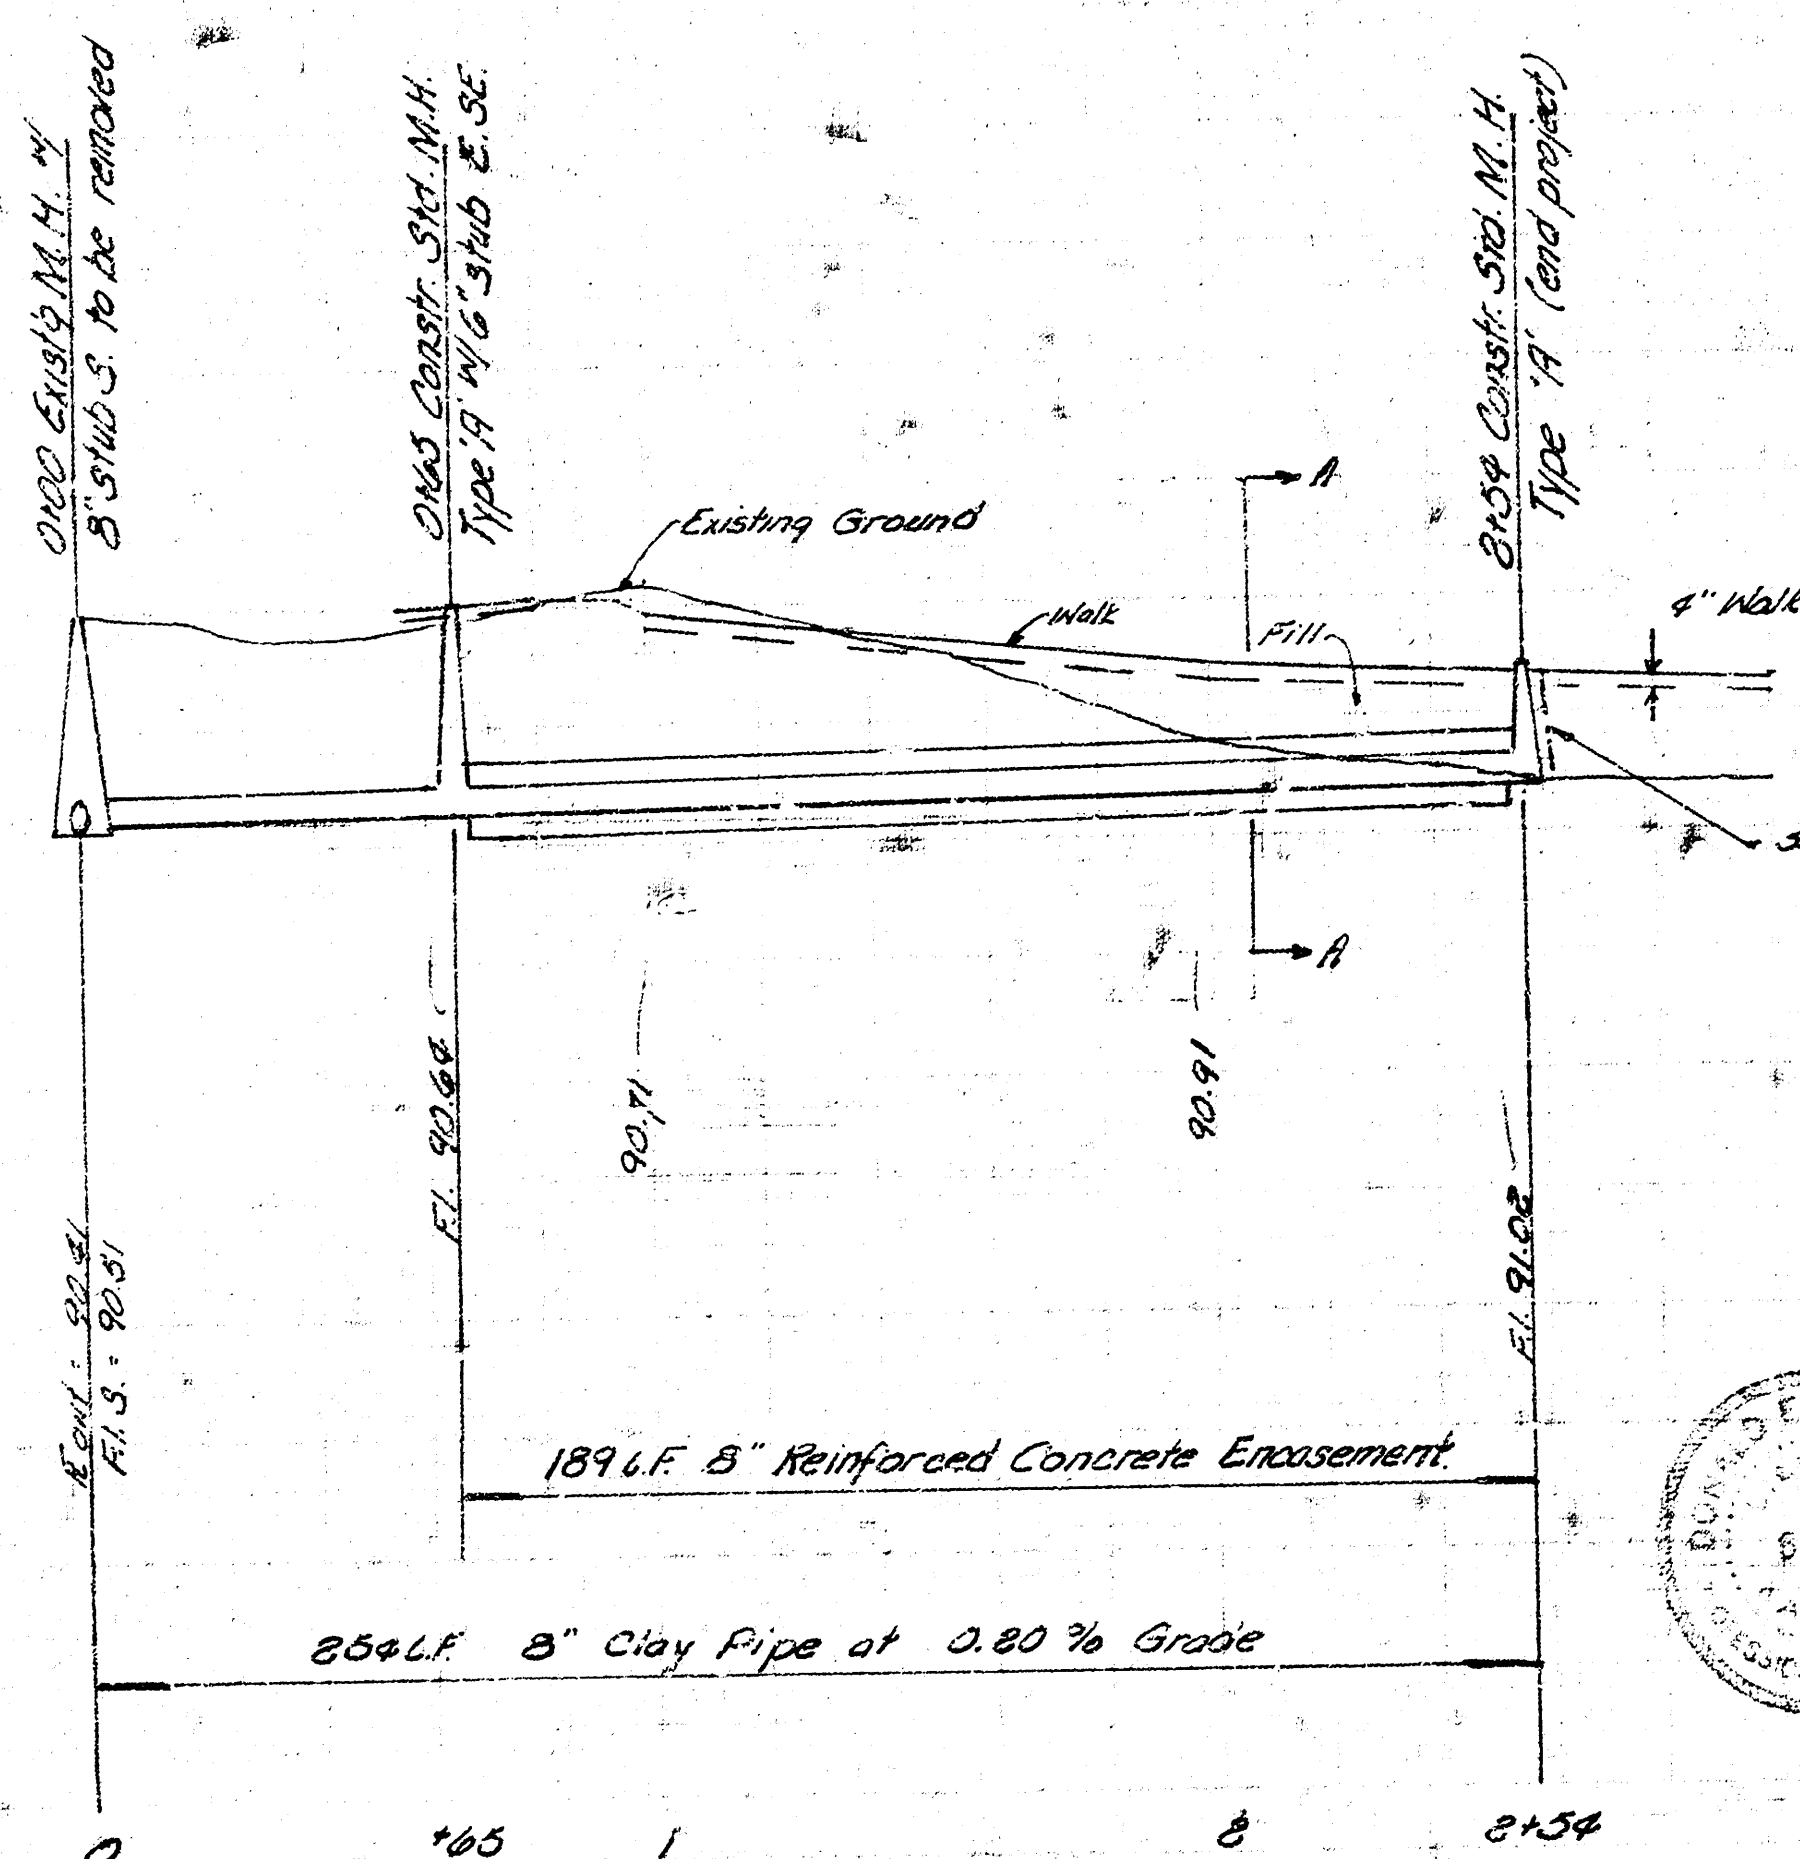

As built 1-7-77

Lateral 23 Dist. AS S.S. #12
 South of Glen Oak Dr. & East of Spruce St. for Lots 2, 3 Block 'D'
WALLACE ADDITION
CITY of WICHITA, KANSAS
P. W. LINN CITY ENGINEER
 Date: October 1977 Project Number: DBKL576044