



B.M. 1517 "D" TOP 50. CURB EDGEMONT 6' E. of E.L. RUTAN

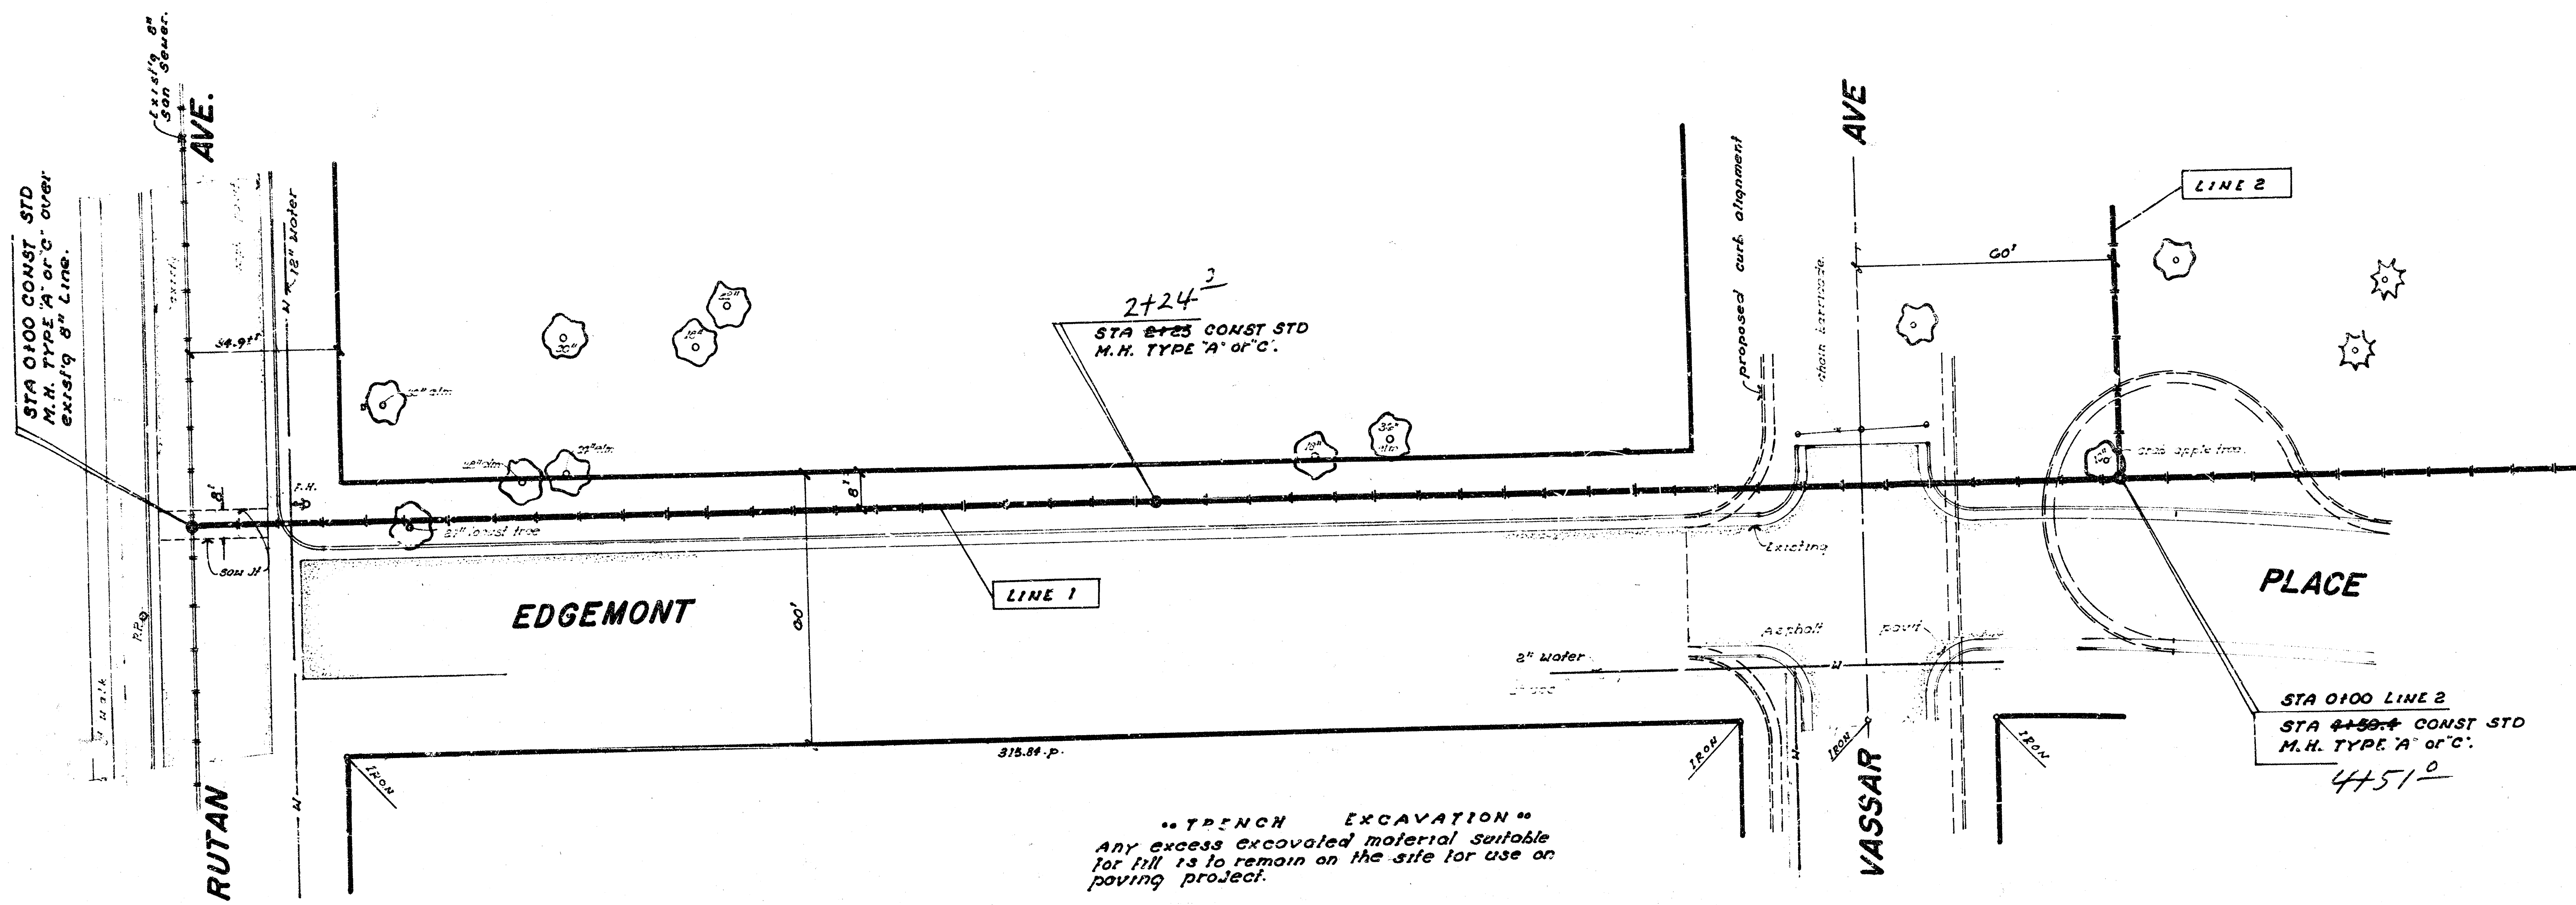


"TRENCH EXCAVATION"  
Any excess excavated material suitable  
for fill is to remain on the site for use on  
paving project.

plan scale 1" = 20'  
profile 1" = 20' Horiz  
1" = 5' Vert

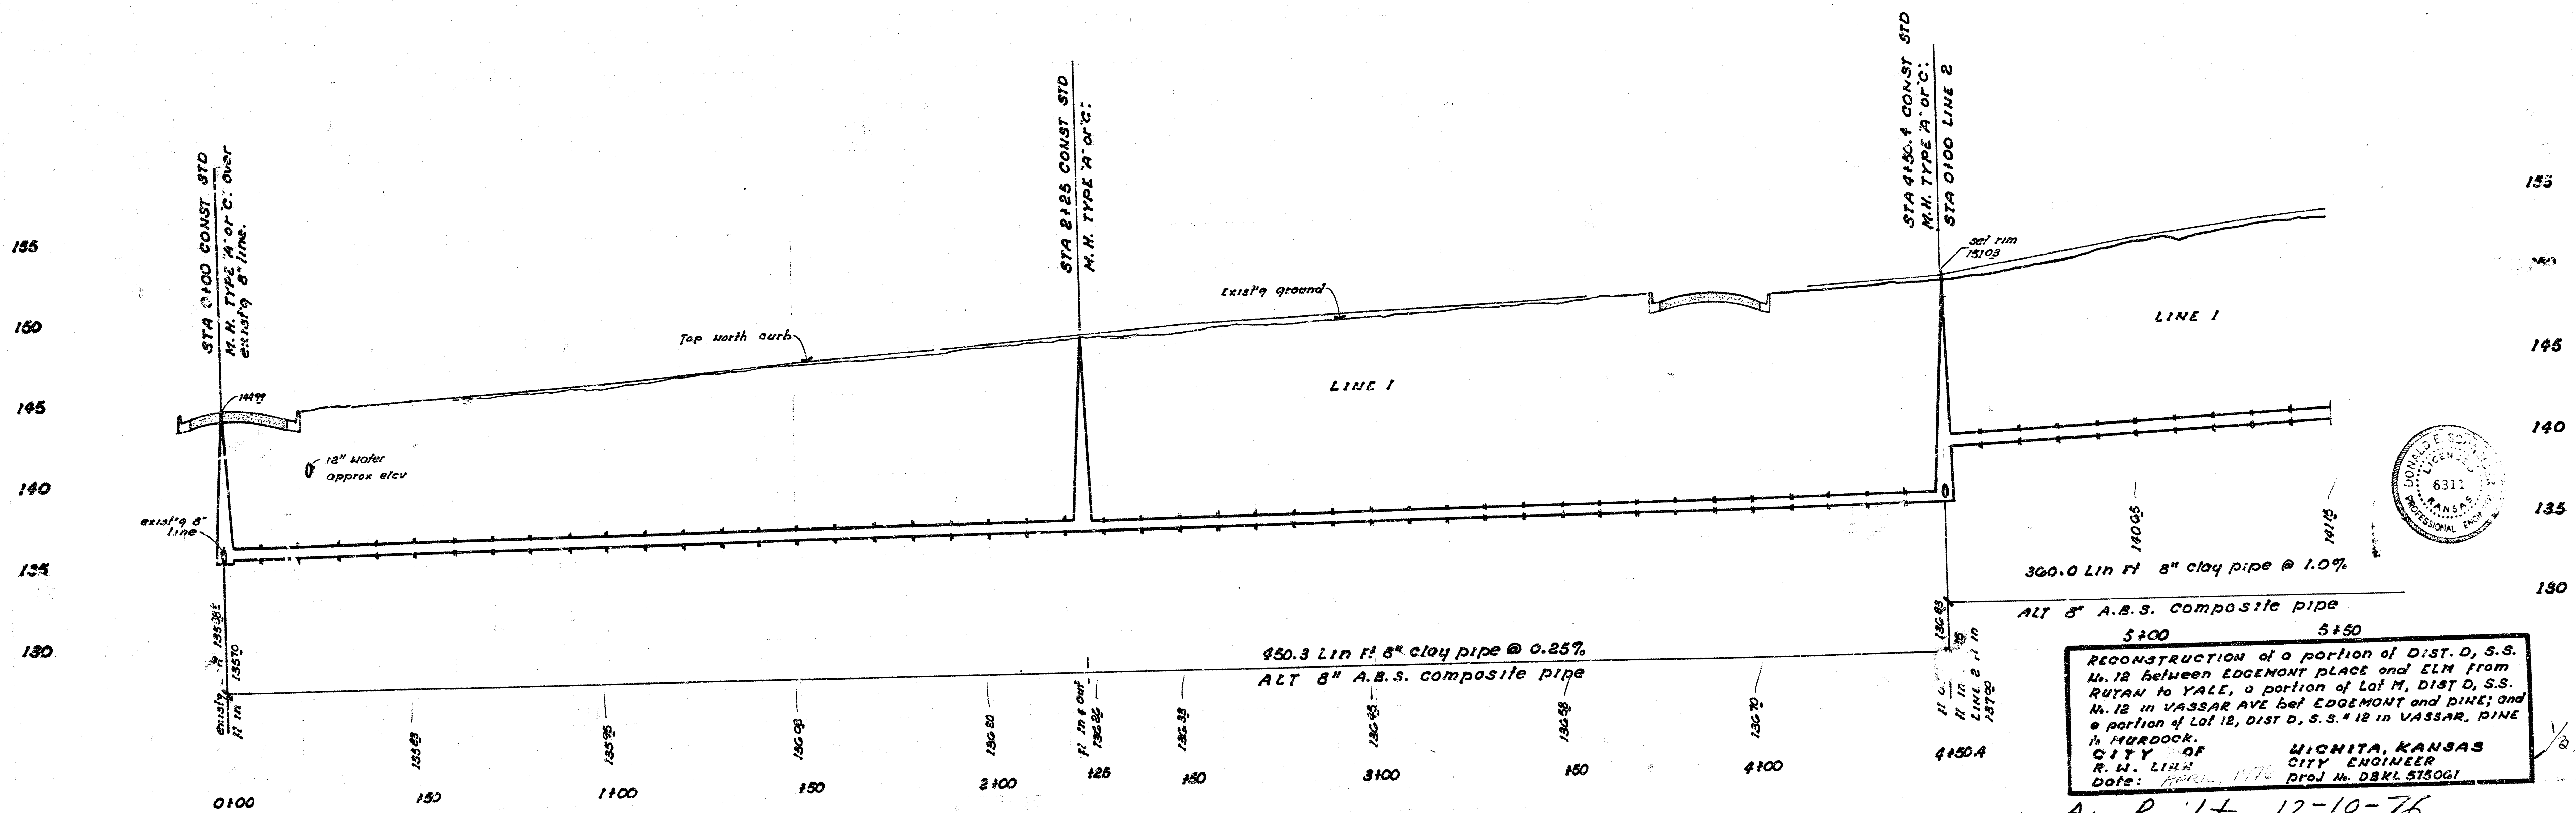


RECONSTRUCTION of a portion of DIST. D, S.S.  
No. 12 between EDGEMONT PLACE and ELM from  
RUTAN to YALE, a portion of Lot M, DIST D, S.S.  
No. 12 in VASSAR AVE bet EDGEMONT and PINE;  
a portion of Lot 12, DIST D, S.S. # 12 in VASSAR, PINE  
to HARDOCK.  
CITY OF WICHITA, KANSAS  
R. W. LINN CITY ENGINEER  
Date: March 1976 PROJ. No. DSKL 5750G1

As BUILT 12-10-76

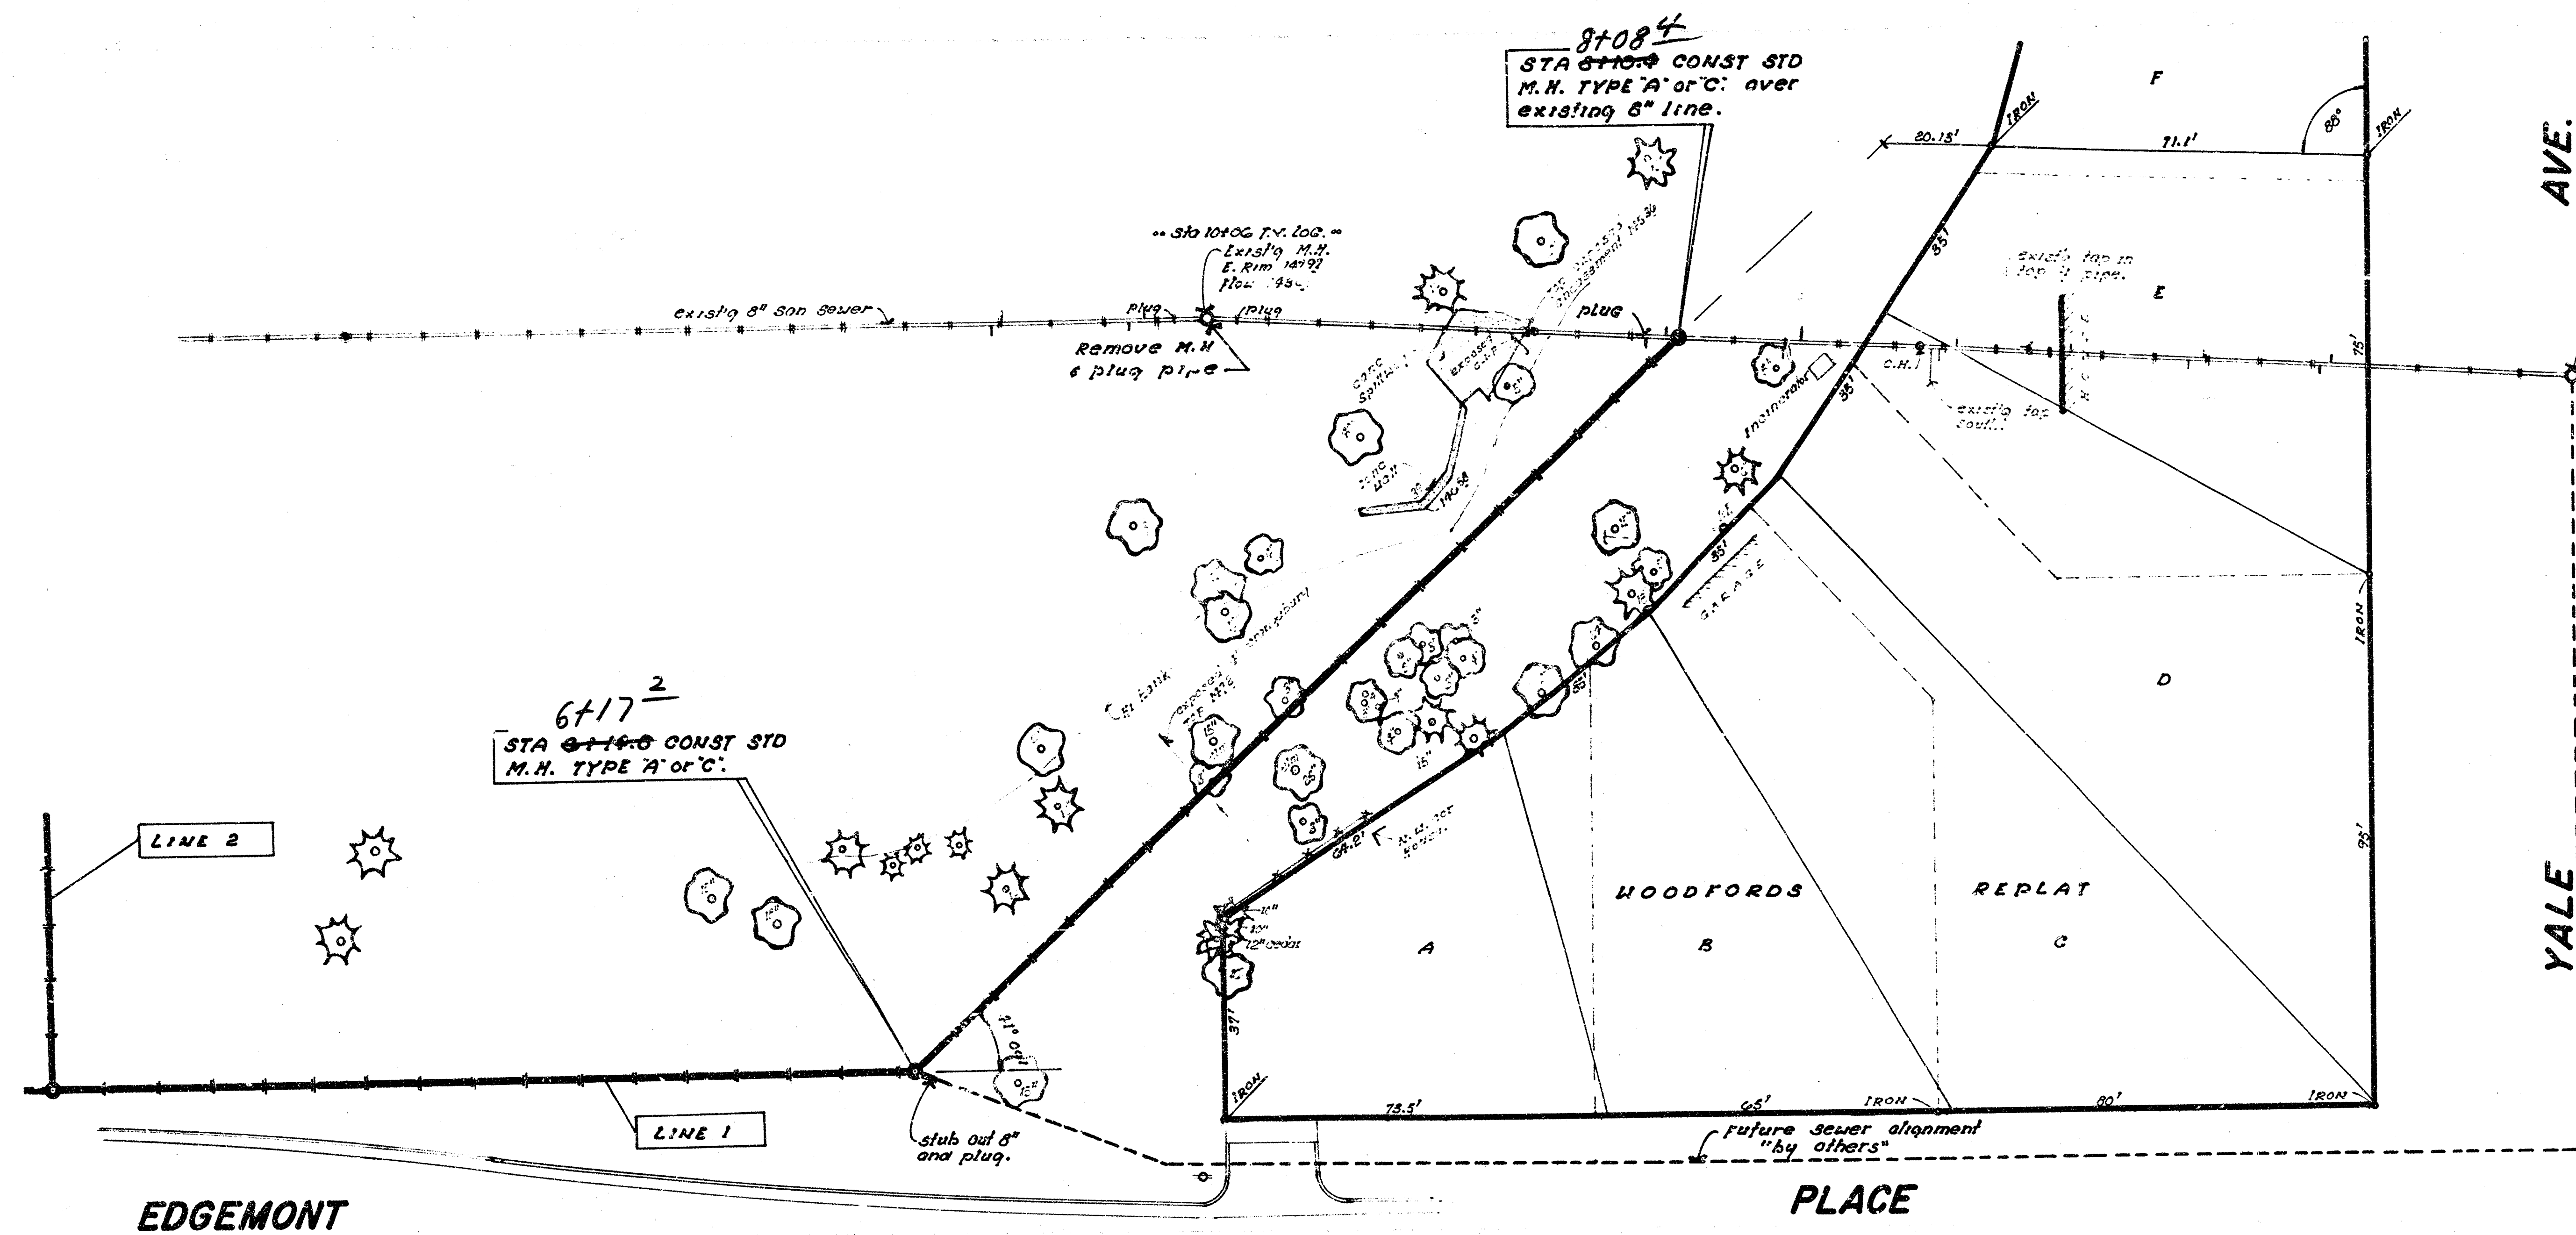

**“SERVICE CONNECTIONS”**  
 NOTE: Contractor to determine the location of existing service connections for houses on lots A thru F WOODFORDS REPLAT. Service lines re connected to be paid as price bid for service connections.

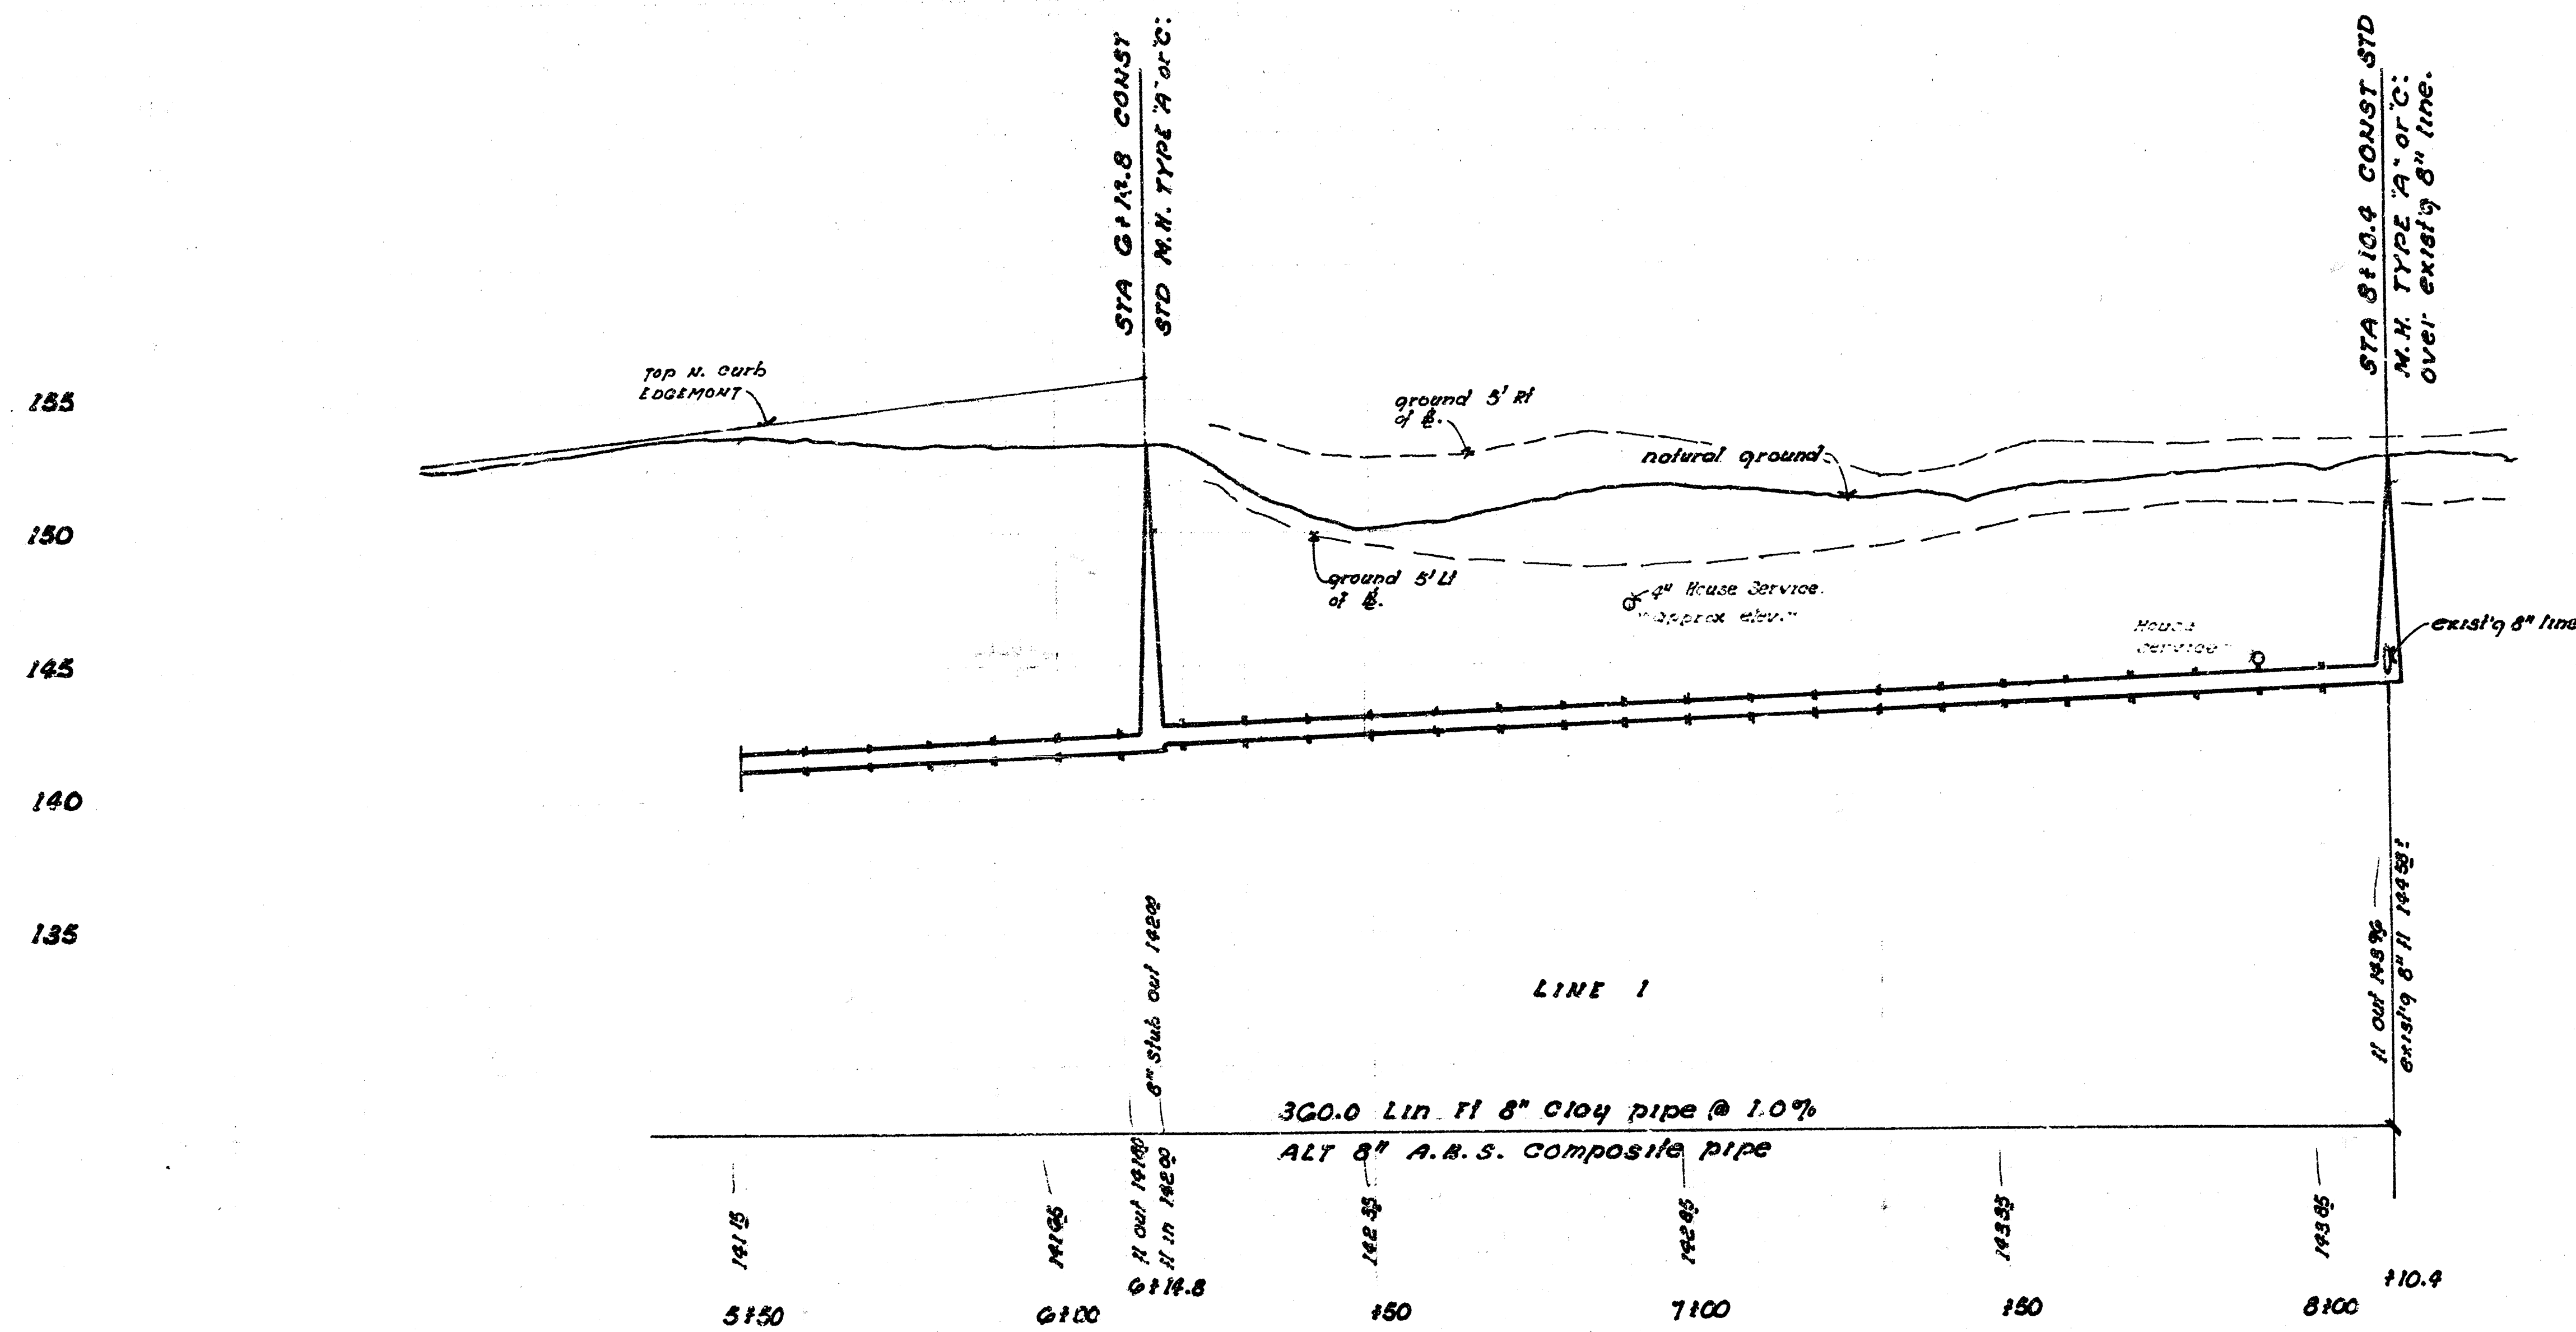

155  
150  
145  
140  
135

