

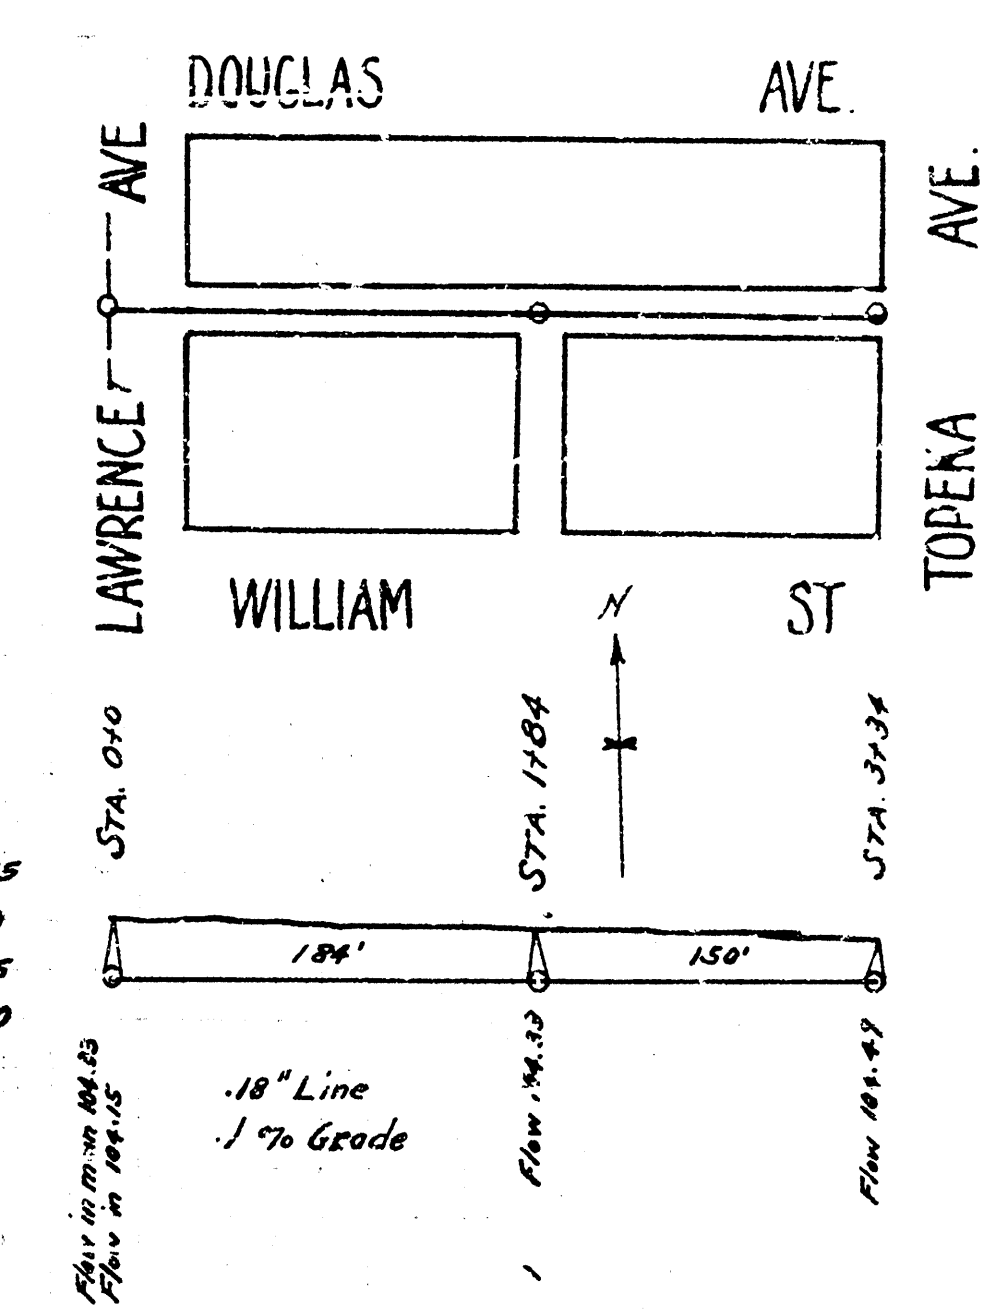
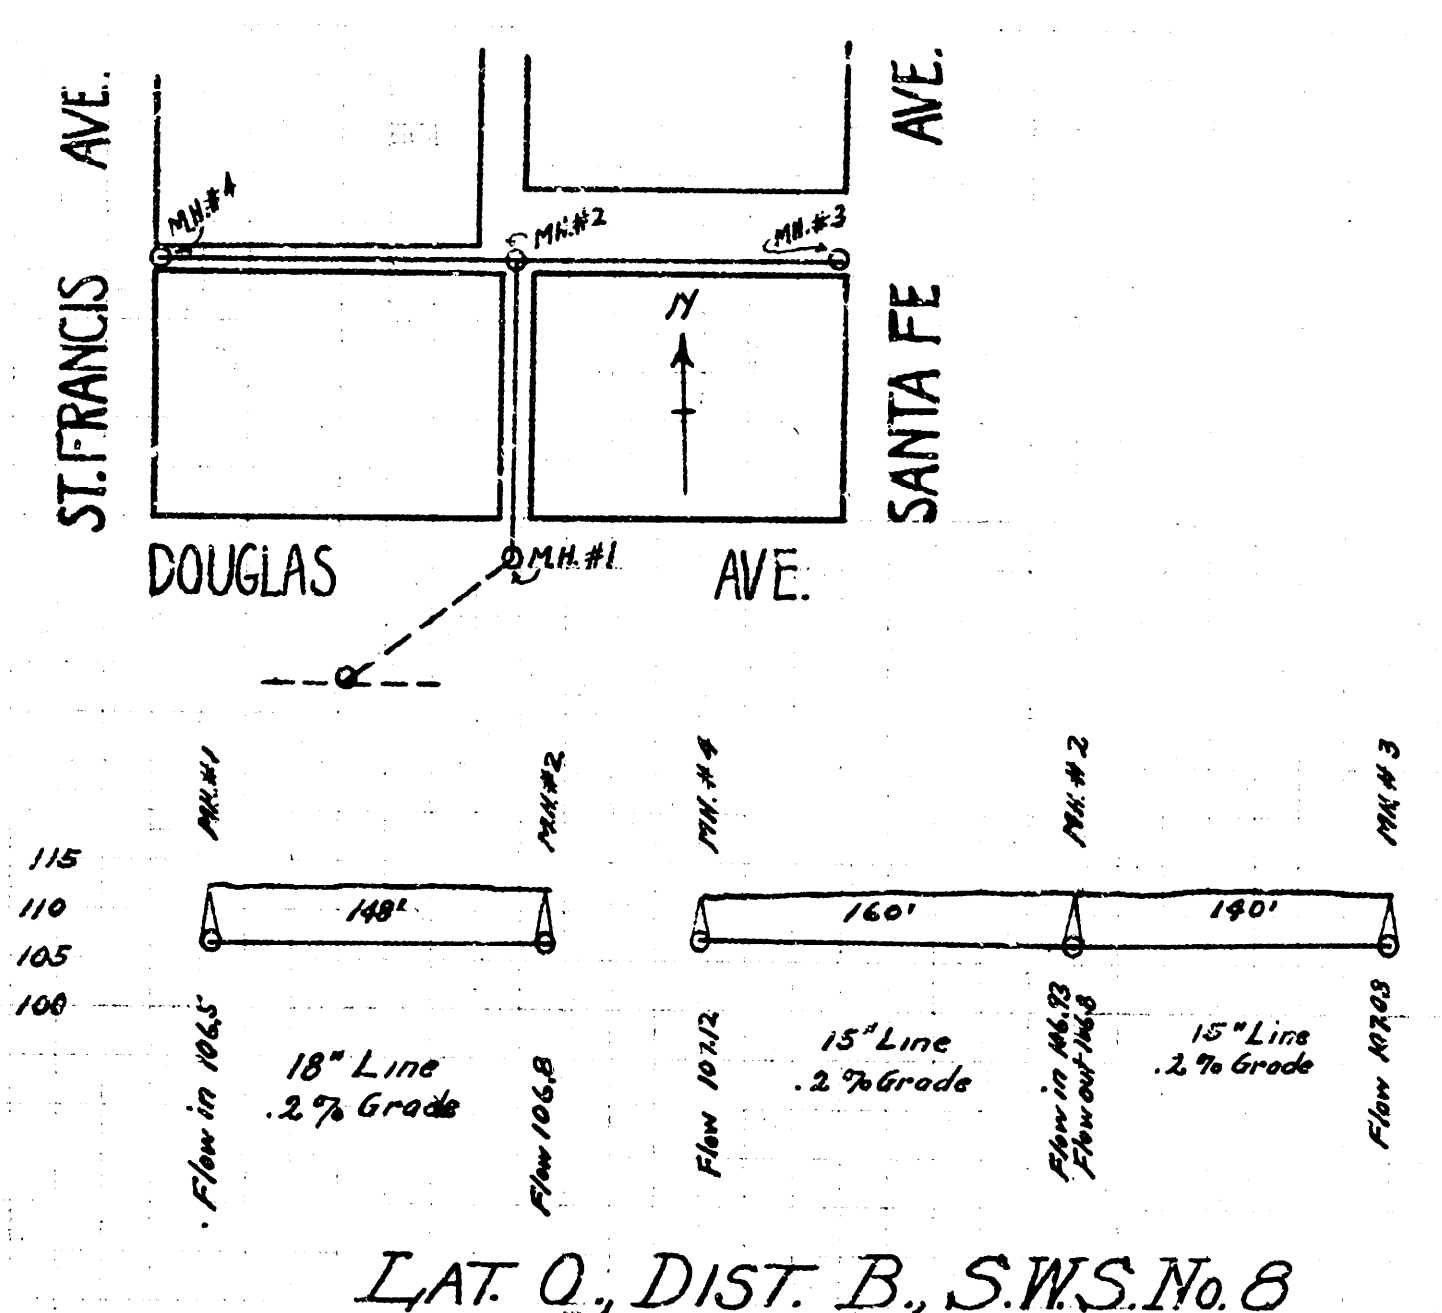


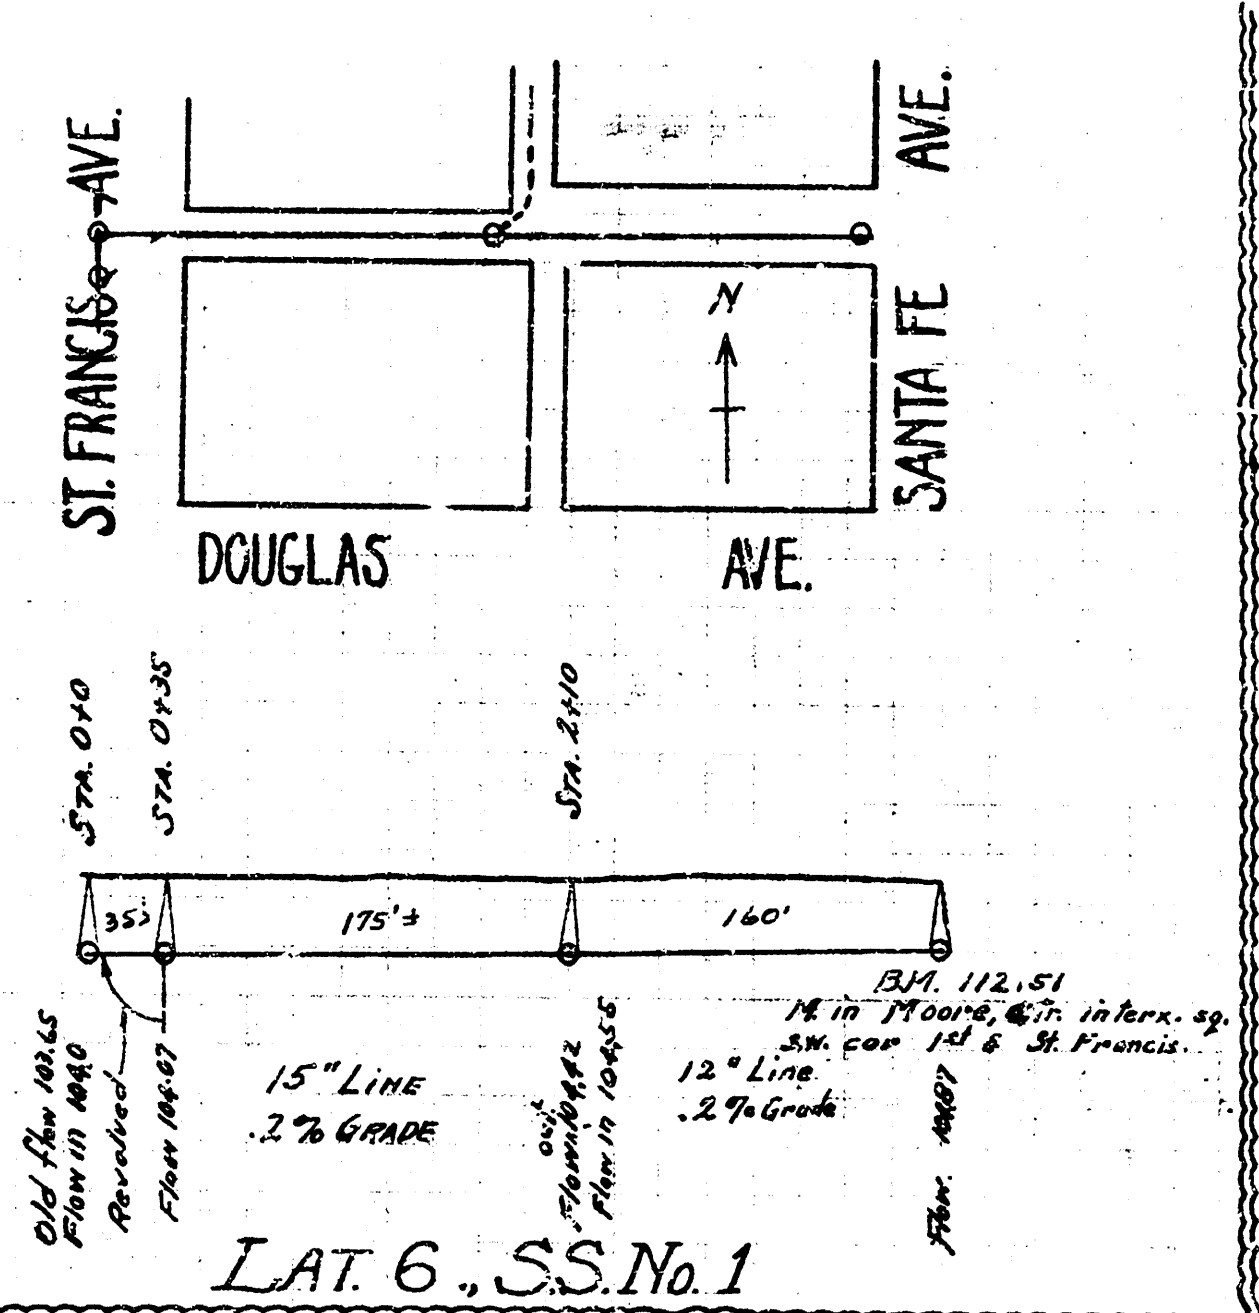

B.M. 110.33 - On south end of
water table under south window
of side of main building
N.W. cor. Topoka & Douglas.

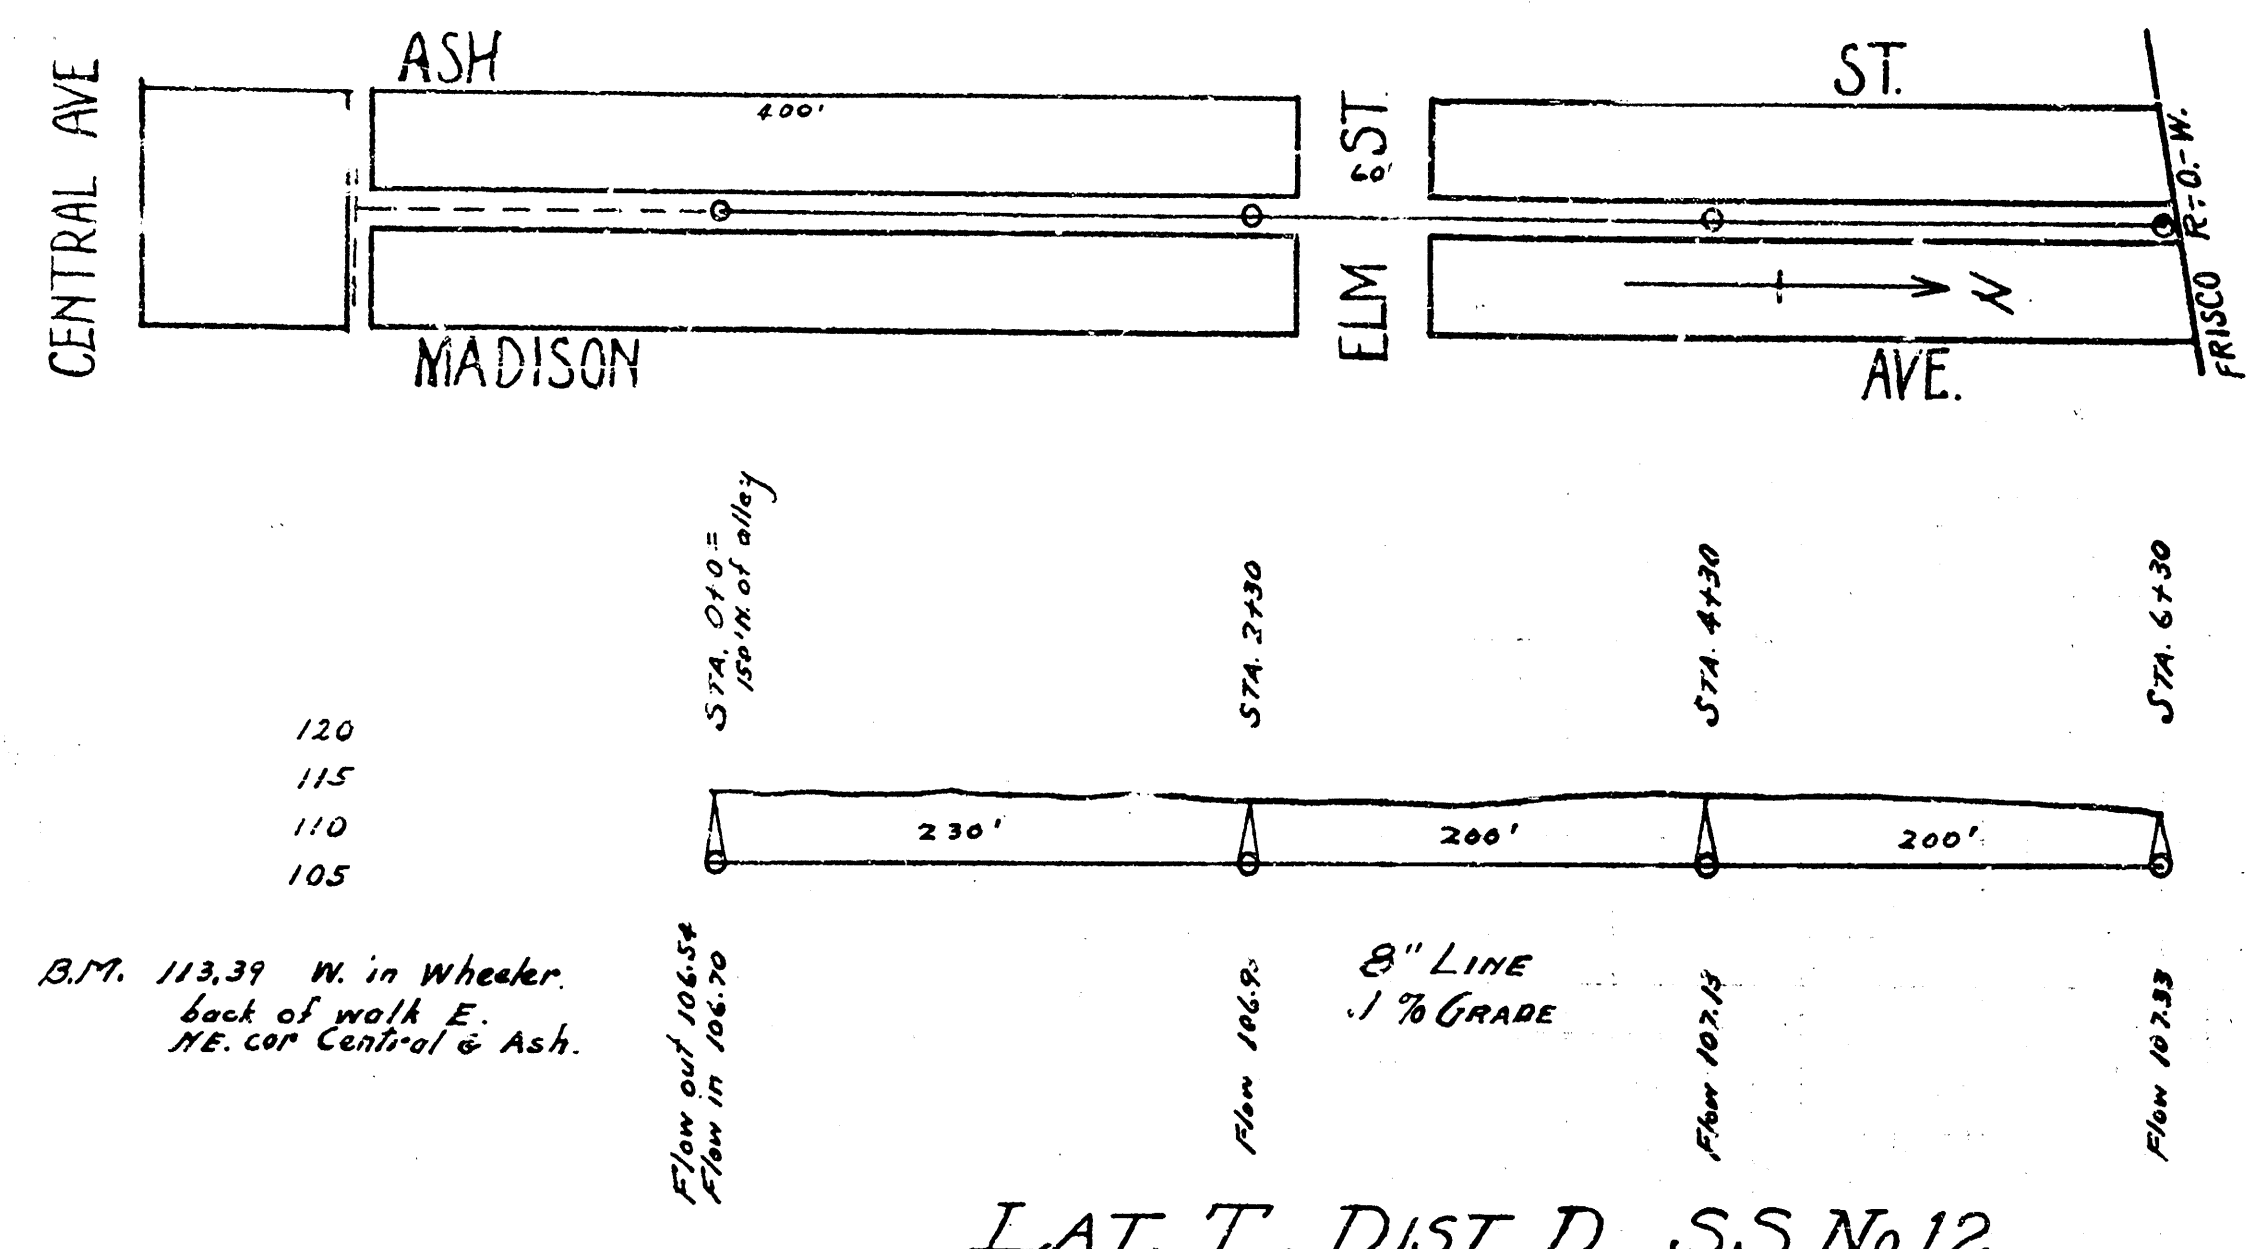