


AS BUILT PLANS

B.M. 132.63 NE COR WK @ NE COR STORE 55 HARRY 100' E CLIFTON.

PLAN SCALE 1" = 40'
 PROFILE SCALE 1" = 40' HOR, 1" = 4' VERTICAL

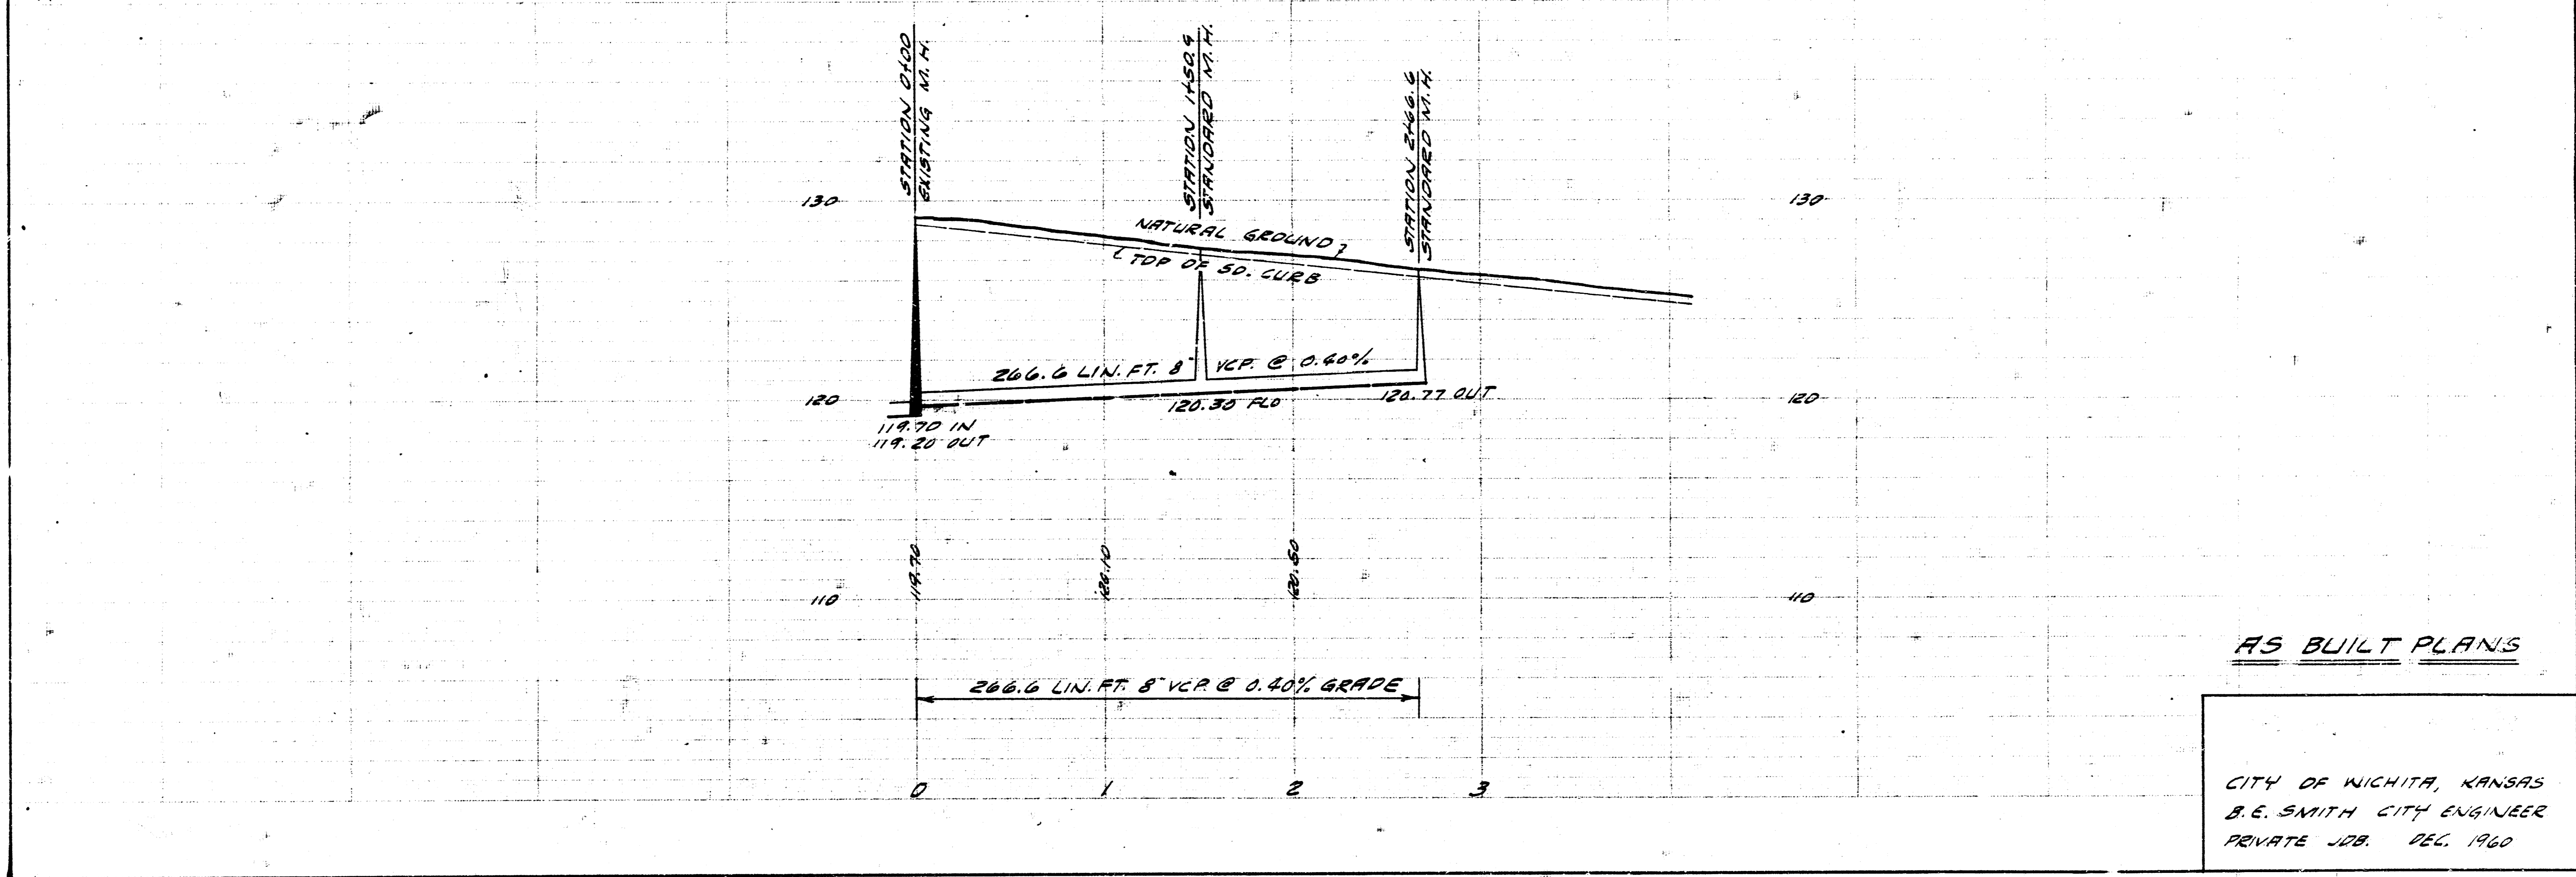

AS BUILT PLANS

CITY OF WICHITA, KANSAS
 B.E. SMITH CITY ENGINEER
 PRIVATE JOB. DEC. 1960