

PRIVATE STORM WATER SEWER IMPROVEMENTS

TO SERVE NEWMARKET SQUARE PHASE 2


CITY OF WICHITA PRIVATE PROJECT NO. 1830 PPS (607861)

CITY OF WICHITA, KANSAS

JAMES L. ARMOUR, P.E.-CITY ENGINEER

INDEX OF SHEETS

1. TITLE SHEET
2. KEYMAP & GENERAL NOTES
- 3-5. PLATS
6. SWS LINE NO. 1
7. SWS LINE NO. 2
8. TYPE 1 CURB INLET DETAILS
9. EROSION CONTROL PLAN
- 10-13. EROSION CONTROL DETAILS

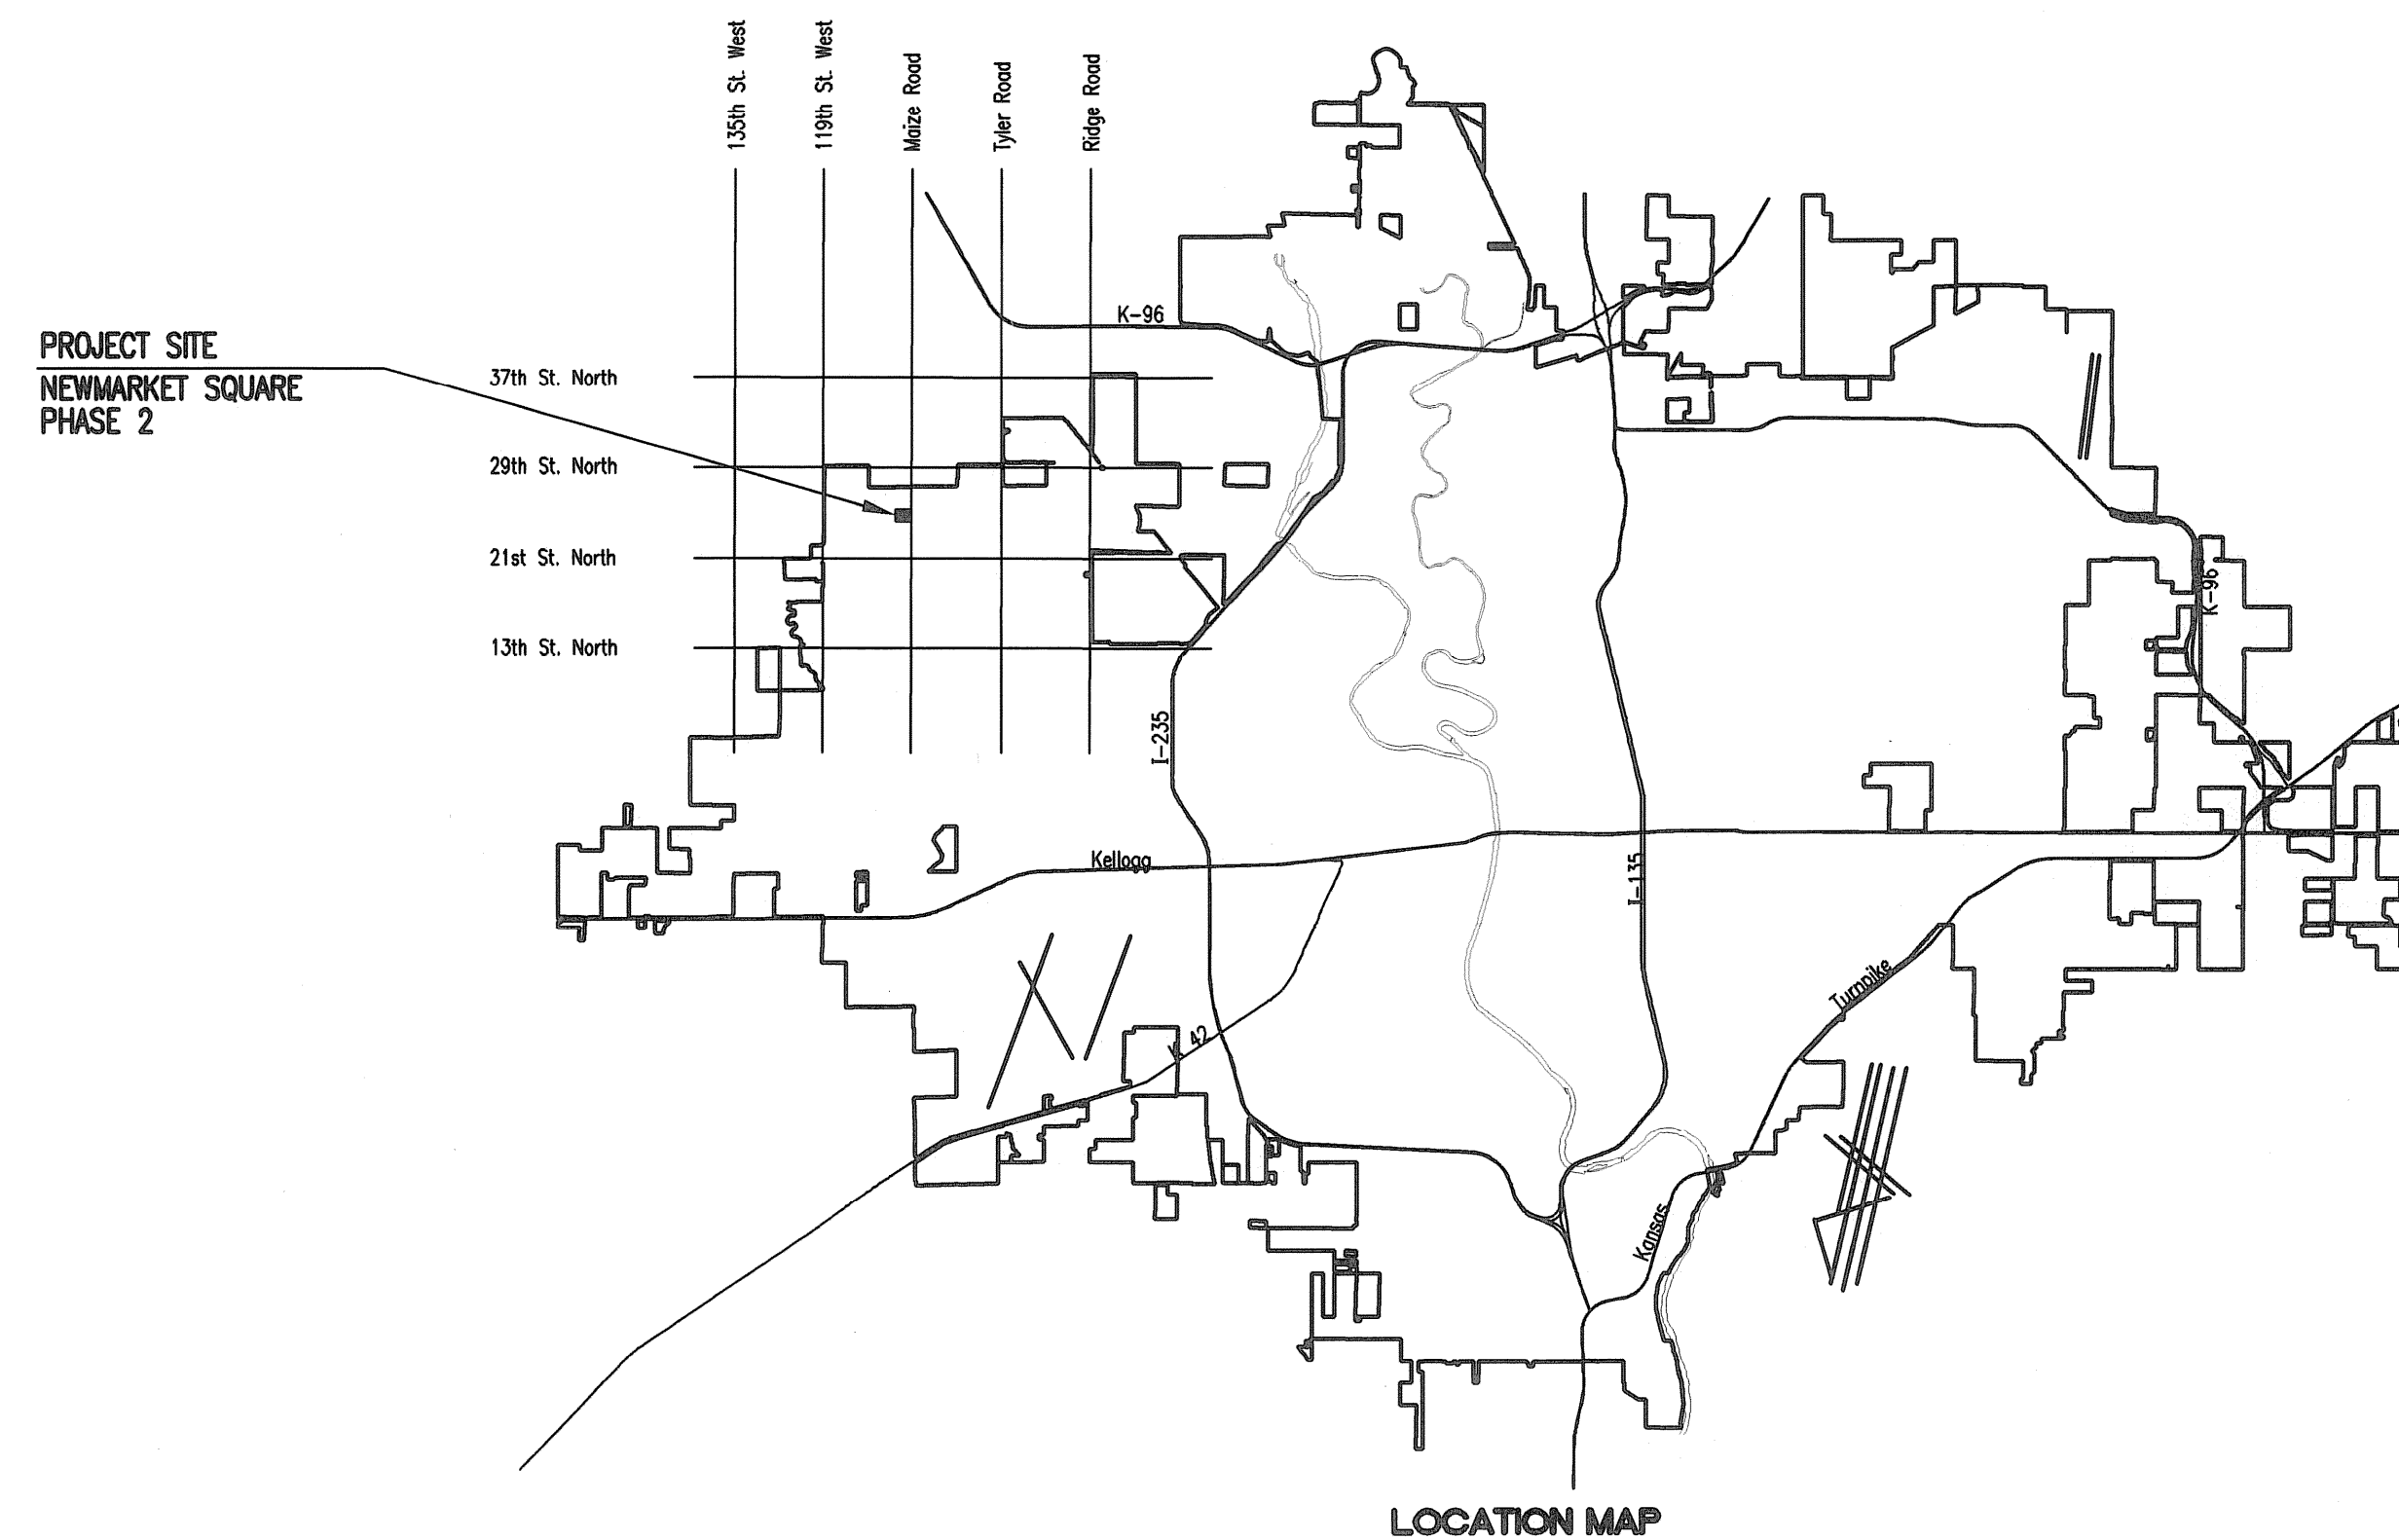

As Built Plans
Contractor: Mies Construction, Inc.
Inspector: Robert Previtera, Reiss &
Goodness, Inc.
pdf by: rp 01 May 20078

APPROVED AS NOTED
By CITY ENGINEER OF WICHITA


Storm Sewers URH 2/19/08

NOTE TO CONTRACTOR

INSPECTION AND TESTING FOR THIS PROJECT IS TO BE PROVIDED BY A LICENSED CONSULTING ENGINEERING FIRM CONTRACTED BY THE OWNER/DEVELOPER. SAID INSPECTION TO BE IN ACCORDANCE WITH THE CITY OF WICHITA STANDARD CONSTRUCTION ENGINEERING PRACTICES AND CERTIFIED BY A LICENSED PROFESSIONAL ENGINEER. NO WORK SHALL BE PERFORMED IN DEDICATED EASEMENTS OR PUBLIC RIGHT-OF-WAY BY THE CONTRACTOR UNTIL SUCH INSPECTION IS ARRANGED FOR AND REQUIRED BONDS HAVE BEEN SUBMITTED TO AND APPROVED BY THE CITY NOR SHALL ANY WORK BE COMMENCED IN DEDICATED EASEMENTS OR PUBLIC RIGHT-OF-WAY WITHOUT WRITTEN AUTHORIZATION BY THE CITY ENGINEER. IMPROVEMENTS PERFORMED UNDER THIS PROJECT SHALL NOT BE ACCEPTED BY THE CITY UNTIL ALL APPLICABLE DOCUMENTATION HAS BEEN SUBMITTED TO THE CITY ENGINEER. THIS MAY INCLUDE: RECORD DRAWINGS, INSPECTION LOGS, TEST DOCUMENTATION, TV TAPES, AND A CERTIFICATE OF COMPLETION. THE ABOVE SHALL BE PERFORMED BY THE CONSULTING FIRM CONTRACTED TO INSPECT THIS PROJECT.

FEBRUARY 2008

PLANS PREPARED BY
PROFESSIONAL ENGINEERING CONSULTANTS, P.A.
ENGINEERS
WICHITA, KANSAS

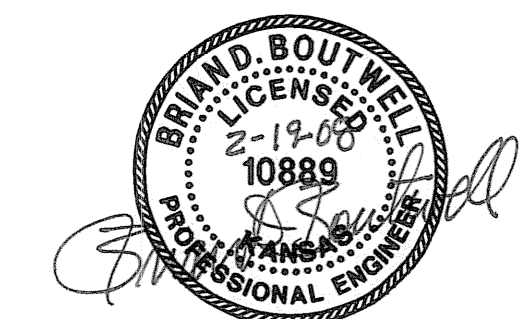

AS BUILT - MAY 1, 2008