

STA. 21+93.56, LINE 1
 8" 90° BEND
 8" 11.25° BEND
 N=1704059.46 E=1664722.75

STA. 23+84.81, LINE 1
 1-45° BEND
 N=1704061.55 E=1664914.02


STA. 24+71.12, LINE 1
 STA. 10+00, LINE 2
 1-8" TEE
 2-8" VALVE ASSY. (SW & NE)
 VALVE BOX EL=1351.7
 N=1704123.25 E=1664974.37

STA. 25+50.72, LINE 1
 1-8" 45° BEND
 N=1704067.58 E=1665031.27


STA. 25+90.68, LINE 1
 1-FIRE HYD. ASSY. (E) L=5'
 VALVE BOX EL=1353.5
 BURY LINE EL=1353.8
 N=1704068.02 E=1665071.23

STA. 26+12.96, LINE 1
 EXIST 16" WATER TAPPING
 SLEEVE & VALVE TO BE
 FURNISHED & INSTALLED BY
 C.O.W. WATER DEPT.
 (CONTRACTOR TO REIMBURSE
 C.O.W.)
 TOP OF VALVE EL=1352.3
 N=1704068.27 E=1665093.59

INSTALL 79.60 LF OF 8" PIPE
 INSTALL 45. BEND
 INSTALL 22.28 LF OF 8" PIPE
 INSTALL 39.96 LF OF 8" PIPE
 INSTALL 86.31 LF OF 8" PIPE
 INSTALL 191.28 LF OF 8" PIPE

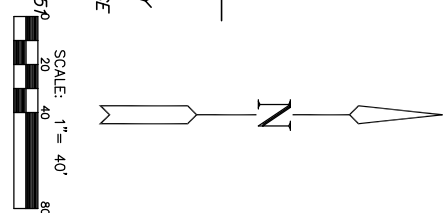

AS-BUILT FEBRUARY 2008

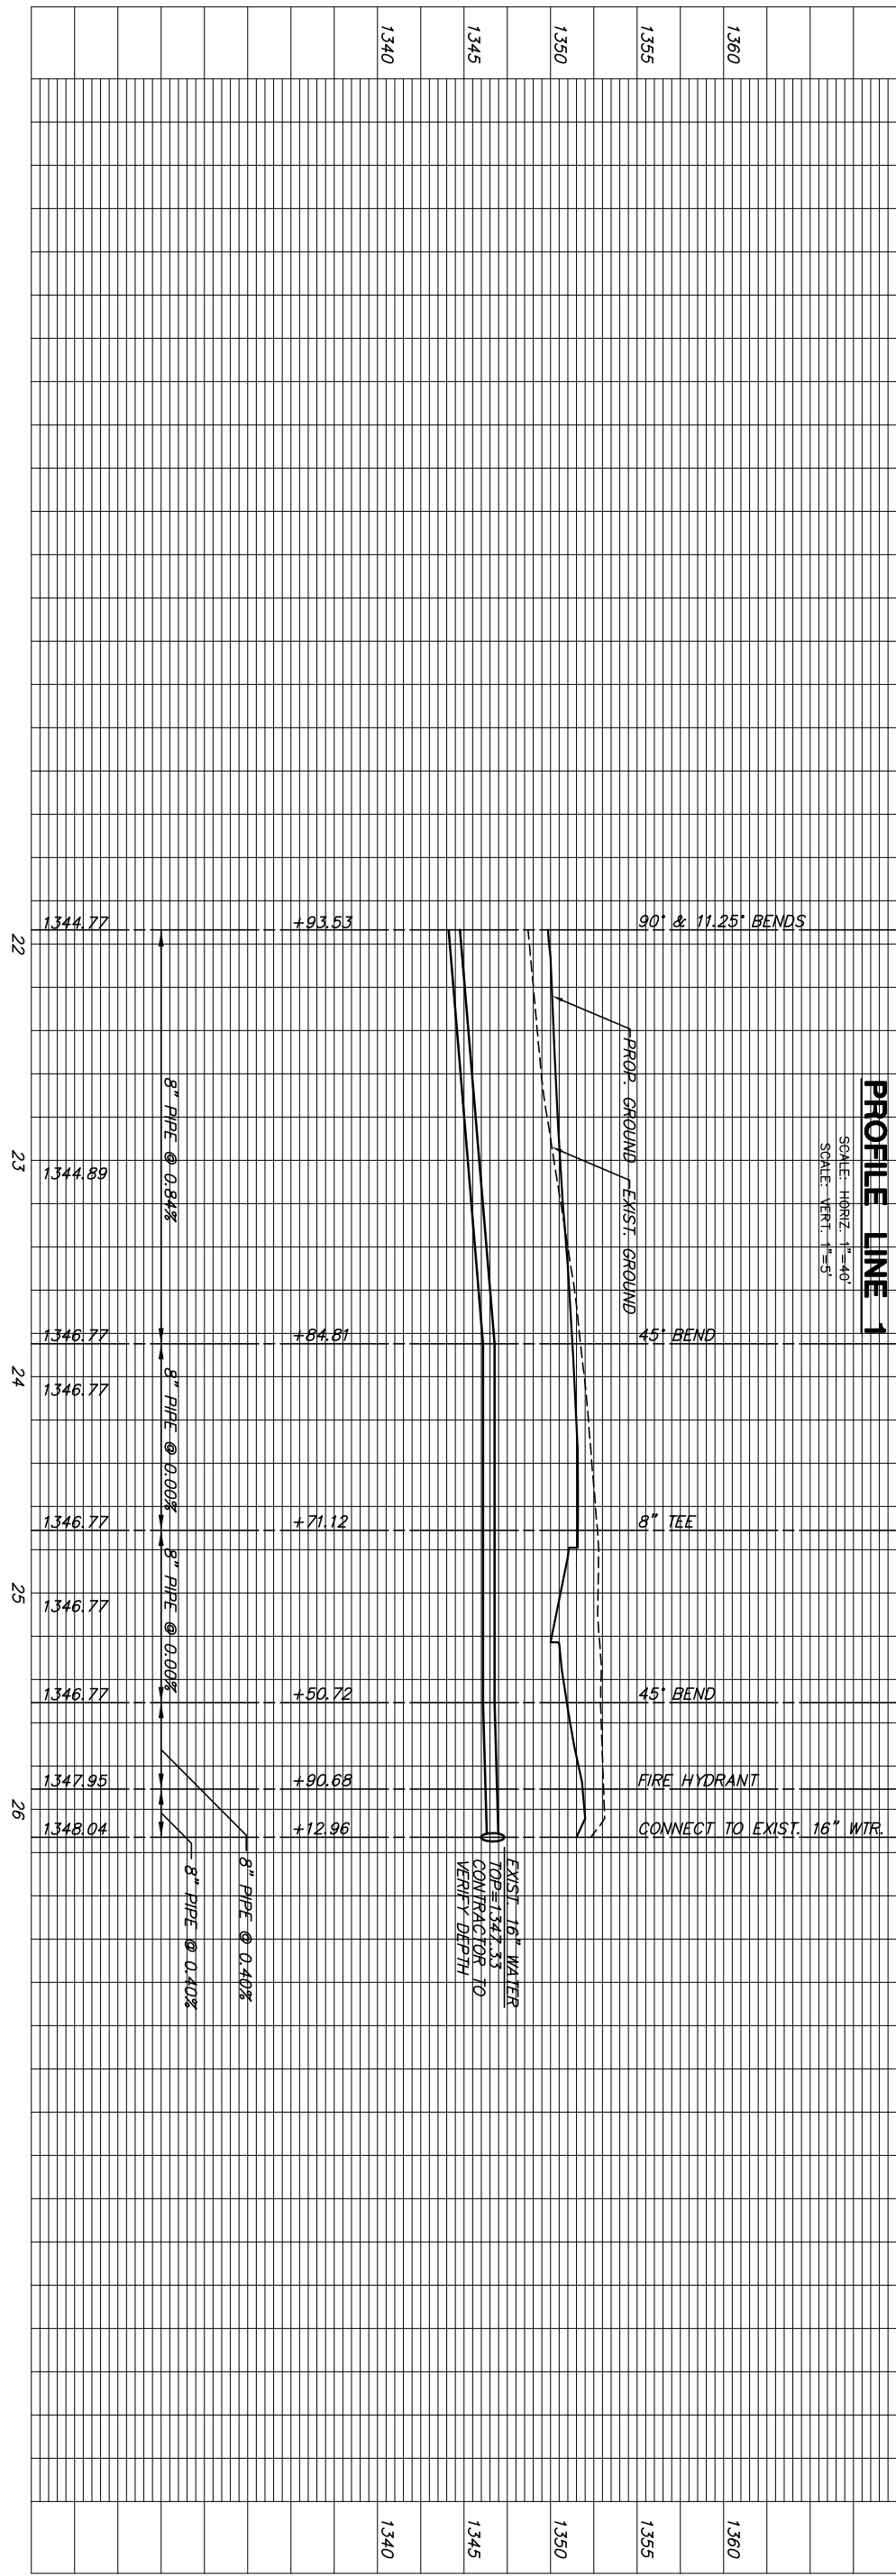

SHEET NO. 5 of 8	ISSUED October 2007	DESIGN BY JWC	DRAWN BY GJA	CHECKED BY GJA	DESIGN BY JWC	DRAWN BY GJA	CHECKED BY GJA	WATER LINE 1 SHEET TITLE 07008 (CO) 07254 (MKEC) PROJECT NUMBER
----------------------------	------------------------	------------------	-----------------	-------------------	------------------	-----------------	-------------------	---

WATER DISTRIBUTION PLANS
THE GROVE AT WICHITA
 LOT 1, BLOCK 1 CAMPUS CREST

MKEC
 ENGINEERING
 CONSULTANTS, INC.
 411 N. WEBB ROAD
 WICHITA, KS. 67206
 316-684-9600