



**SANITARY SEWER PLANS FOR
POWER C.D.C. THIRD ADDITION**

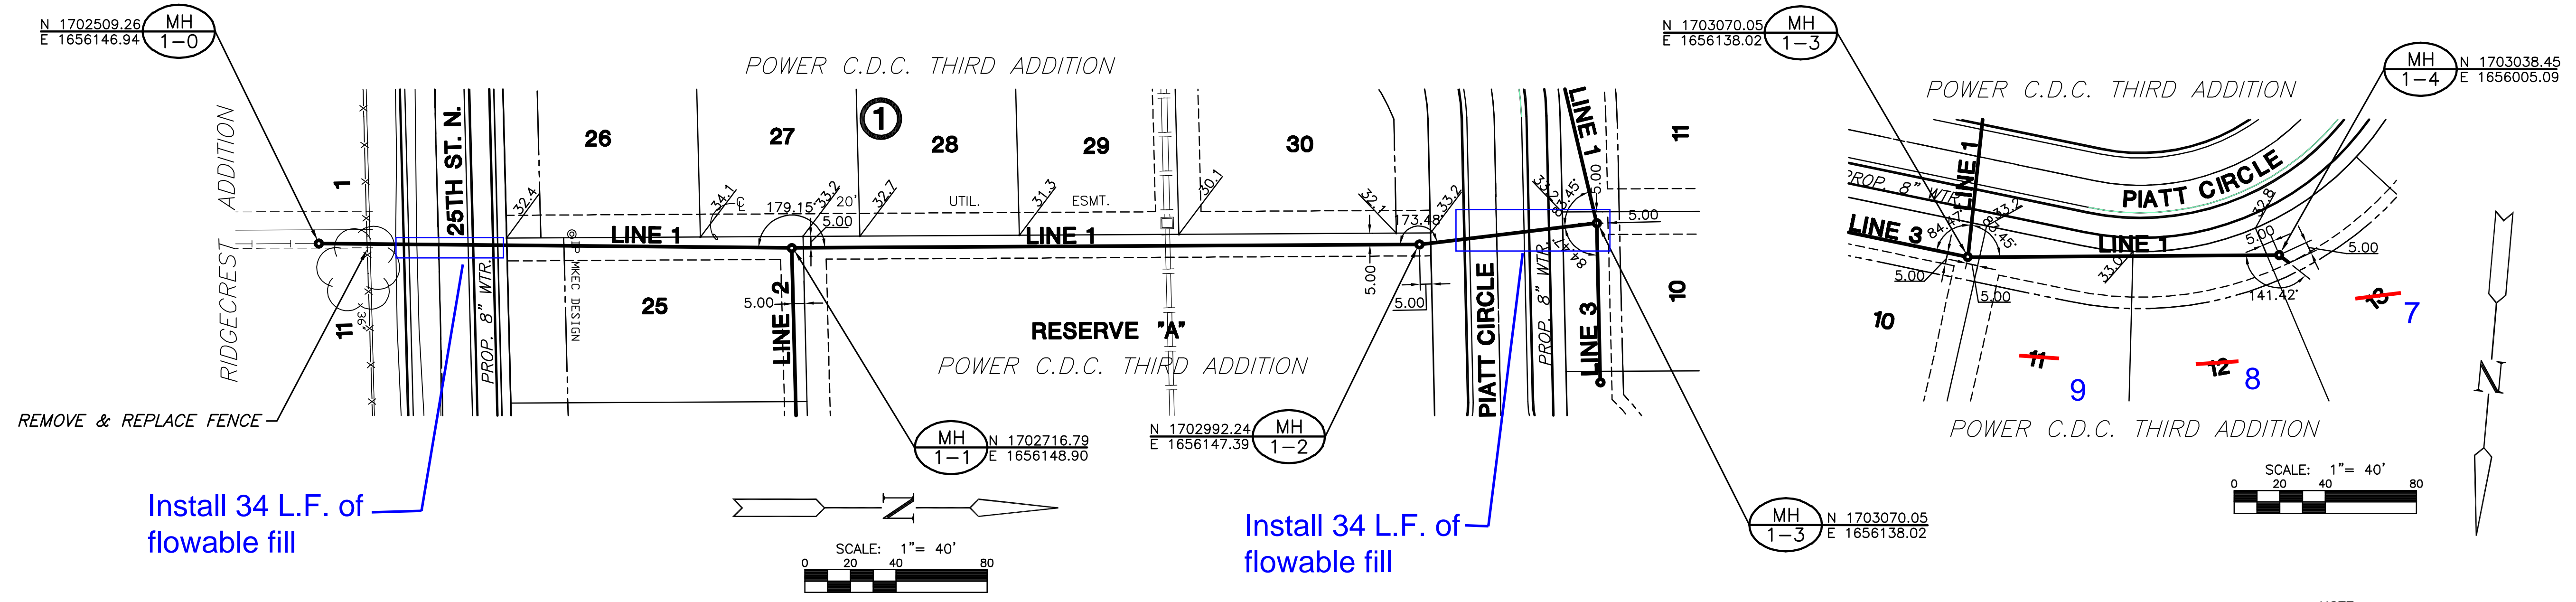

PLAN LINE 1

PLAN LINE 1

NOTE:
TRENCHES TO BE BACKFILLED WITH SAND,
FLUSHED, AND VIBRATED WHEN SEWER RUNS
ALONG FRONT OF LOTS TO WITHIN 5' OF
FINISHED GROUND. (LINE 1 STA 15+61.4-16+98.0)

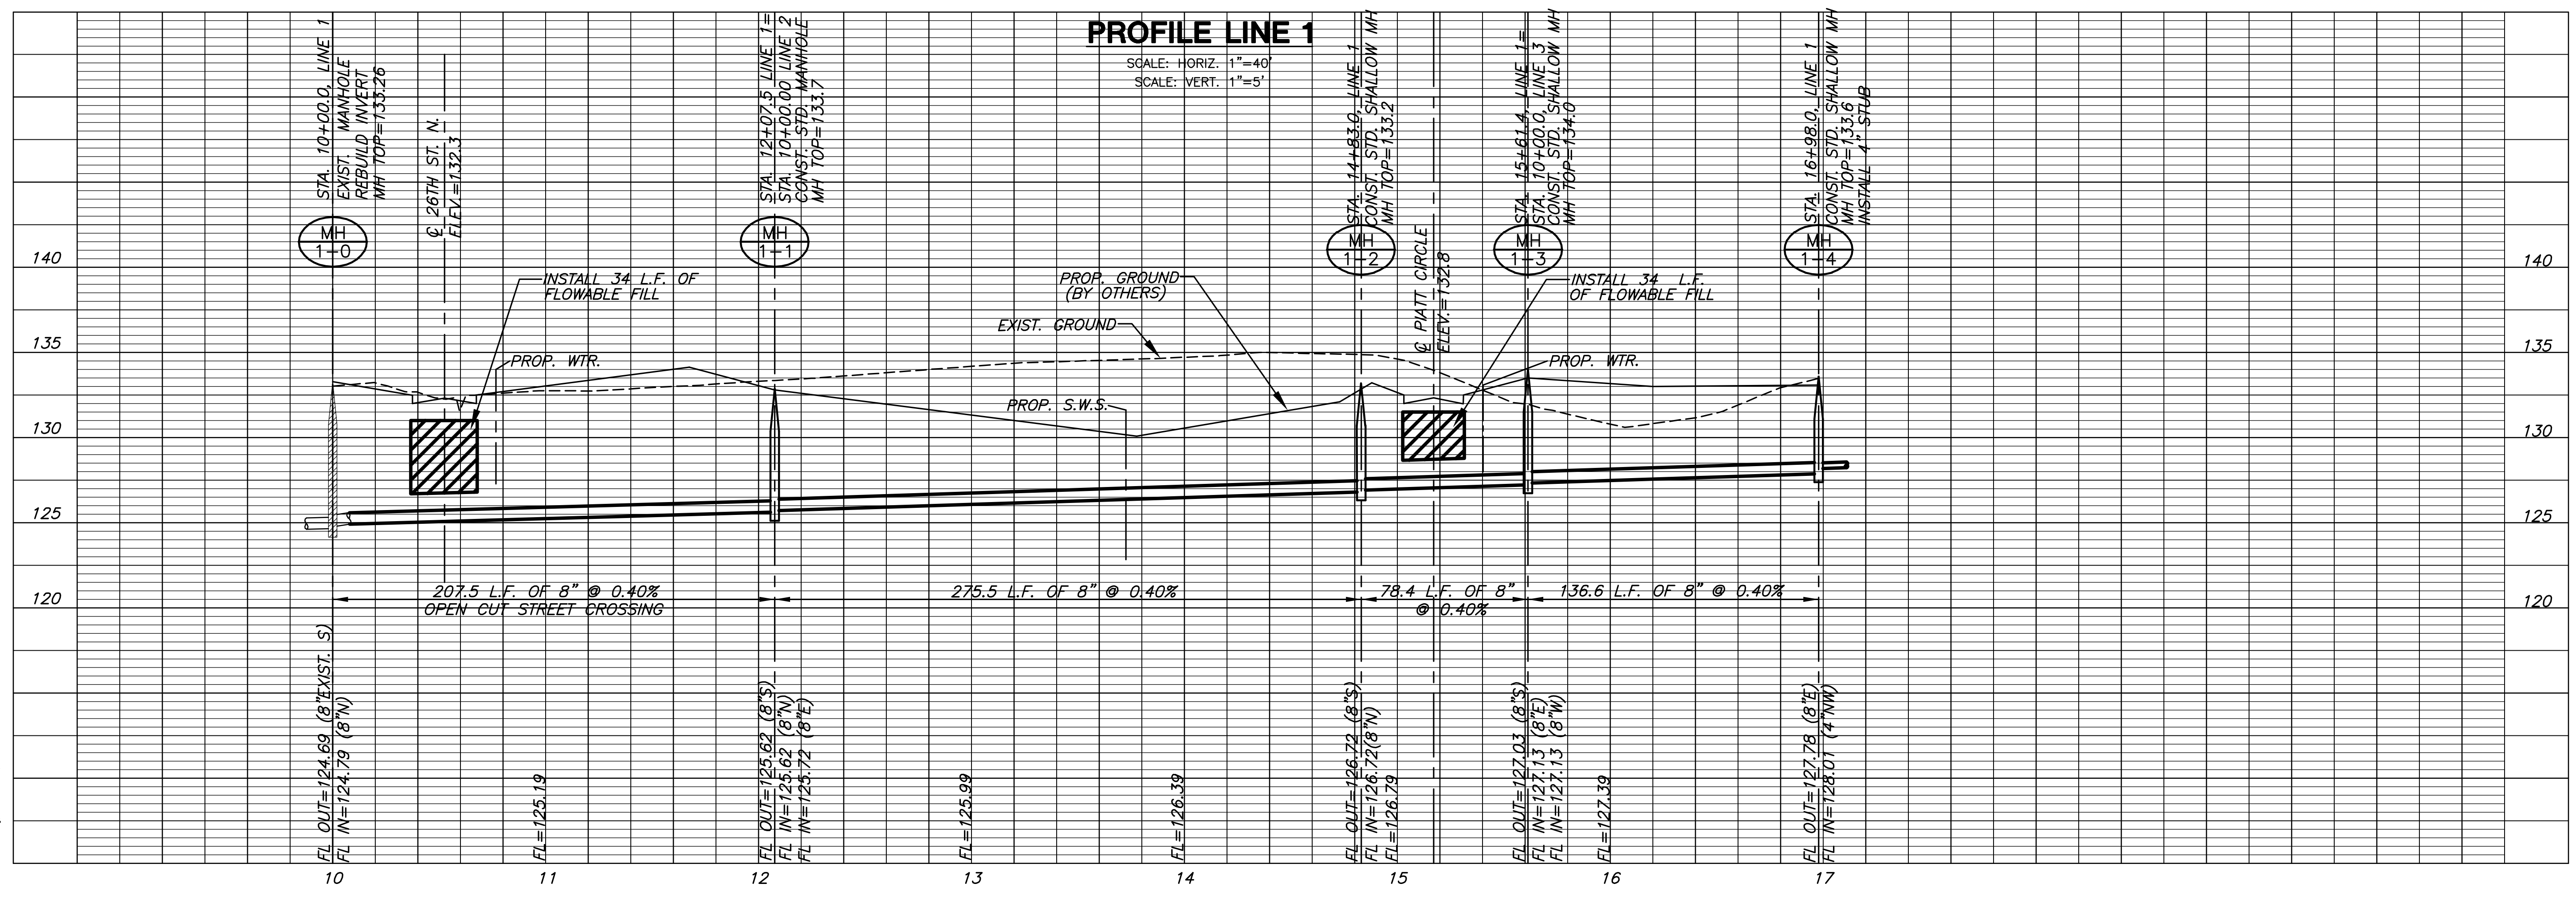

PROFILE LINE 1

SCALE: HORIZ. 1"=40'
SCALE: VERT. 1"=5'

PLAN LINE 1

SHEET TITLE

PROJECT NUMBER

DESIGN BY JTC

DRAWN BY DDG

CHECKED BY GJA

ISSUED October 2007

REVISED

SHEET NO.

3 of 9

PLOT DATE: Wednesday, October 31, 2007 @ 02:07PM

H:\CIVIL\020305\03084.DWG\SAN\03084.LT.DWG