


LATERAL 4, MAIN 7 OF THE NORTHWEST INTERCEPTOR SEWER IN THE CITY OF WICHITA, KANSAS

OCA NO. 744239
CITY OF WICHITA PROJECT NO. 468-83826
JAMES L. ARMOUR, P.E. - CITY ENGINEER

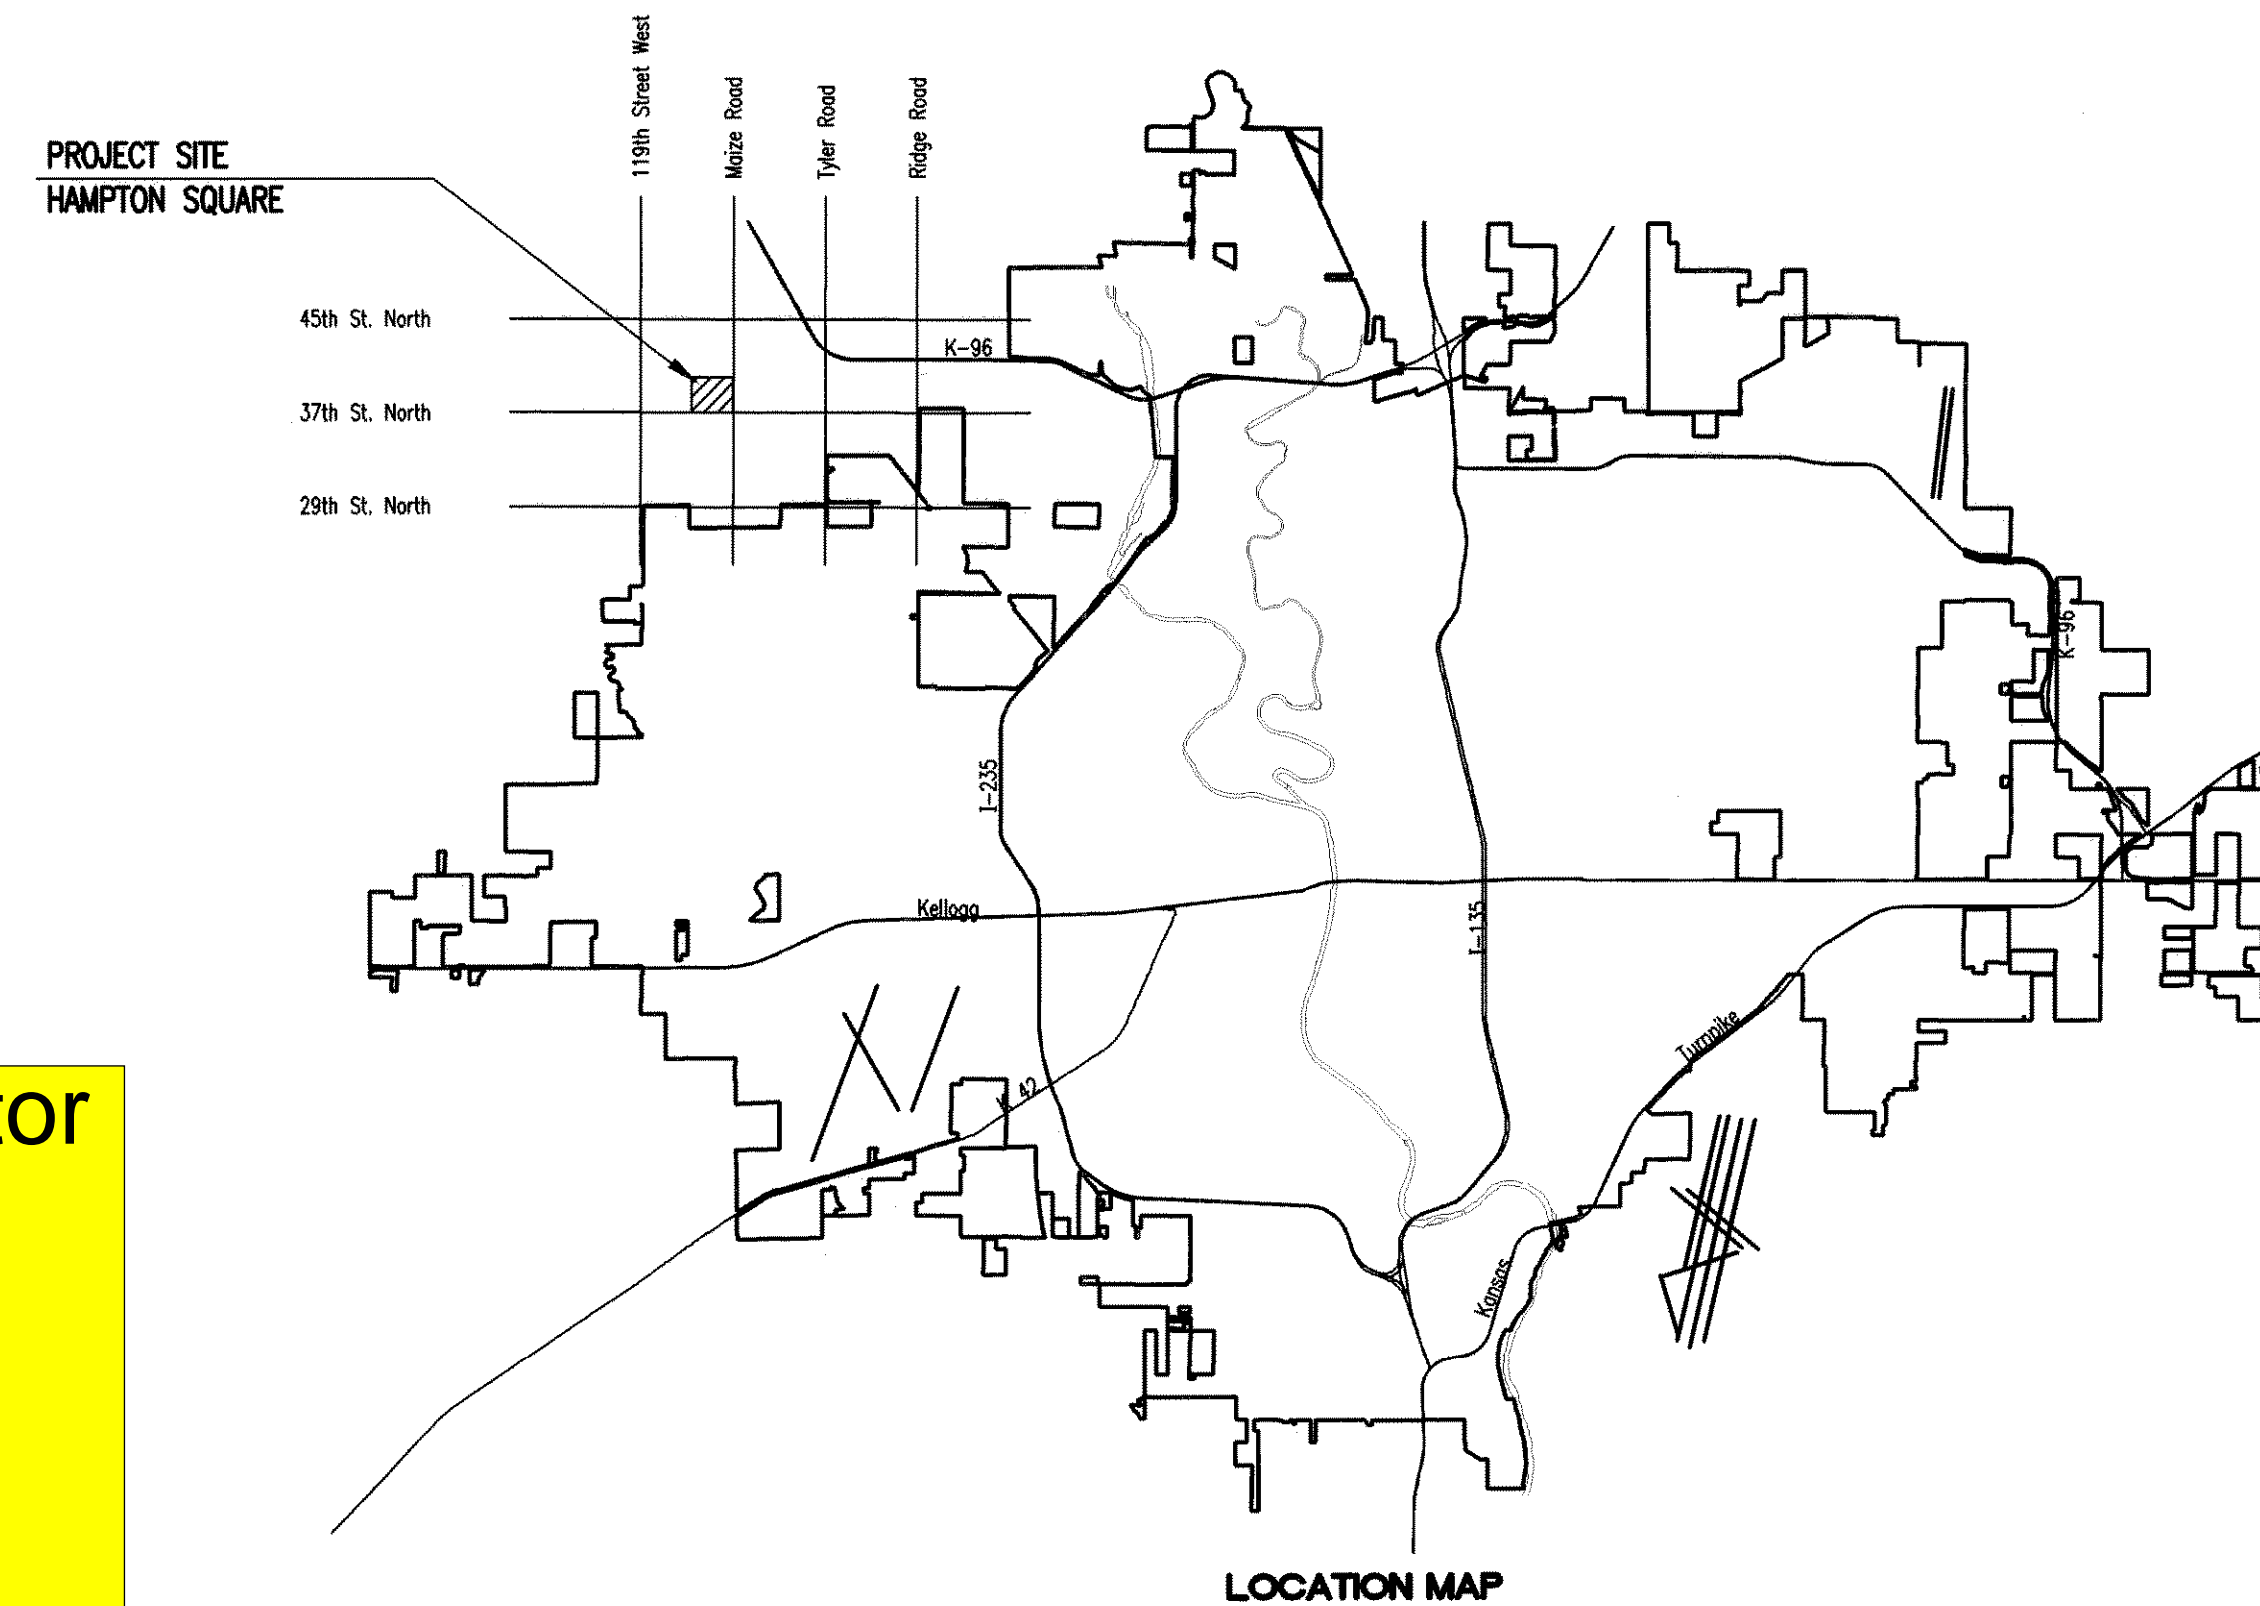

INDEX OF SHEETS

SHEET NO. 1	TITLE SHEET
SHEET NO. 2	KEY MAP AND GENERAL NOTES
SHEET NO. 3	PLAT
SHEET NO. 4	PROJECT COORDINATES
SHEET NO. 5-6	PLAN/PROFILE
SHEET NO. 7	TYPE "P" MANHOLE DETAILS
SHEET NO. 8	FRAME & COVER DETAILS
SHEET NO. 9	RISER DETAILS
SHEET NO. 10-13	SOIL EROSION BMP DETAILS

Nowak Construction Co., Inc. - Contractor
 Shearer, City - Inspector
 Released 2/2/08
 As-Built
 Riser & Stubs
 .pdf by JDL 4/21/08

SEPTEMBER 2007

PLANS PREPARED BY
PROFESSIONAL ENGINEERING CONSULTANTS, P.A.
 ENGINEERS
 WICHITA, KANSAS

