


- = FENCE REMOVAL & REPLACEMENT
- = SIDEWALK REMOVAL & REPLACEMENT
- = TREE TRIMMING

NOTE:
CONTRACTOR SHALL NOT MAKE ANY SANITARY SEWER SERVICE CONNECTIONS
UNTIL SEWER MAINS HAVE BEEN TESTED AND ACCEPTED BY THE ENGINEER AND
THE CITY OF WICHITA.

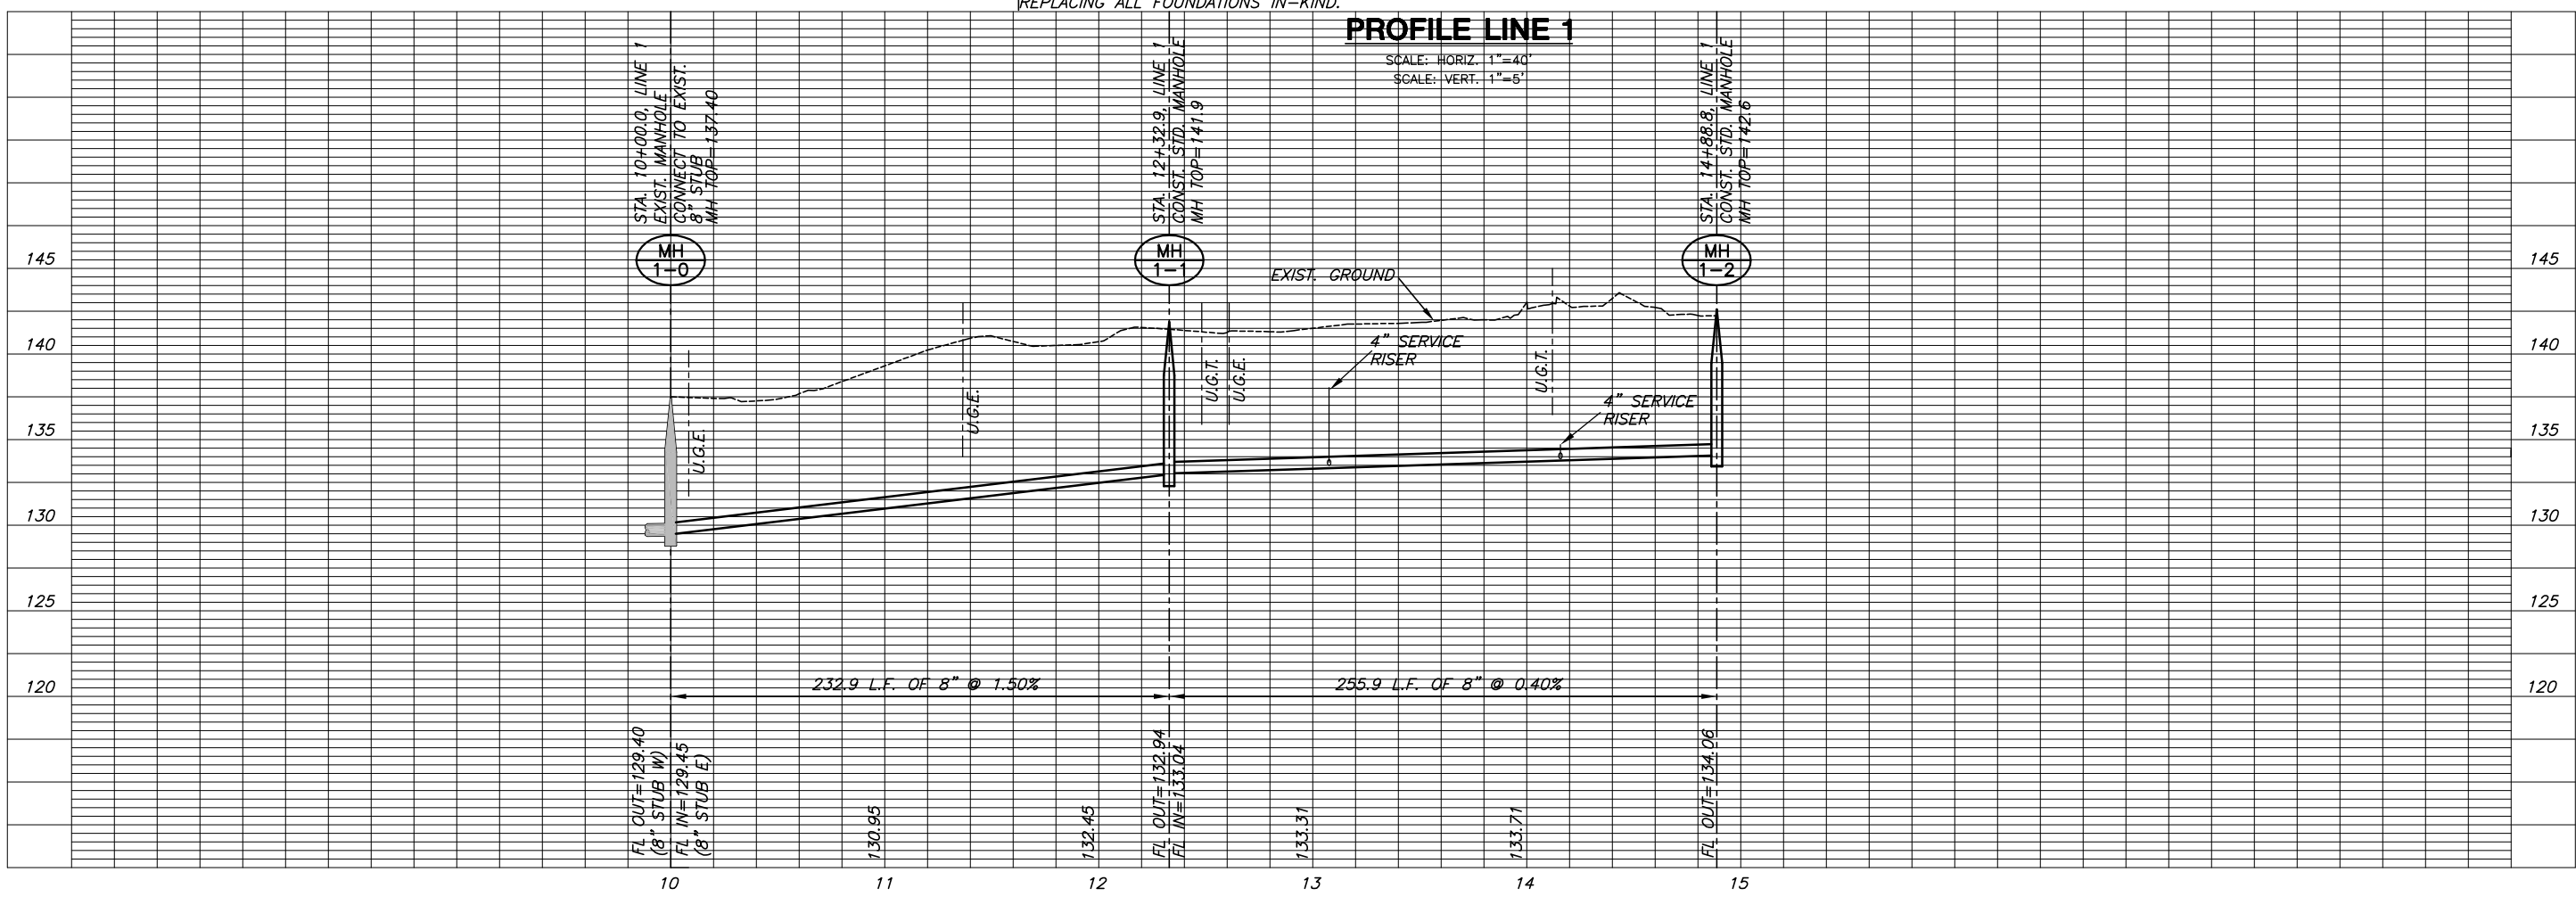

PLOTFILE: Friday, March 28, 2008 @ 11:32AM

J:\CIVIL\06635\DWG\SAN\PHASE 2\06635B1.DWG

LINE 1
SHEET TITLE
06635
PROJECT NUMBER

SRS
DESIGN BY
TKL
DRAWN BY
MAB
CHECKED BY

ISSUED
February 2008
REVISED

See As Built
Details Above For
SS Service Lines.

SHEET NO.
5 of 9