


**PHASE 2 SANITARY SEWER PLANS FOR
SALVATION ARMY
HIAWATHA CAMPUS**

**BUBBLE
MAP**
SHEET TITLE
PROJECT NUMBER
06635

DESIGN BY **SRS**
DRAWN BY **TKL**
CHECKED BY **MAB**

ISSUED **February 2008**
REVISED
As Built: 5-15-08
No Changes Made.

SHEET NO.
6 of 9

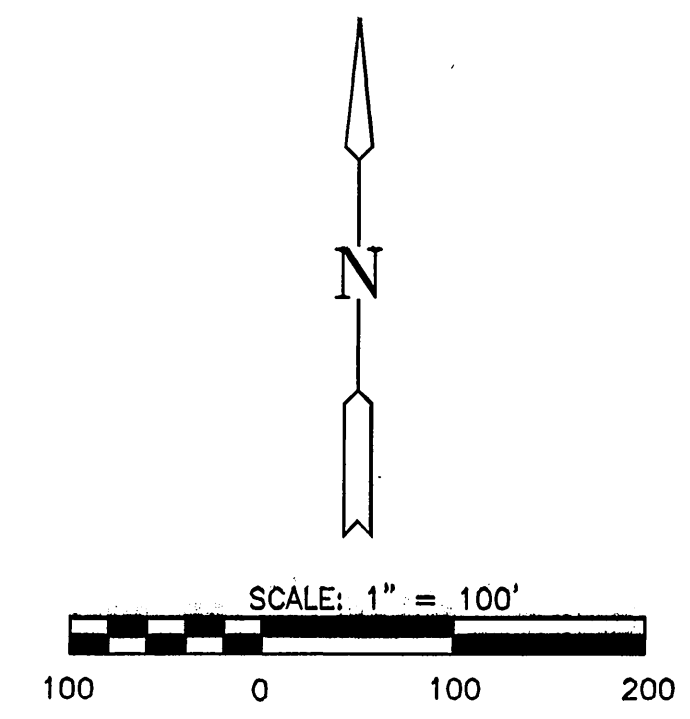

SANITARY SEWER LINE POINTS			
POINT NO.	NORTHING	EASTING	DESCRIPTION
200	99562.67	100749.22	EX. MANHOLE *
201	99551.31	100981.80	MANHOLE
202	99752.46	101140.00	MANHOLE

* NOTE: CONTRACTOR SHALL
FIELD VERIFY LOCATION OF
MH 200 PRIOR TO
BEGINNING CONSTRUCTION.

CONTROL POINTS			
POINT NO.	NORTHING	EASTING	DESCRIPTION
100	99962.11	100009.23	PI
101	100000.00	99999.98	PK NAIL
102	99990.90	100705.49	PK NAIL
103	98664.04	100038.98	PI

