

WATER DISTRIBUTION SYSTEM IMPROVEMENTS


TO SERVE

ETHANOL PRODUCT CORP HEADQUARTERS

PRIVATE PROJECT NO. 1295 PPW (607853)

CITY OF WICHITA, KANSAS

JAMES L. ARMOUR, P.E. - CITY ENGINEER

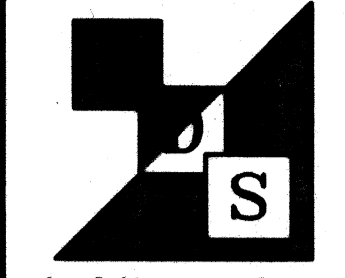


Architectural
Development
Services, L.L.C.
P.O. Box 48405
Wichita, Kansas 67201
Phone: 316 988-4343
Fax: 316 988-9064



INDEX OF SHEETS

| | |
|--------------------|---------------------------------|
| SHEET NO. C4.1 | TITLE SHEET |
| SHEET NO. C4.2 | KEY MAP AND GENERAL NOTES |
| SHEET NO. C4.3 | PLAN/PROFILE |
| SHEET NO. C4.4 | PLAN/PROFILE |
| SHEET NO. C4.5 | STANDARD WATER ASSEMBLY DETAILS |
| SHEET NO. C4.6 | BACKFILL DETAILS |
| SHEET NO. C5.2-5.4 | SOIL EROSION BMP DETAILS |
| SHEET NO. C6.1 | PLAT |

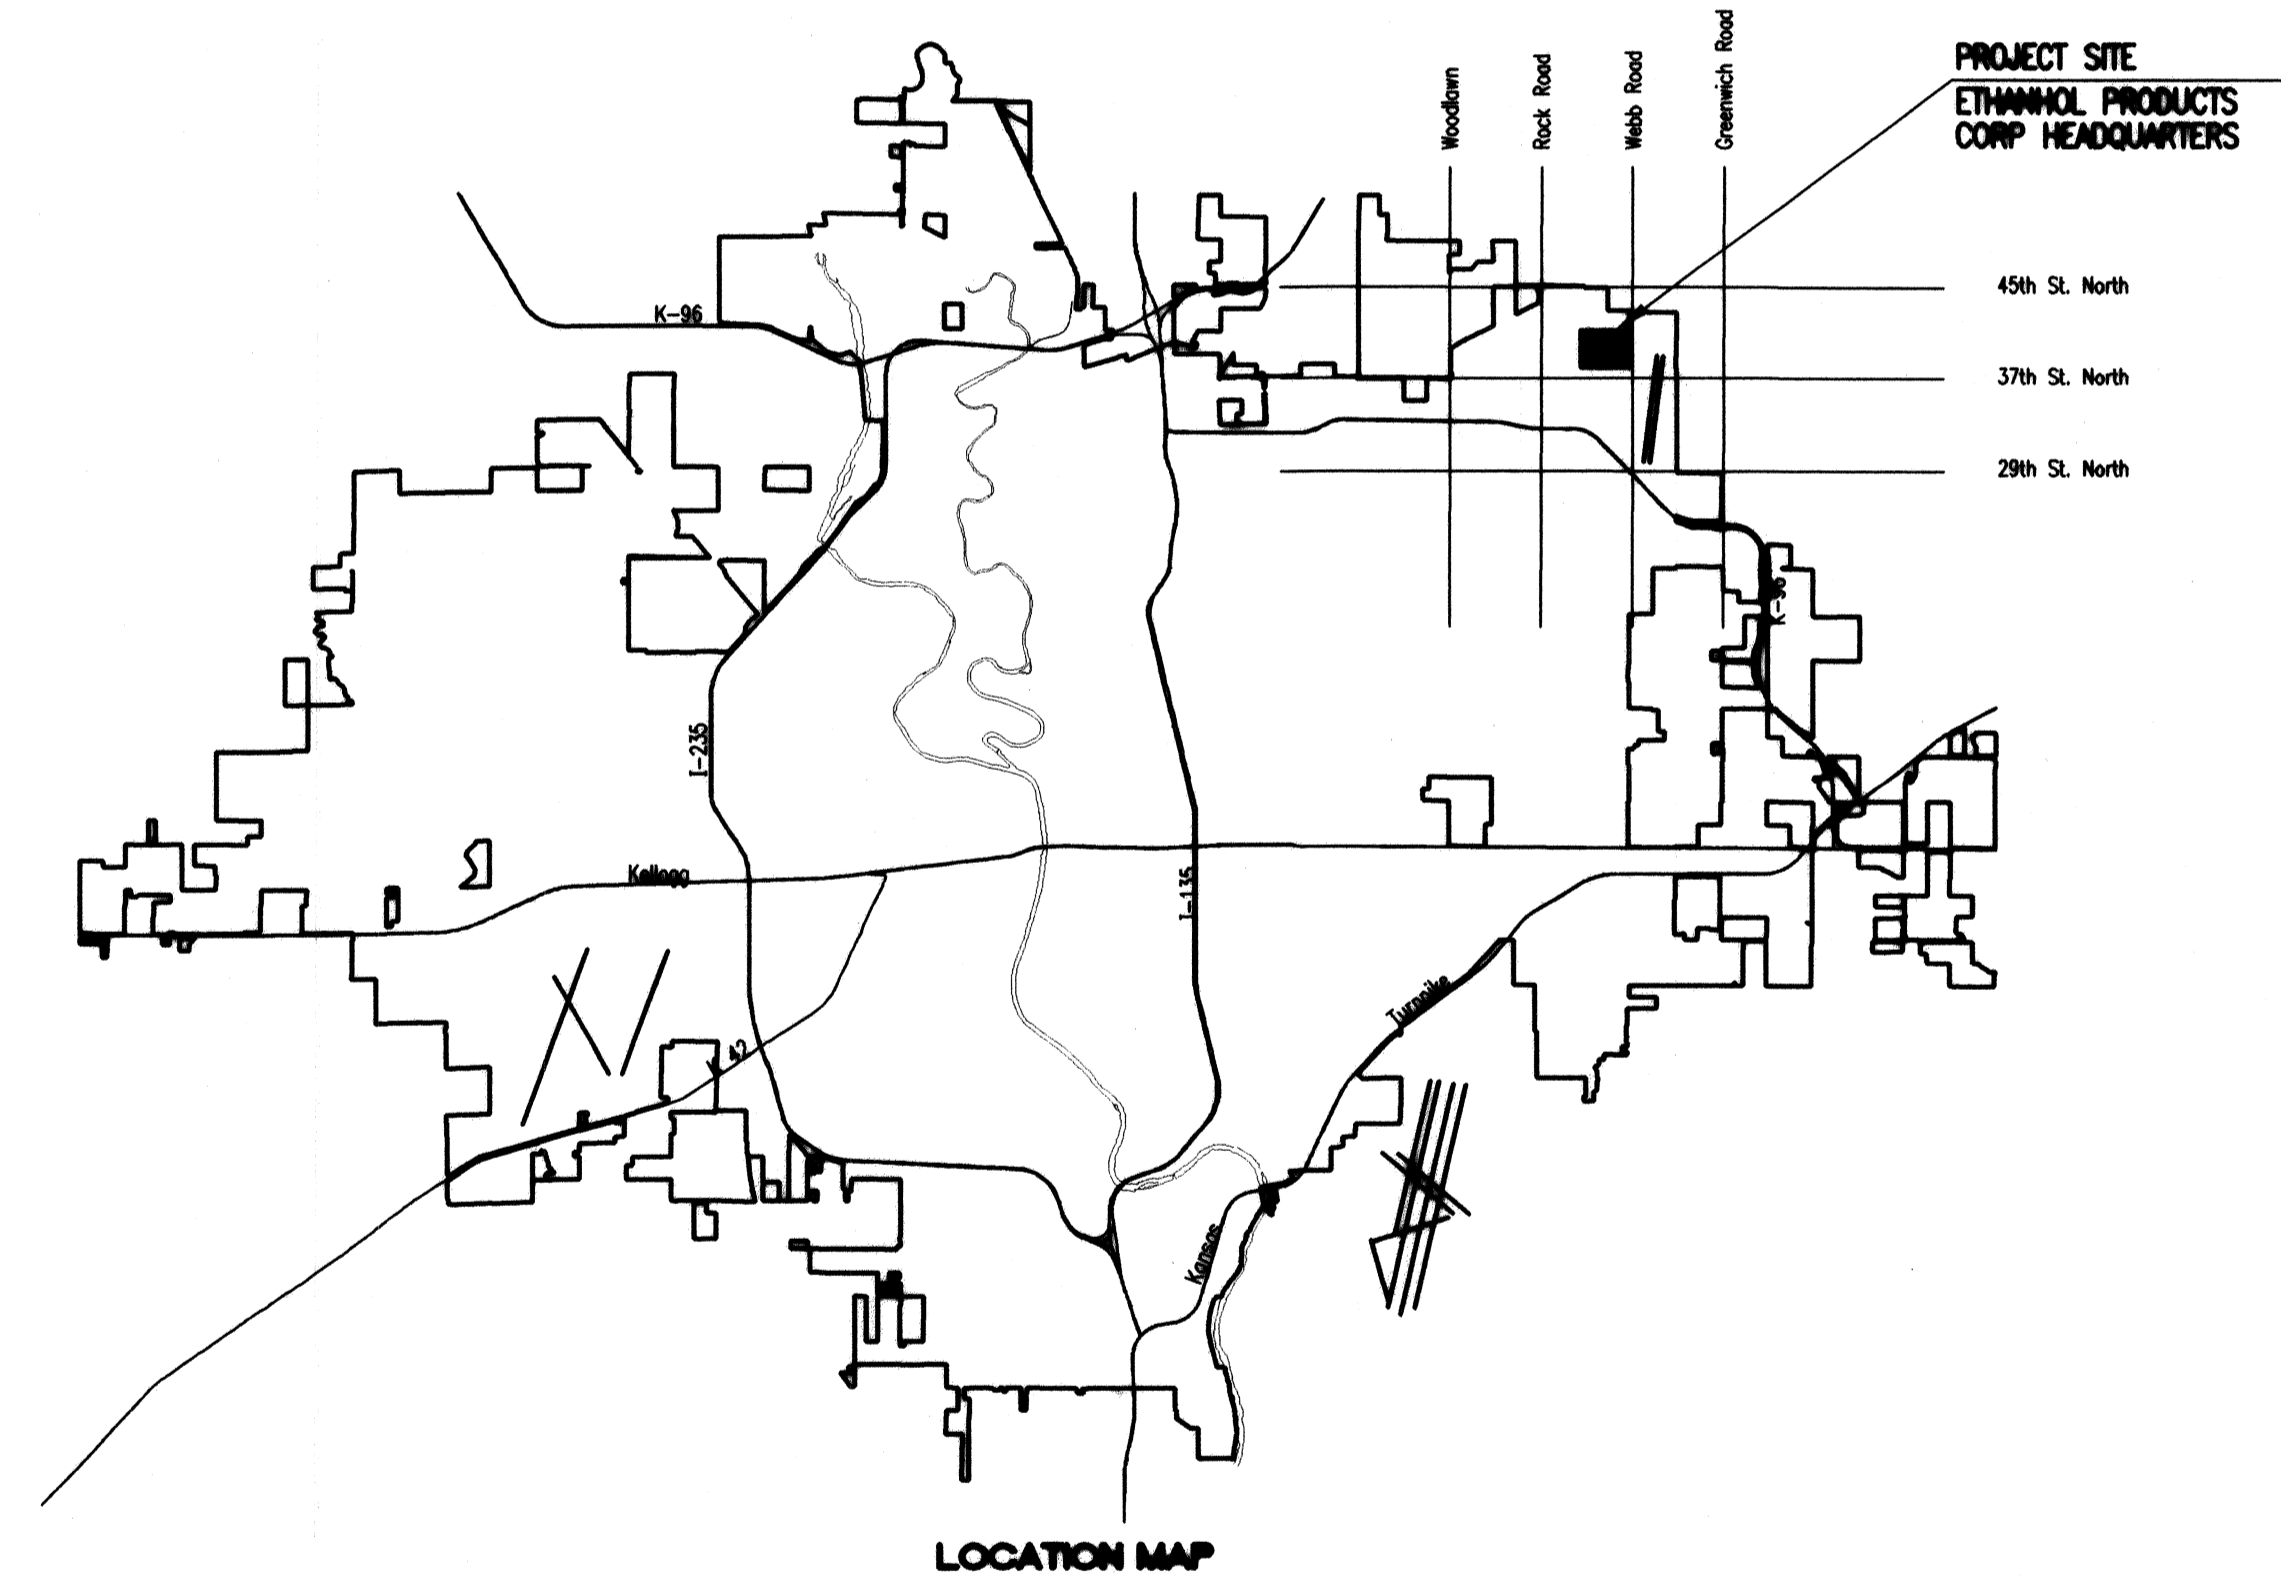

APPROVED AS NOTED
 BY CITY ENGINEER OF WICHITA,
 BY WICHITA WATER & SEWER DEPARTMENT,
 & BY WICHITA FIRE DEPARTMENT

Water Mains (Public Works) *[Signature]* 3/8/07
 Water Mains (Water and Sewer Dept.) *[Signature]* 3/8/07
 Fire Prot. Line *[Signature]* 3/8/07

NOTE TO CONTRACTORS

PUBLIC PROPERTY:
 Inspection and testing for the waterline is to be provided by a Licensed Consulting Engineering Firm under contract with the Owner/Developer. Said inspection is to be in accordance with the City of Wichita standard construction engineering practices and certified by a Licensed Professional Engineer licensed in the State of Kansas. No work shall be performed in dedicated easements or public right-of-way by the Contractor without such inspection nor shall any work be commenced without written authorization by the City Engineer. All Construction and Materials shall comply with the City of Wichita Specifications and Standards (on file and available in the City Engineer's Office).

PRIVATE PROPERTY:
 Installation and testing for the fire protection line is to be performed by a City of Wichita licensed fire protection contractor in accordance with the fire codes as adopted by the City of Wichita. All materials and construction practices for the fire protection line shall comply with the fire codes as adopted by the City of Wichita (available from the City of Wichita Fire Department). The Contractor shall not commence work without notification and approval of the Wichita Fire Department.
 Inspection of the fire protection line is to be provided by the City of Wichita Fire Department and by a licensed Consulting Engineering Firm under contract with the Owner/Developer.
 The contractor shall not start work until the project inspector is assigned to the project and present on the site. Any work done without inspection will be required to be uncovered for inspection.

MARCH 2007

PLANS PREPARED BY
PROFESSIONAL ENGINEERING CONSULTANTS, P.A.
 ENGINEERS
 WICHITA, KANSAS

As Built Plans:
 CONTRACTOR: McCullough Excavation
 INSPECTOR: Tom Jones, K E Miller Engineering
 .PDF by: NWS, 04-04-08

**Ethanol Products
 Corporate Headquarters**
 38th and Webb Road
 Wichita, Kansas

prints issued
3-9-07
For Construction

project no.
06122

drawn SAU check GMS

PRIVATE WATER
TITLE SHEET

C4.1

of

Sheet: 01-08-2007 12:26:08 PM by SW
Plot Scale: 01-03-08-2007 11:18:41 PM by SW
0:\2006\06567\Site Civil\Private Plans\Waterline\06567-C4.1-PPWTITLE