

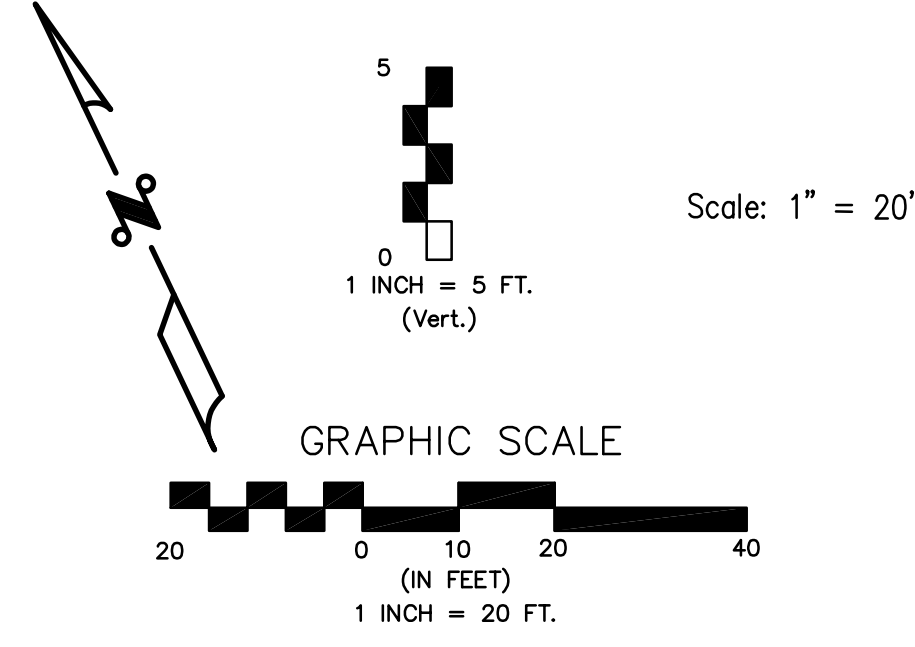
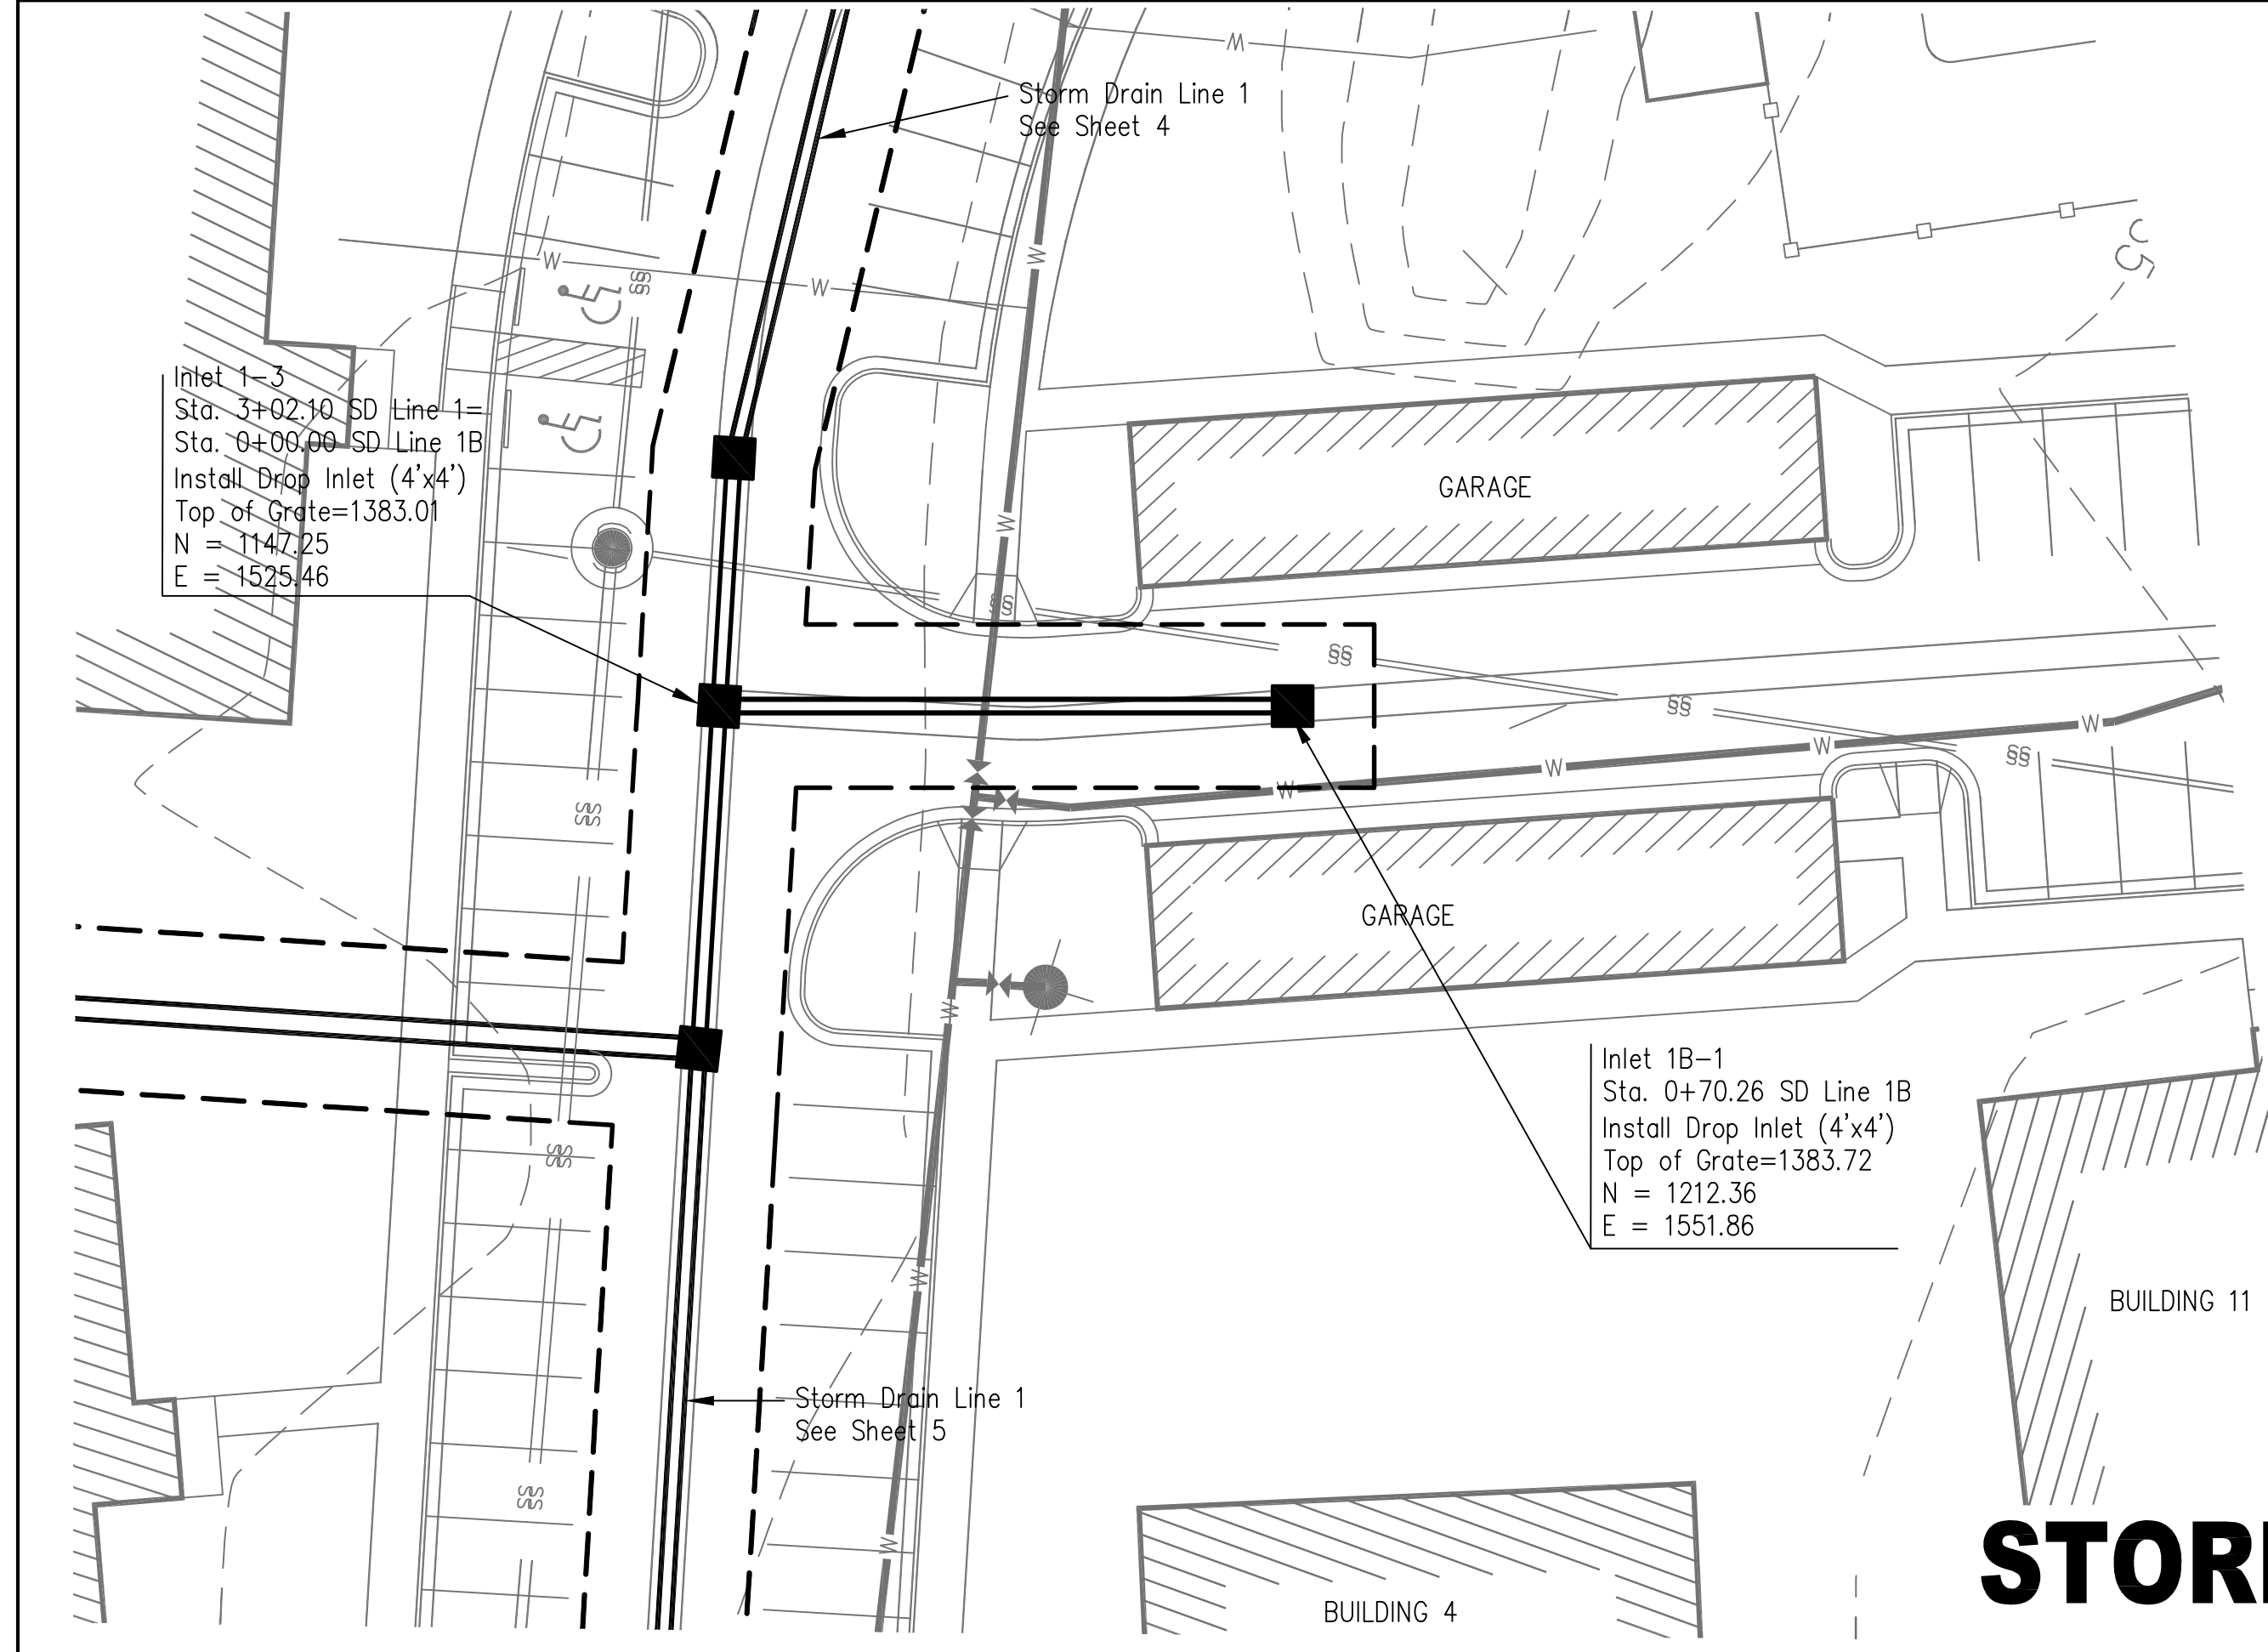


P:\1909A Revit\1909A Revit\Working Drawings\1909A Revit\1909A Revit.dwg, PLOT 1 - SHT 30.dwg, SHT 30, 4/9/2008 9:02:30 AM

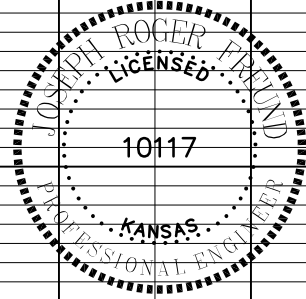

STORM DRAIN LINE "1B"

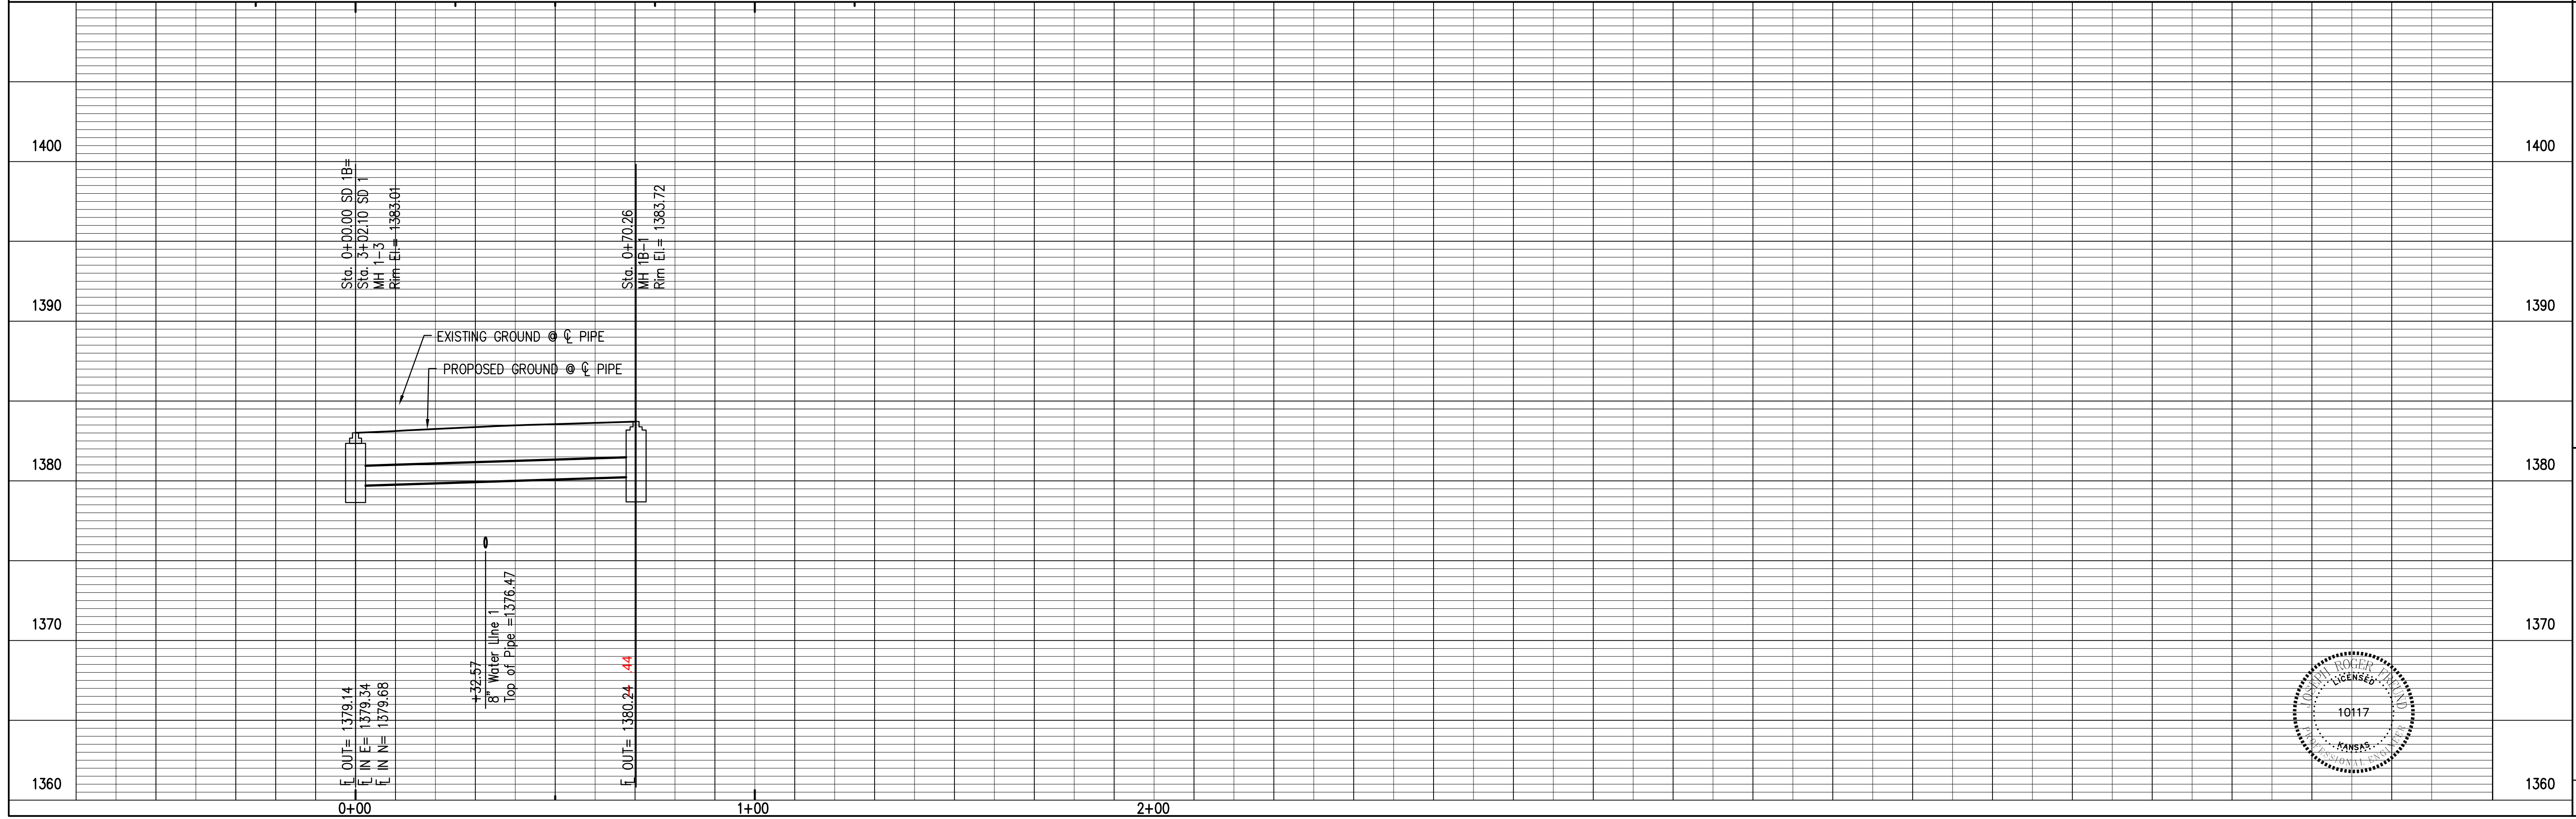

No.	Date	By	Approved	Revision
1				
2				
3				
4				

PLAN AND PROFILE
STORM DRAIN LINE "1B"
Webber Group
Inwood Apartments

1909A

Engineer: JRF
Designer: KJW
Poe Job No.: 1909
Date: 8-31-07

Sheet 6
C-30 of 20

POE & ASSOCIATES, INC.
CONSULTING ENGINEERS
5940 E. Central, Suite 200 • Wichita, KS 67208-4242
Phone 316/685-4114 • FAX 316/685-4444