



Scale: 1"=20'

NOTE: Traffic to be carried thru on 31st St. during construction.
Contractor shall verify location of 8" Gas line prior to beginning trenching operations.

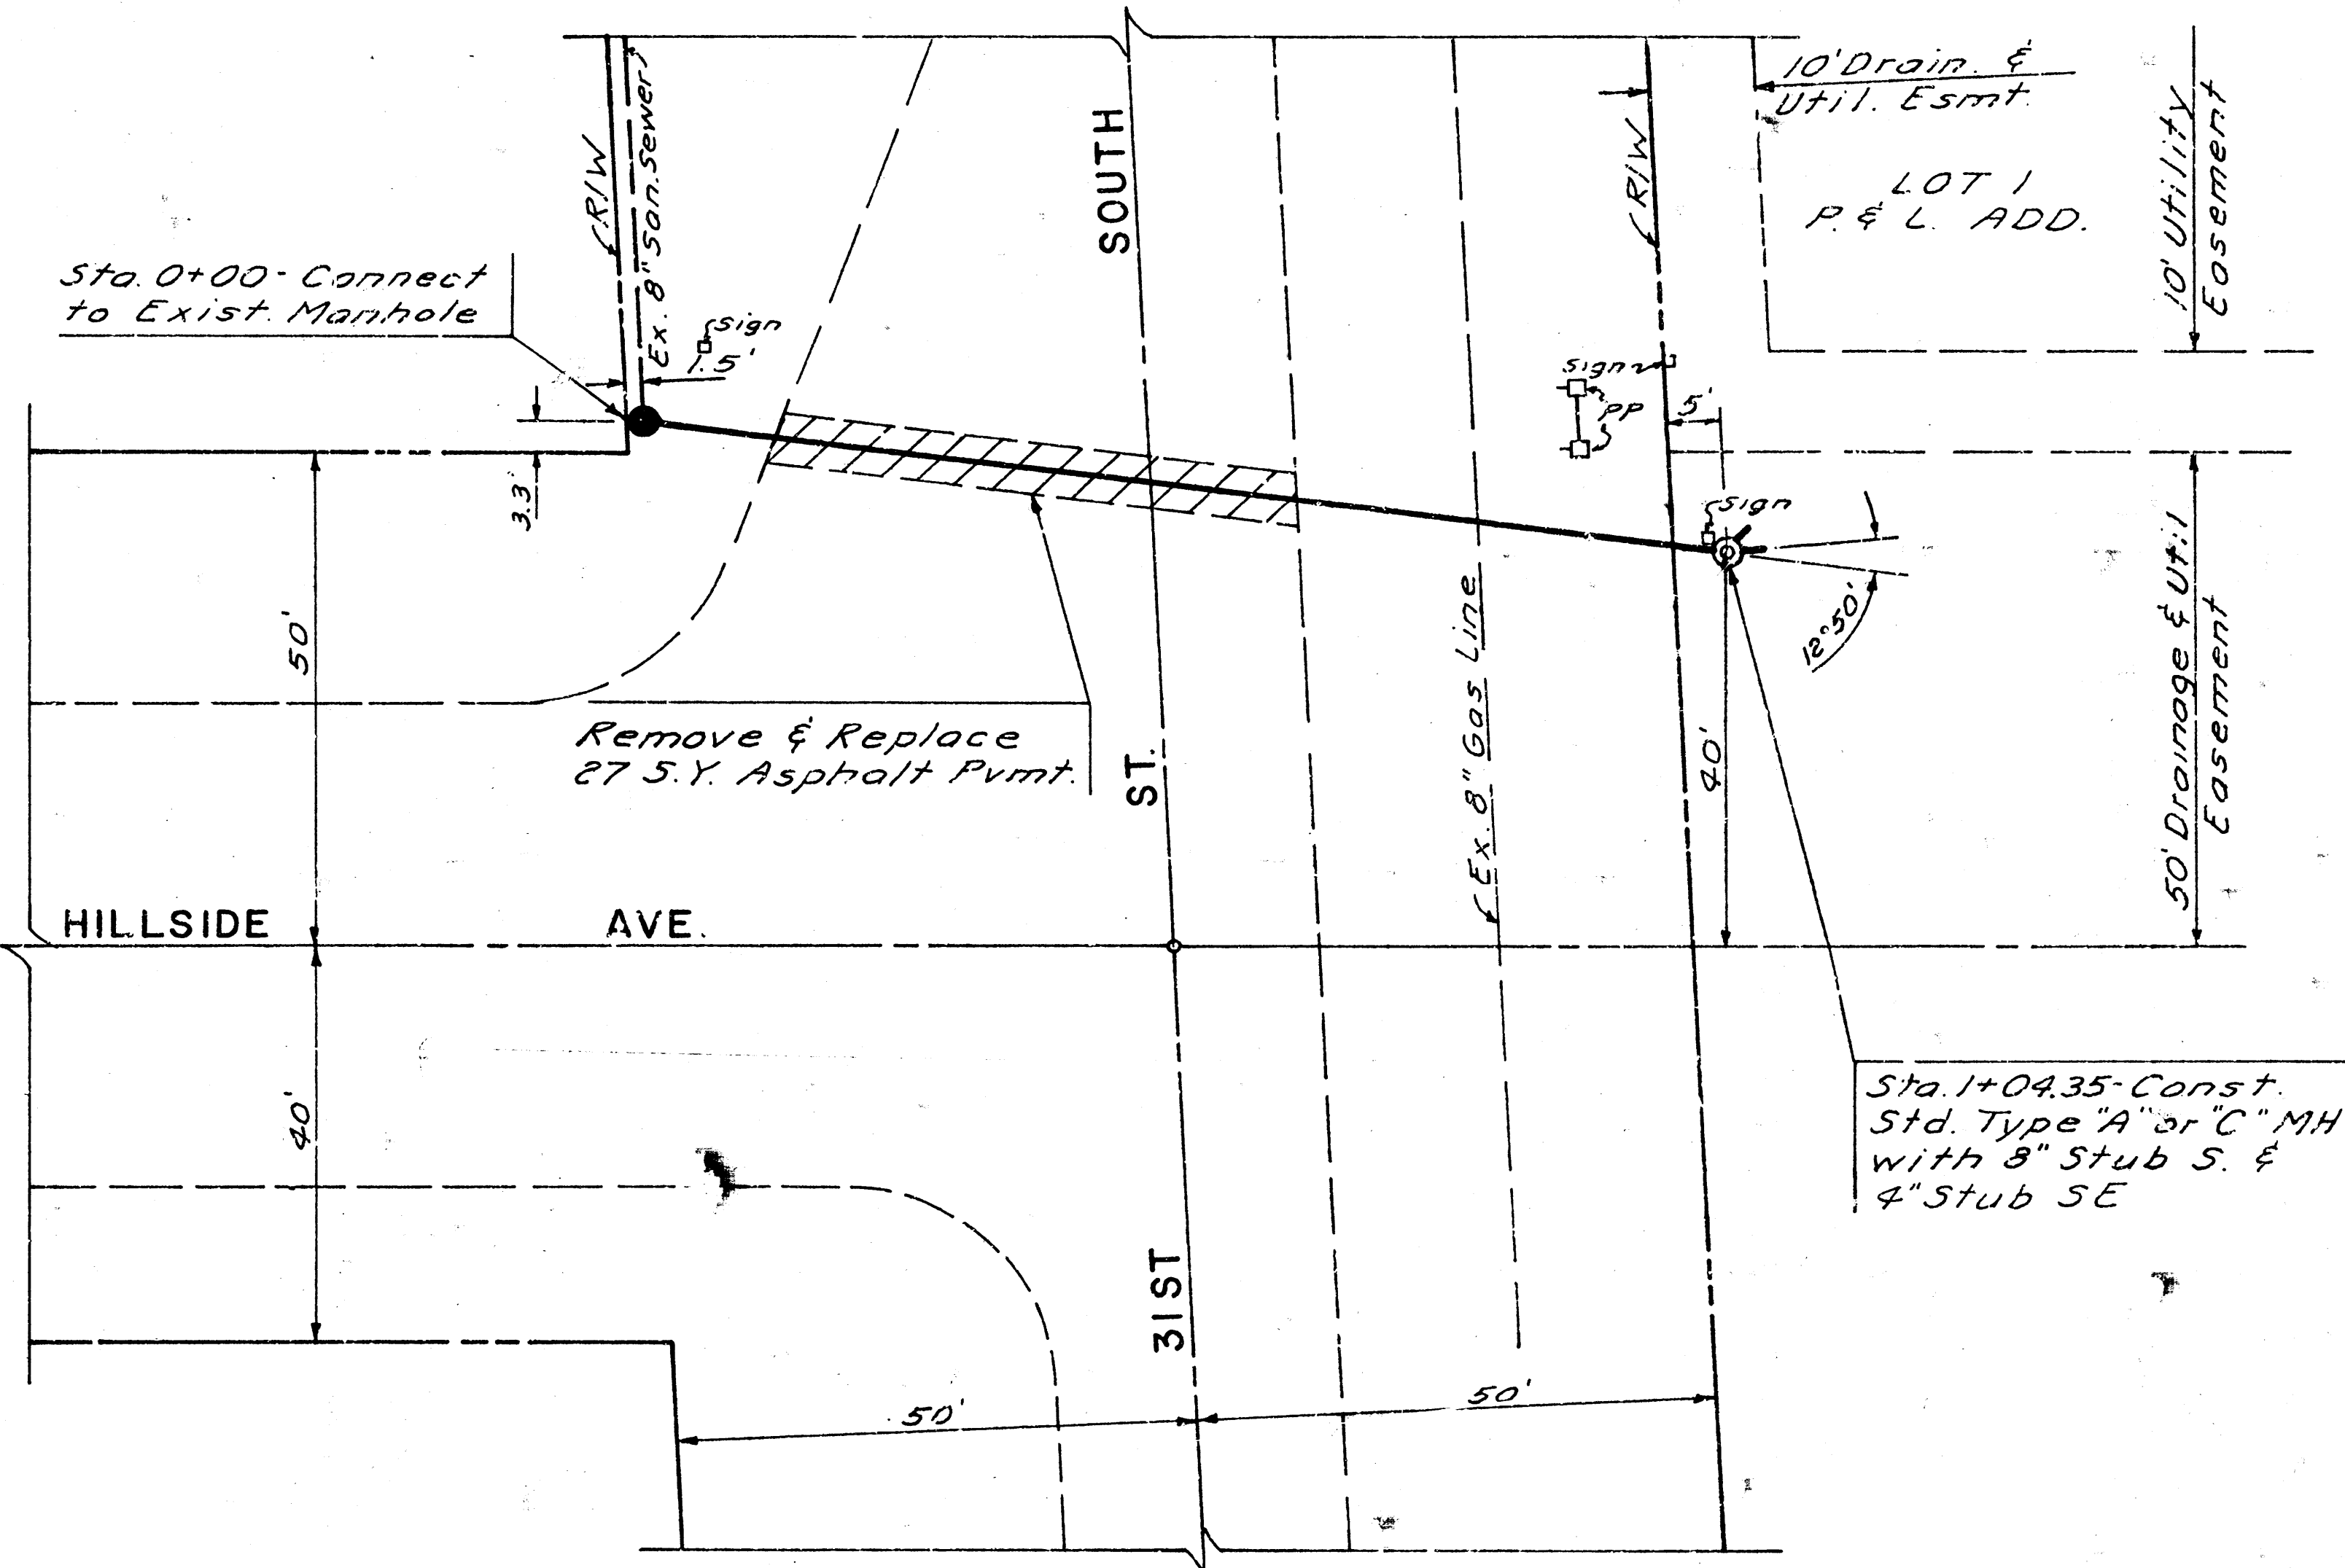

3-29-77
APPROVED AS NOTED
By CITY ENGINEER OF WICHITA
Sanitary Sewers. D.E.S.
Storm Sewers.
Driveway Approaches

NOTE TO CONTRACTOR
This project will be constructed under the supervision of the CITY ENGINEER and conforming to the SPECIFICATIONS of the CITY OF WICHITA. THE CONTRACTOR will be responsible for all costs of construction, materials, and inspection.

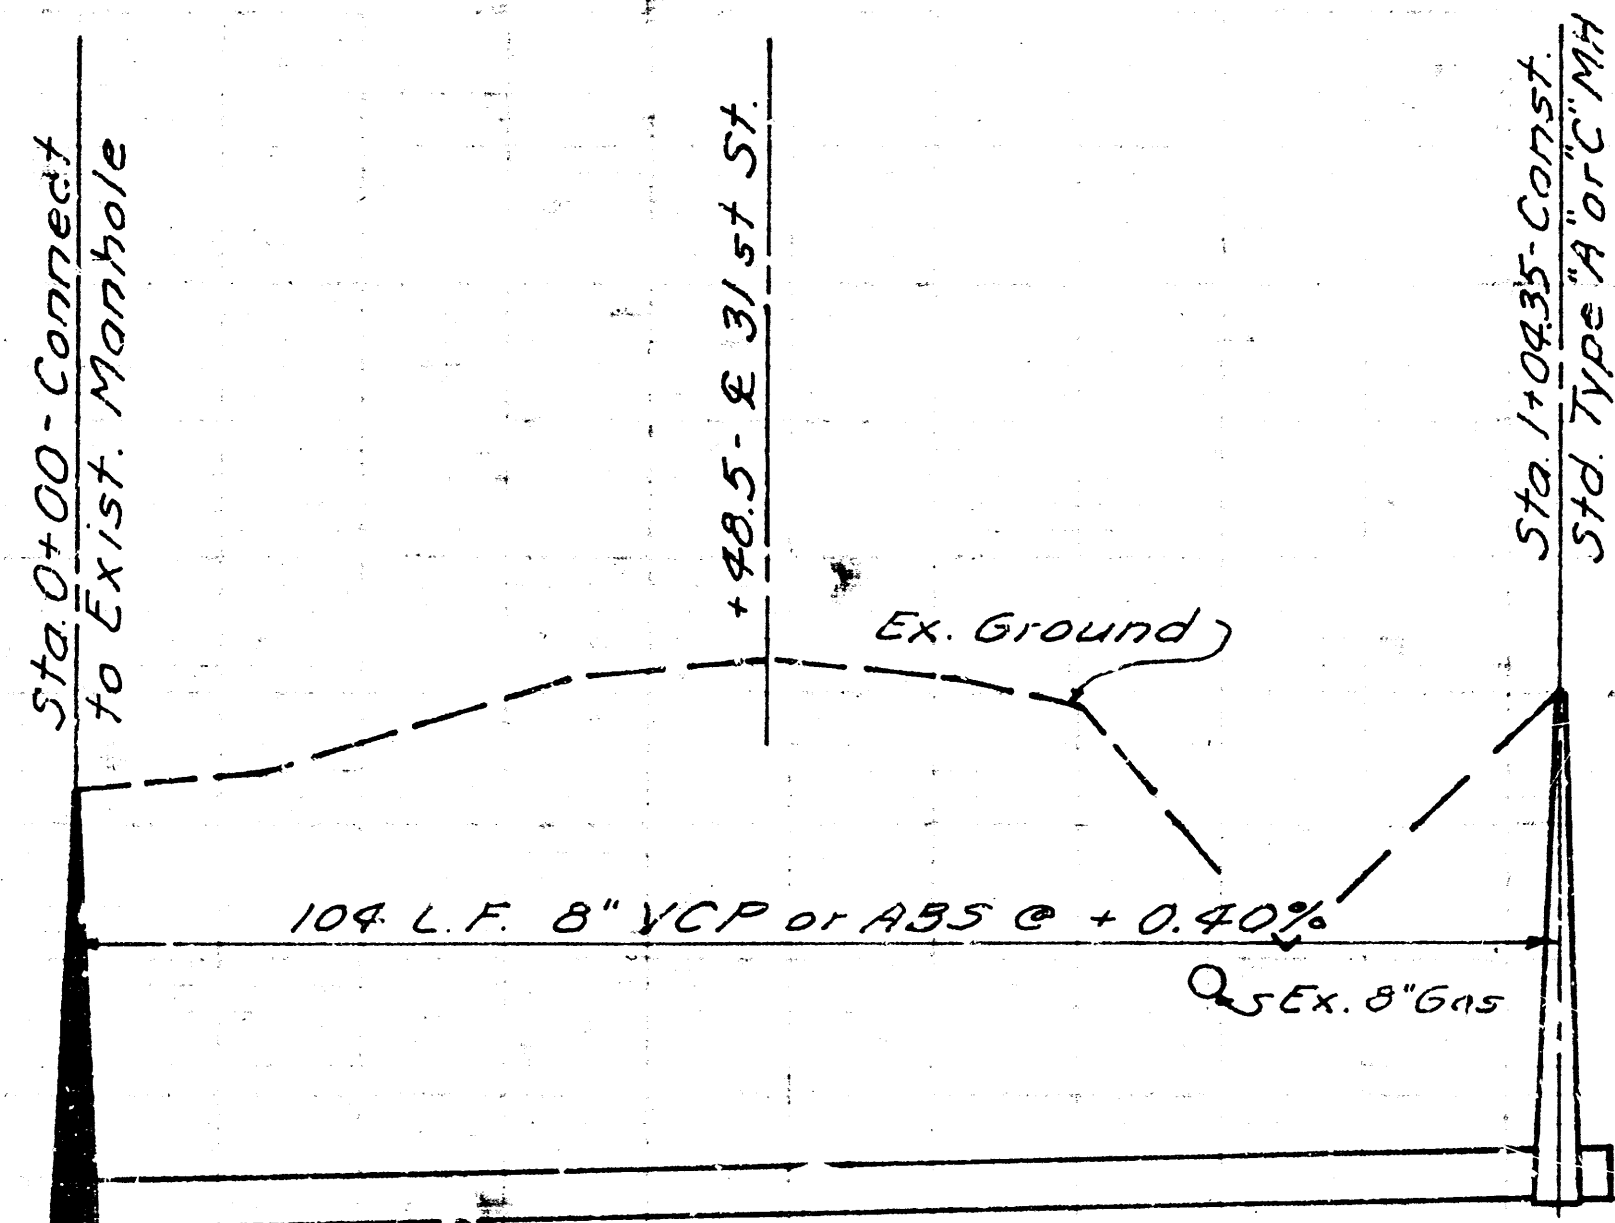

BM - City Disc. 52' N & 44' E
Hillside & 31st - El. 104.29

* Verify Elev.
in Field to
match slope

El. out 98.00
El. in 98.10 (8" S)
El. in 98.33 (4" SE)

CITY PROJ. NO. DBKW 7C7019
SANITARY SEWER TO SERVE
LOT 1 - P & L ADDITION

REVISED 2-21-77 (JEL)