



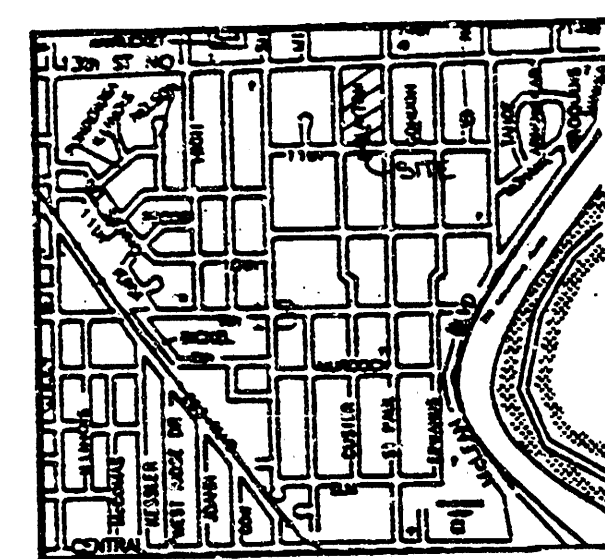

LOCATION MAP

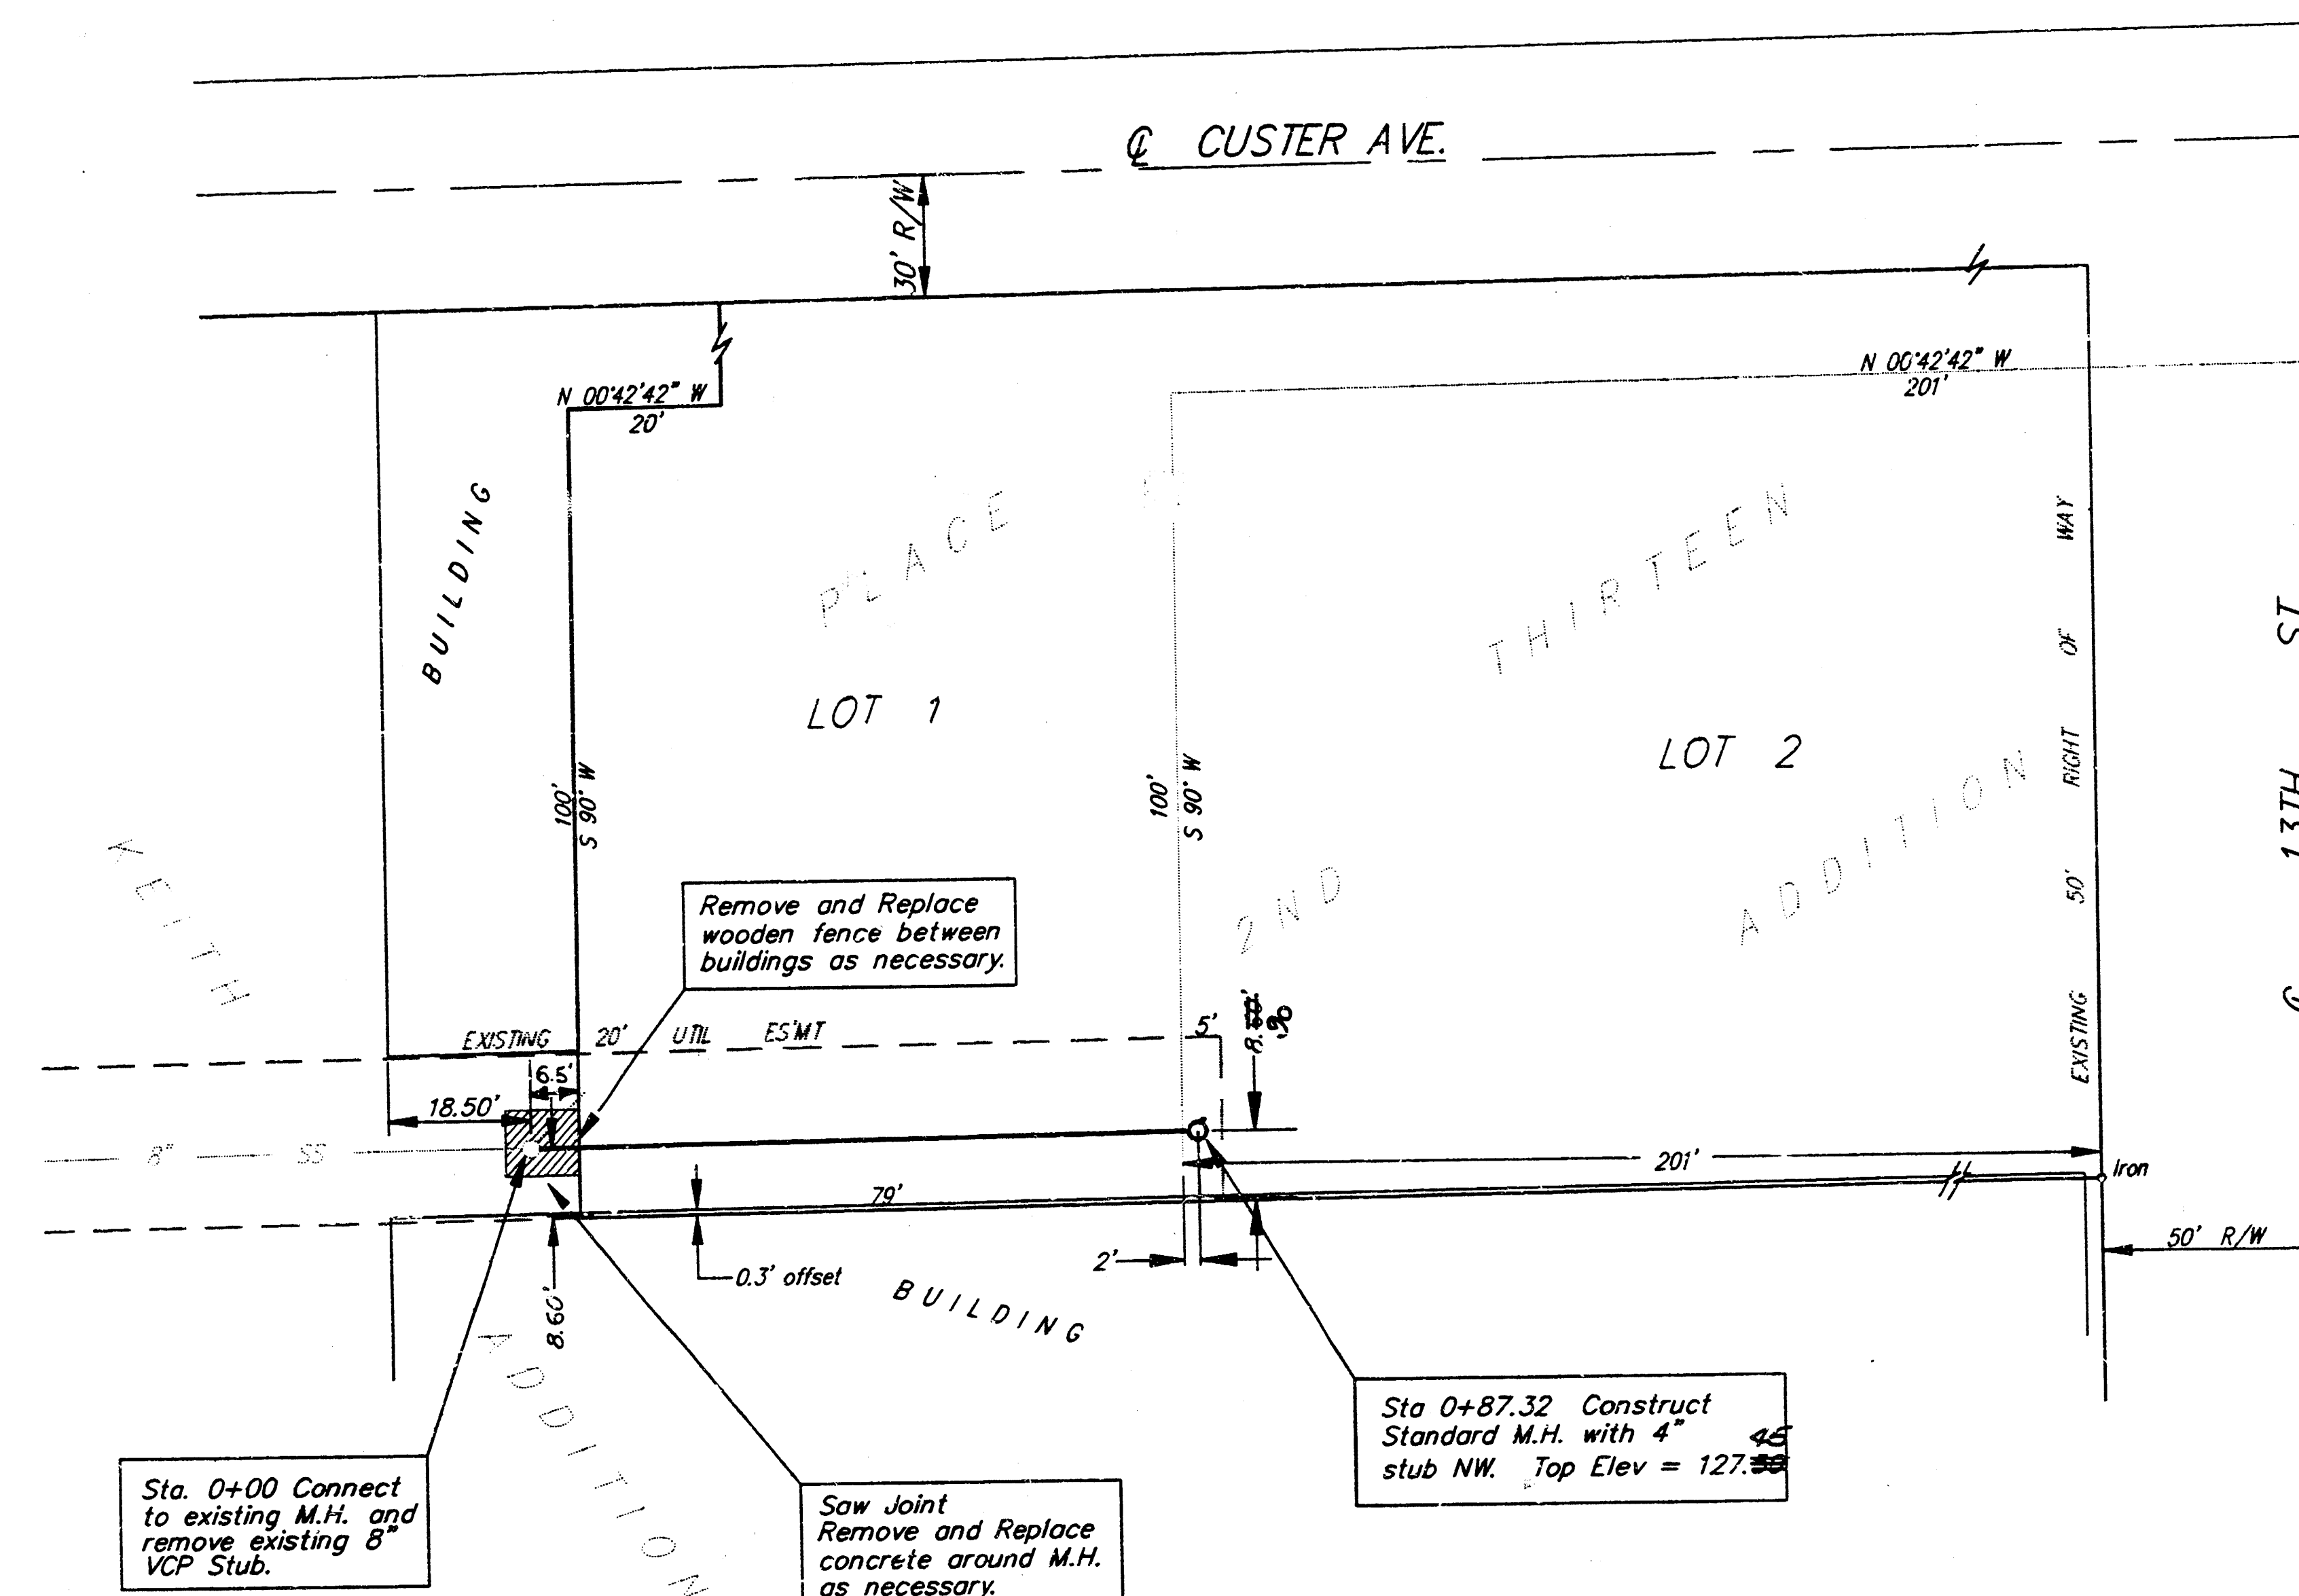

SCALE: 1" = 20' HORIZ.
1" = 5' VERT.

APPROVED AS NOTED
BY CITY ENGINEER OF WICHITA

Sanitary Sewers UR 4-18742

Storm Sewers _____

Driveway Approaches _____

Water Mains _____

Paving _____

NOTE TO CONTRACTORS

Inspection and testing for this project is to be provided by a Licensed Consulting Engineering Firm under contract with the Owner/Developer. Said inspection to be in accordance with the City of Wichita standard construction engineering practices and certified by a Licensed Professional Engineer. No work shall be performed in dedicated easements or public right-of-way by the Contractor without such inspection nor shall any work be commenced without written authorization by the City Engineer.

BENCH MARK:

City Standard Disc., 29.5' E and 35.9' N of center of Sheridan & 13th St. No. Elev. = 125.72 City Datum

Square cut on top of curb at west end of curb return at SW corner of Custer and 13th St. No. Elev. = 127.93 City Datum

