

PRIVATE SANITARY SEWER EXTENSION TO SERVE

QUIKTRIP 1ST ADDITION

PROJECT NO. 468-76-245-80001-000-000-193

INDEX CODE 606947

CITY OF WICHITA, KANSAS

MICHAEL E. LINDEBAK CITY ENGINEER

APPROVED AND SIGNED

By CITY ENGINEER WICHITA

Sanitary Sewers *QEB 12/14/88*

Storm Sewers _____

Driveway Approaches _____

Water Mains _____


Paving _____

GENERAL SANITARY SEWER NOTES

- Underground utility service lines and overhead utility pole lines are to be adjusted as necessary by others prior to construction unless the plans specifically call for their adjustment by the Contractor or unless the plans specifically identify a utility to be adjusted by its owner during construction. Existing utilities and their location, as shown on the plans, represent the best information obtainable for design. The Contractor will be required to work around existing utilities within the right-of-way which do not conflict with proposed construction.
- Rubble from the removal of miscellaneous structures and excess excavation which is to be wasted shall be disposed of on sites to be provided by the Contractor. These sites shall be approved by the Engineer as to suitability, appearance and site location. Locations that, in the opinion of the Engineer, will leave an unsightly appearance will not be approved.
- Trees and shrubs in public right-of-way which are in direct conflict with proposed new construction shall be removed by the Contractor with the Engineer's approval. Trees and shrubs which are not in direct conflict with proposed new construction shall be saved and protected from damage.
- The Contractor shall be responsible for preserving property irons. The Contractor will be required to re-establish any property irons which are damaged or destroyed by his construction operations. Such irons shall be re-established by a licensed land surveyor or a licensed professional engineer in accordance with state laws.

NOTE TO CONTRACTOR

INSPECTION AND TESTING FOR THIS PROJECT IS TO BE PROVIDED BY A LICENSED CONSULTING ENGINEERING FIRM UNDER CONTRACT WITH THE OWNER/DEVELOPER. SAID INSPECTION TO BE IN ACCORDANCE WITH THE CITY OF WICHITA STANDARD CONTRACT FOR ENGINEERING SERVICES AND CERTIFIED BY A LICENSED PROFESSIONAL ENGINEER. NO WORK SHALL BE PERFORMED IN THE PUBLIC RIGHT-OF-WAY WITHOUT WRITTEN AUTHORIZATION OF THE CITY ENGINEER.

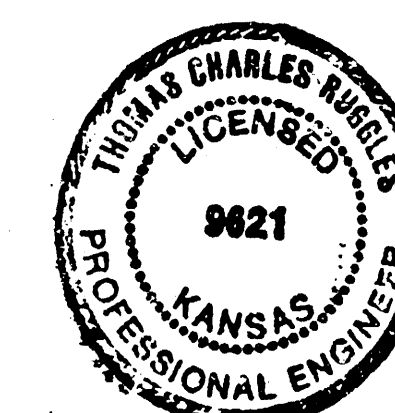

*Booked
5-89
RDC*

Rev. As-built 4-17-89 TCR


NOV. 21, 1988

BAUGHMAN COMPANY, P.A.
SURVEYING & ENGINEERING
319/262-7271 • 315 ELLIS • WICHITA, KANSAS 67211

1 OF 3

SH. NO.	DESCRIPTION
1	TITLE SHEET
2	SANITARY SEWER, PLAN-PROFILE

SCALE: 1" = 160'

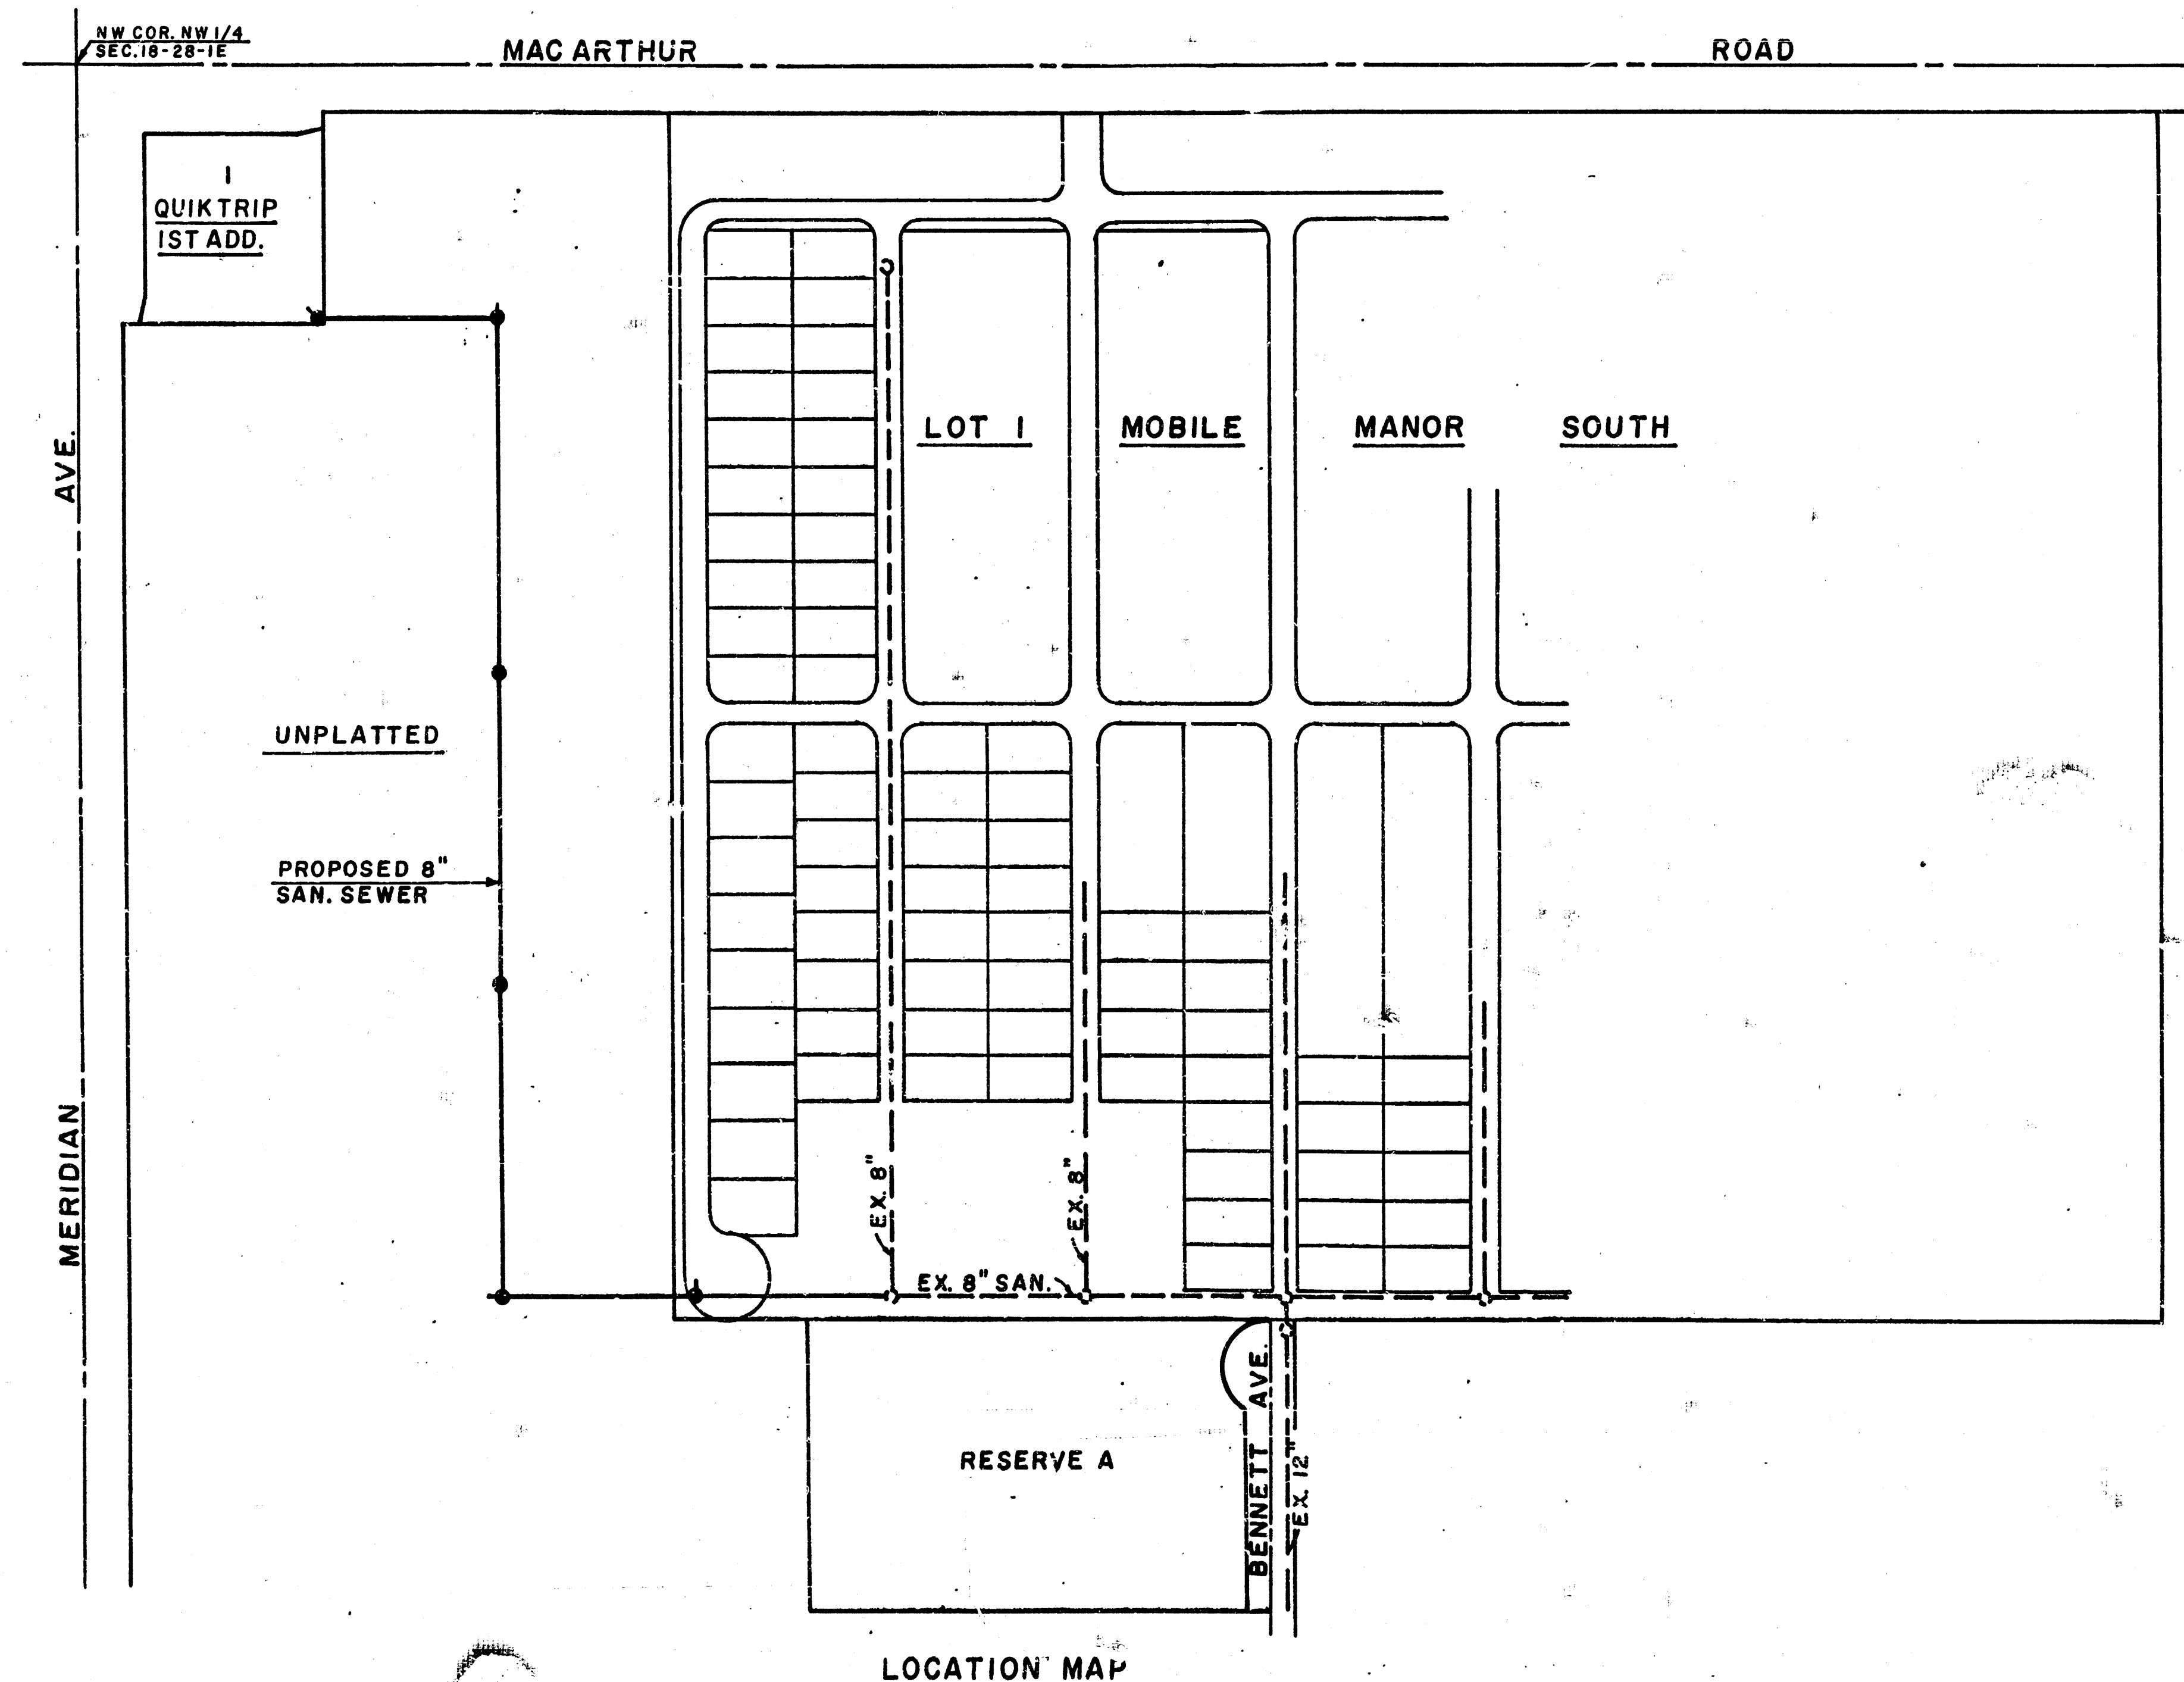

FILMED FROM THE BEST
AVAILABLE COPY.....

