


BENCH MARK: "1" Cut On Top of Curb Located @ The East Side of Mead, opposite of the North Prop. Line of Mona. Elevation: 81.85 City Datum.

MEAD

Scale: 1" = 20' Plan
1" = 5' Profile

PROJECT AREA

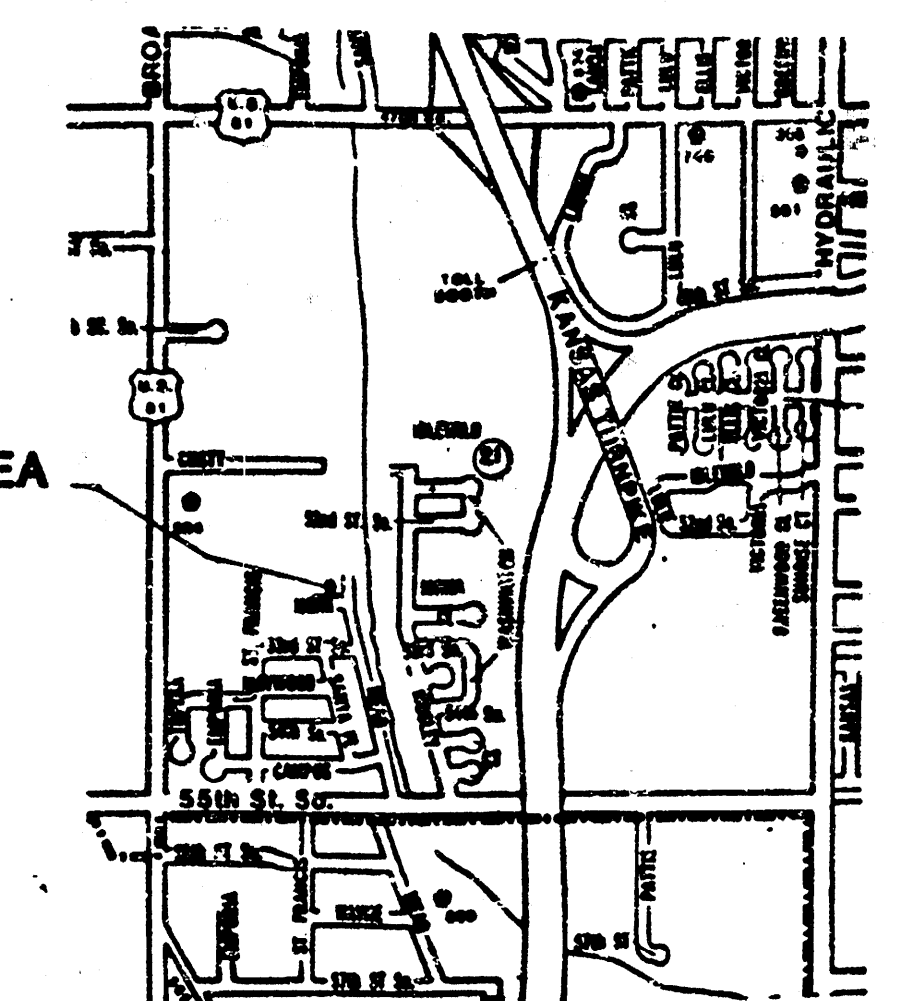

LOCATION MAP

RIVERSIDE FOURTH ADDITION

MONA

APPROVED AS NOTED
By CITY ENGINEER OF WICHITA


Sanitary Sewers 1/24/89
Storm Sewers _____
Driveway Approaches _____
Water Mains _____
Paving _____

GENERAL NOTES


- Underground utility service lines and overhead utility pole lines are to be adjusted as necessary by others prior to construction unless the plans specifically call for their adjustment by the Contractor or unless the plans specifically identify a utility to be adjusted by its owner during construction. Existing utilities and their location, as shown on the plans, represent the best information obtainable for design. The Contractor will be required to work around existing utilities within the right-of-way which do not conflict with proposed construction.
- The Contractor shall be responsible for preserving property irons. The Contractor will be required to re-establish any property irons which are damaged or destroyed by his construction operations. Such irons shall be re-established by a licensed land surveyor in accordance with state laws.

NOTE TO CONTRACTOR
INSPECTION AND TESTING FOR THIS PROJECT IS TO BE PROVIDED BY A LICENSED CONSULTING ENGINEERING FIRM UNDER CONTRACT WITH THE OWNER/DEVELOPER. SAID INSPECTION TO BE IN ACCORDANCE WITH THE CITY OF WICHITA STANDARD CONSTRUCTION SPECIFICATIONS AND CERTIFIED BY A LICENSED ENGINEER. THE CITY OF WICHITA SHALL BE REQUIRED TO VERIFY THE LOCATION AND DEPTH OF THE POINT-OF-WAY BY THE CITY ENGINEER. THE CITY ENGINEER SHALL HAVE THE RIGHT TO REFUSE ANY WORK THAT DOES NOT MEET THE CITY ENGINEER'S REQUIREMENTS WITHOUT WRITTEN AUTHORIZATION FROM THE CITY ENGINEER.

6" P.V.C. RISER CLEANOUT DETAIL

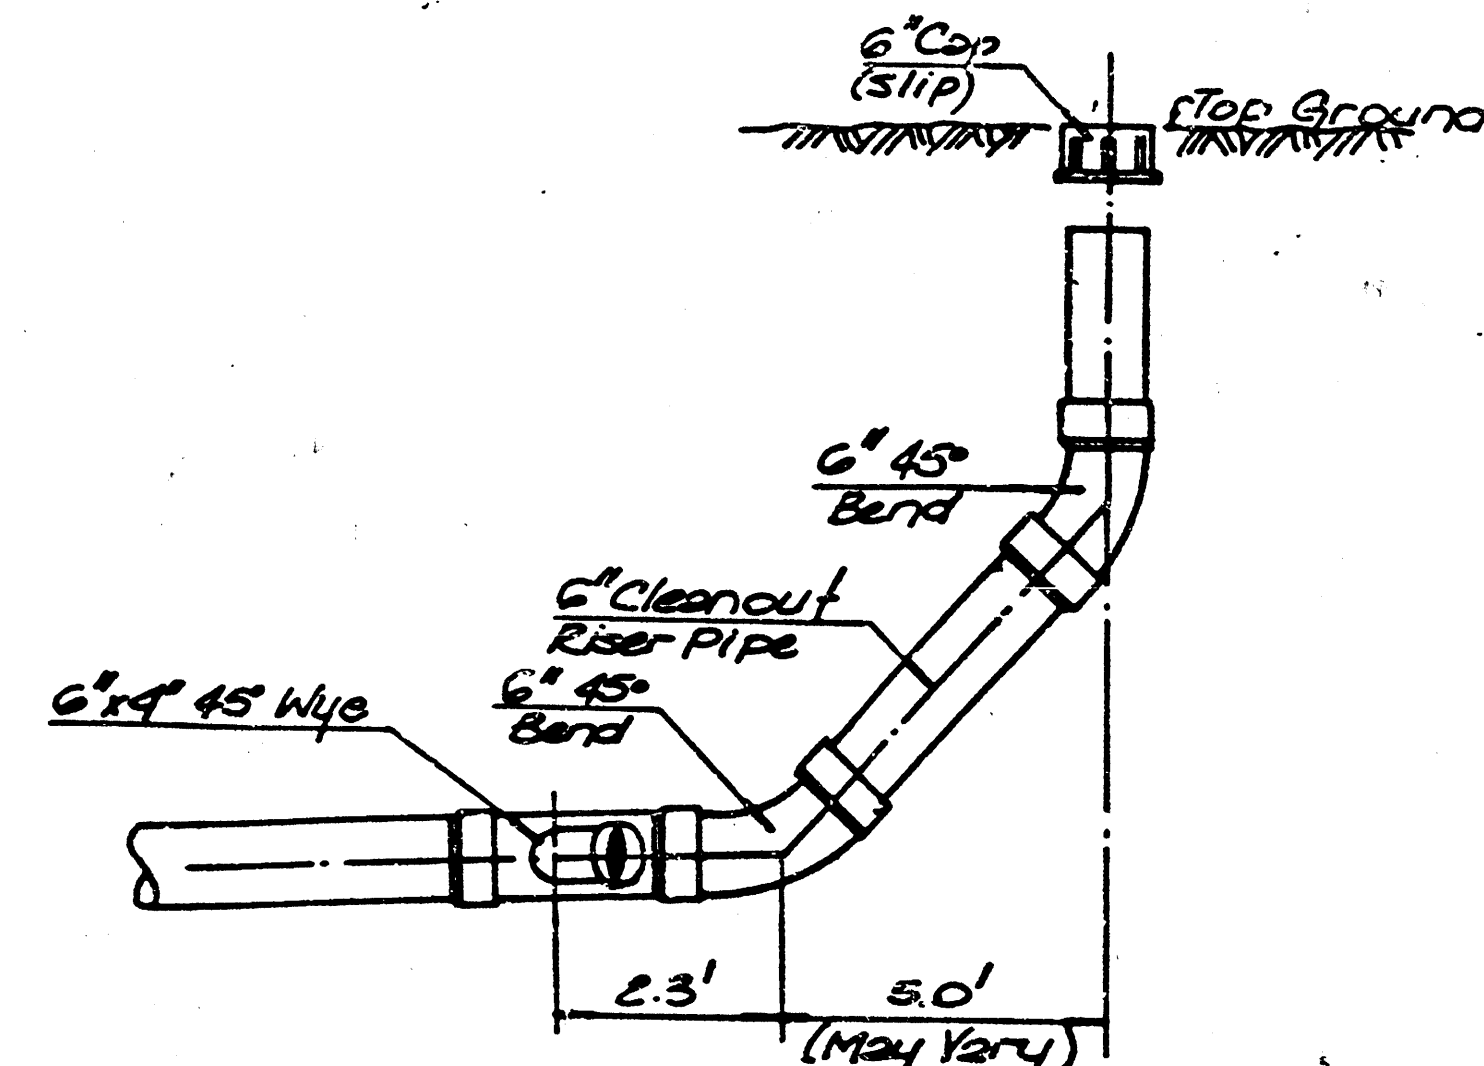

Station of 360' Const. 6" P.V.C. Riser Cleanout Riser (4" N.Y.C. End to House)
Station of 0+00 Connect to Existing Manhole.

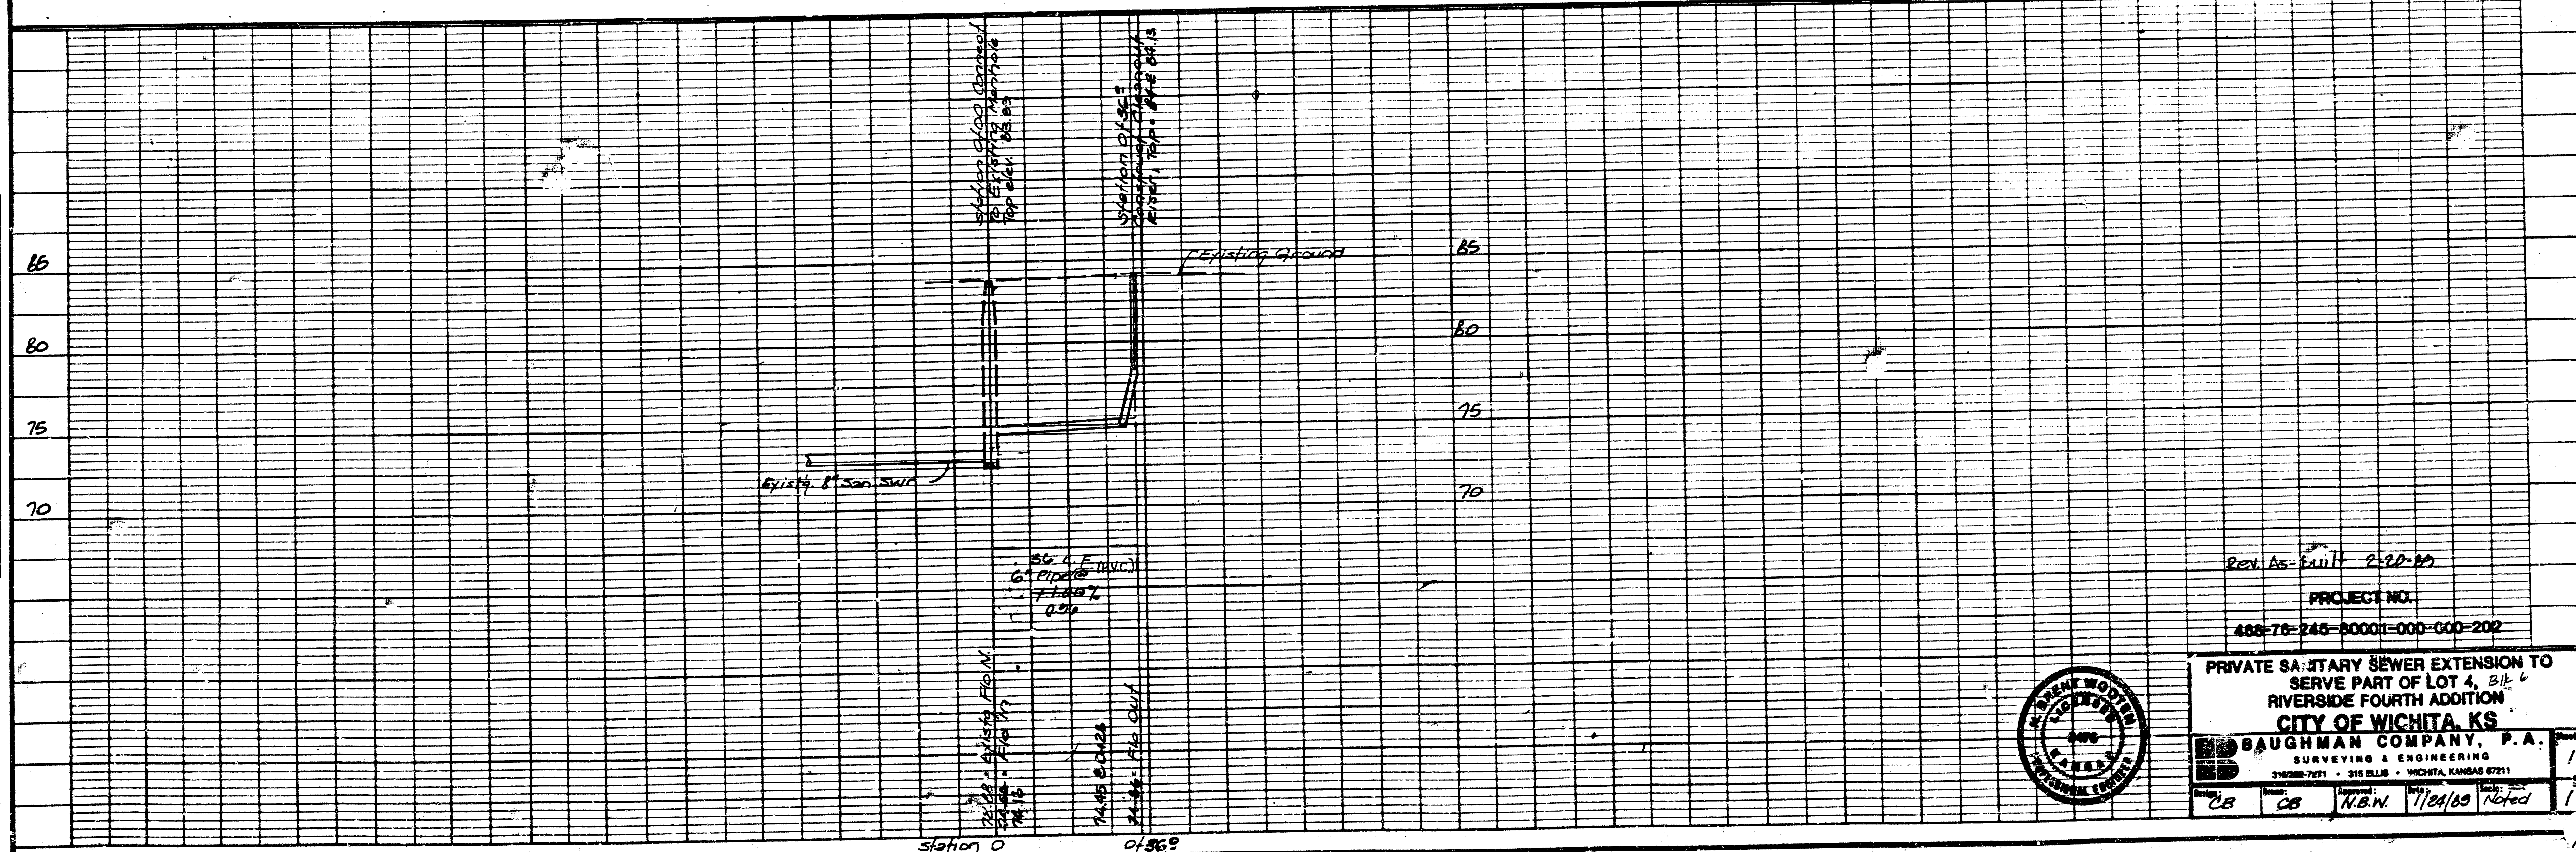

Rev As-Built 2-20-89
PROJECT NO.
468-76-245-80001-000-000-202

PRIVATE SANITARY SEWER EXTENSION TO
SERVE PART OF LOT 4, B/L 6
RIVERSIDE FOURTH ADDITION
CITY OF WICHITA, KS

BAUGHMAN COMPANY, P.A.
SURVEYING & ENGINEERING
310220-7271 • 315 ELLIS • WICHITA, KANSAS 67211

Drawn: CB, Checked: CB, Date: 1/24/89, Notes: 1

FILMED FROM THE BEST
AVAILABLE COPY.....