



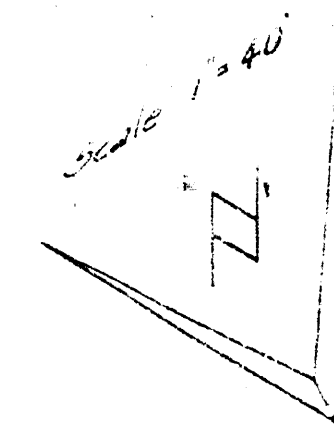

B.M. 119.30 NAIL IN ALP ES CHARLES END POLE N. OF 13TH.


AS BUILT PLANS

5' = 1' SCALE BY MEANS OF THE BULL K-1004

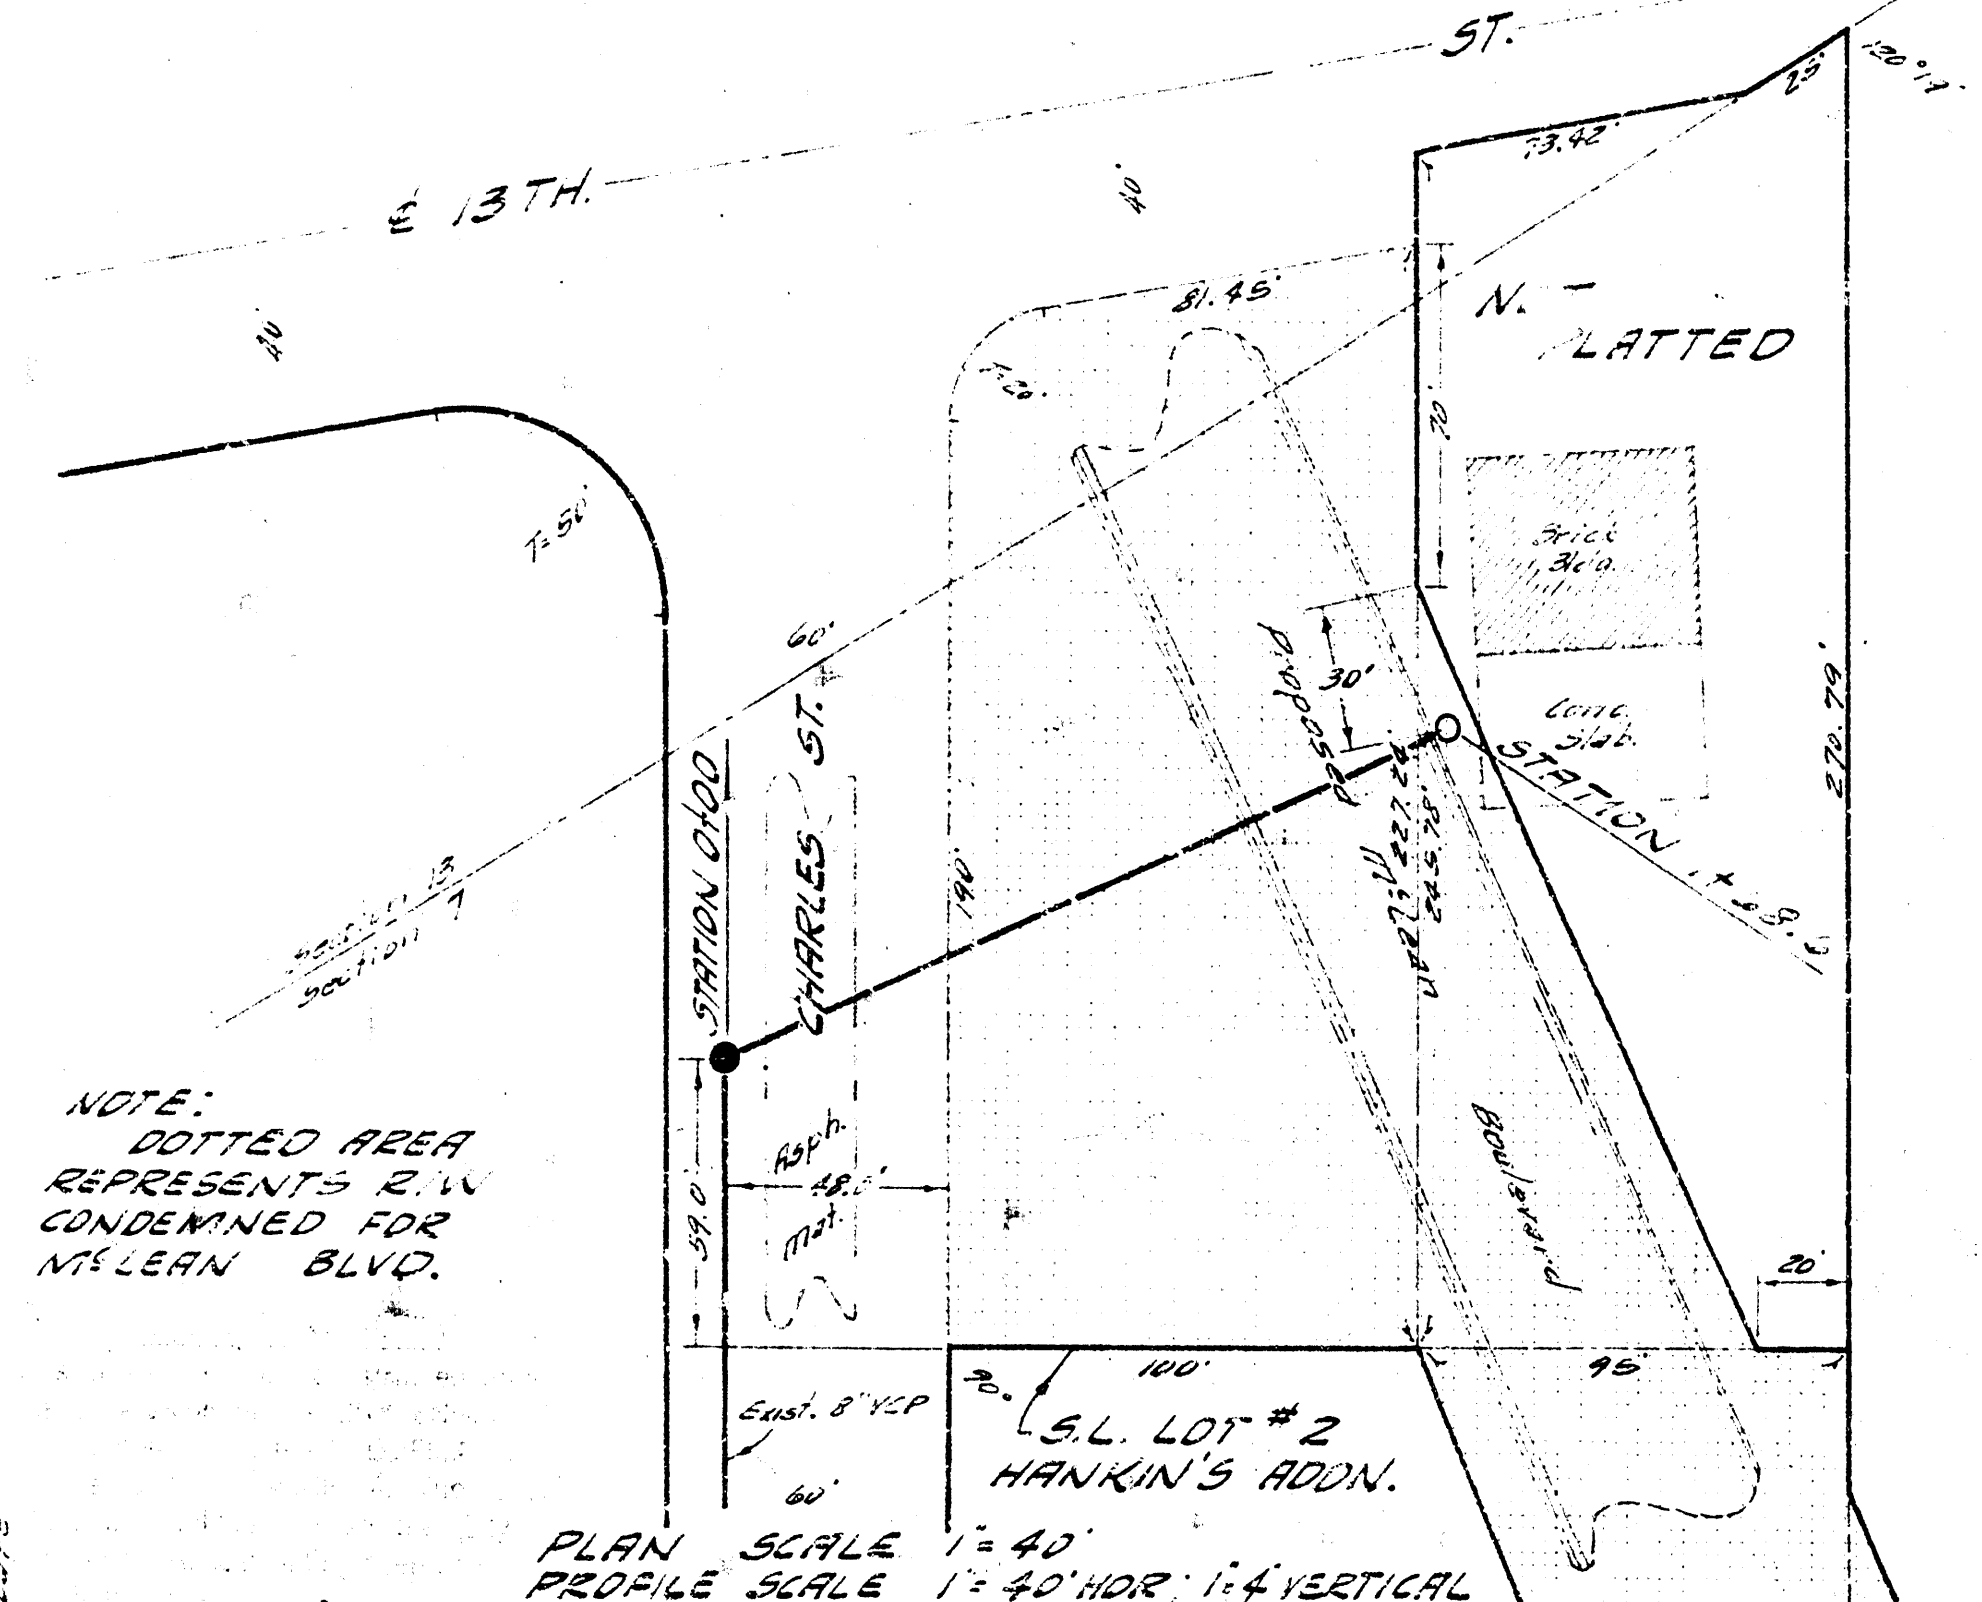

NOTE: DOTTED AREA REPRESENTS E.V. CONDEMNED FOR McLEARN BLVD.

PLAN SCALE 1" = 40'
PROFILE SCALE 1" = 40' HORIZ, 1" = 4' VERT

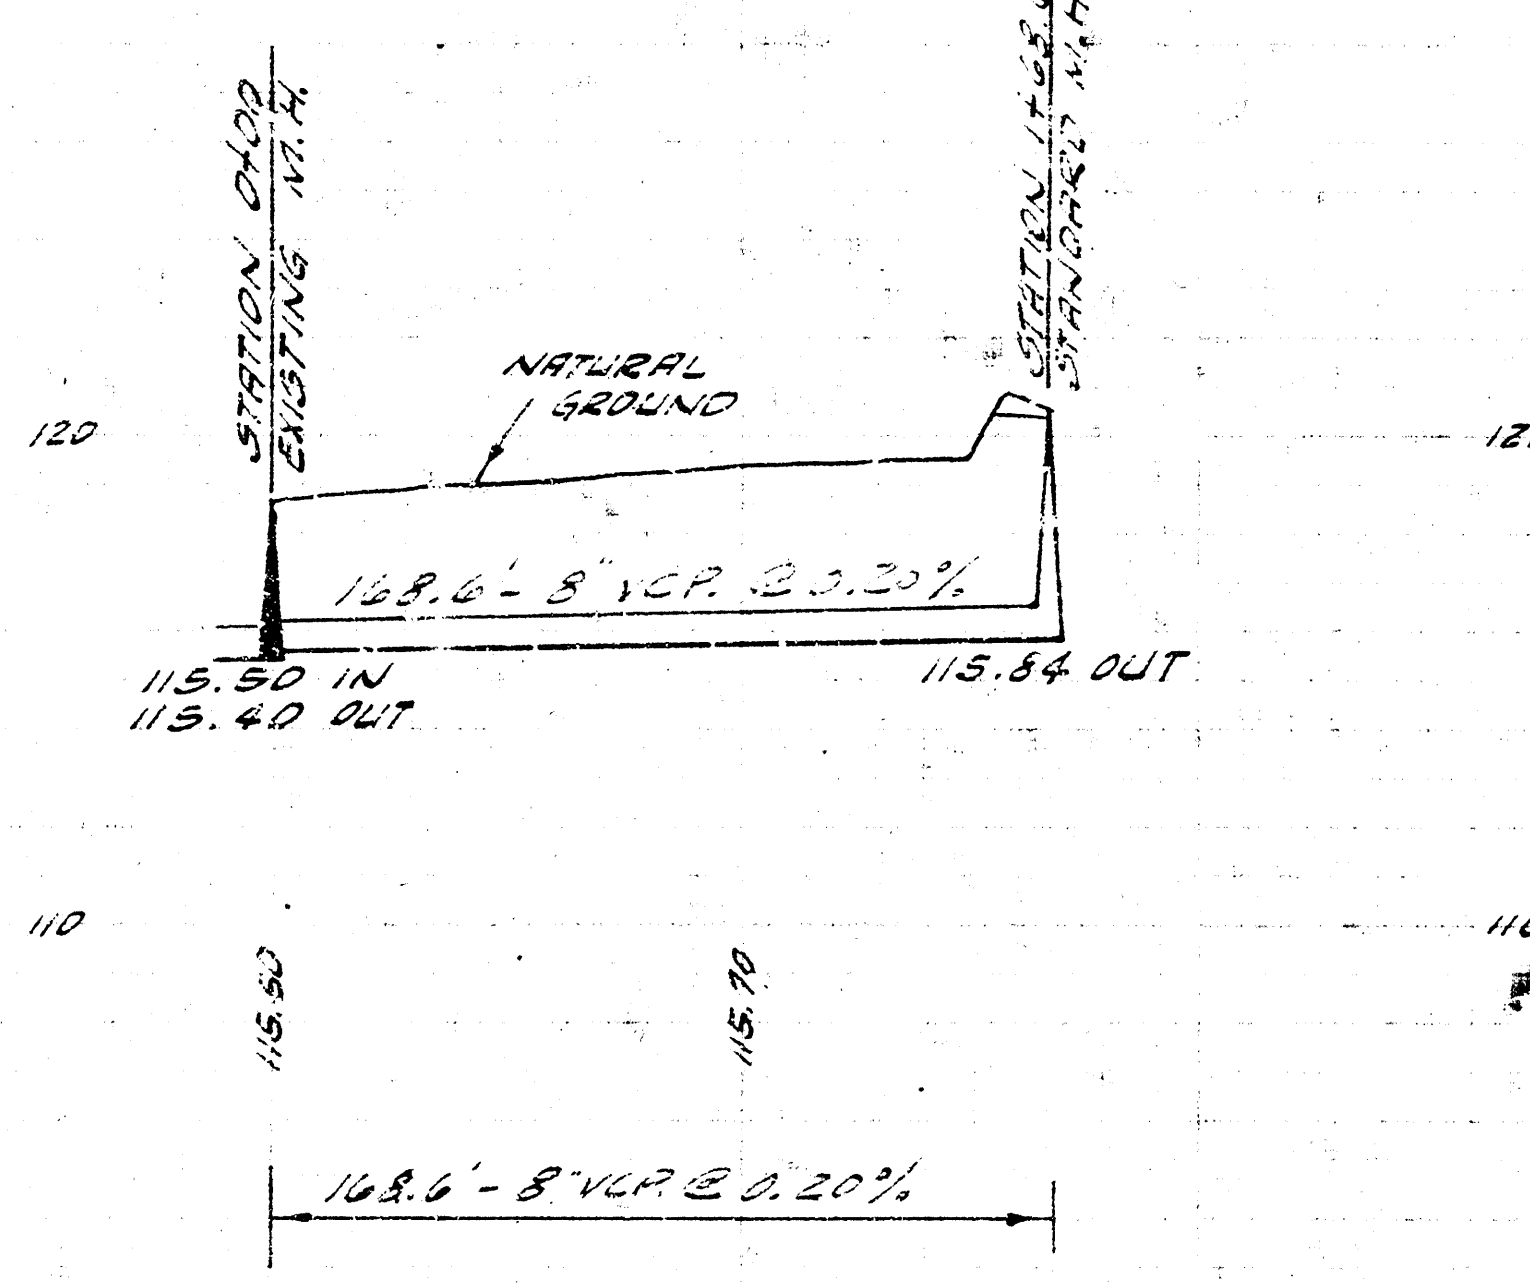


AS BUILT PLANS


ENT. OF LAT 16 SUB. 13 SAN. SEWER 22
CITY OF WICHITA, KANSAS
B.E. SMITH CITY ENGINEER
PRIVATE JOB. MAY, 1960



Scale 1" = 80'

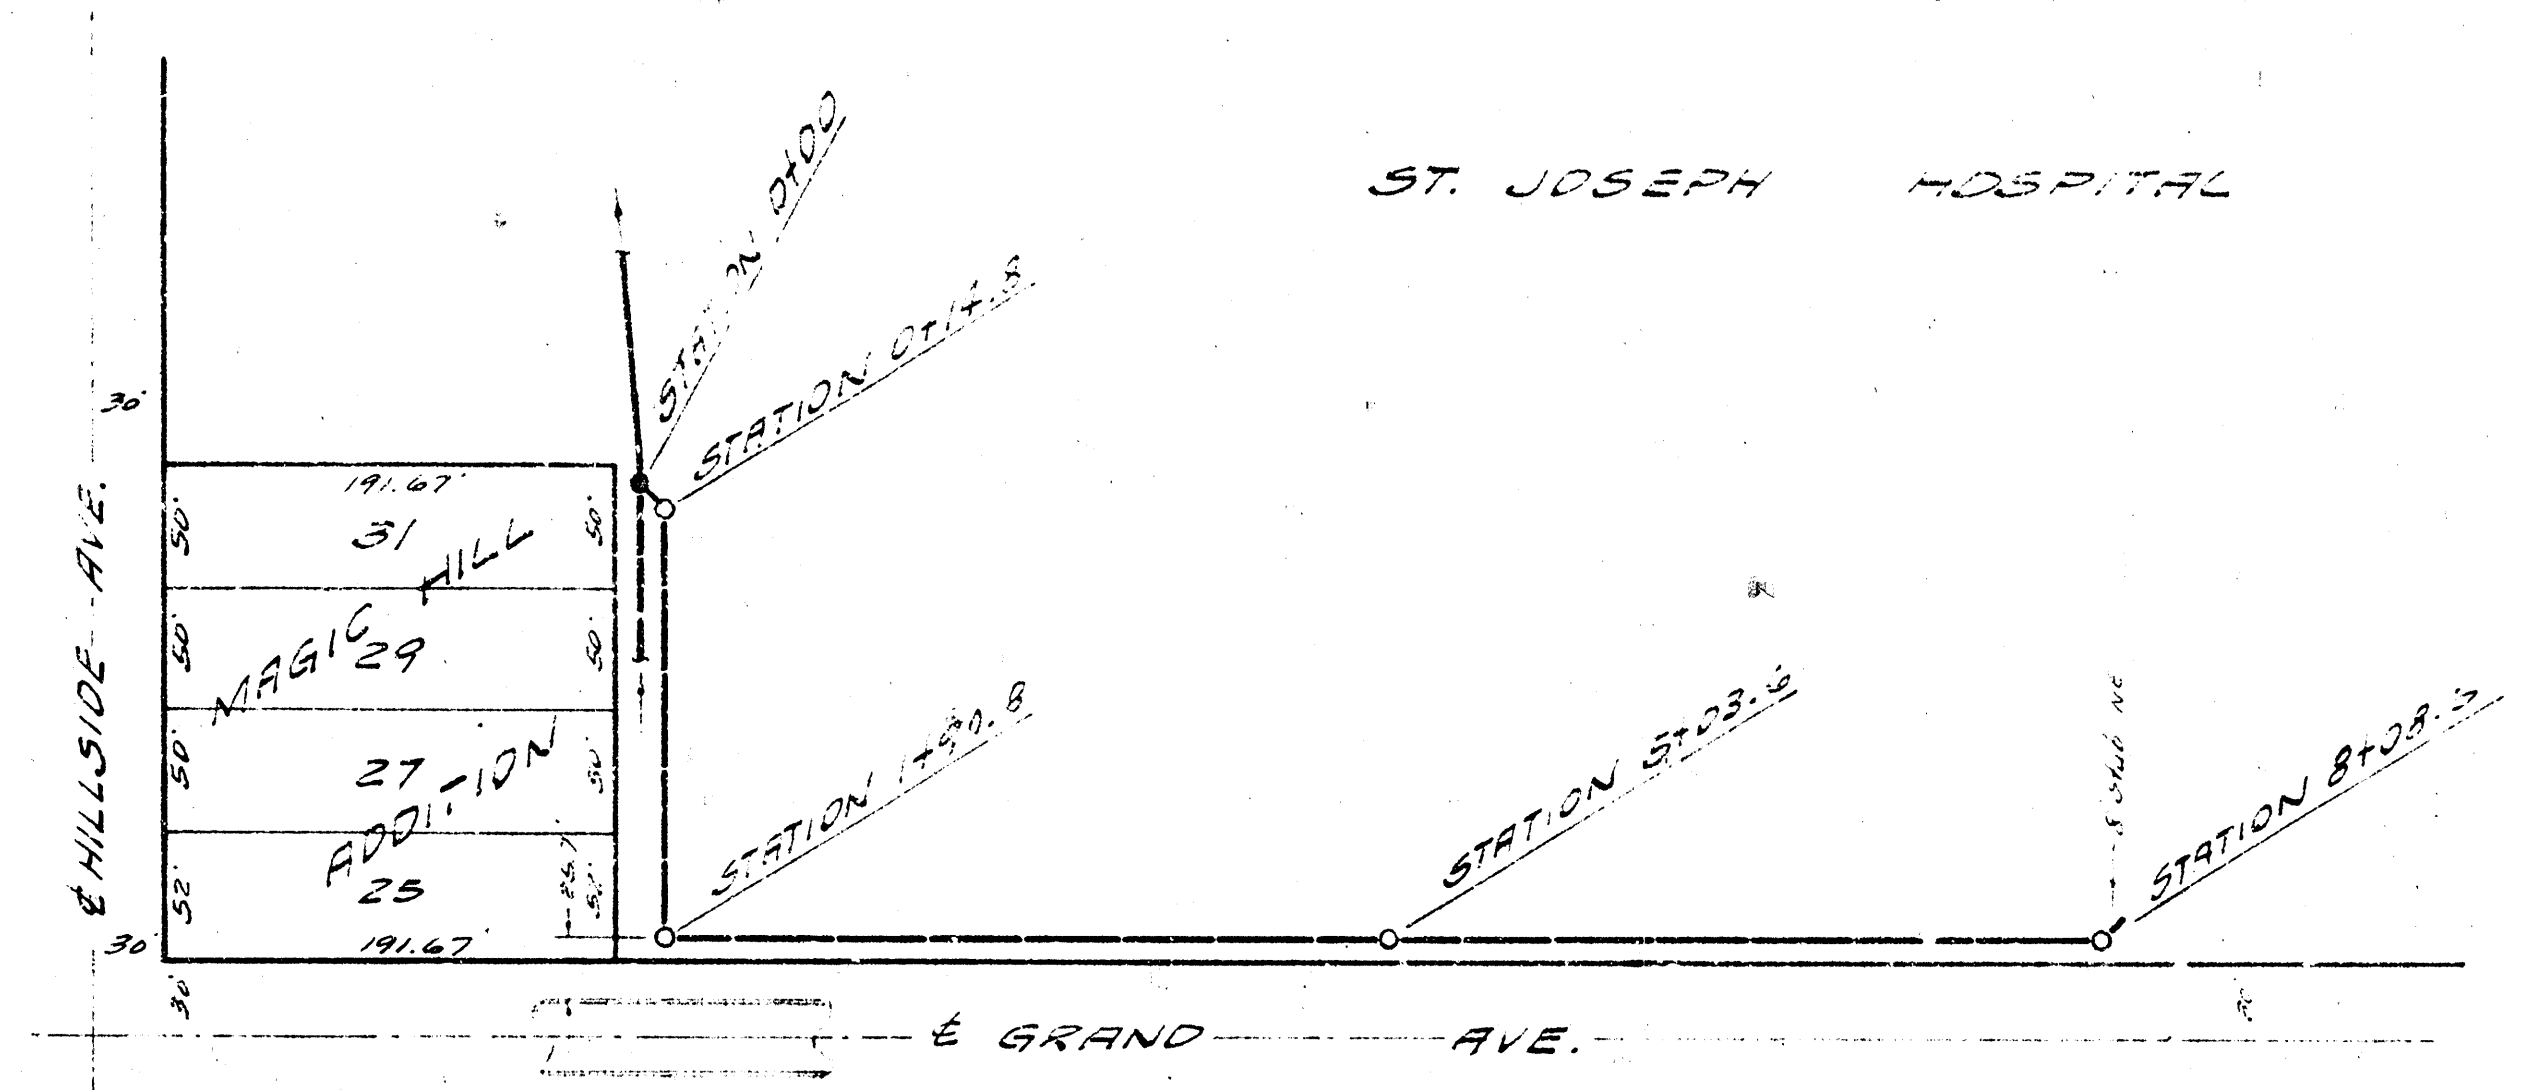

PLAN SCALE 1" = 80'
PROFILE SCALE 1" = 80' HORIZ, 1" = 4' VERT

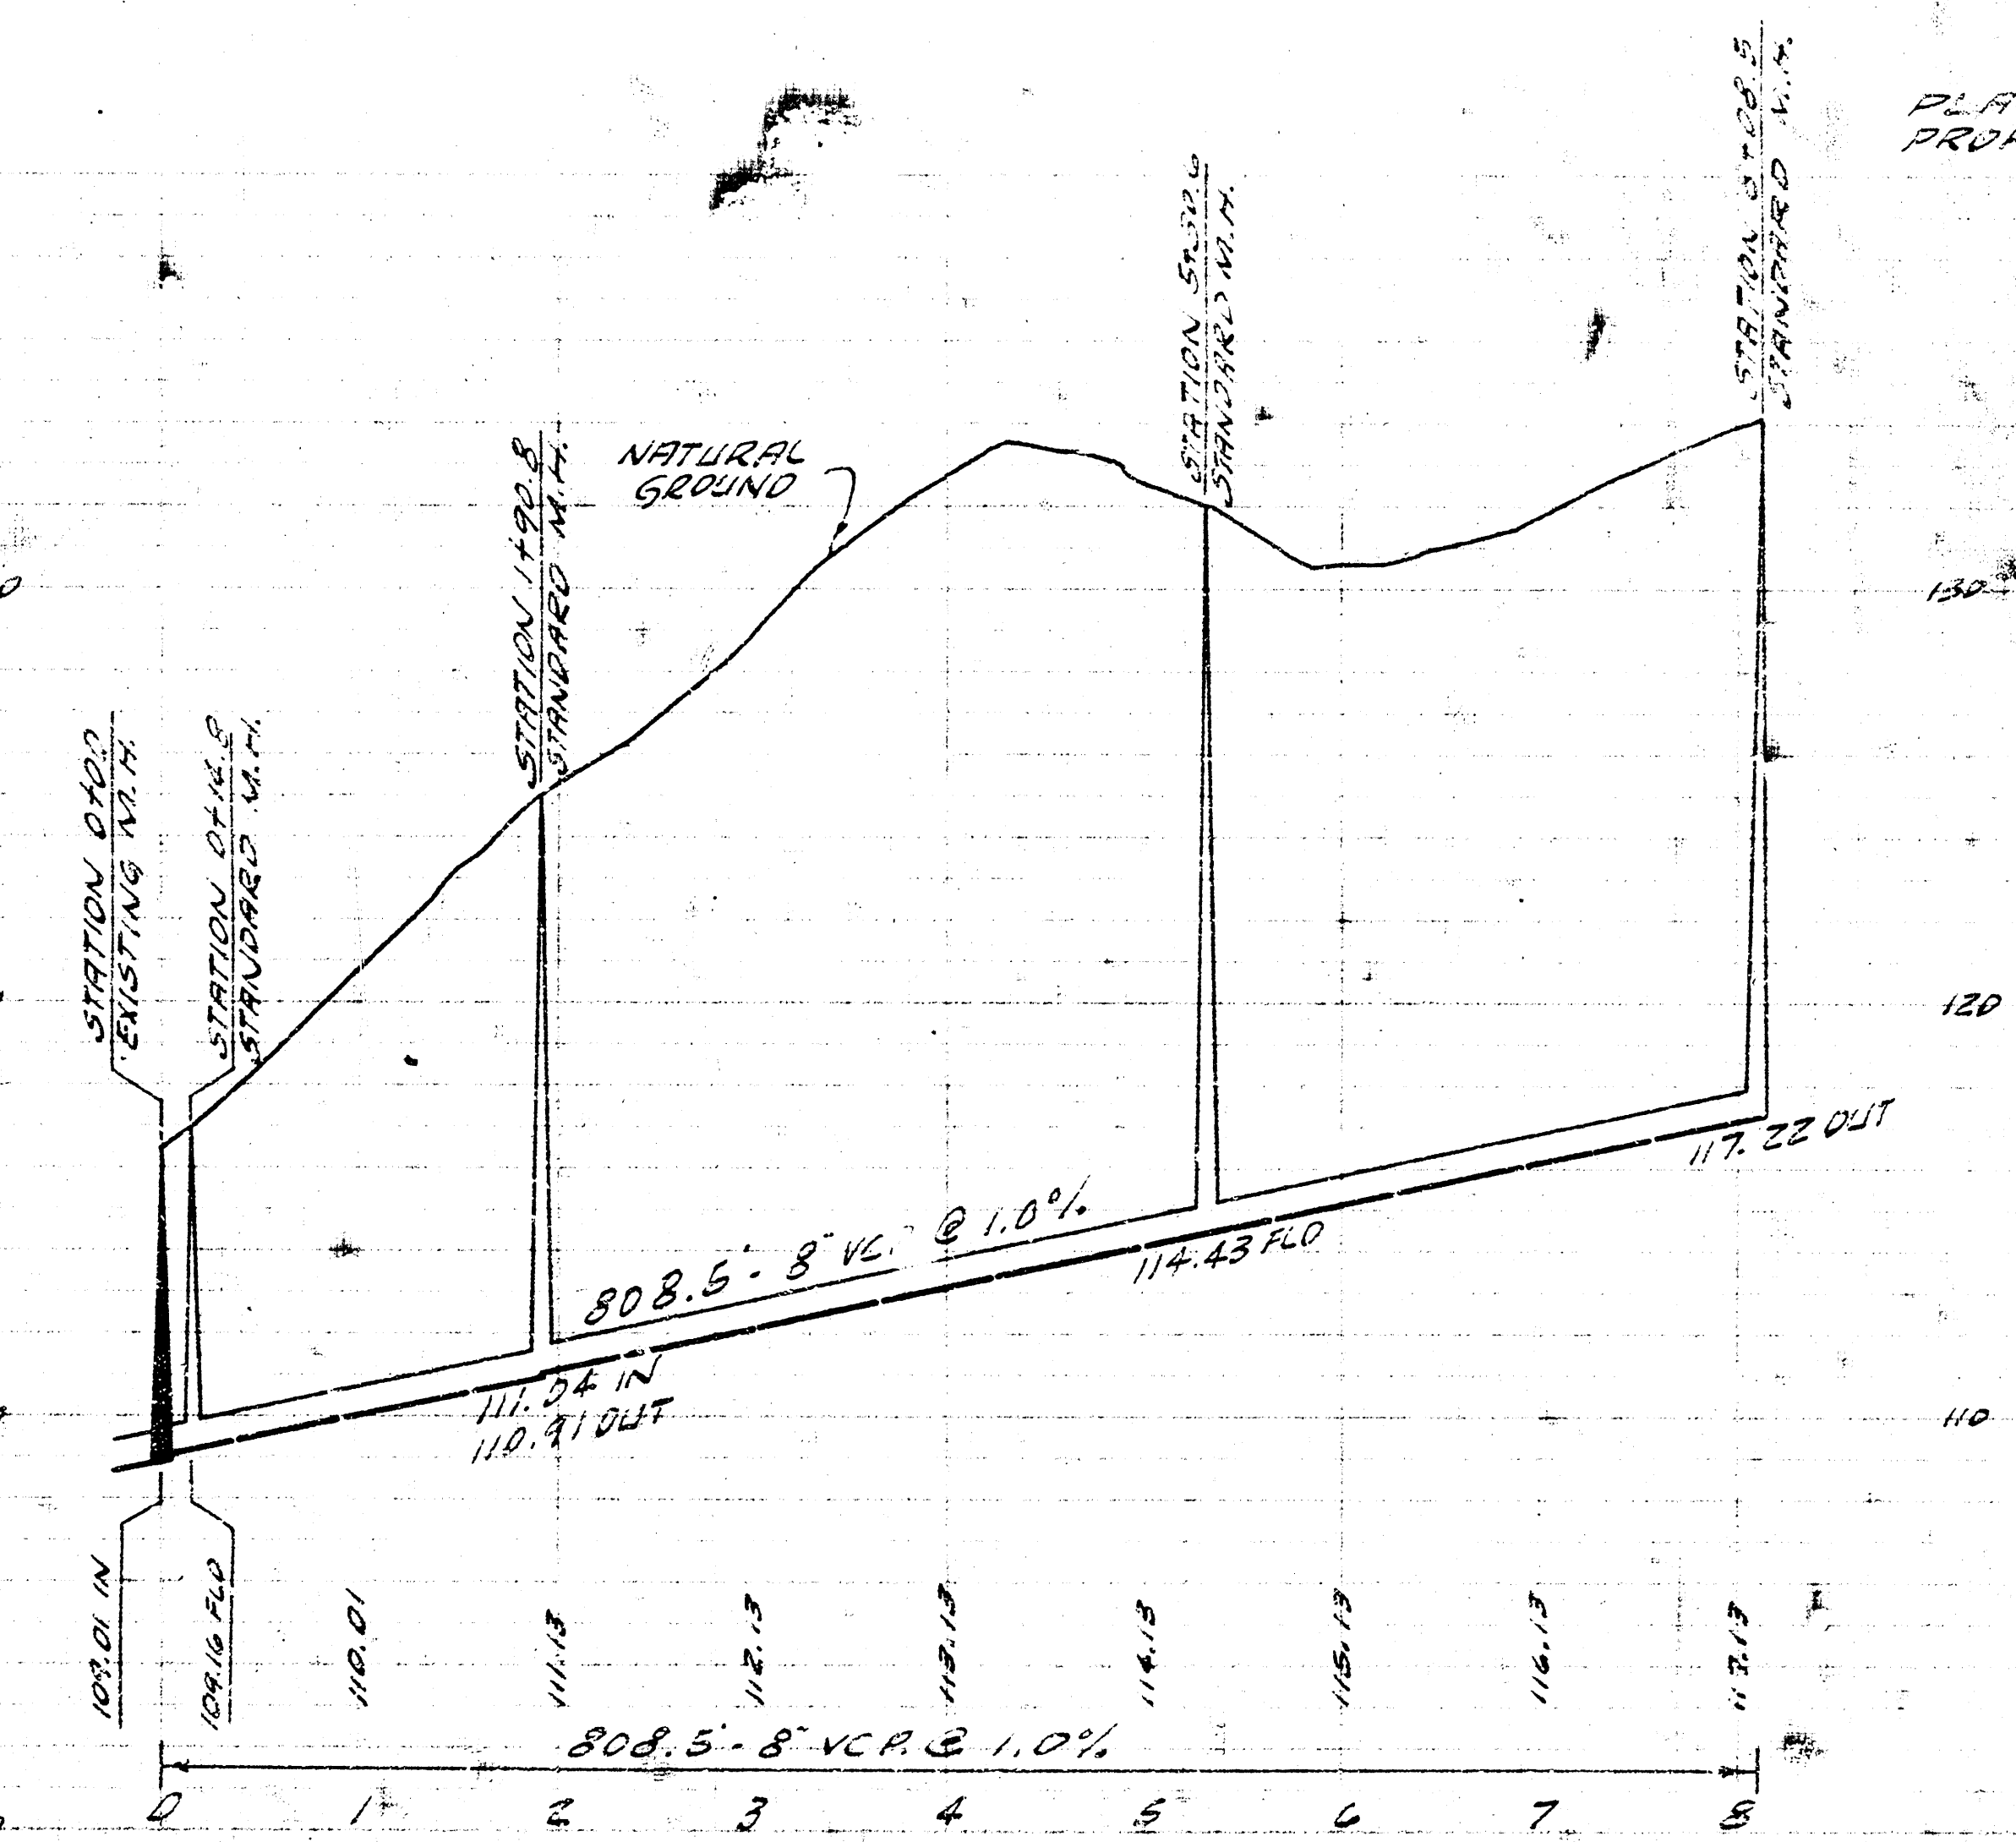

PRIVATE S.S. FOR ST. JOSEPH HOSPITAL
CITY OF WICHITA, KANSAS
B.E. SMITH CITY ENGINEER
PRIVATE JOB. JUNE 1960