

GENERAL NOTES

- Underground utility service lines are marked with pole lines to be exposed as necessary prior to construction unless the plans specifically call for their adjustment by the Contractor. Where the more specific marking is called for by the utility and their location, as shown on the plans, represent the best information available for which the Contractor will be required to work around existing utilities without the right-of-way which is not conflict with proposed construction.
- Trees and shrubs in public right-of-way which are in direct conflict with proposed new construction shall be removed by the Contractor at the Contractor's expense. Trees and shrubs which are not in direct conflict with proposed new construction shall be saved and protected from damage.
- The Contractor shall be responsible for maintaining continuous flow of sewage through existing sewer. Contractor's proposed method for maintaining flow shall be approved by the engineer. Cost of maintaining flow of sewage through construction shall be paid in detail and this cost shall be considered as overhead to the other day work of work.
- The Contractor shall be responsible for protecting property lines. The Contractor will be required to establish any property lines which are damaged or destroyed by his construction operations. Such lines shall be re-established by a licensed land surveyor in accordance with state law.

Hand signed by owner, not to be used for construction purposes without the seal of the engineer. Date: 8/19/92

Project No. **VRH 8/19/92**

Client: _____

Address: _____

City: _____

State: _____

Zip: _____

Scale: _____

Sheet No. _____

Total Sheets _____

Project Name: _____

Project Location: _____

Project Description: _____

Project Start Date: _____

Project End Date: _____

Project Status: _____

Project Manager: _____


Project Engineer: _____

Project Designer: _____


Project Checker: _____

Project Approver: _____

31ST STREET NORTH

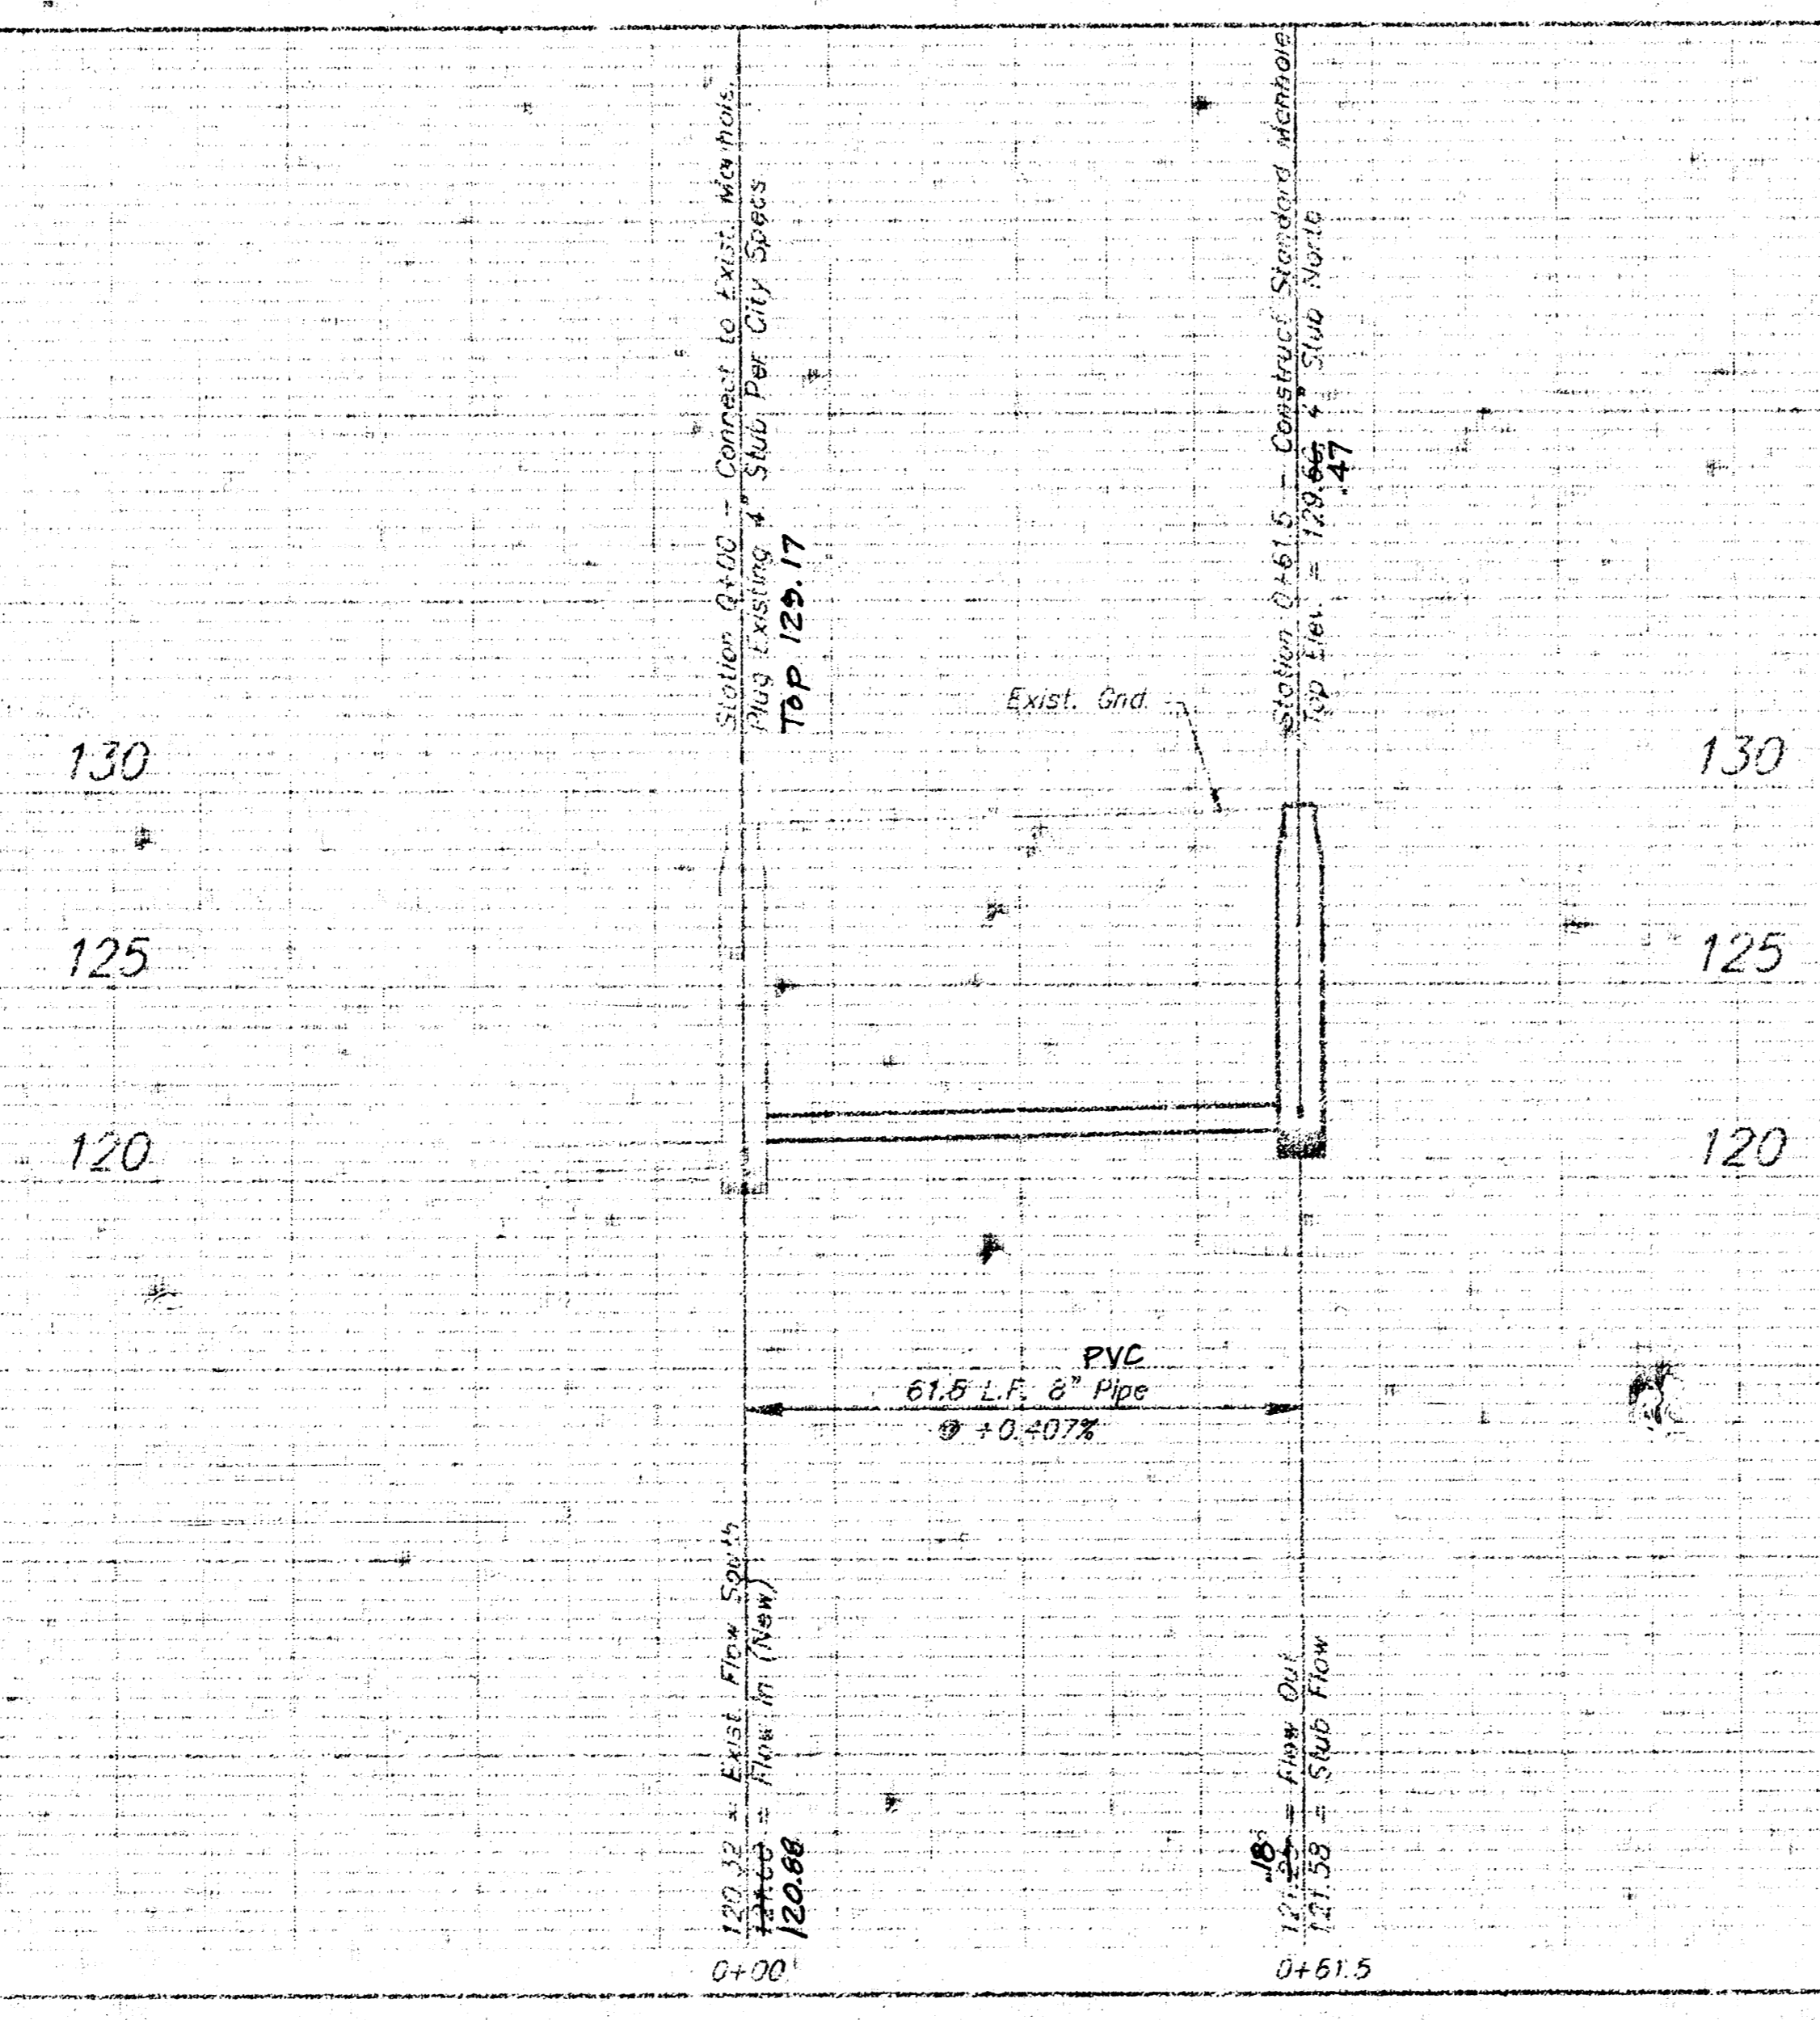

Booked
10-10-92
JKB

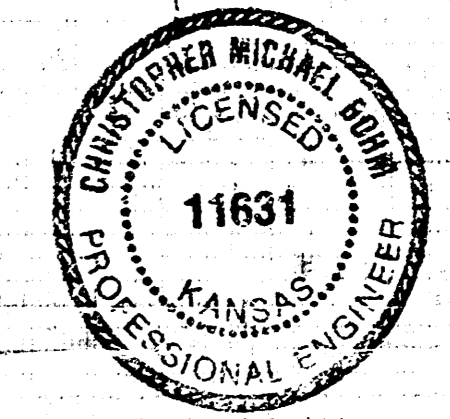

Revised as built 9-4-92

PRIVATE SANITARY SEWER EXTENSION TO SERVE PART OF LOT 1, SCHLENDER ADDITION

BAUGHMAN COMPANY P.A.
ENGINEERING & SURVEYING
114, 212, 217 • 115, 116, 117 • 118, 119, 120, 199, 200

359 PPS PROJECT NUMBER **607861**

DESIGNER: C. Schmitt
CHECKER: C. Schmitt
DATE: Aug 92