




COUNTY	STATE	PROJECT NUMBER	FISCAL YEAR	SHEET NO.	TOTAL SHEETS
SEDGWICK	KANSAS	PB-296	1997	1	1

As Built 7/25/97
Private Project No. 727 PPS (607861)

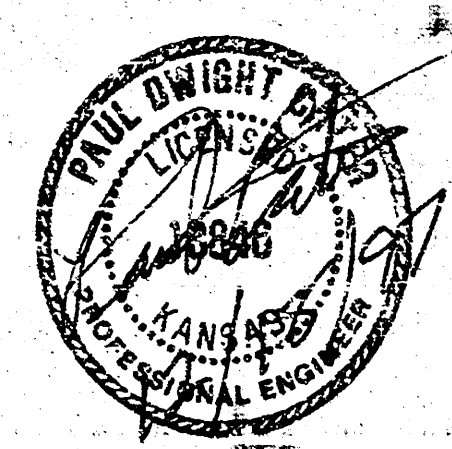

APPROVED AS NOTED
By CITY ENGINEER OF WICHITA
Sanitary Sewer: VRH 6/17/97
Storm Sewer: _____
Driveway Approaches: _____
Water Mains: _____
Paving: _____

NOTE TO CONTRACTOR
INSPECTION AND TESTING FOR THIS PROJECT IS TO BE PROVIDED BY A LICENSED CONSULTING ENGINEERING FIRM UNDER CONTRACT WITH THE OWNER/DEVELOPER. SAID INSPECTION TO BE IN ACCORDANCE WITH THE CITY OF WICHITA STANDARD CONSTRUCTION ENGINEERING PRACTICES AND CERTIFIED BY A LICENSED PROFESSIONAL ENGINEER. NO WORK SHALL BE PERFORMED IN DEDICATED EASEMENTS OR THE PUBLIC RIGHT-OF-WAY BY THE CONTRACTOR WITHOUT SUCH INSPECTION AND SHALL ANY WORK BE COMMENCED IN DEDICATED EASEMENTS OR PUBLIC RIGHT-OF-WAY WITHOUT WRITTEN AUTHORIZATION BY THE CITY ENGINEER. CONSTRUCTION SHALL BE IN ACCORDANCE TO THE CITY OF WICHITA STANDARD SPECIFICATIONS.

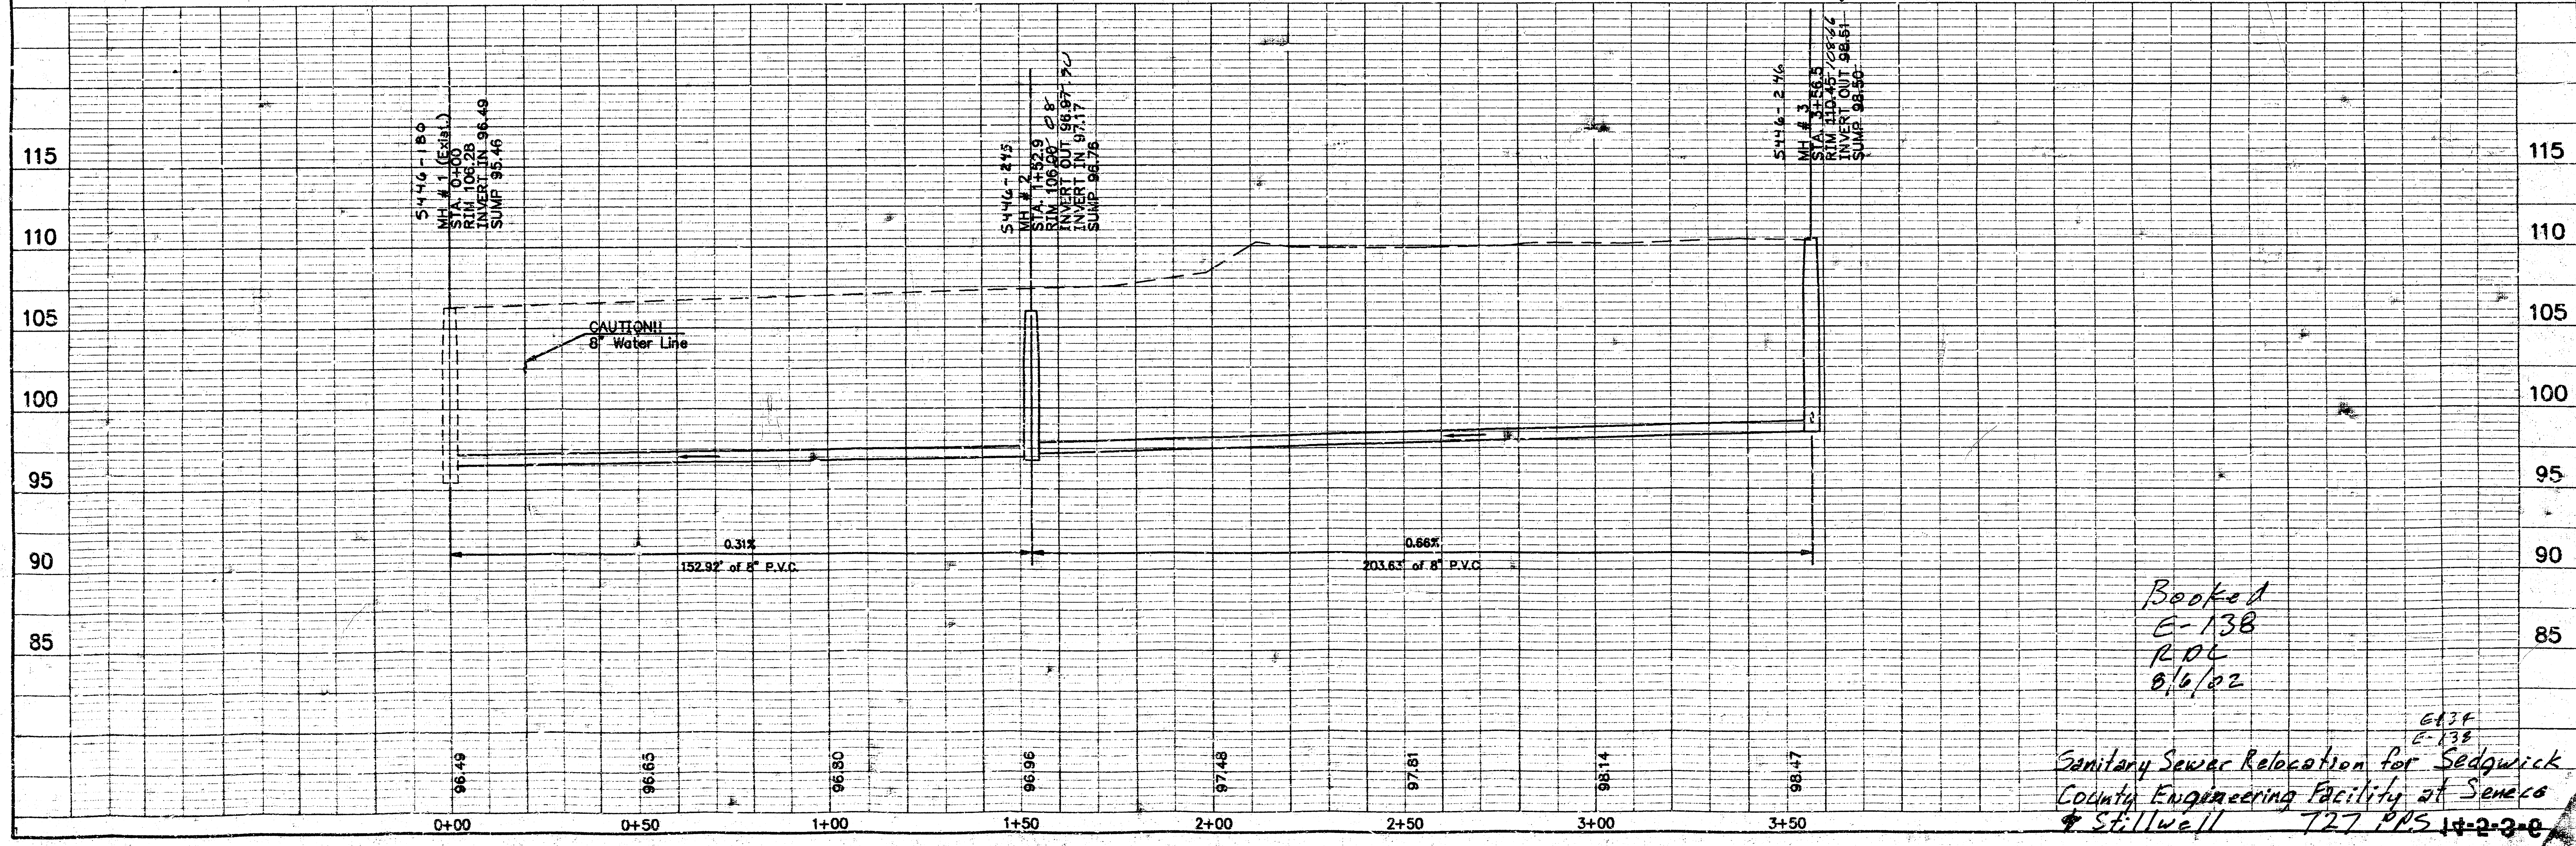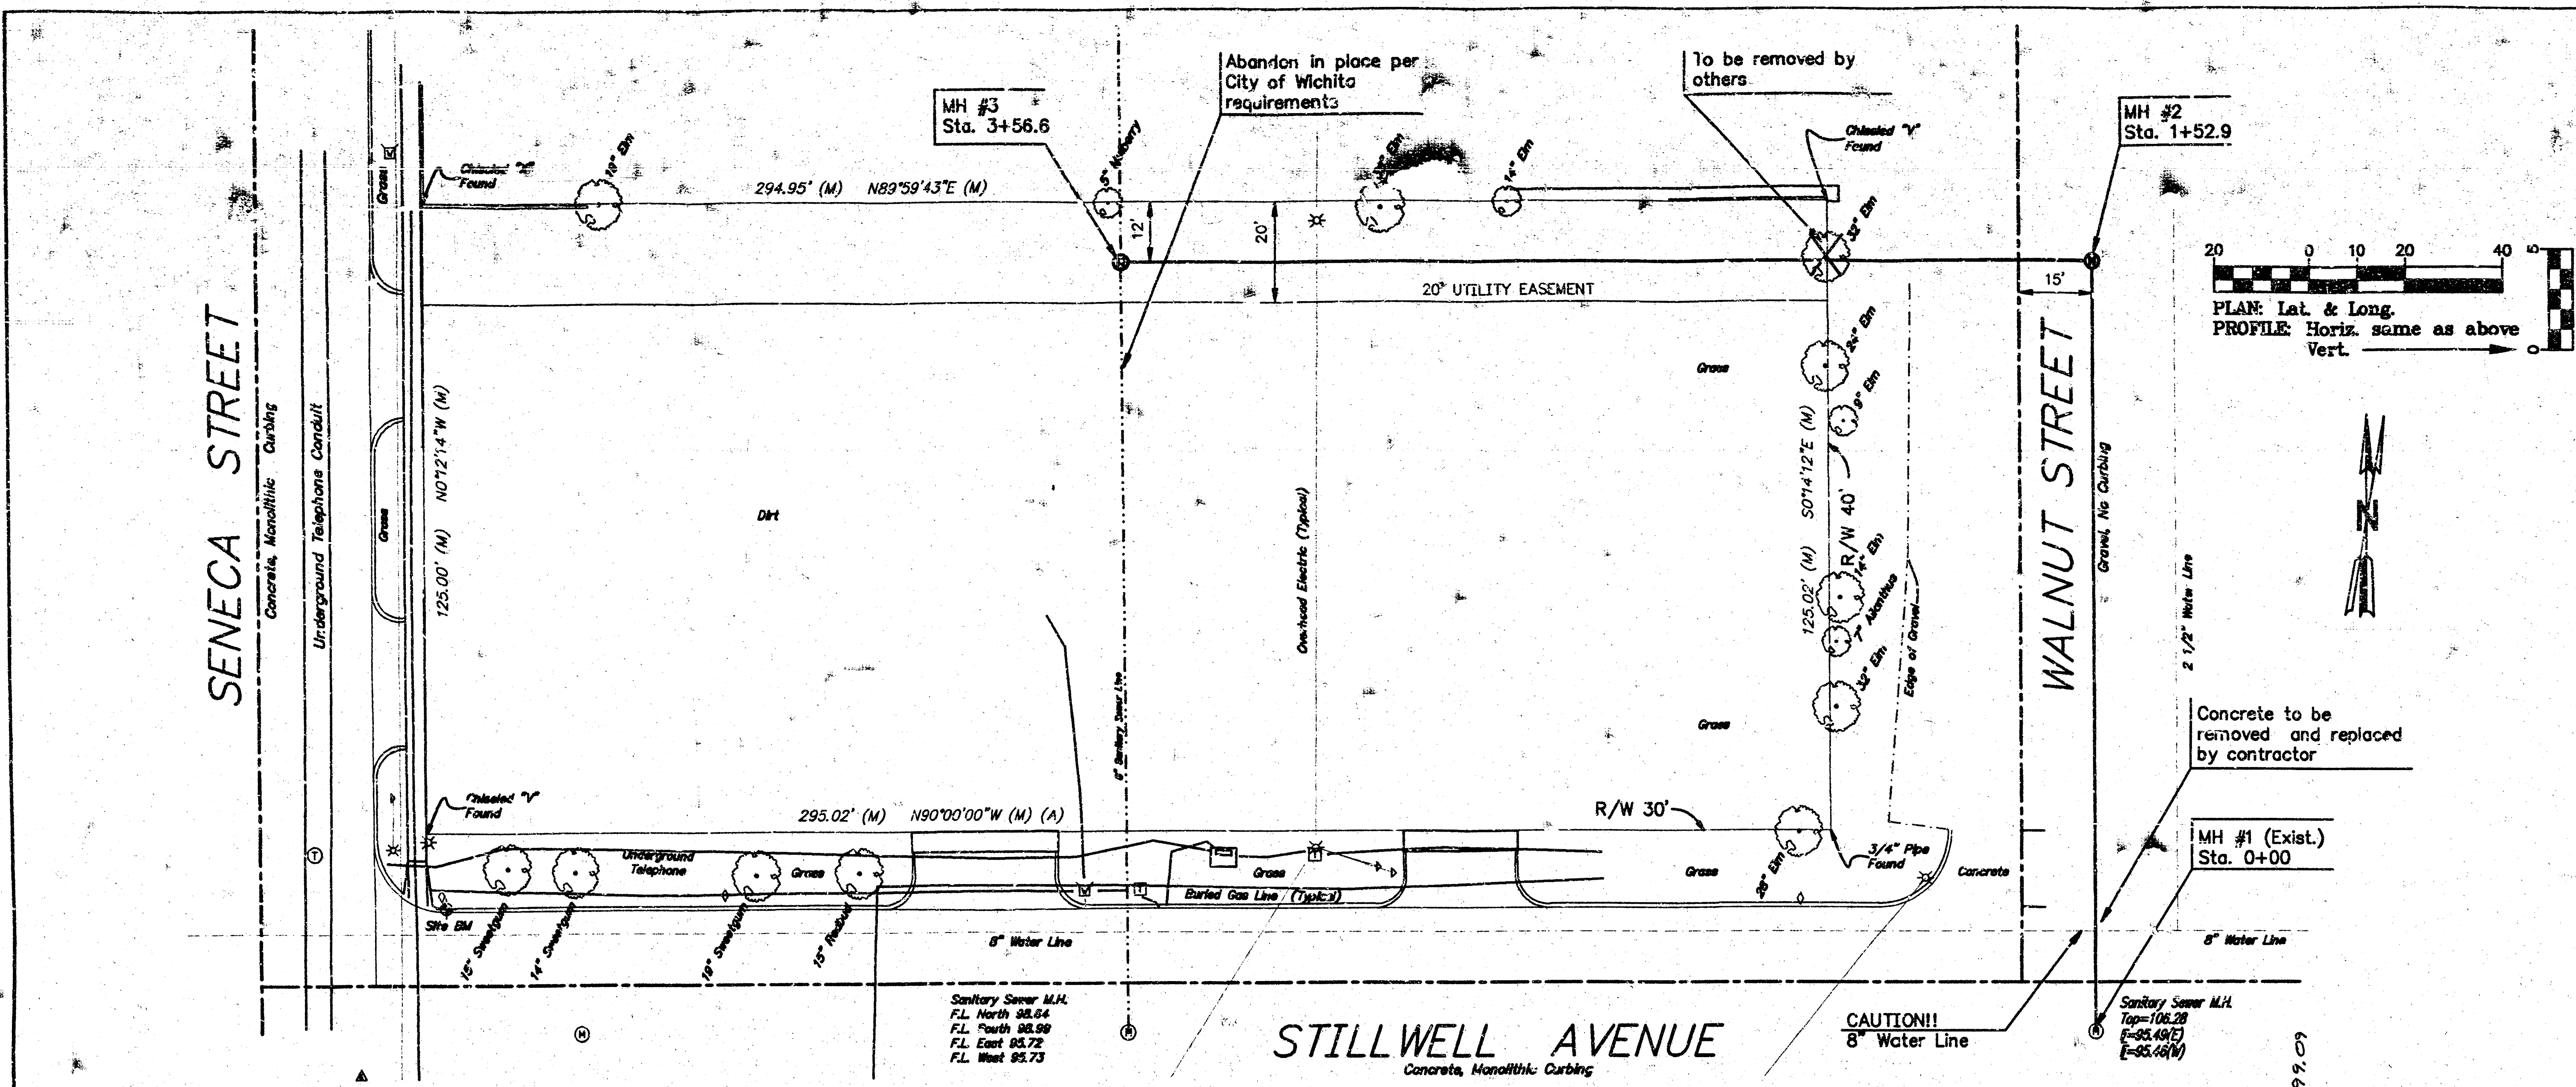

Booked
E-138
R.D.C.
8/6/02
Sanitary Sewer Relocation for Sedgwick
County Engineering Facility at Seneca
+ Stillwell 727 PPS 1+2-2-0

UL-00058 MCH JUN 16 10 58 11 1997 DRAFT-KMT