


CITY OF WICHITA, KANSAS

Sanitary Sewer Extension to Serve
Tract 'B', Lot 14, Sherwood Glen 5th Add.

MICHAEL E. LINDEBAK, P.E., CITY ENGINEER

PROJECT #: 217PPS



INDEX #: 607861

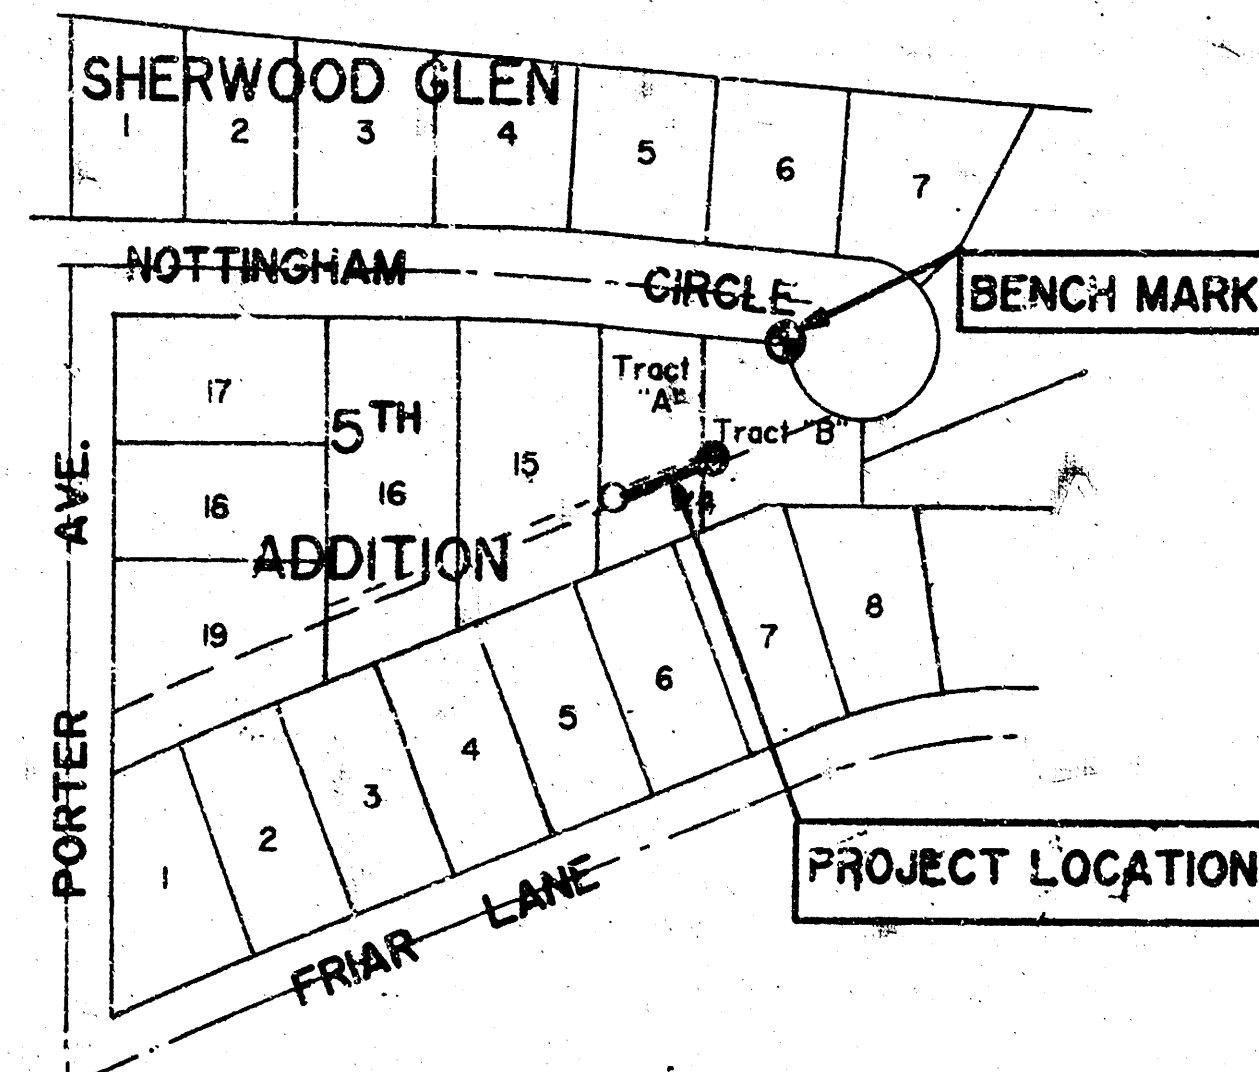

LOCATION MAP


GENERAL NOTES:

1. BENCH MARK: 1' CHISELED ON TOP OF CURB, SOUTH SIDE OF NOTTINGHAM CIRCLE; AT BEGINNING RETURN OF CUL-DE-SAC. ELEVATION = 132.48
2. THE CONTRACTOR IS RESPONSIBLE FOR PRESERVING PROPERTY IRONS. THE CONTRACTOR WILL BE REQUIRED TO RE-ESTABLISH ANY PROPERTY IRONS WHICH ARE DAMAGED OR DESTROYED BY HIS CONSTRUCTION OPERATIONS. SUCH IRONS SHALL BE RE-ESTABLISHED BY A LICENSED LAND SURVEYOR OR LICENSED PROFESSIONAL ENGINEER IN ACCORDANCE WITH STATE LAW.

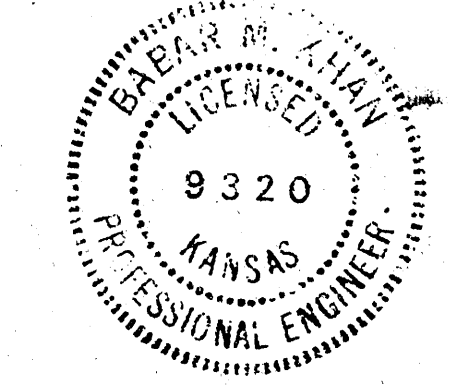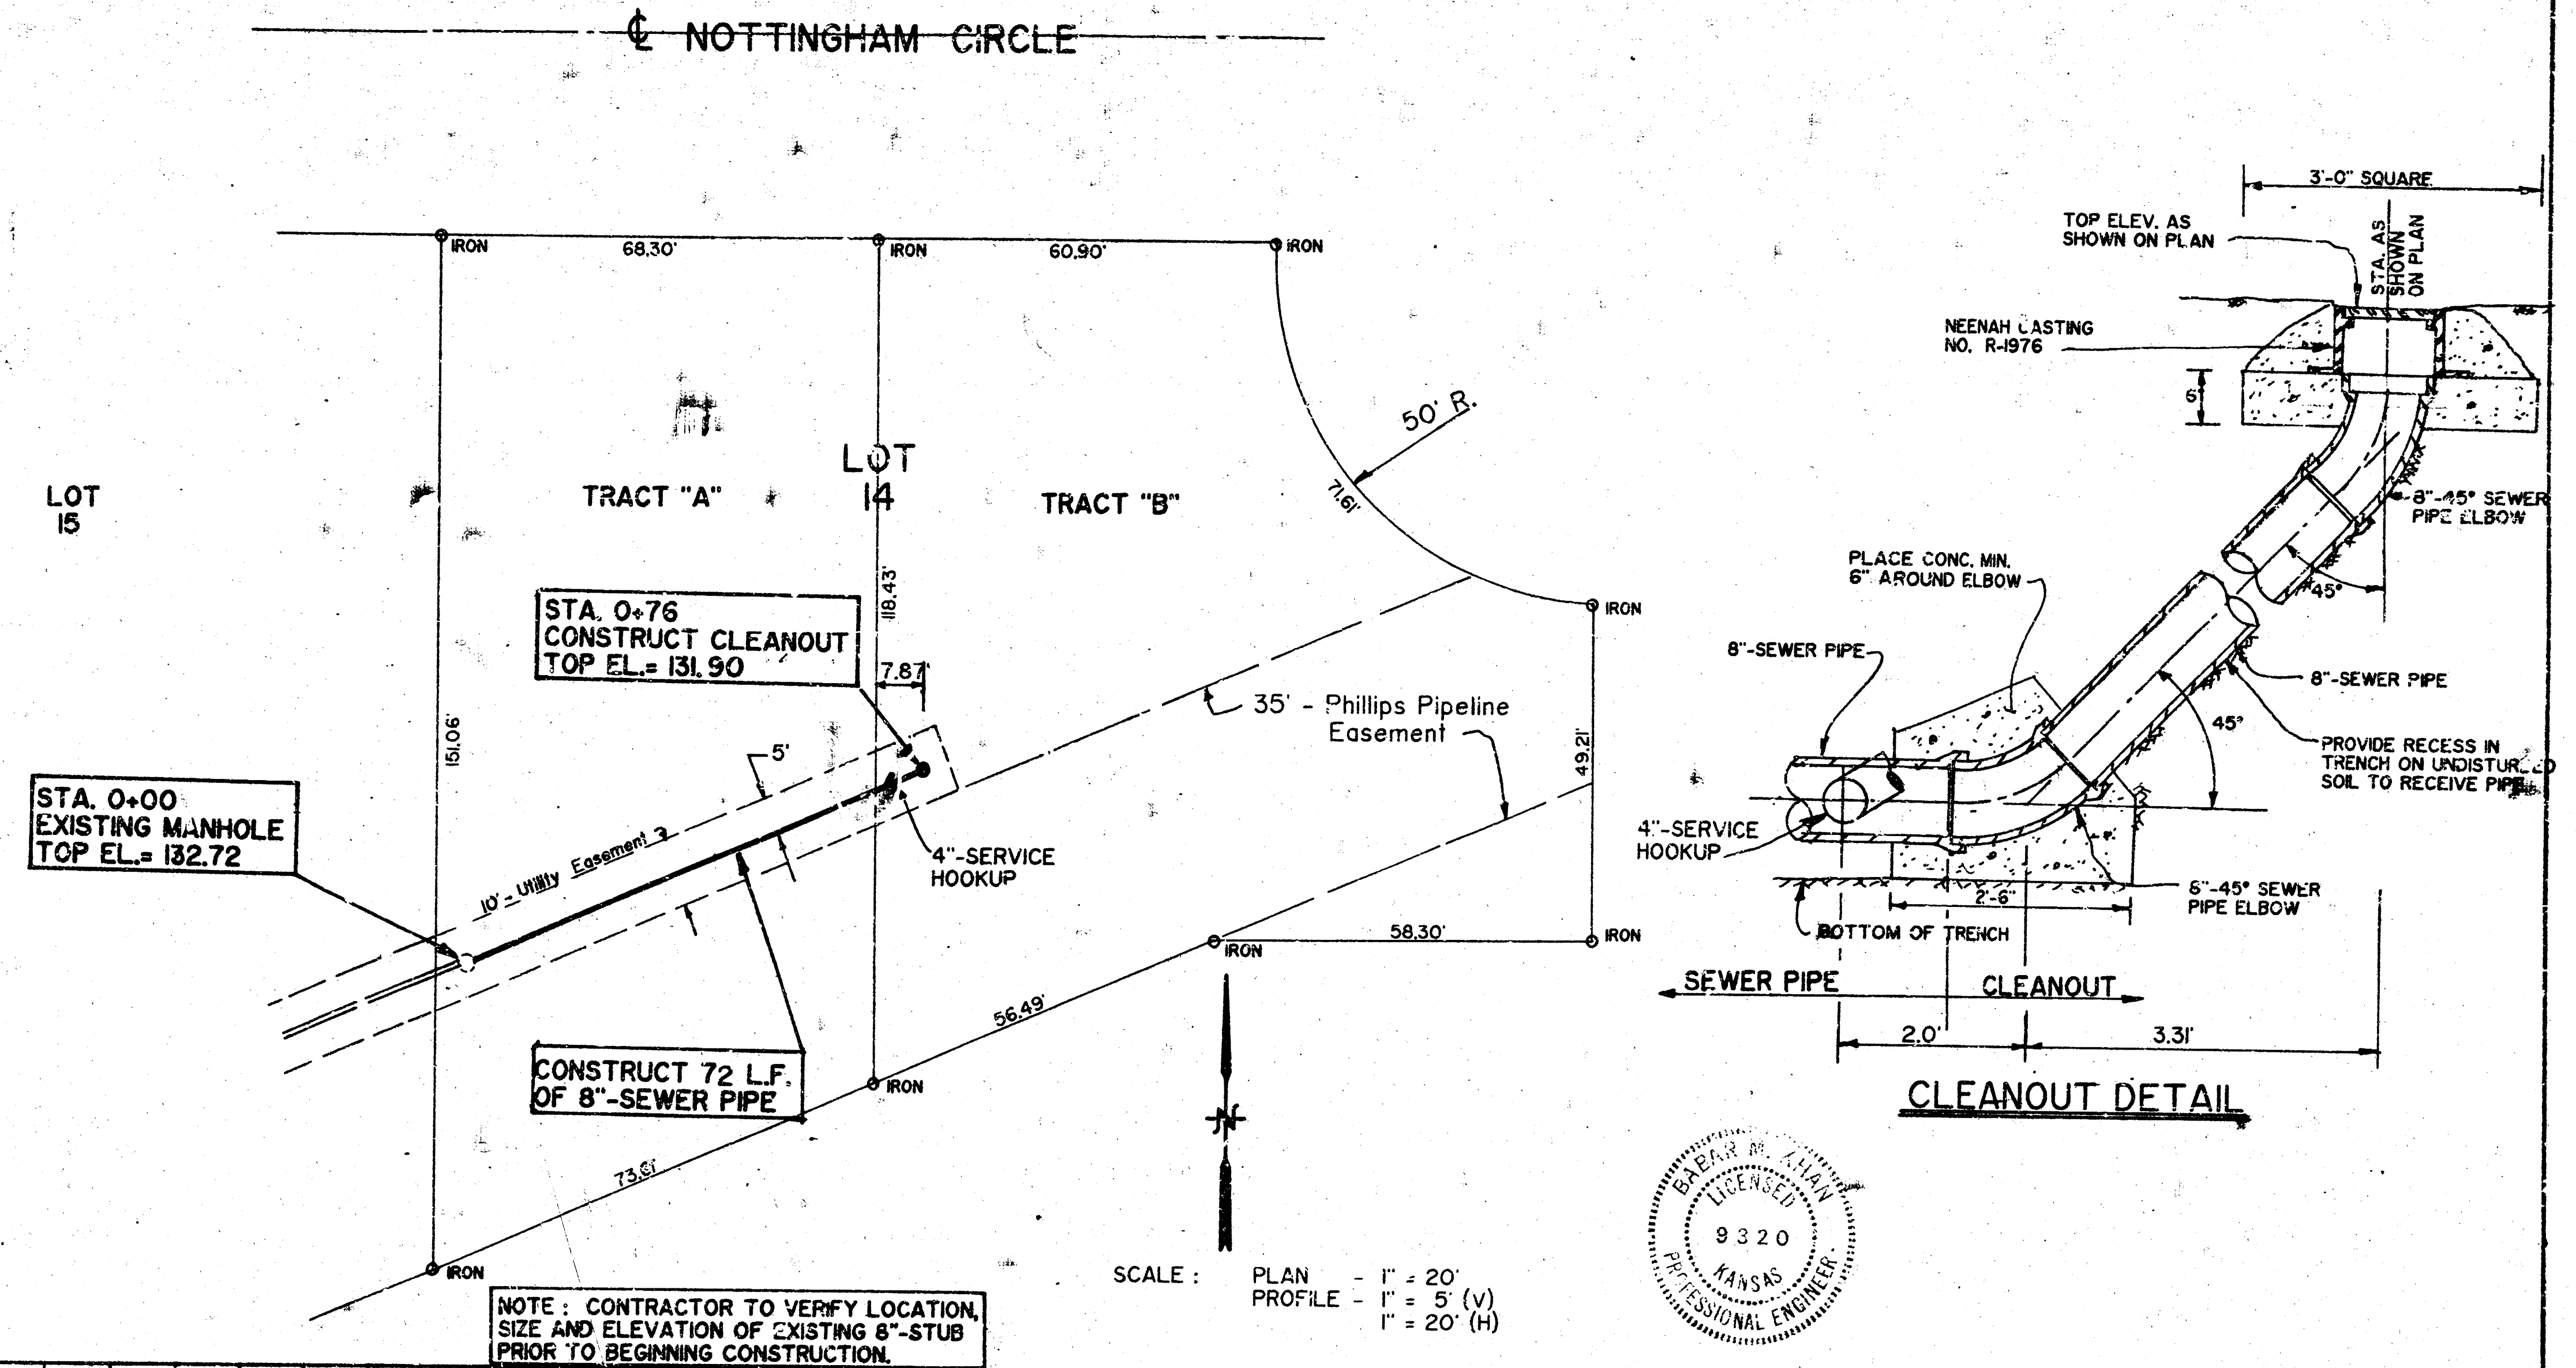


PLAN	DATE	BY	REVISION
1			ISSUED FOR PERMIT
2			FOR CITY REVIEW
3			FOR CITY REVIEW
4			FOR CITY REVIEW
5			FOR CITY REVIEW
6			FOR CITY REVIEW
7			FOR CITY REVIEW
8			FOR CITY REVIEW
9			FOR CITY REVIEW
10			FOR CITY REVIEW

PROFILE	DATE	BY	REVISION
1			ISSUED FOR PERMIT
2			FOR CITY REVIEW
3			FOR CITY REVIEW
4			FOR CITY REVIEW
5			FOR CITY REVIEW
6			FOR CITY REVIEW
7			FOR CITY REVIEW
8			FOR CITY REVIEW
9			FOR CITY REVIEW
10			FOR CITY REVIEW

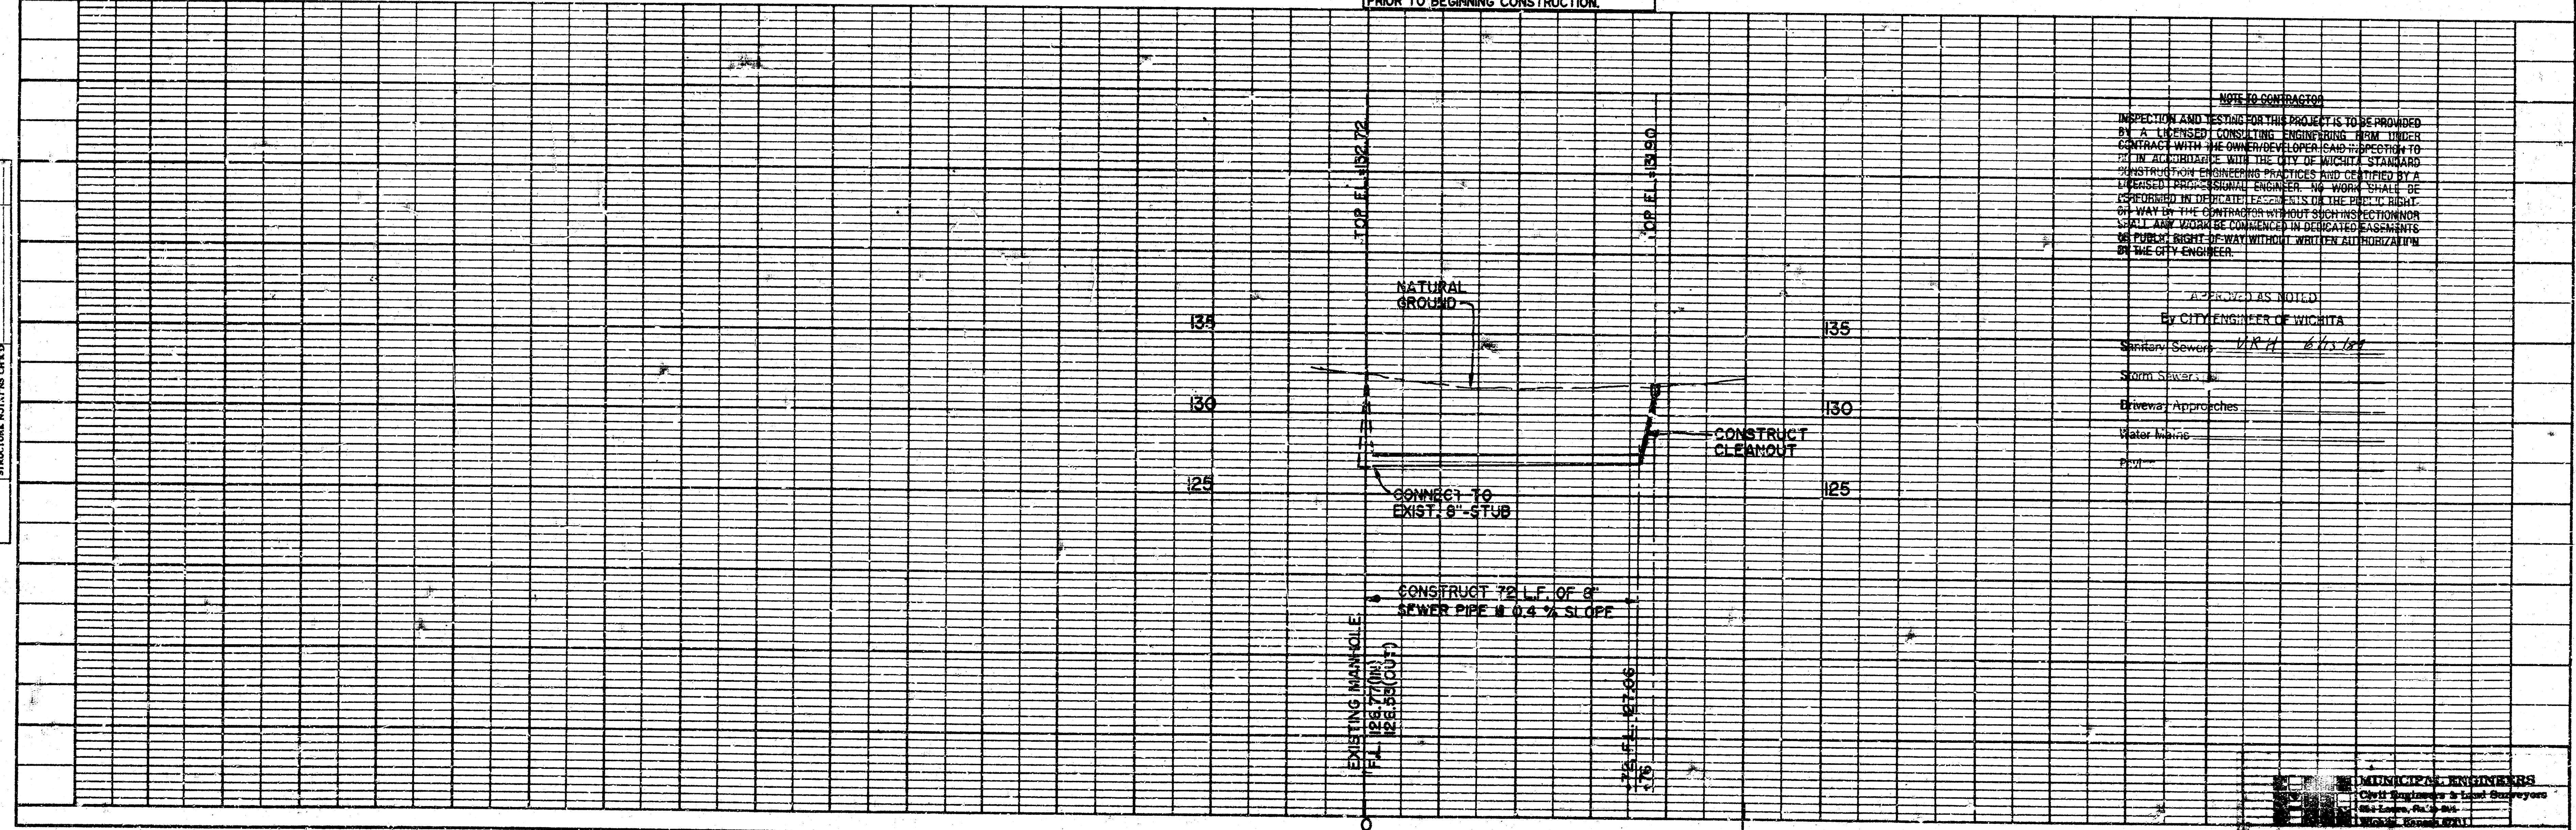

NOTE TO CONTRACTOR
INSPECTION AND TESTING FOR THIS PROJECT IS TO BE PROVIDED BY A LICENSED CONSULTING ENGINEERING FIRM UNDER CONTRACT WITH THE OWNER/DEVELOPER SAID INSPECTION TO BE IN ACCORDANCE WITH THE CITY OF WICHITA STANDARD SPECIFICATIONS FOR CONSTRUCTION PRACTICES AND CERTIFIED BY A LICENSED PROFESSIONAL ENGINEER. NO WORK SHALL BE COMPLETED IN DEVIATION OF THESE SPECIFICATIONS WITHOUT THE WRITTEN APPROVAL OF THE CITY ENGINEER.

APPROVED AS NOTED
By CITY ENGINEER OF WICHITA
Sanitary Sewer: *[Signature]*
Storm Sewer: *[Signature]*
Driveways/Approaches: *[Signature]*
Water Mains: *[Signature]*
Pipes: *[Signature]*

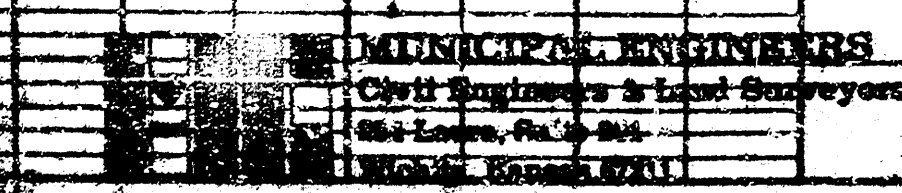

Sanitary Sewer Extension to Serve
Tract 'B', Lot 14, Sherwood Glen 5th Add.
MICHAEL E. LINDEBAK, P.E., CITY ENGINEER


PROJECT # : 217PPS

INDEX # : 607861



GENERAL NOTES:

1. BENCH MARK: "A" CHISELED ON TOP OF CURB, SOUTH SIDE OF NOTTINGHAM CIRCLE, AT BEGINNING RETURN OF CUL-DE-SAC. ELEVATION: 132.45

2. THE CONTRACTOR IS RESPONSIBLE FOR PRESERVING PROPERTY RIMS. THE CONTRACTOR WILL BE REQUIRED TO RE-ESTABLISH ANY PROPERTY RIMS WHICH ARE DAMAGED OR DESTROYED BY HIS CONSTRUCTION OPERATIONS. SUCH RIMS SHALL BE RE-ESTABLISHED BY A LICENSED LAND SURVEYOR OR LICENSED PROFESSIONAL ENGINEER IN ACCORDANCE WITH STATE LAW.

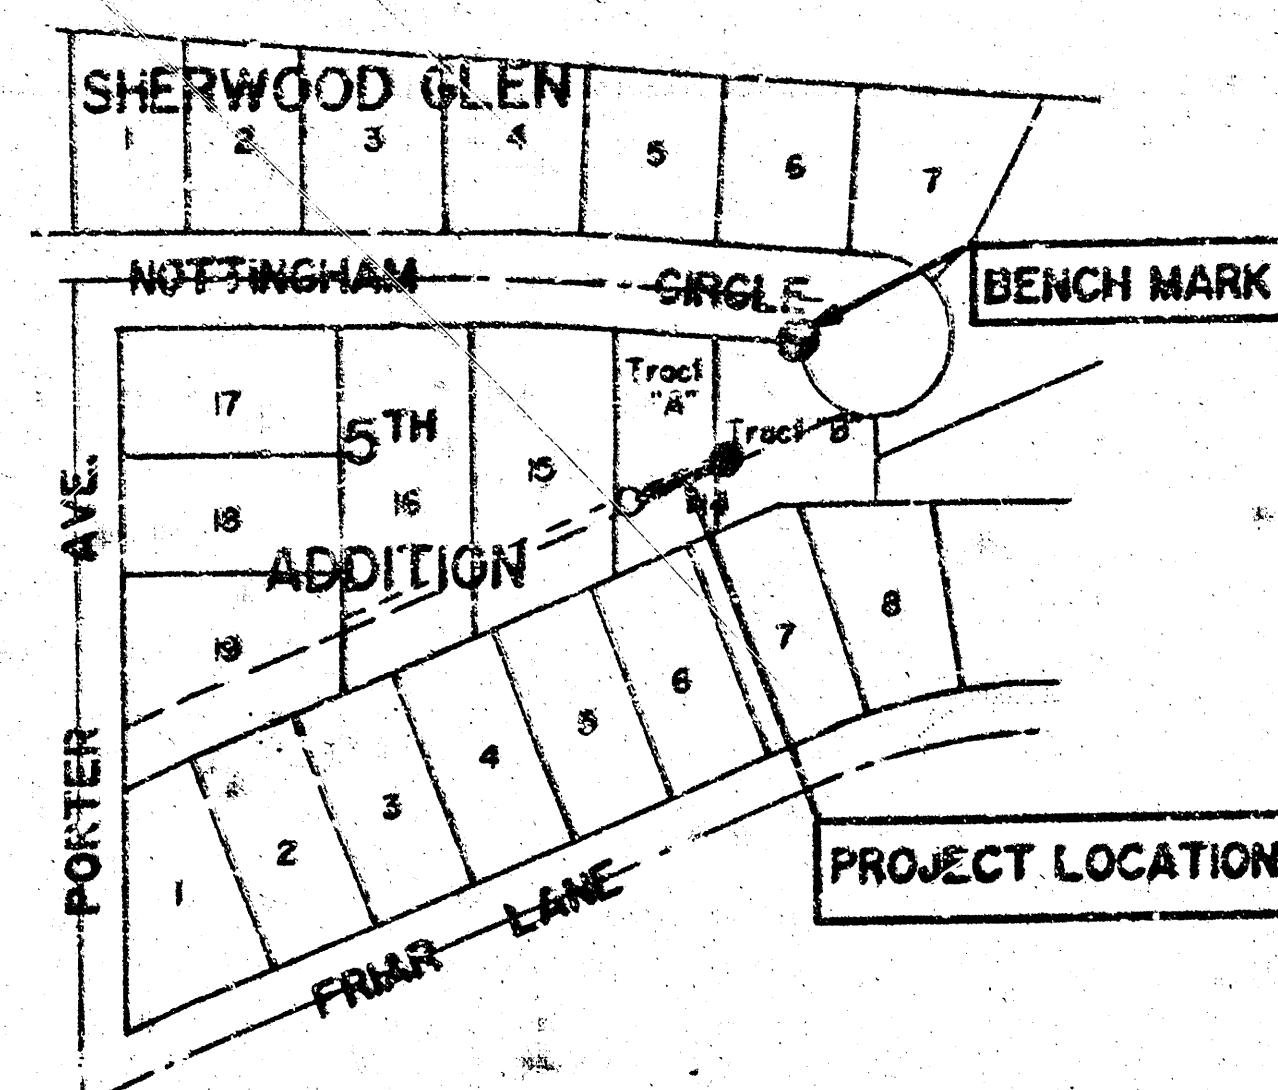

LOCATION MAP

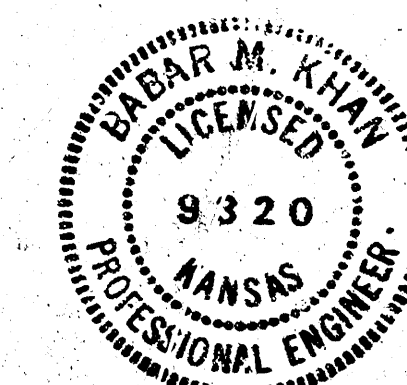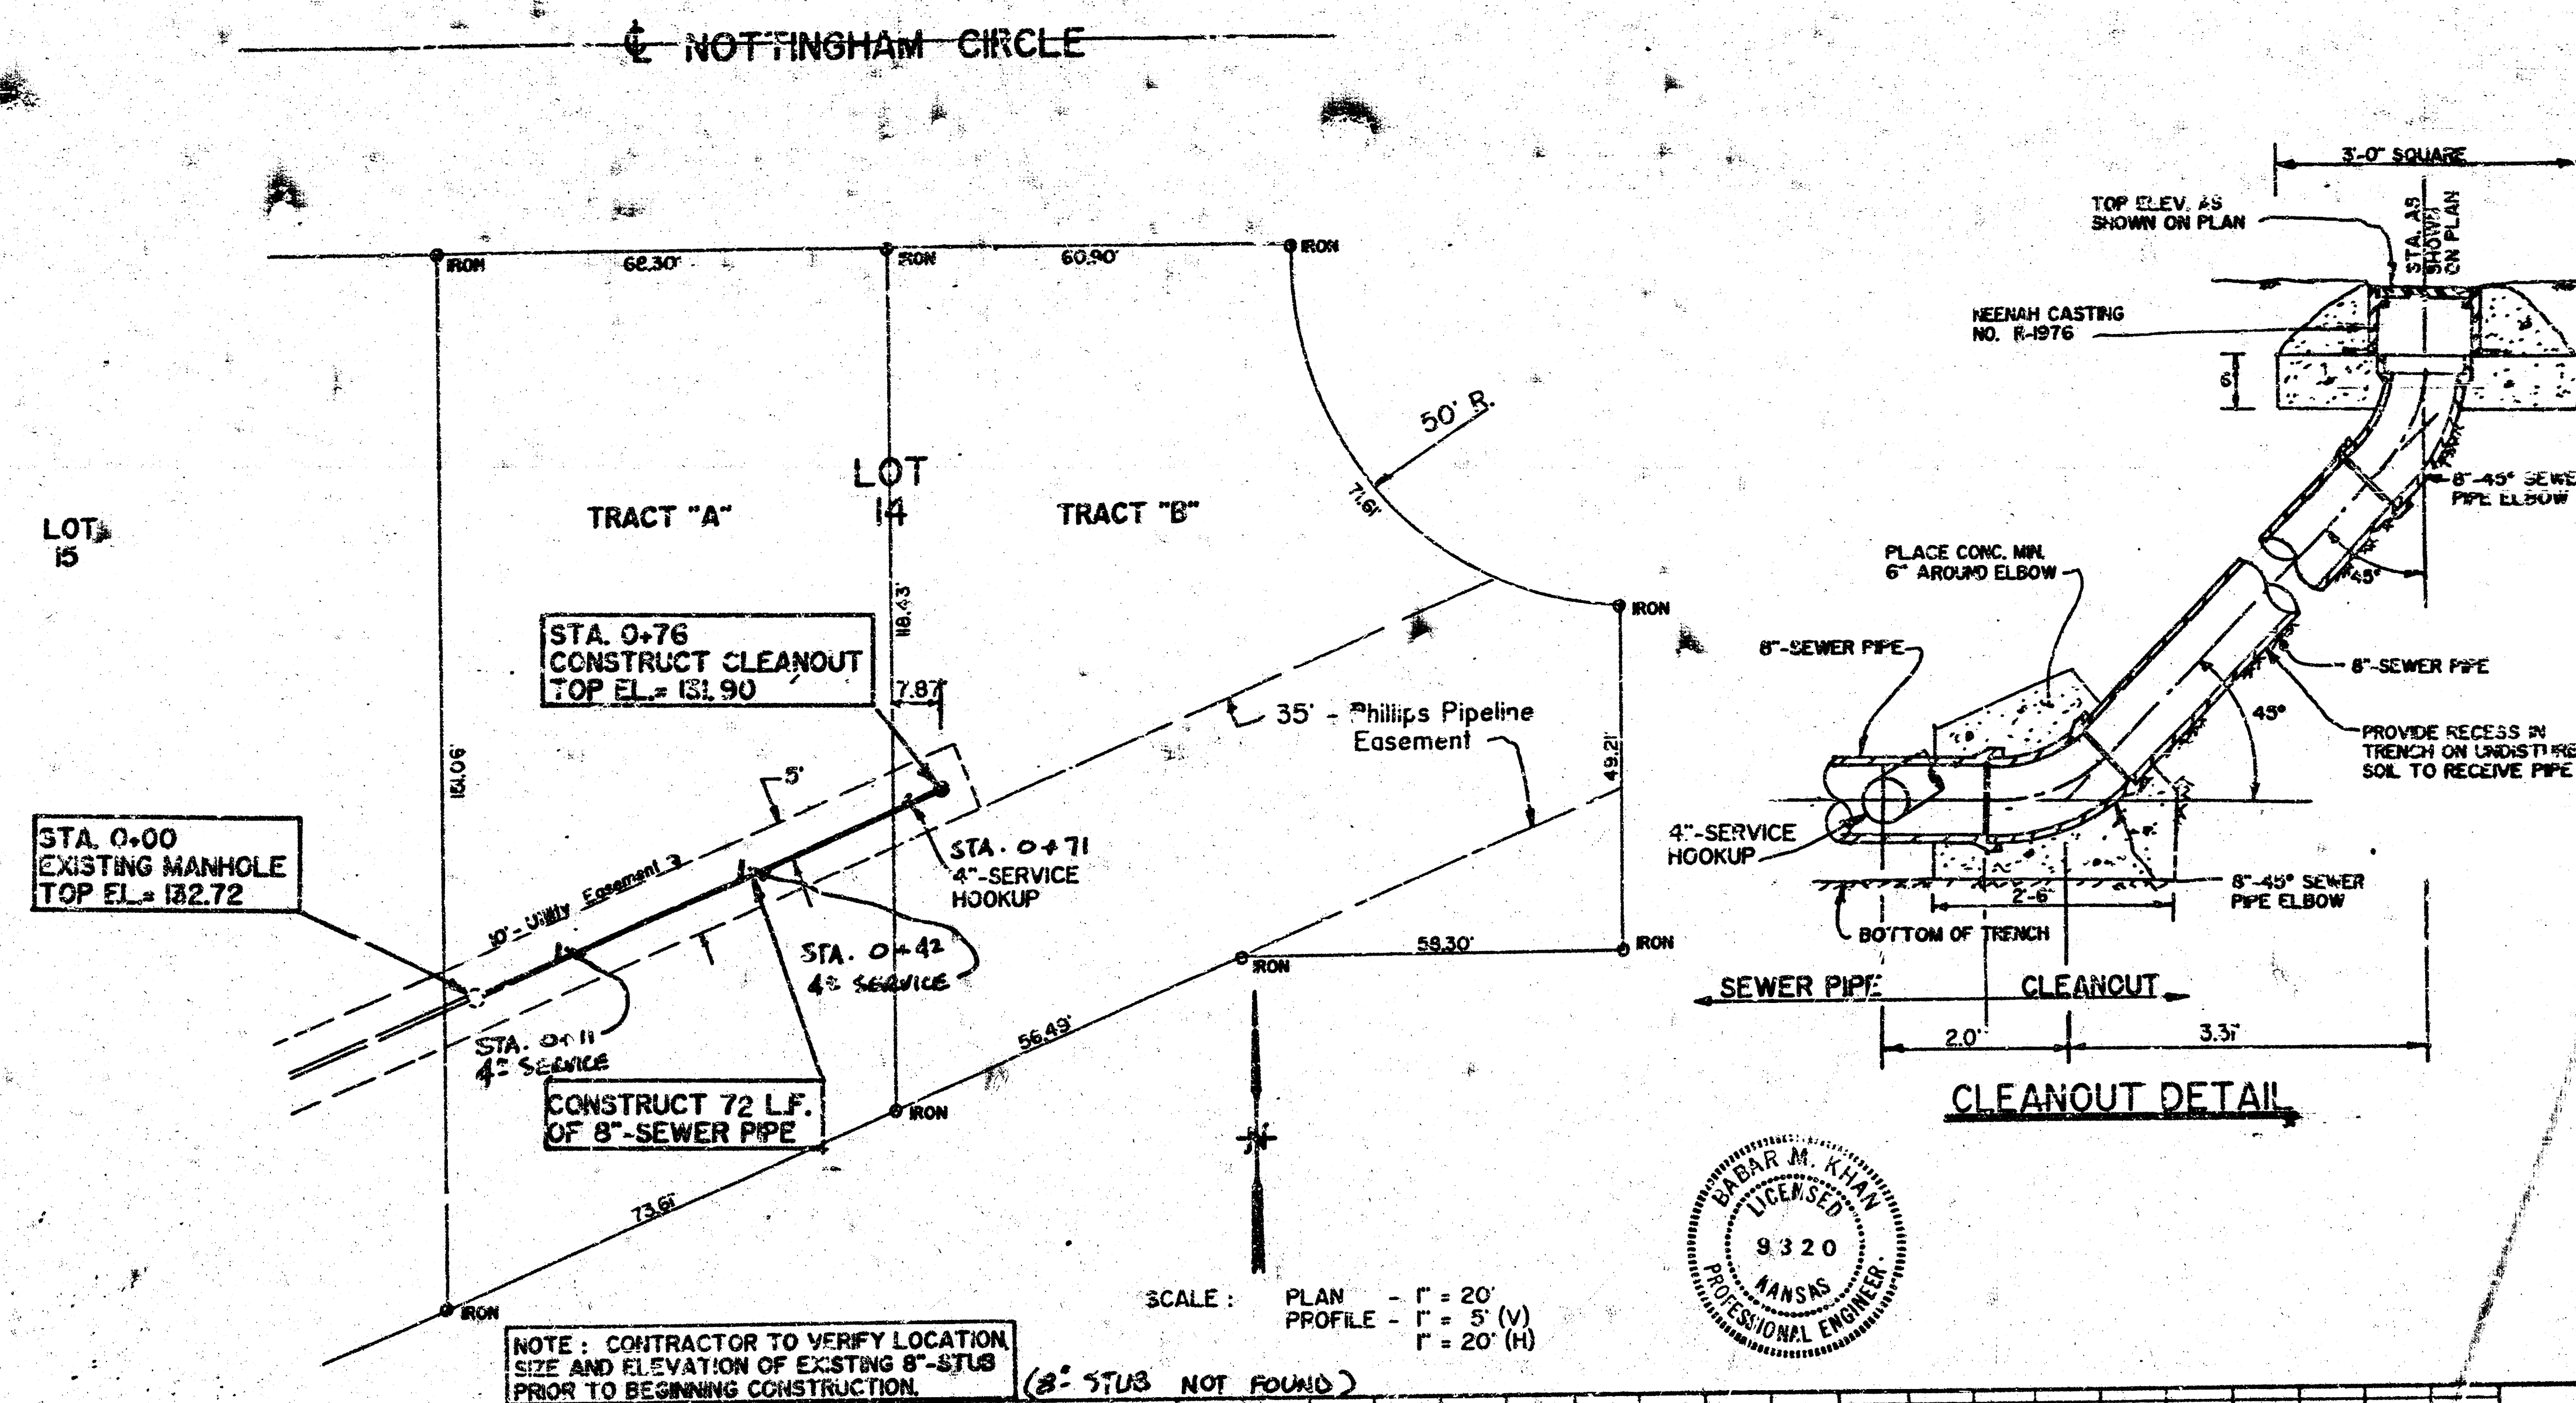

NOTE TO CONTRACTOR

IN REPLY TO AND TESTING FOR THIS PROJECT IS TO BE PROVIDED BY A LICENSED CONSULTING ENGINEERING FIRM UNDER CONTRACT WITH THE OWNER/DEVELOPER. SAID REPORT IS TO BE PROVIDED IN ACCORDANCE WITH THE CITY OF MINNEAPOLIS STANDARD CONSTRUCTION ENGINEERING PRACTICES AND CERTIFIED BY A LICENSED PROFESSIONAL ENGINEER. NO WORK SHALL BE PERFORMED IN DELEGATED RESPONSIBILITIES FOR THE PUBLIC TRANSITATION. IN THE CONTRACT DOCUMENTS, THE FOLLOWING SECTION IS TO BE DELETED: SECTION 01100 - GENERAL NOTES. THE FOLLOWING IS TO BE ADDED: SECTION 01100 - GENERAL NOTES. THE FOLLOWING IS TO BE ADDED: SECTION 01100 - GENERAL NOTES. THE FOLLOWING IS TO BE ADDED: SECTION 01100 - GENERAL NOTES.

APPROVED AS NOTED
By CITY ENGINEER OF VICTORIA
Sanitary Sewer 4" R.H. 6/15/72
Storm Sewers _____
Brawley Approaches _____
Pier Mounting _____
Basin _____

AS BUILT

MUNICIPAL ENGINEERS
Civil Engineers & Local Surveyors
254 Leona, Suite 801
Chicago, Illinois 60601

SANITARY SEWER EXTENSION TO SERVE TRACT "B", LOT 14, SHERWOOD GLEN 5TH ADDITION

PLATE 1. PLAN. PROFILE. F.A.S.
CLEARPRINT PAPER CO., S.F. CAL.
NO. 100H-1