


PLAN	DATE	BY
	SURVEYED: _____ PLANNED: _____ NOTE BOOK: _____ NO. _____	

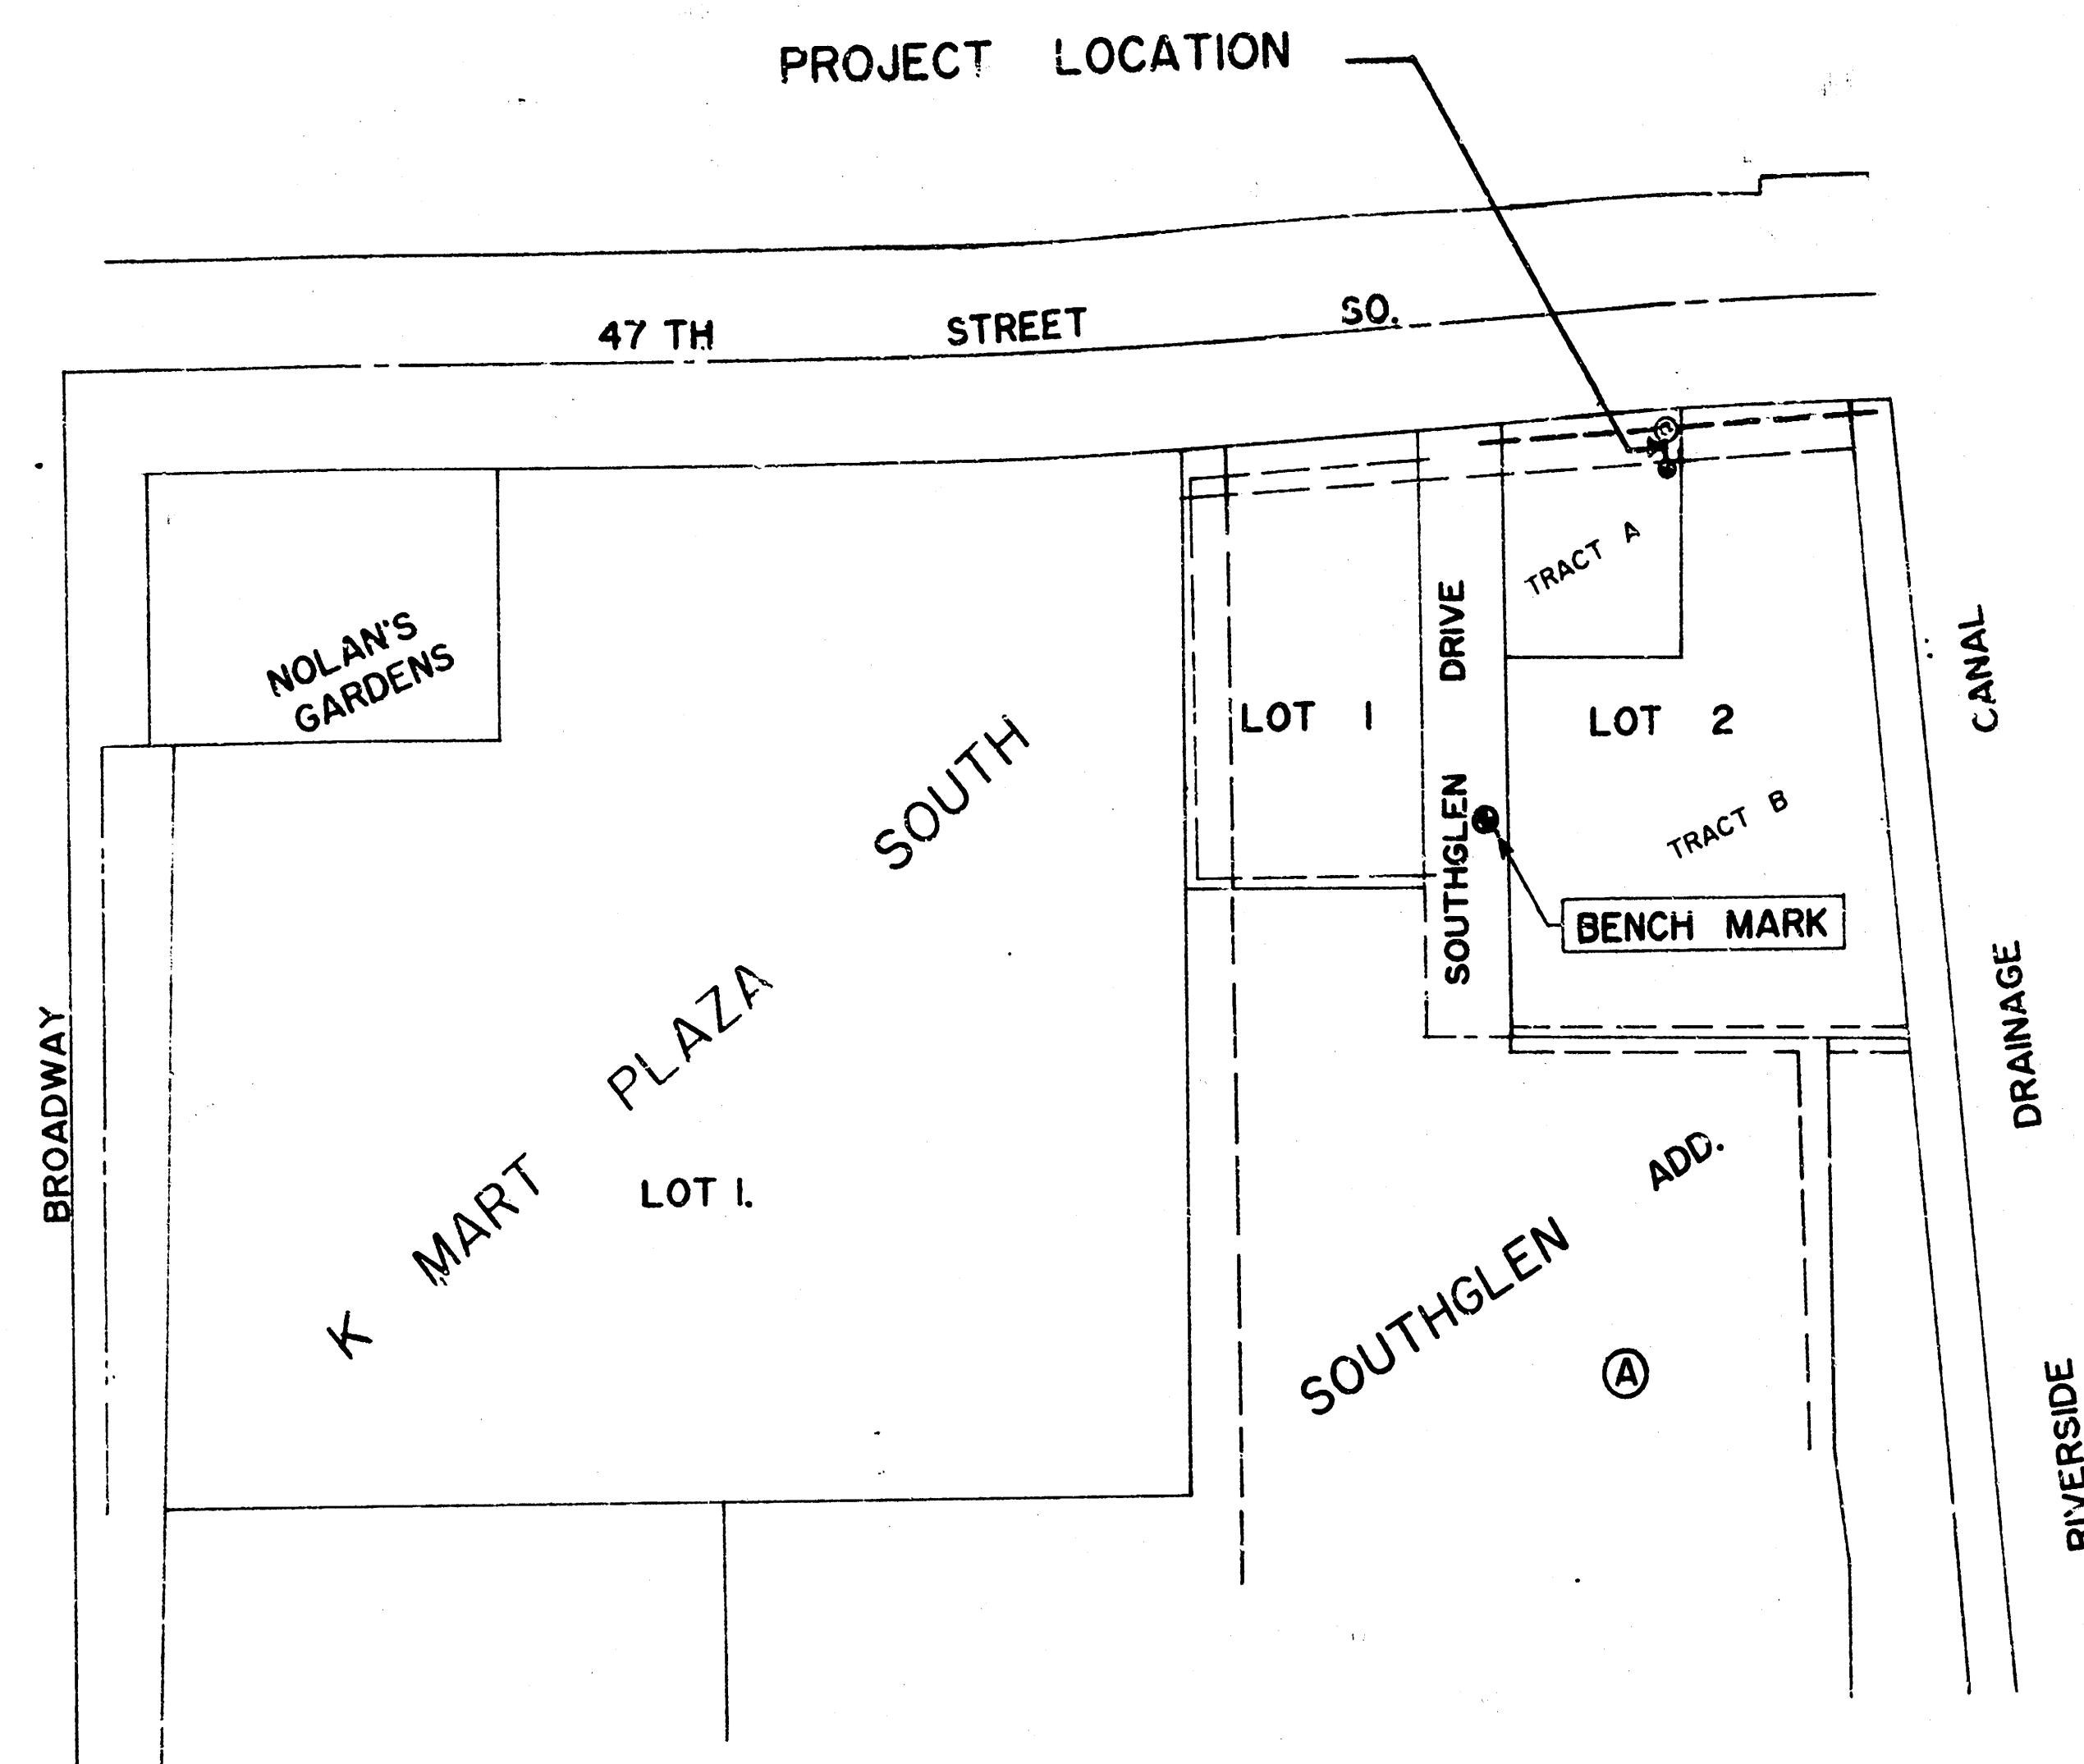

LOCATION MAP


SANITARY SEWER EXTENSION
TO SERVE
TRACT A, LOT 2, BLOCK A,
SOUTHGLEN ADDITION
WICHITA, KANSAS

PROJECT NO.: 468 - 76 - 245 - 80001 - 000 - 000 - 173

SCALE: 1" = 150'

GENERAL NOTES:

1. Bench Mark: 'Q' cut on top of east curb; south end of paved road (Southglen Drive); Elev. = 83.27
2. All construction shall conform to City of Wichita, Kansas Standard Specifications.
3. Location of underground utilities including derby gasoline, as shown, are approximate. Contractor shall contact utility companies and verify the location and depth of all underground utilities.

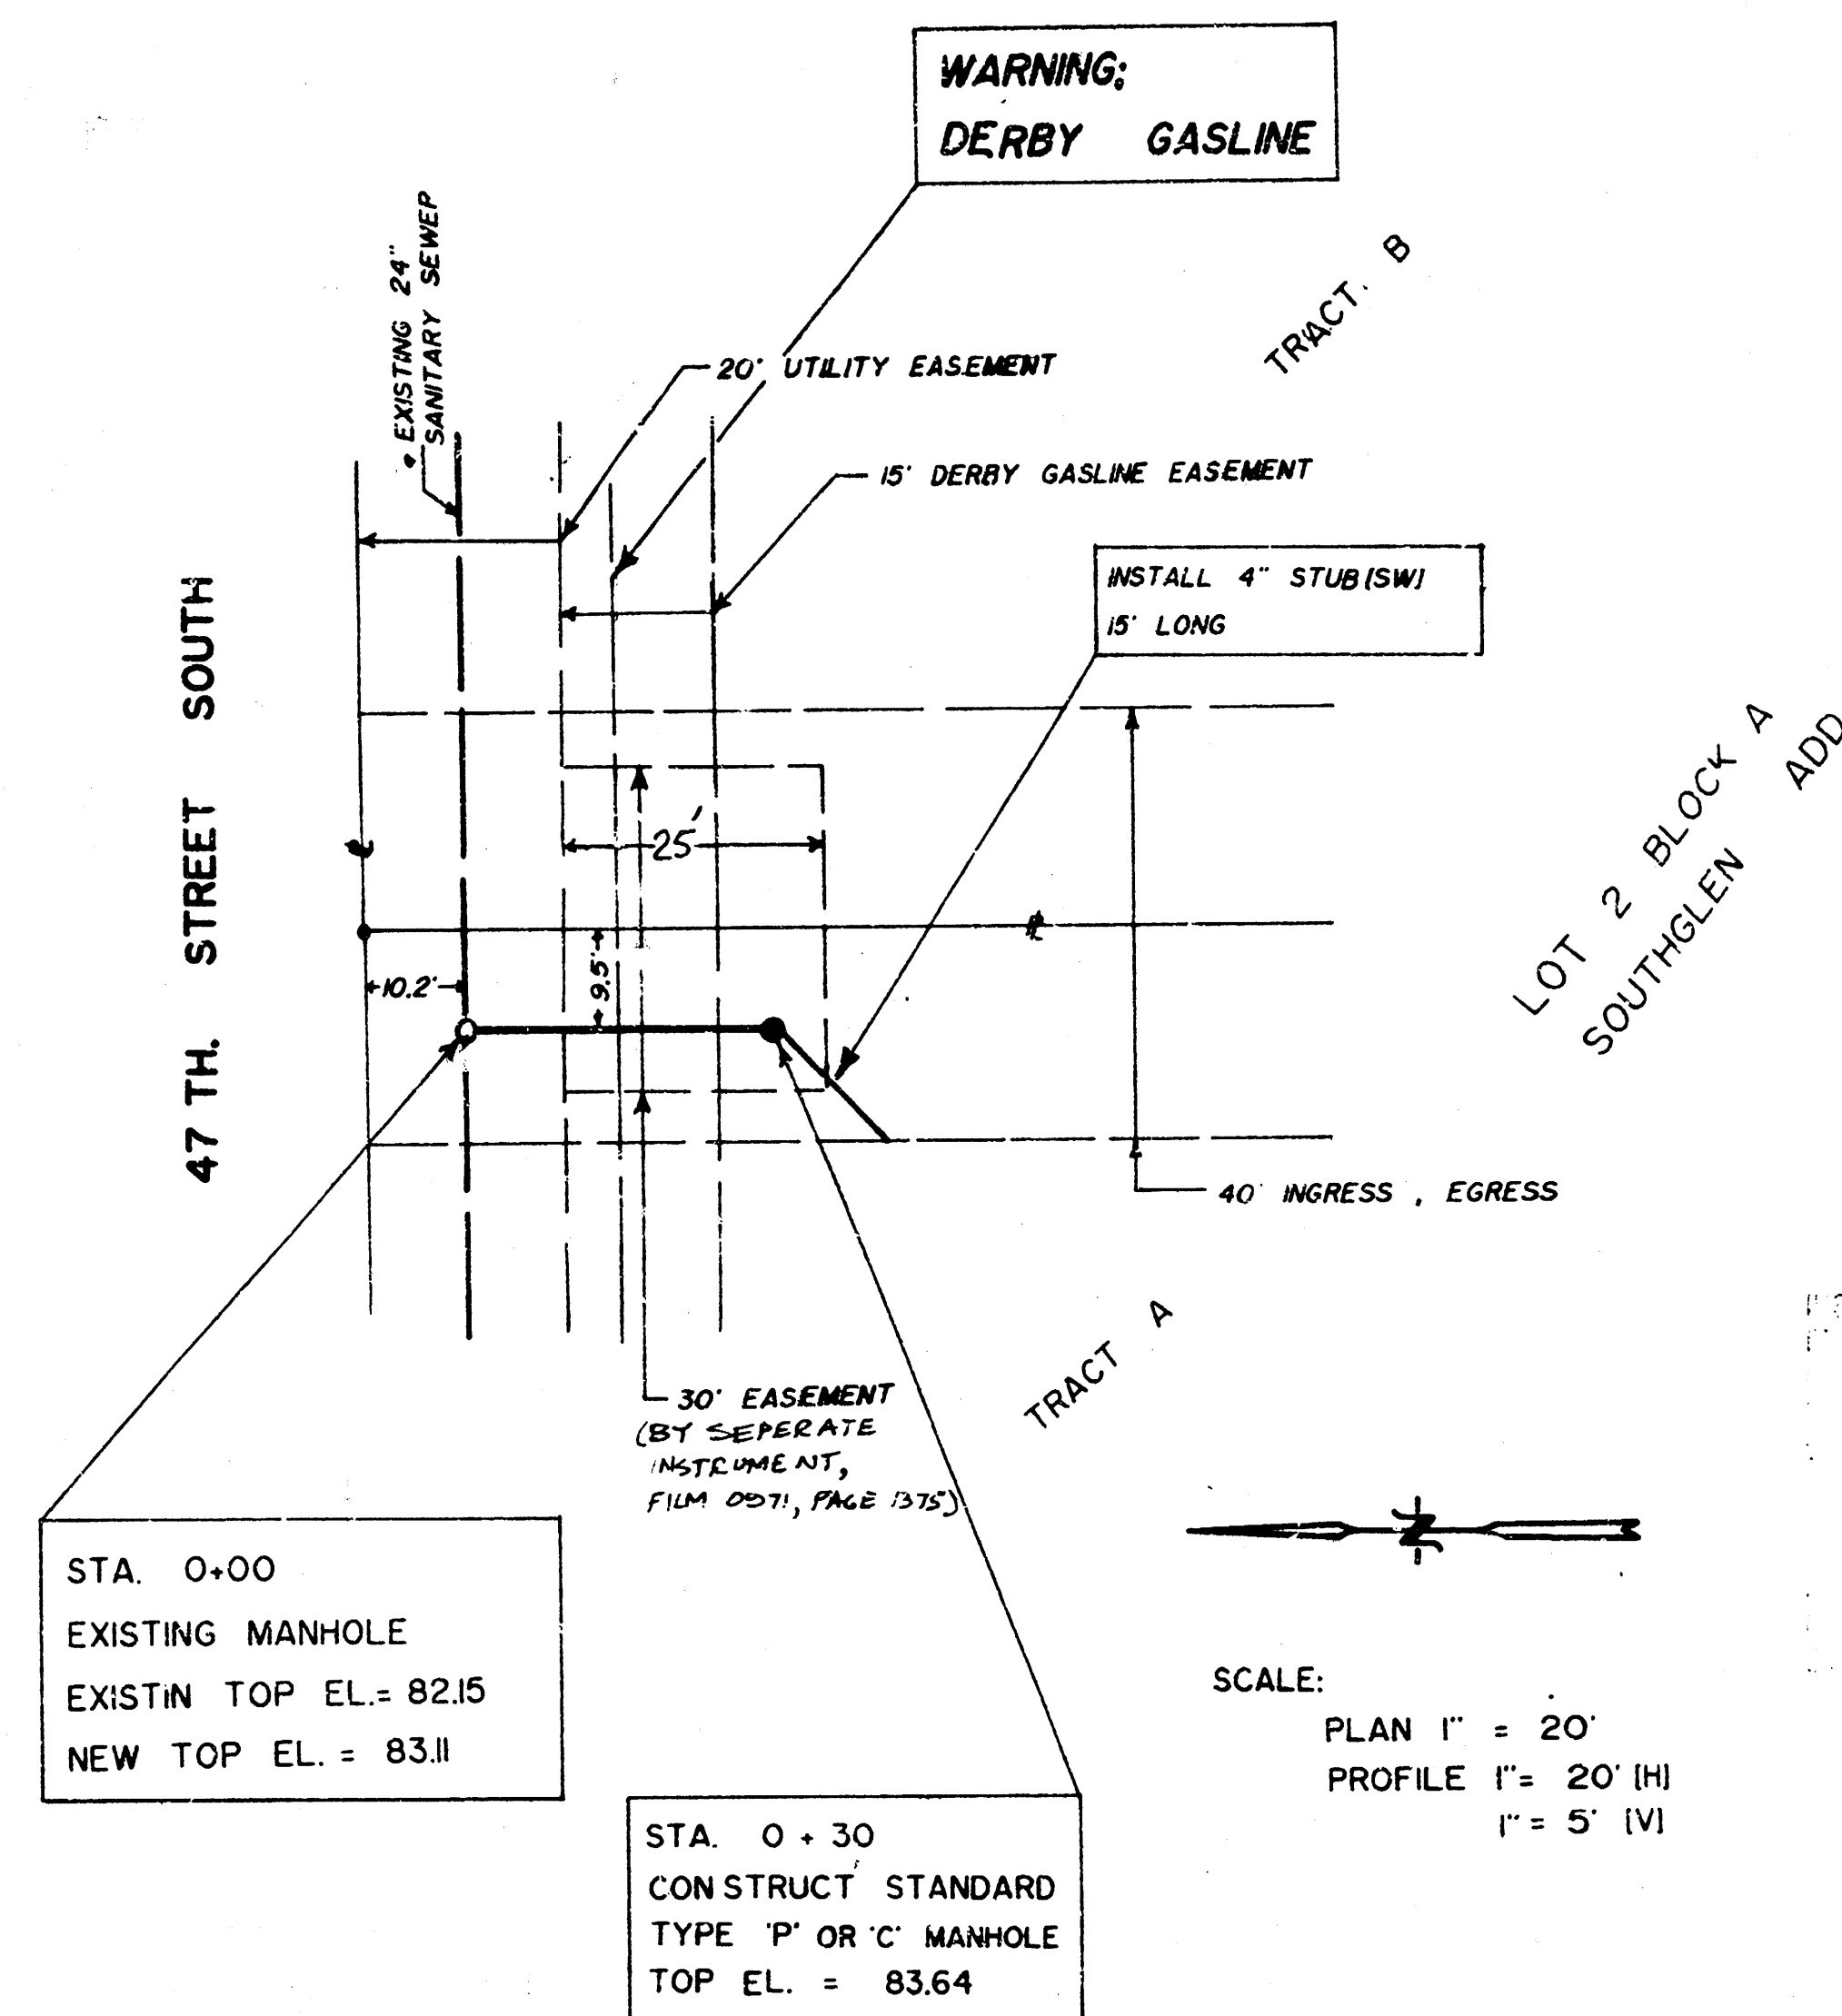


APPROVED AS NOTED
BY CITY ENGINEER OF WICHITA

Seal of the City Engineer of Wichita, Kansas, dated July 25, 1954.

NOTE TO CONTRACTOR

FOR THE CITY OF WICHITA, KANSAS, THE ENGINEER HAS REVIEWED THE PLANS AND SPECIFICATIONS FOR THE SANITARY SEWER EXTENSION TO SERVE TRACT A, LOT 2, BLOCK A, SOUTHGLEN ADDITION, WICHITA, KANSAS. THE ENGINEER'S REVIEW IS LIMITED TO THE TECHNICAL ASPECTS OF THE PLANS AND SPECIFICATIONS AND DOES NOT CONSTITUTE A GUARANTEE OF THE ACCURACY OF THE INFORMATION PROVIDED BY THE OWNER OR THE DESIGNER.

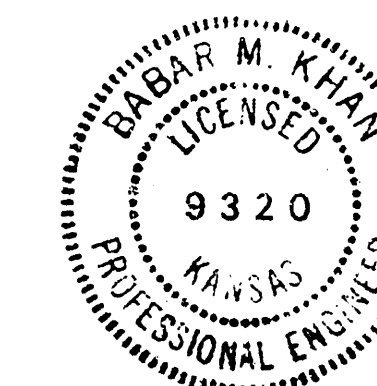

BOOKED

PROFILE	DATE	BY
	SURVEYED: _____ PLANNED: _____ NOTE BOOK: _____ NO. _____	

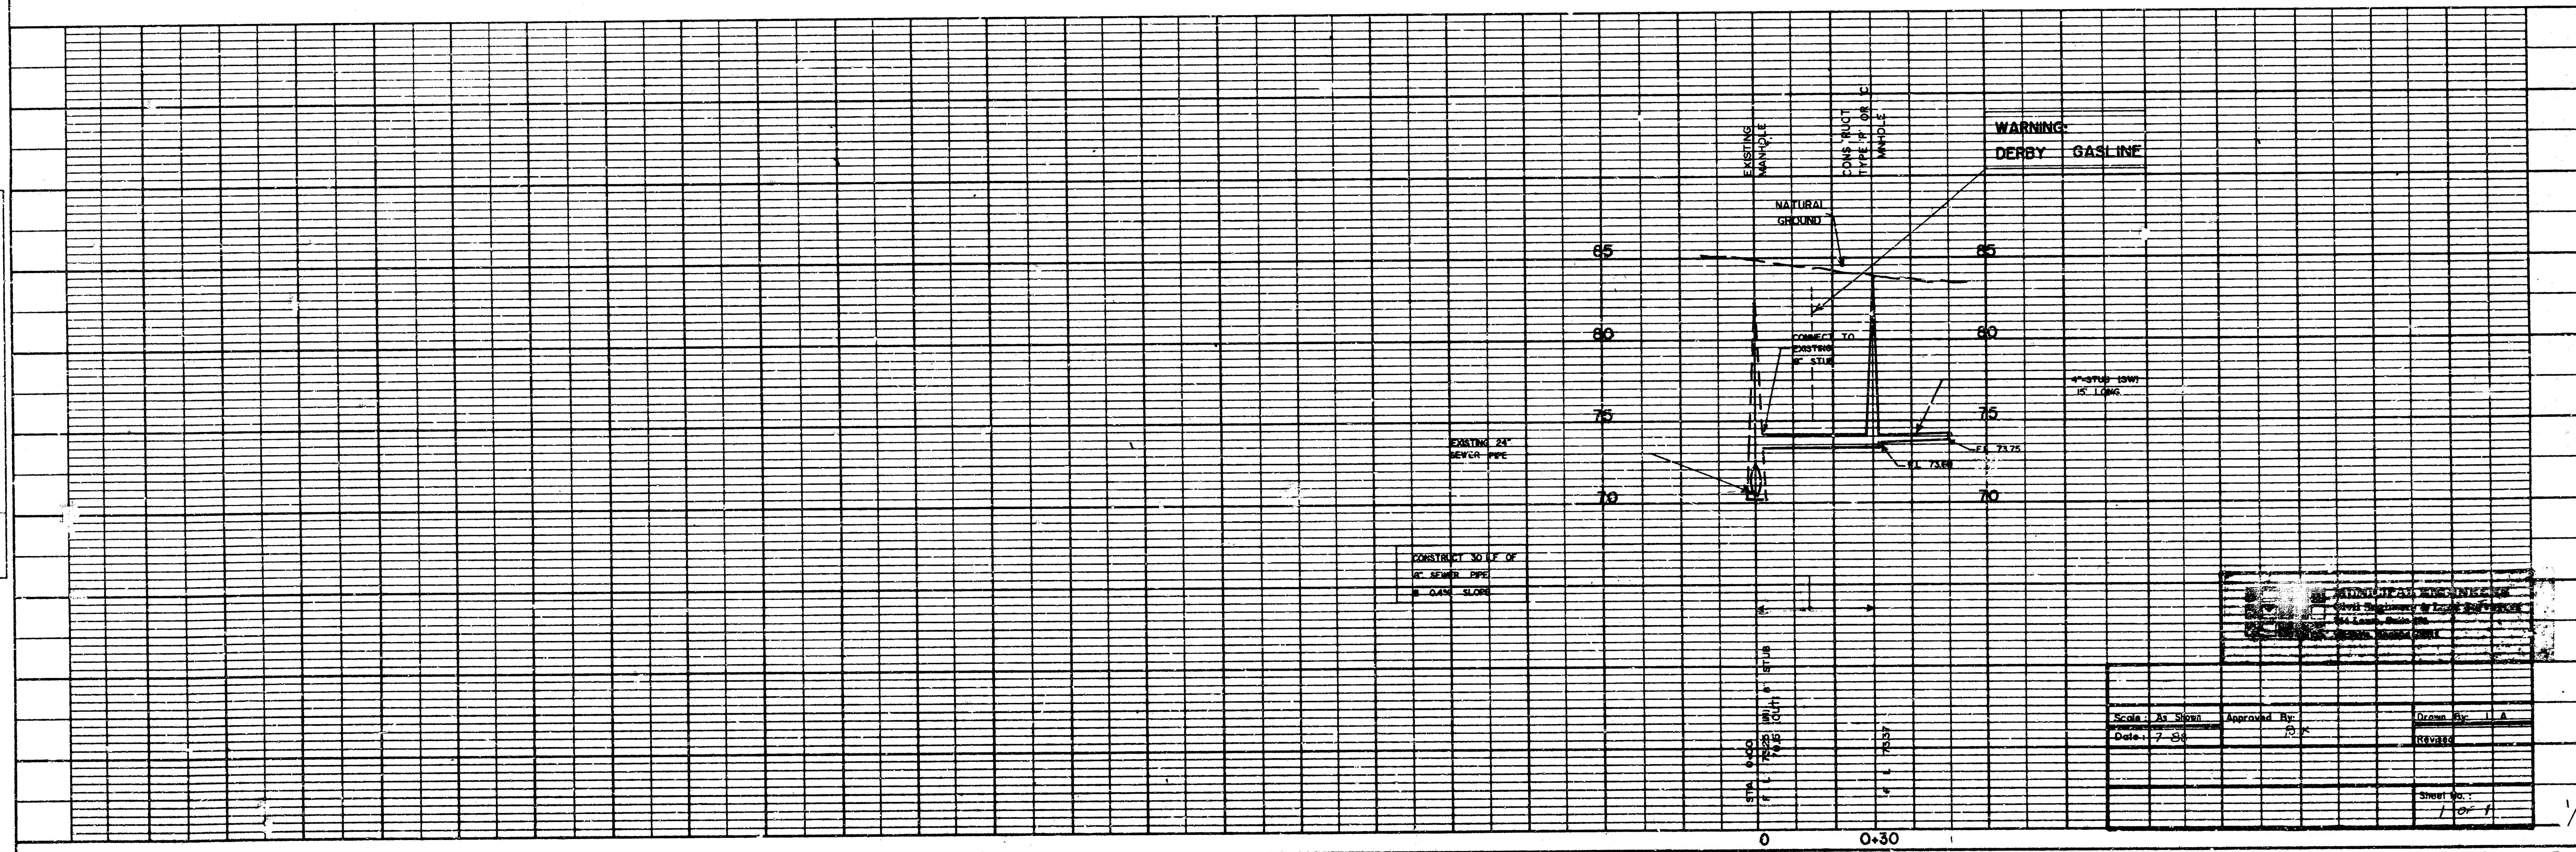



PLATE 1 - PLAN - PROFILE - F.A.S.
CLEARPRINT PAPER CO., S.F. CAL.
NO. 1000-1

10 10 3 14

FILMED FROM THE BEST AVAILABLE COPY....

PLAN	DATE	BY
	DESIGNED	CHECKED
	NOTE BOOK	ALIGNMENT CHECKED
	NO.	RT. OF WAY CHECKED


PROFILE	DATE	BY
	DESIGNED	CHECKED
	NOTE BOOK	GRADES CHECKED
	NO.	STRUCTURE NOTATIONS CHD.

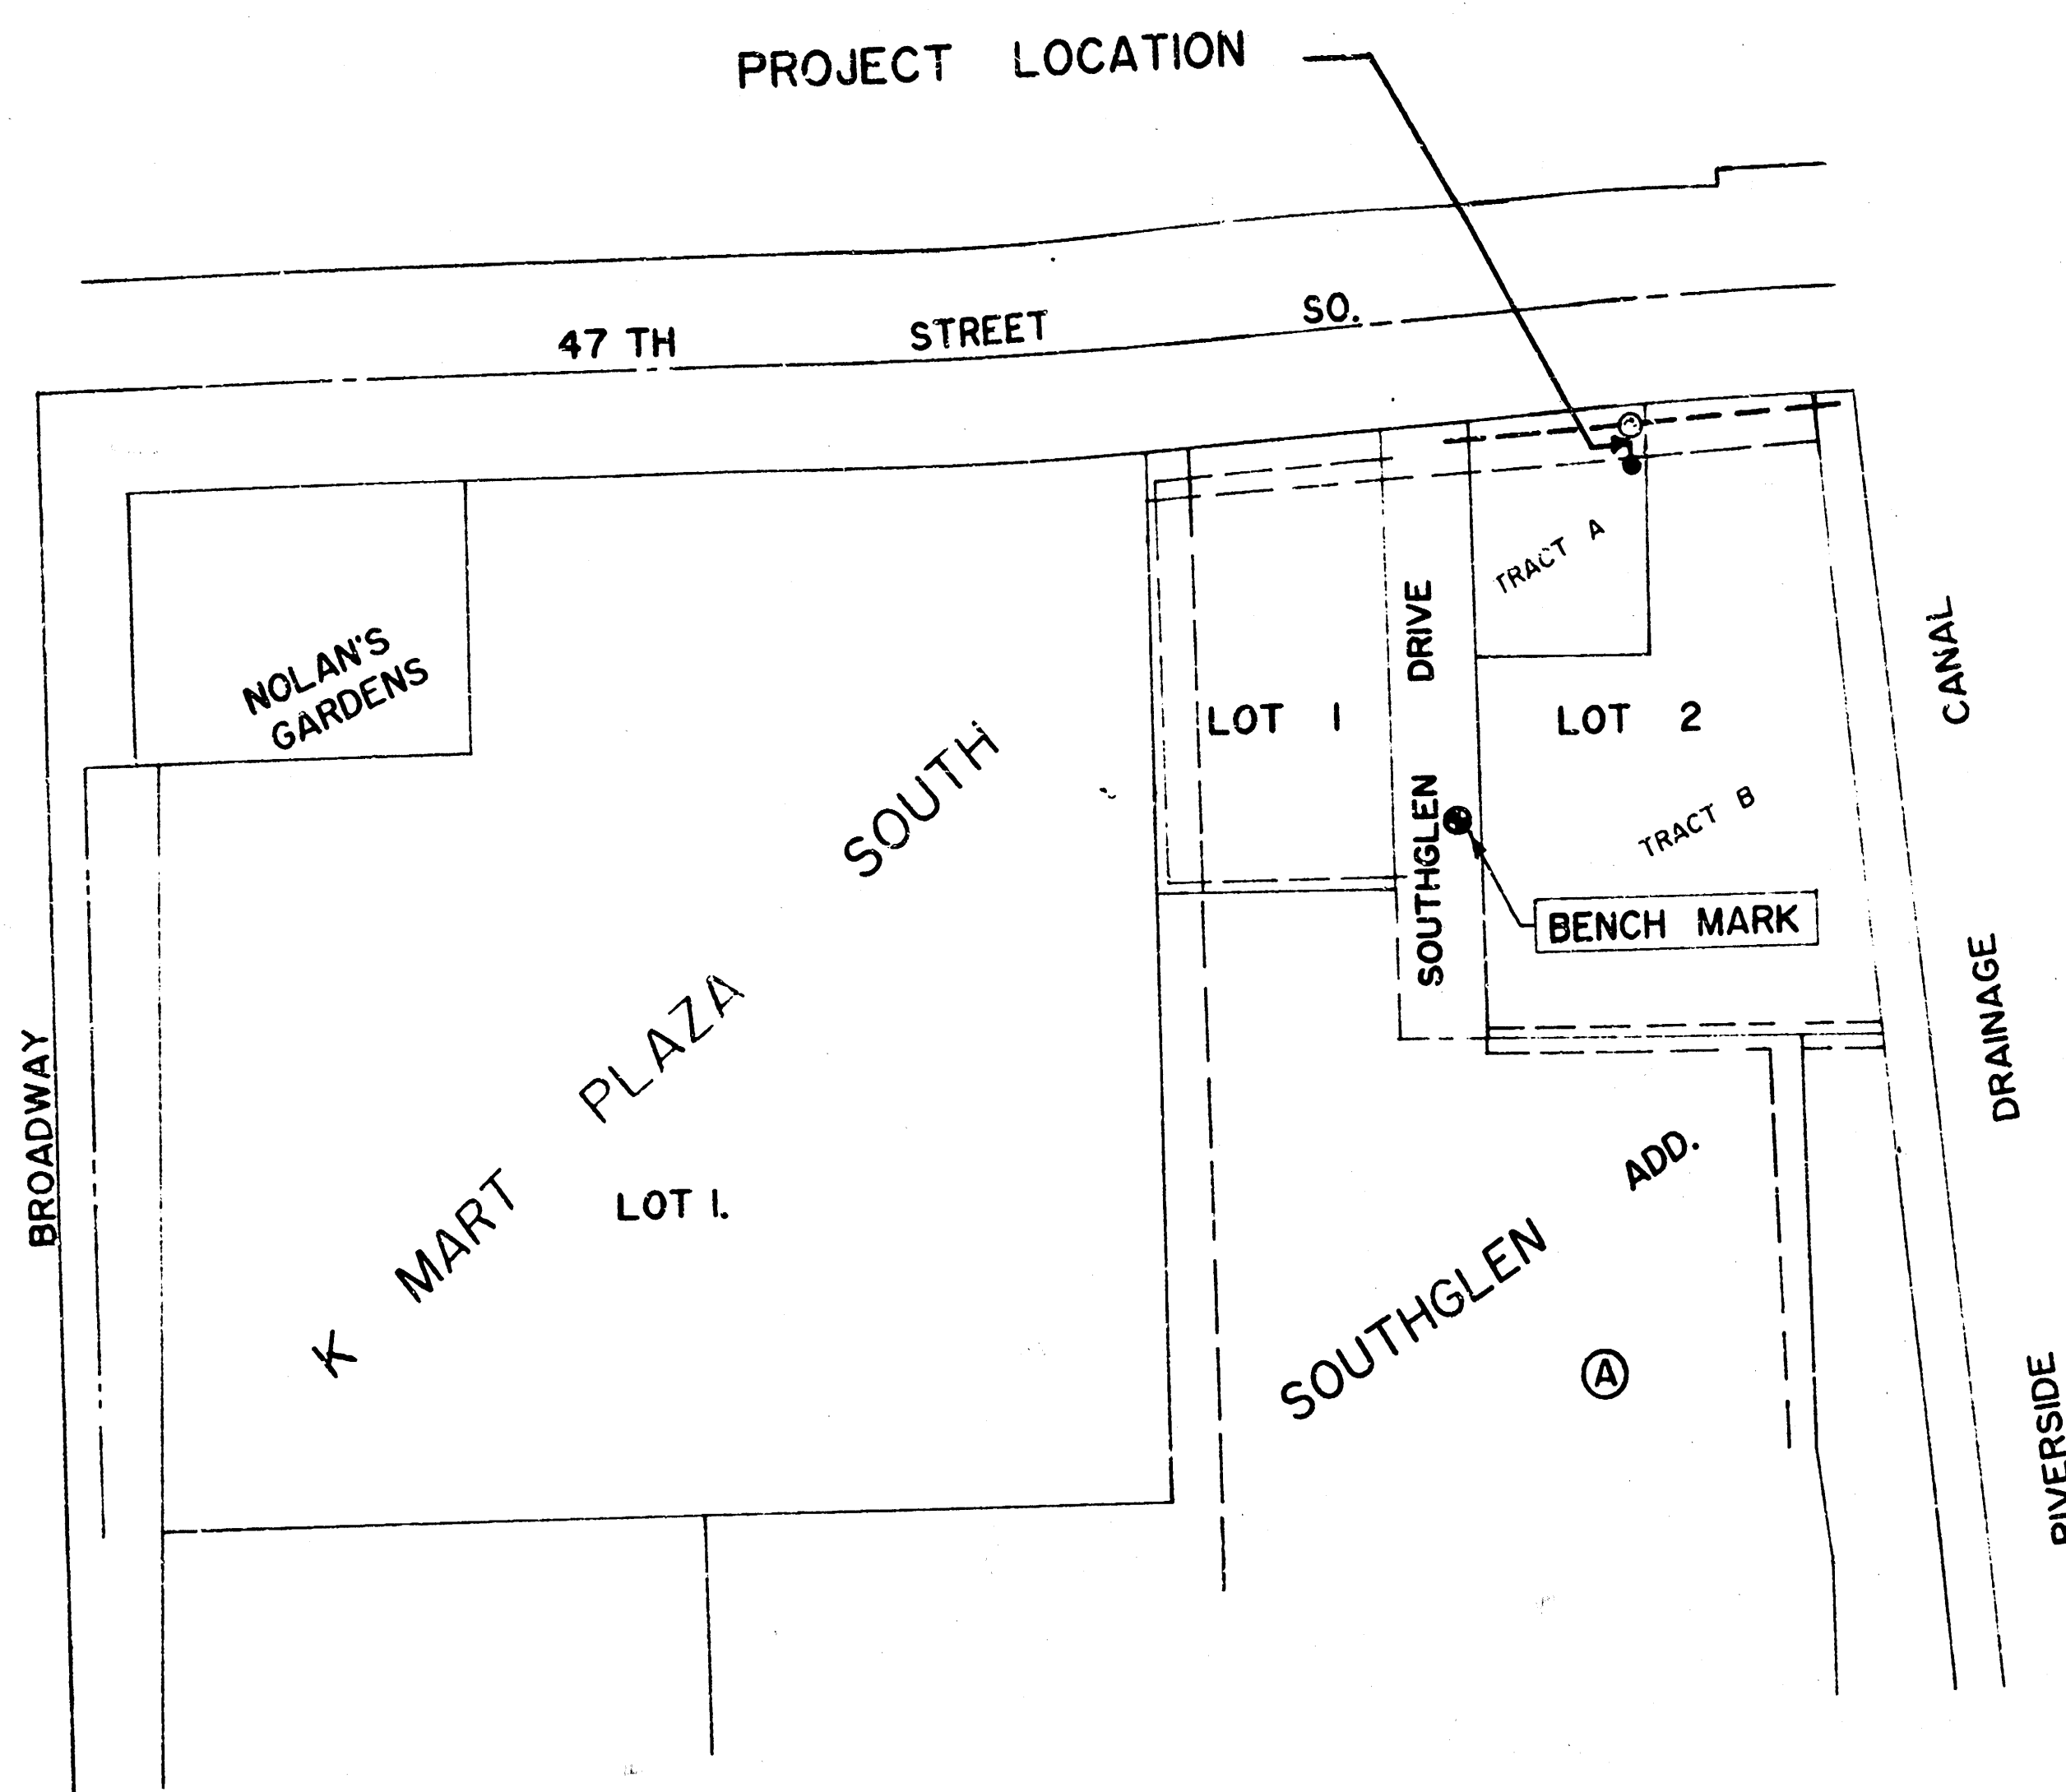



LOCATION MAP

SANITARY SEWER EXTENSION
TO SERVE
TRACT A, LOT 2, BLOCK A,
SOUTHGLEN ADDITION
WICHITA, KANSAS

PROECT NO.: 468 - 76 - 245 - 80001 - 000 - 000 - 173

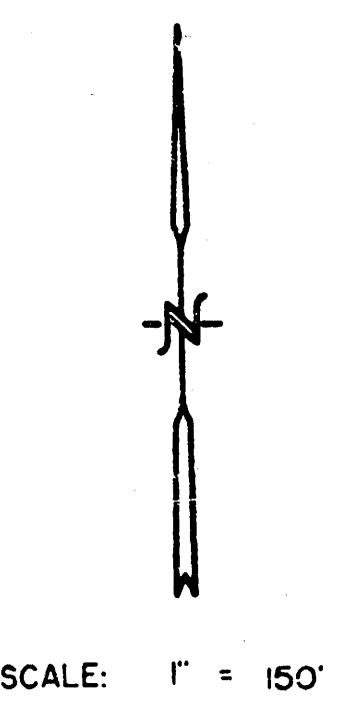

- GENERAL NOTES:
1. Bench Mark: 'u' cut on top of east curb; south end of paved road (Southglen Drive); Elev. = 83.27
 2. All construction shall conform to City of Wichita, Kansas Standard Specifications.
 3. Location of underground utilities including derby gasline, as shown, are approximate. Contractor shall contact utility companies and verify the location and depth of all underground utilities.

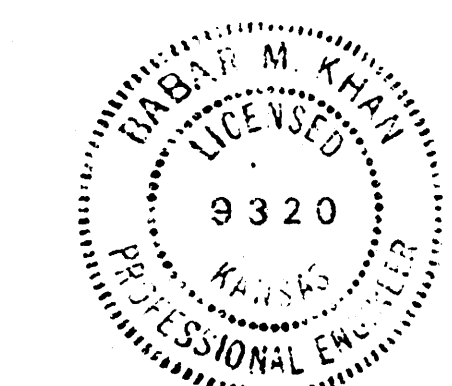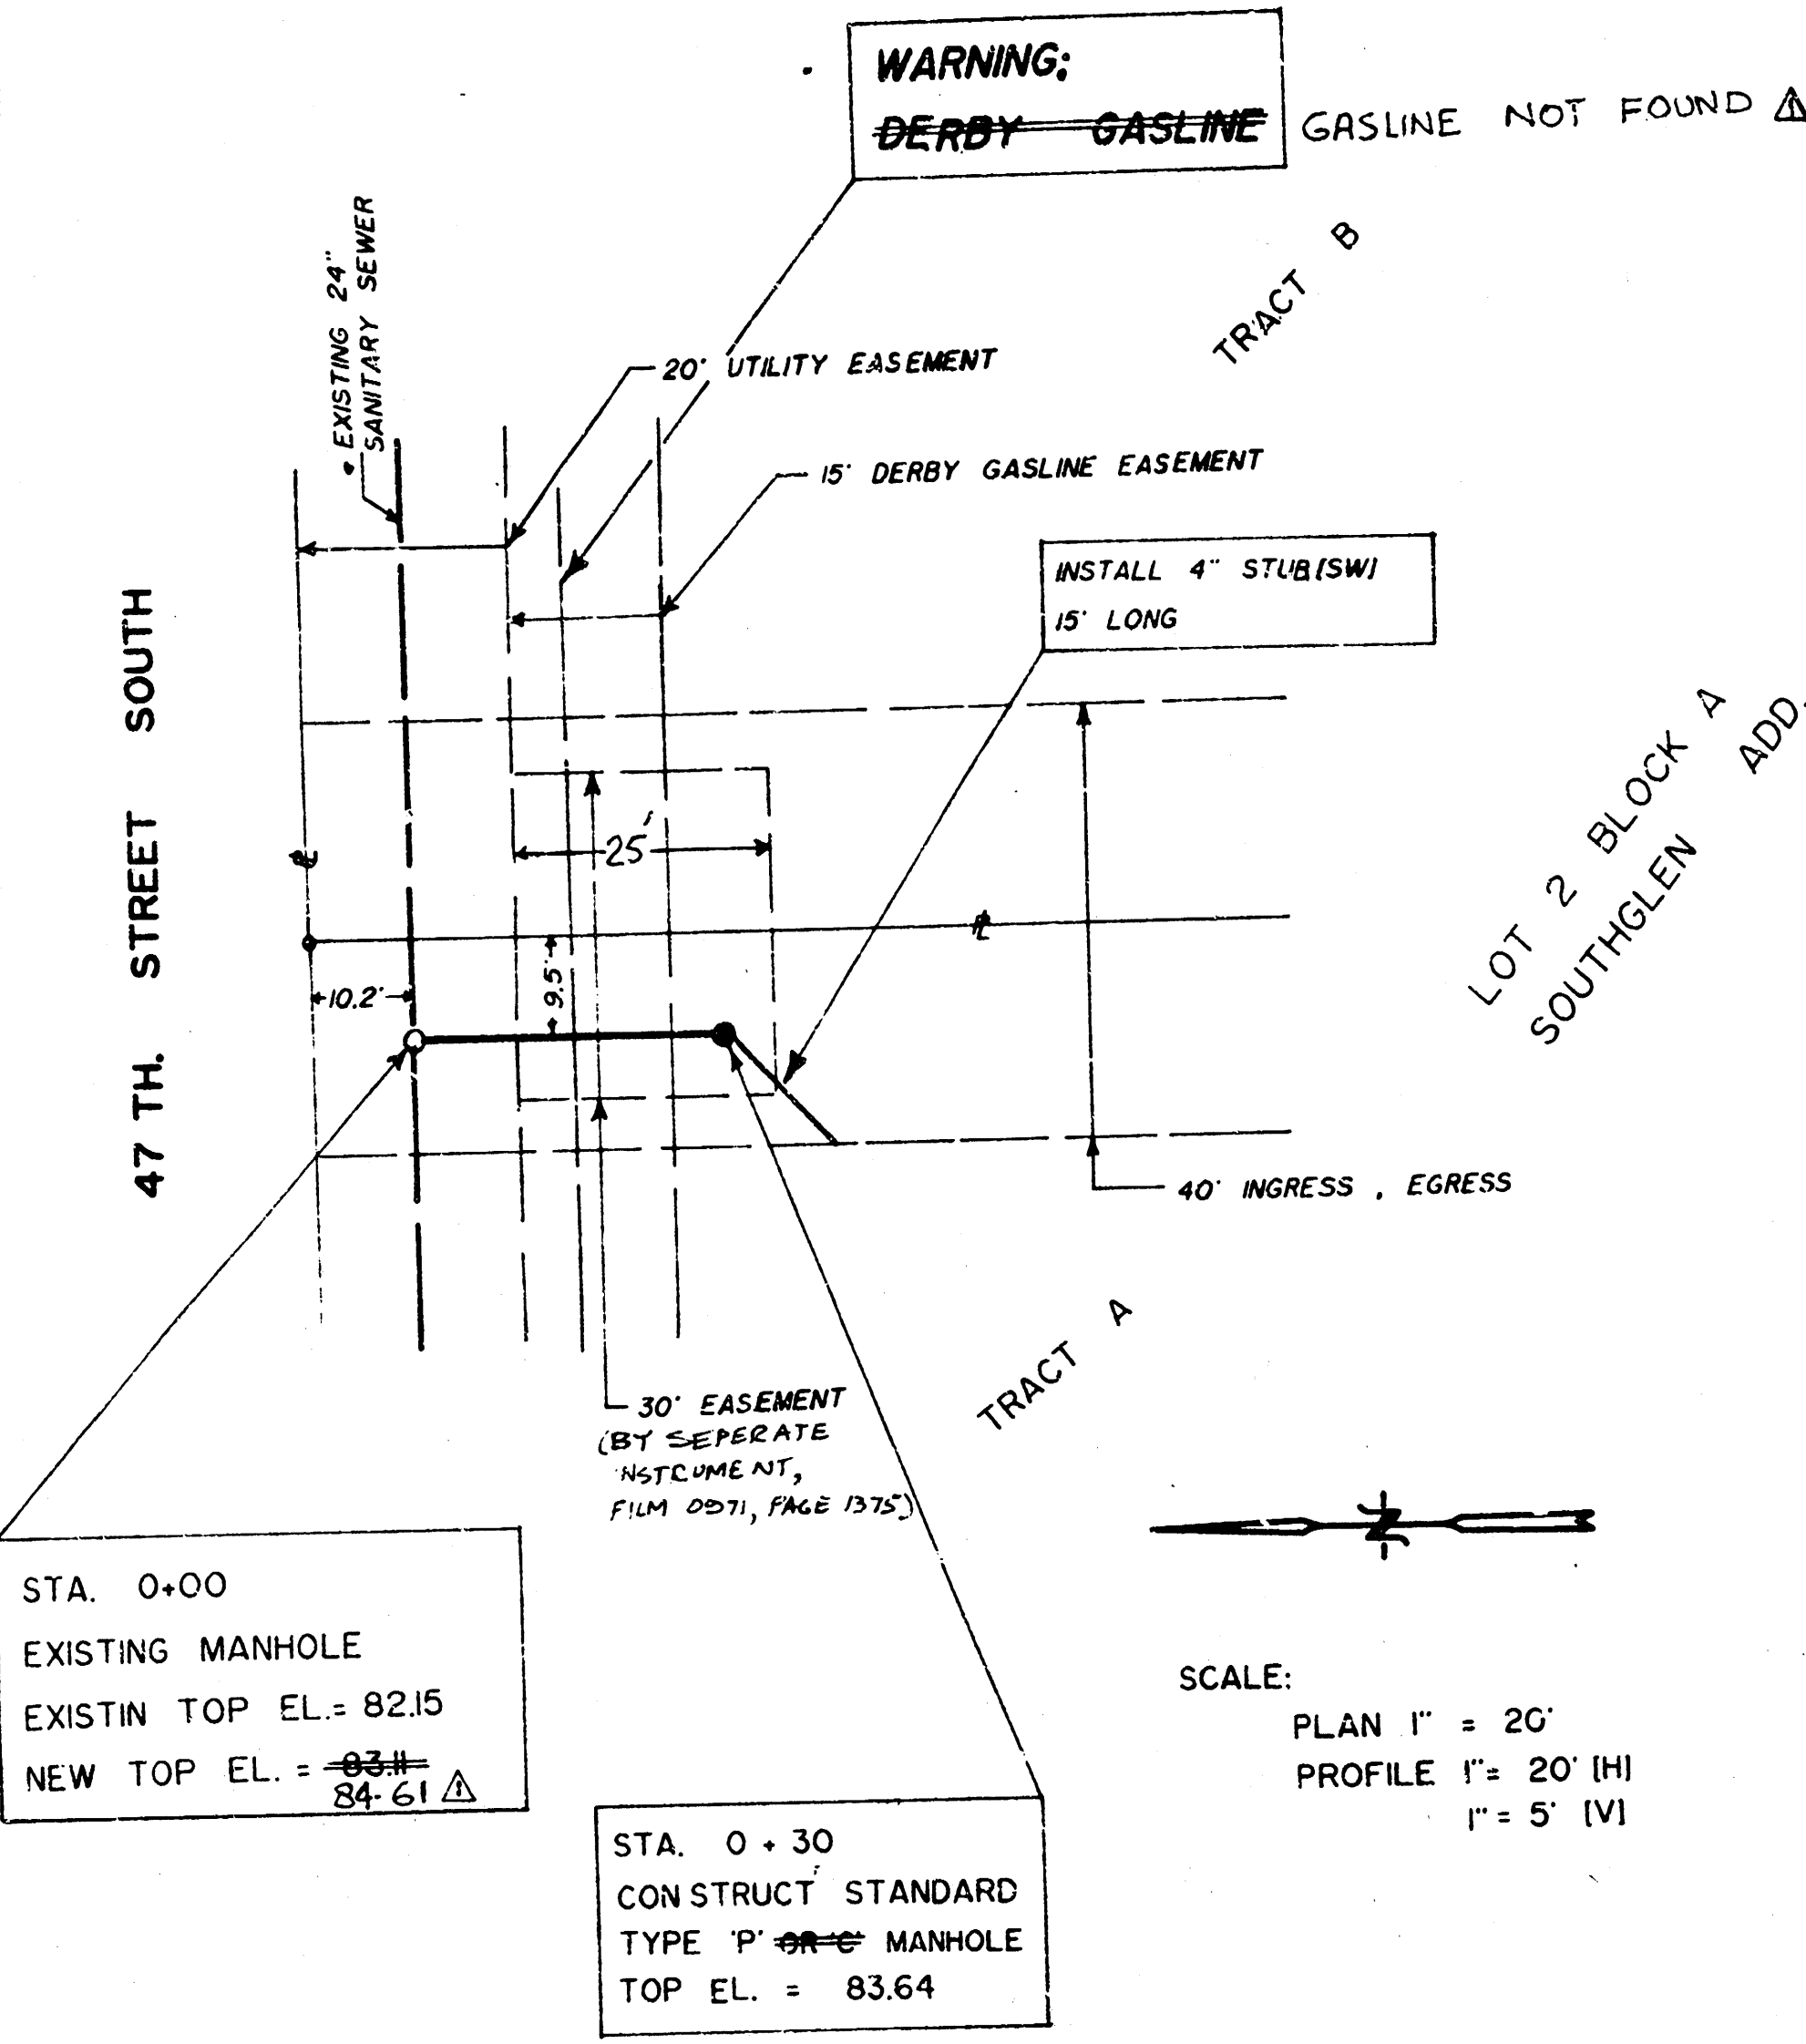

Δ AS-BUILT

