




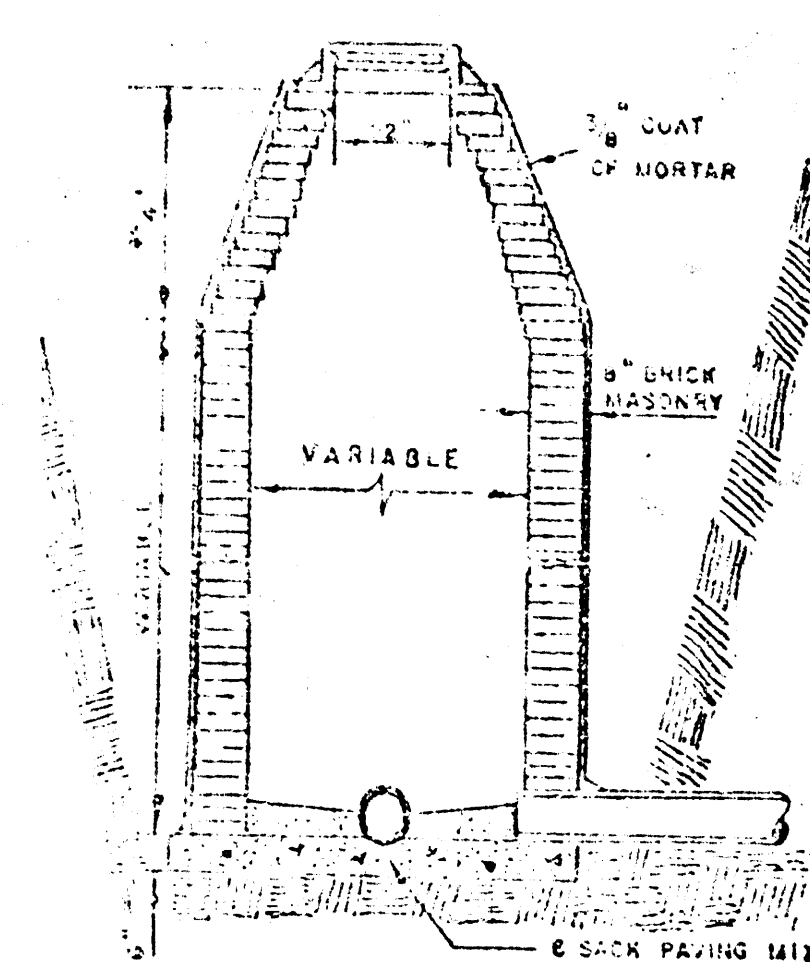


STANDARD MANHOLE
TYPE "A"
* 6" ON 5" DIA. M.H.

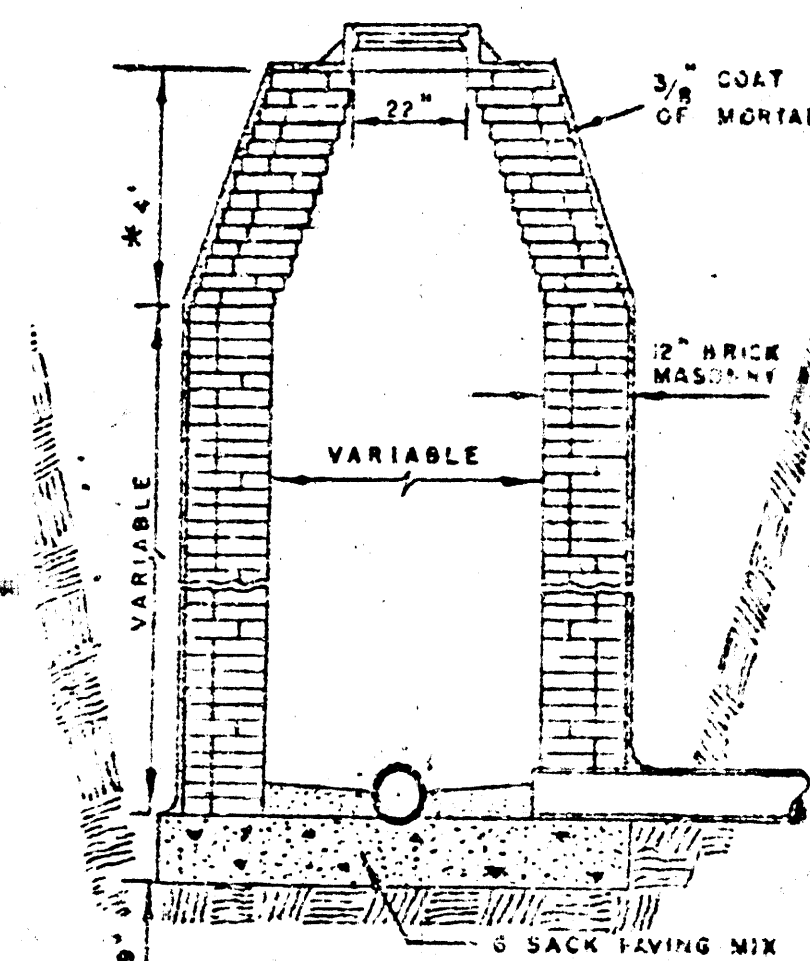

STANDARD MANHOLE
TYPE "B"

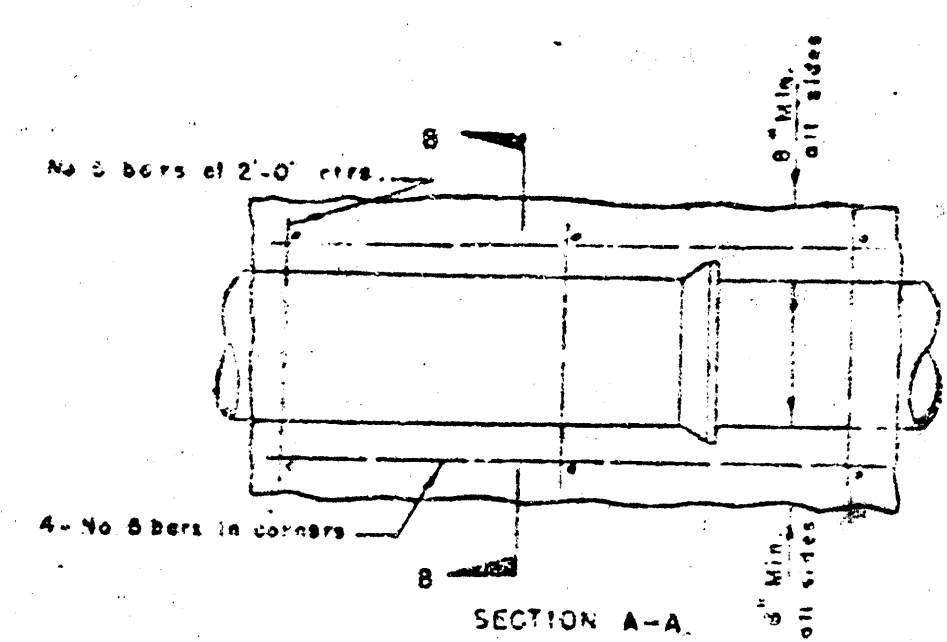


SECTION A-A

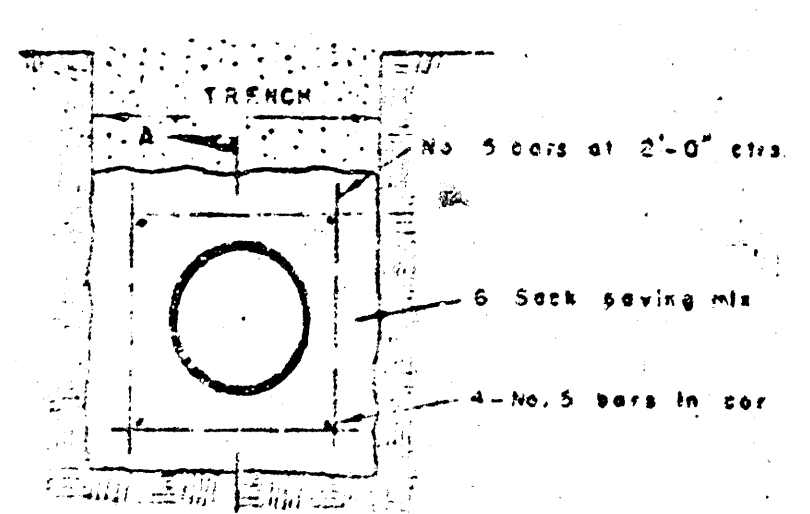

SECTION B-B

REINFORCED CONCRETE ENCASEMENT

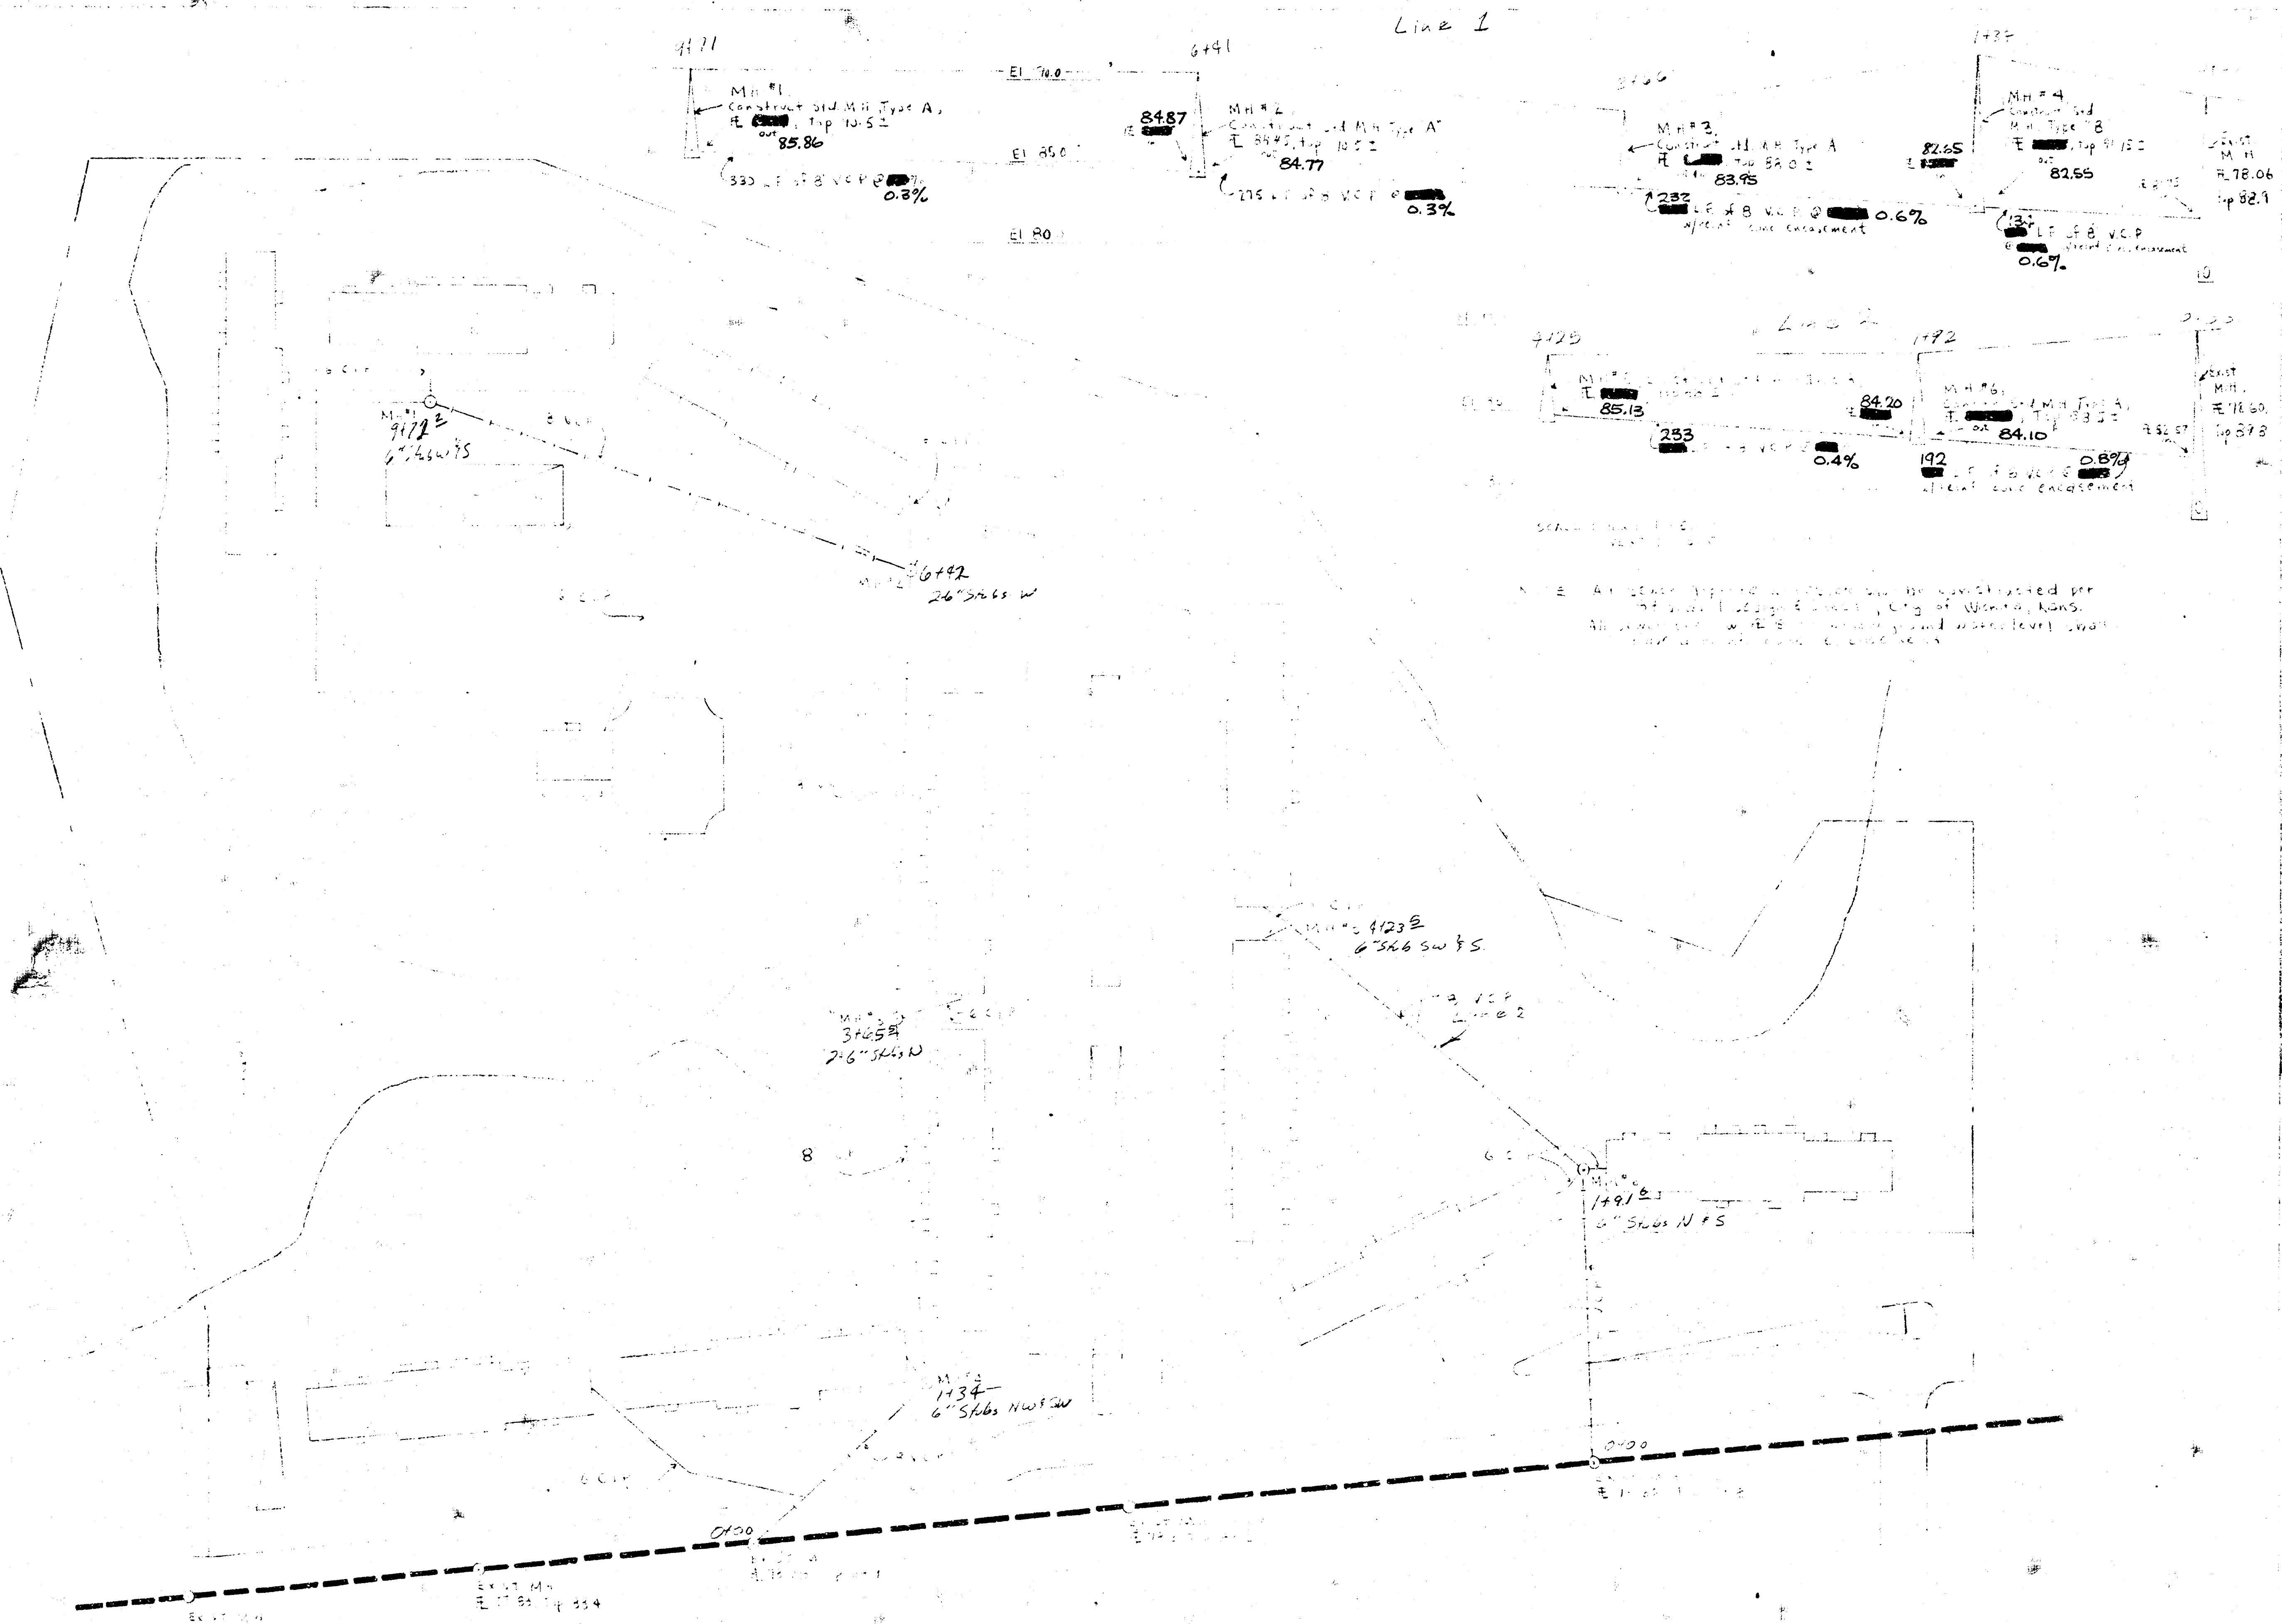

As Built

UTILITY PLAN

Final Map 31 55 JK #4
SOUTHLAKE VILLAGE
BHEB50355
DICK BRABHAM ARCH. IS
12/2/73