

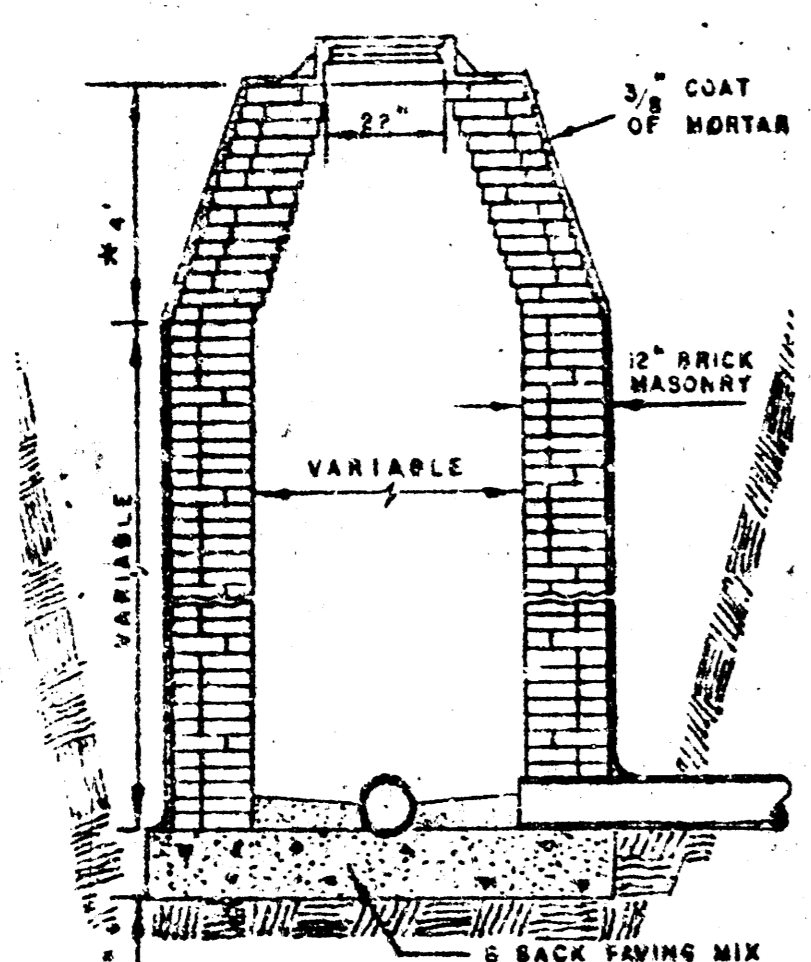




STANDARD MANHOLE TYPE "A"
R.C.P. ON 6" DIA. M.H.

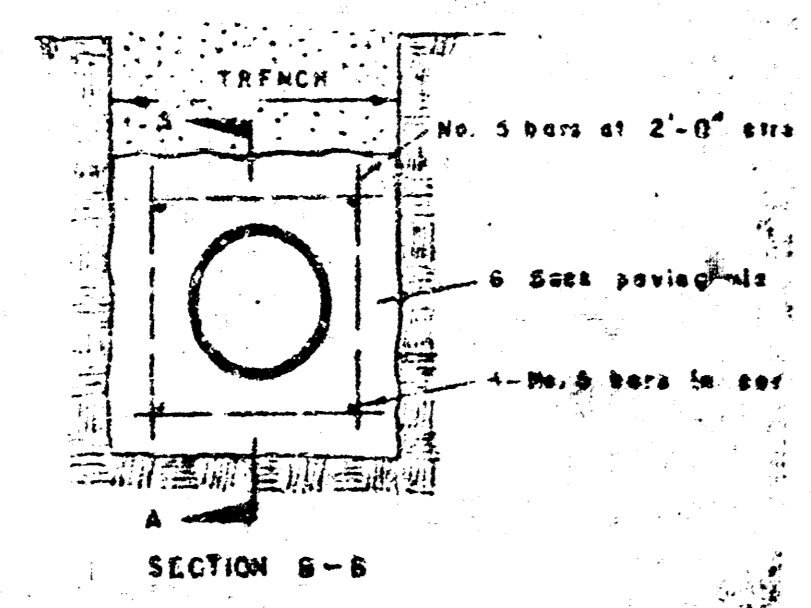

STANDARD MANHOLE TYPE "B"

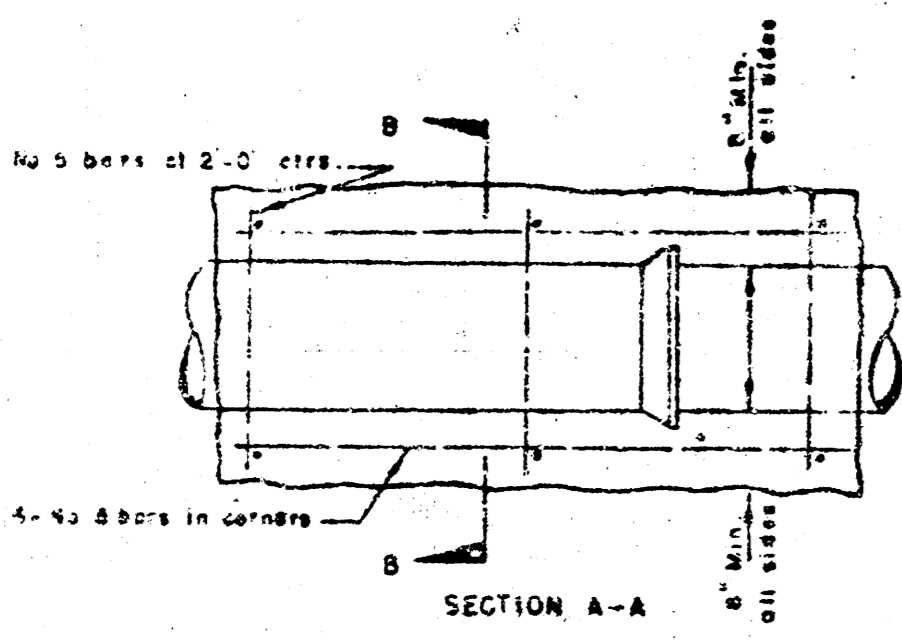

REINFORCED CONCRETE ENCASEMENT

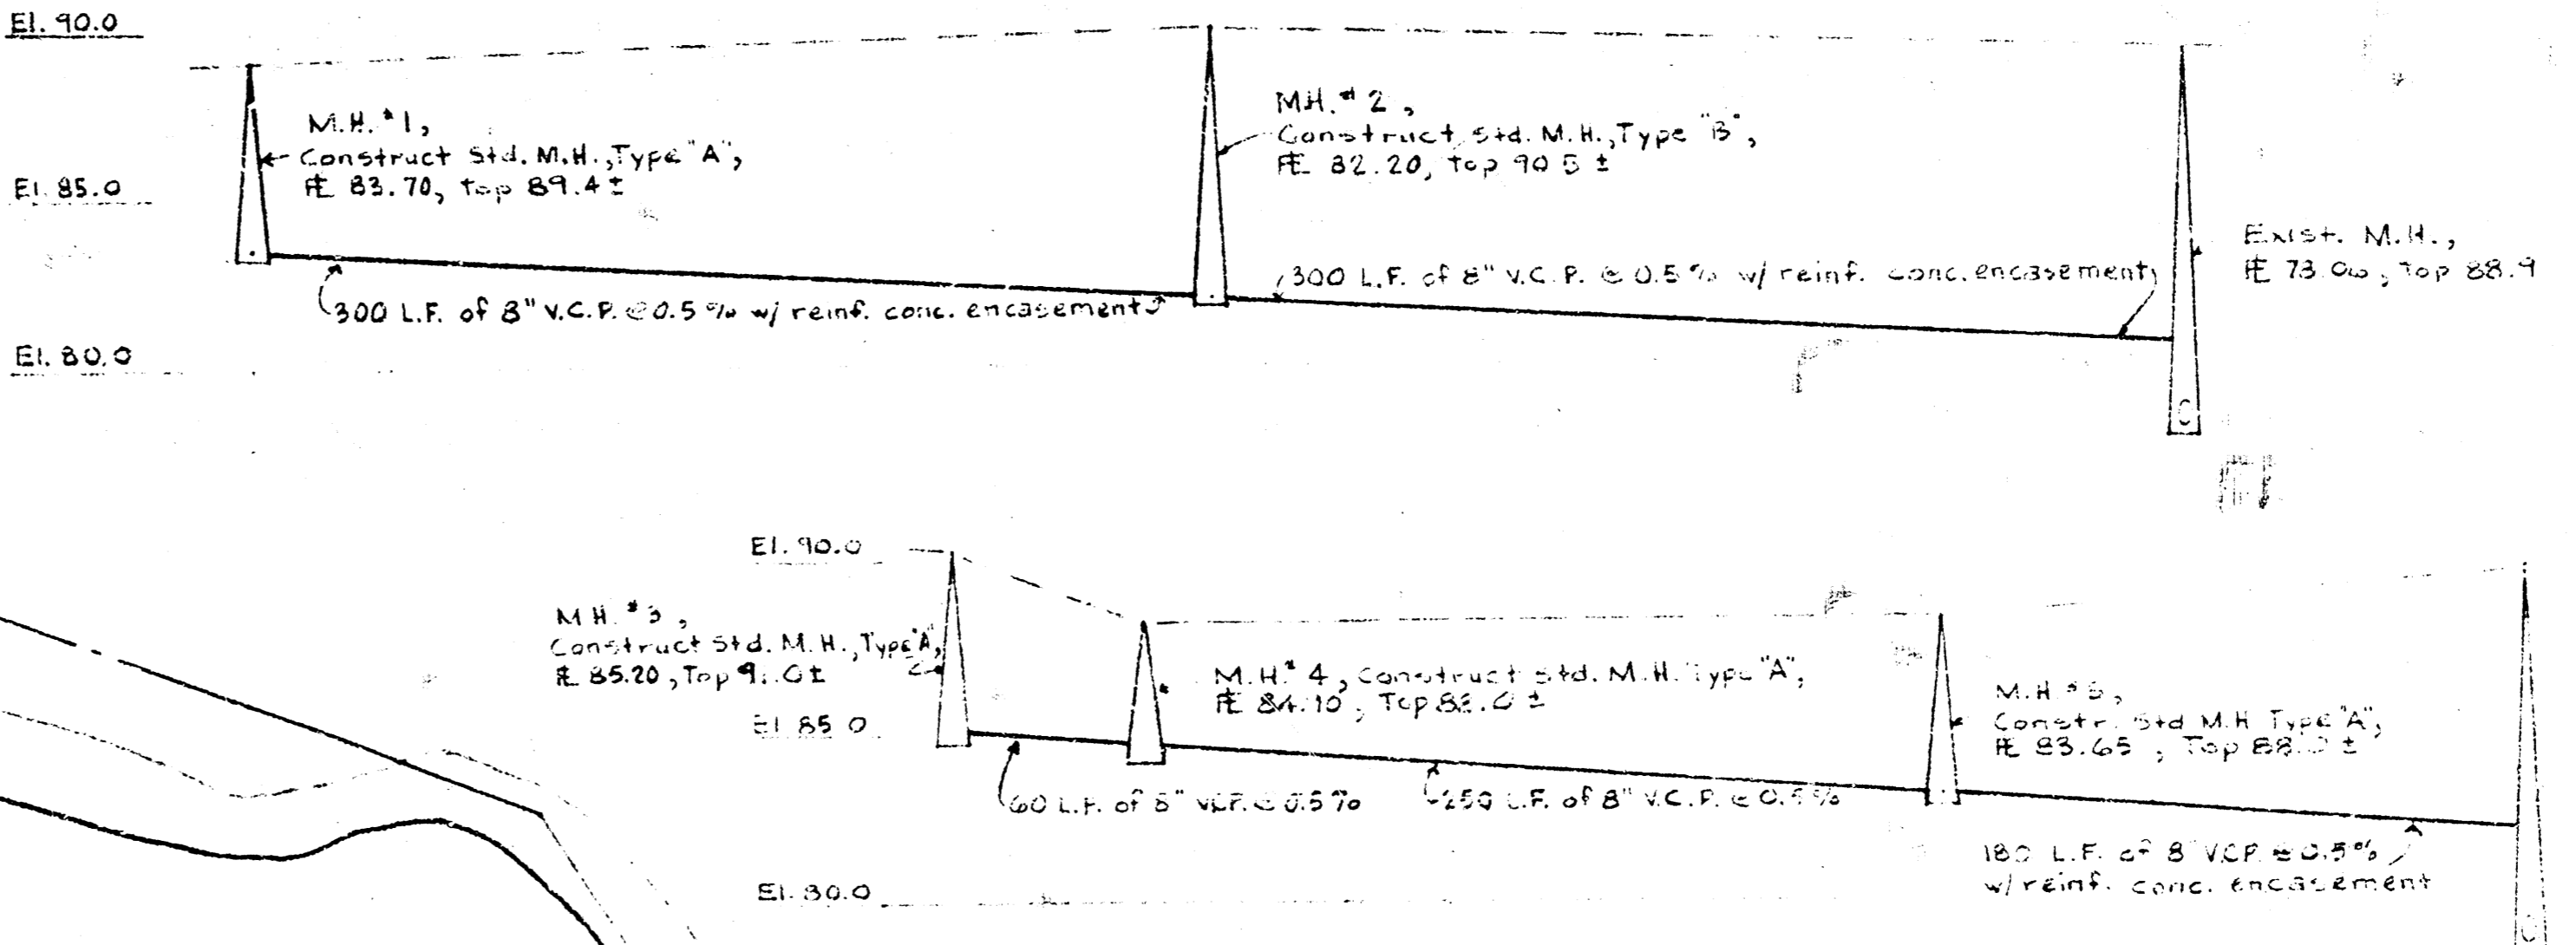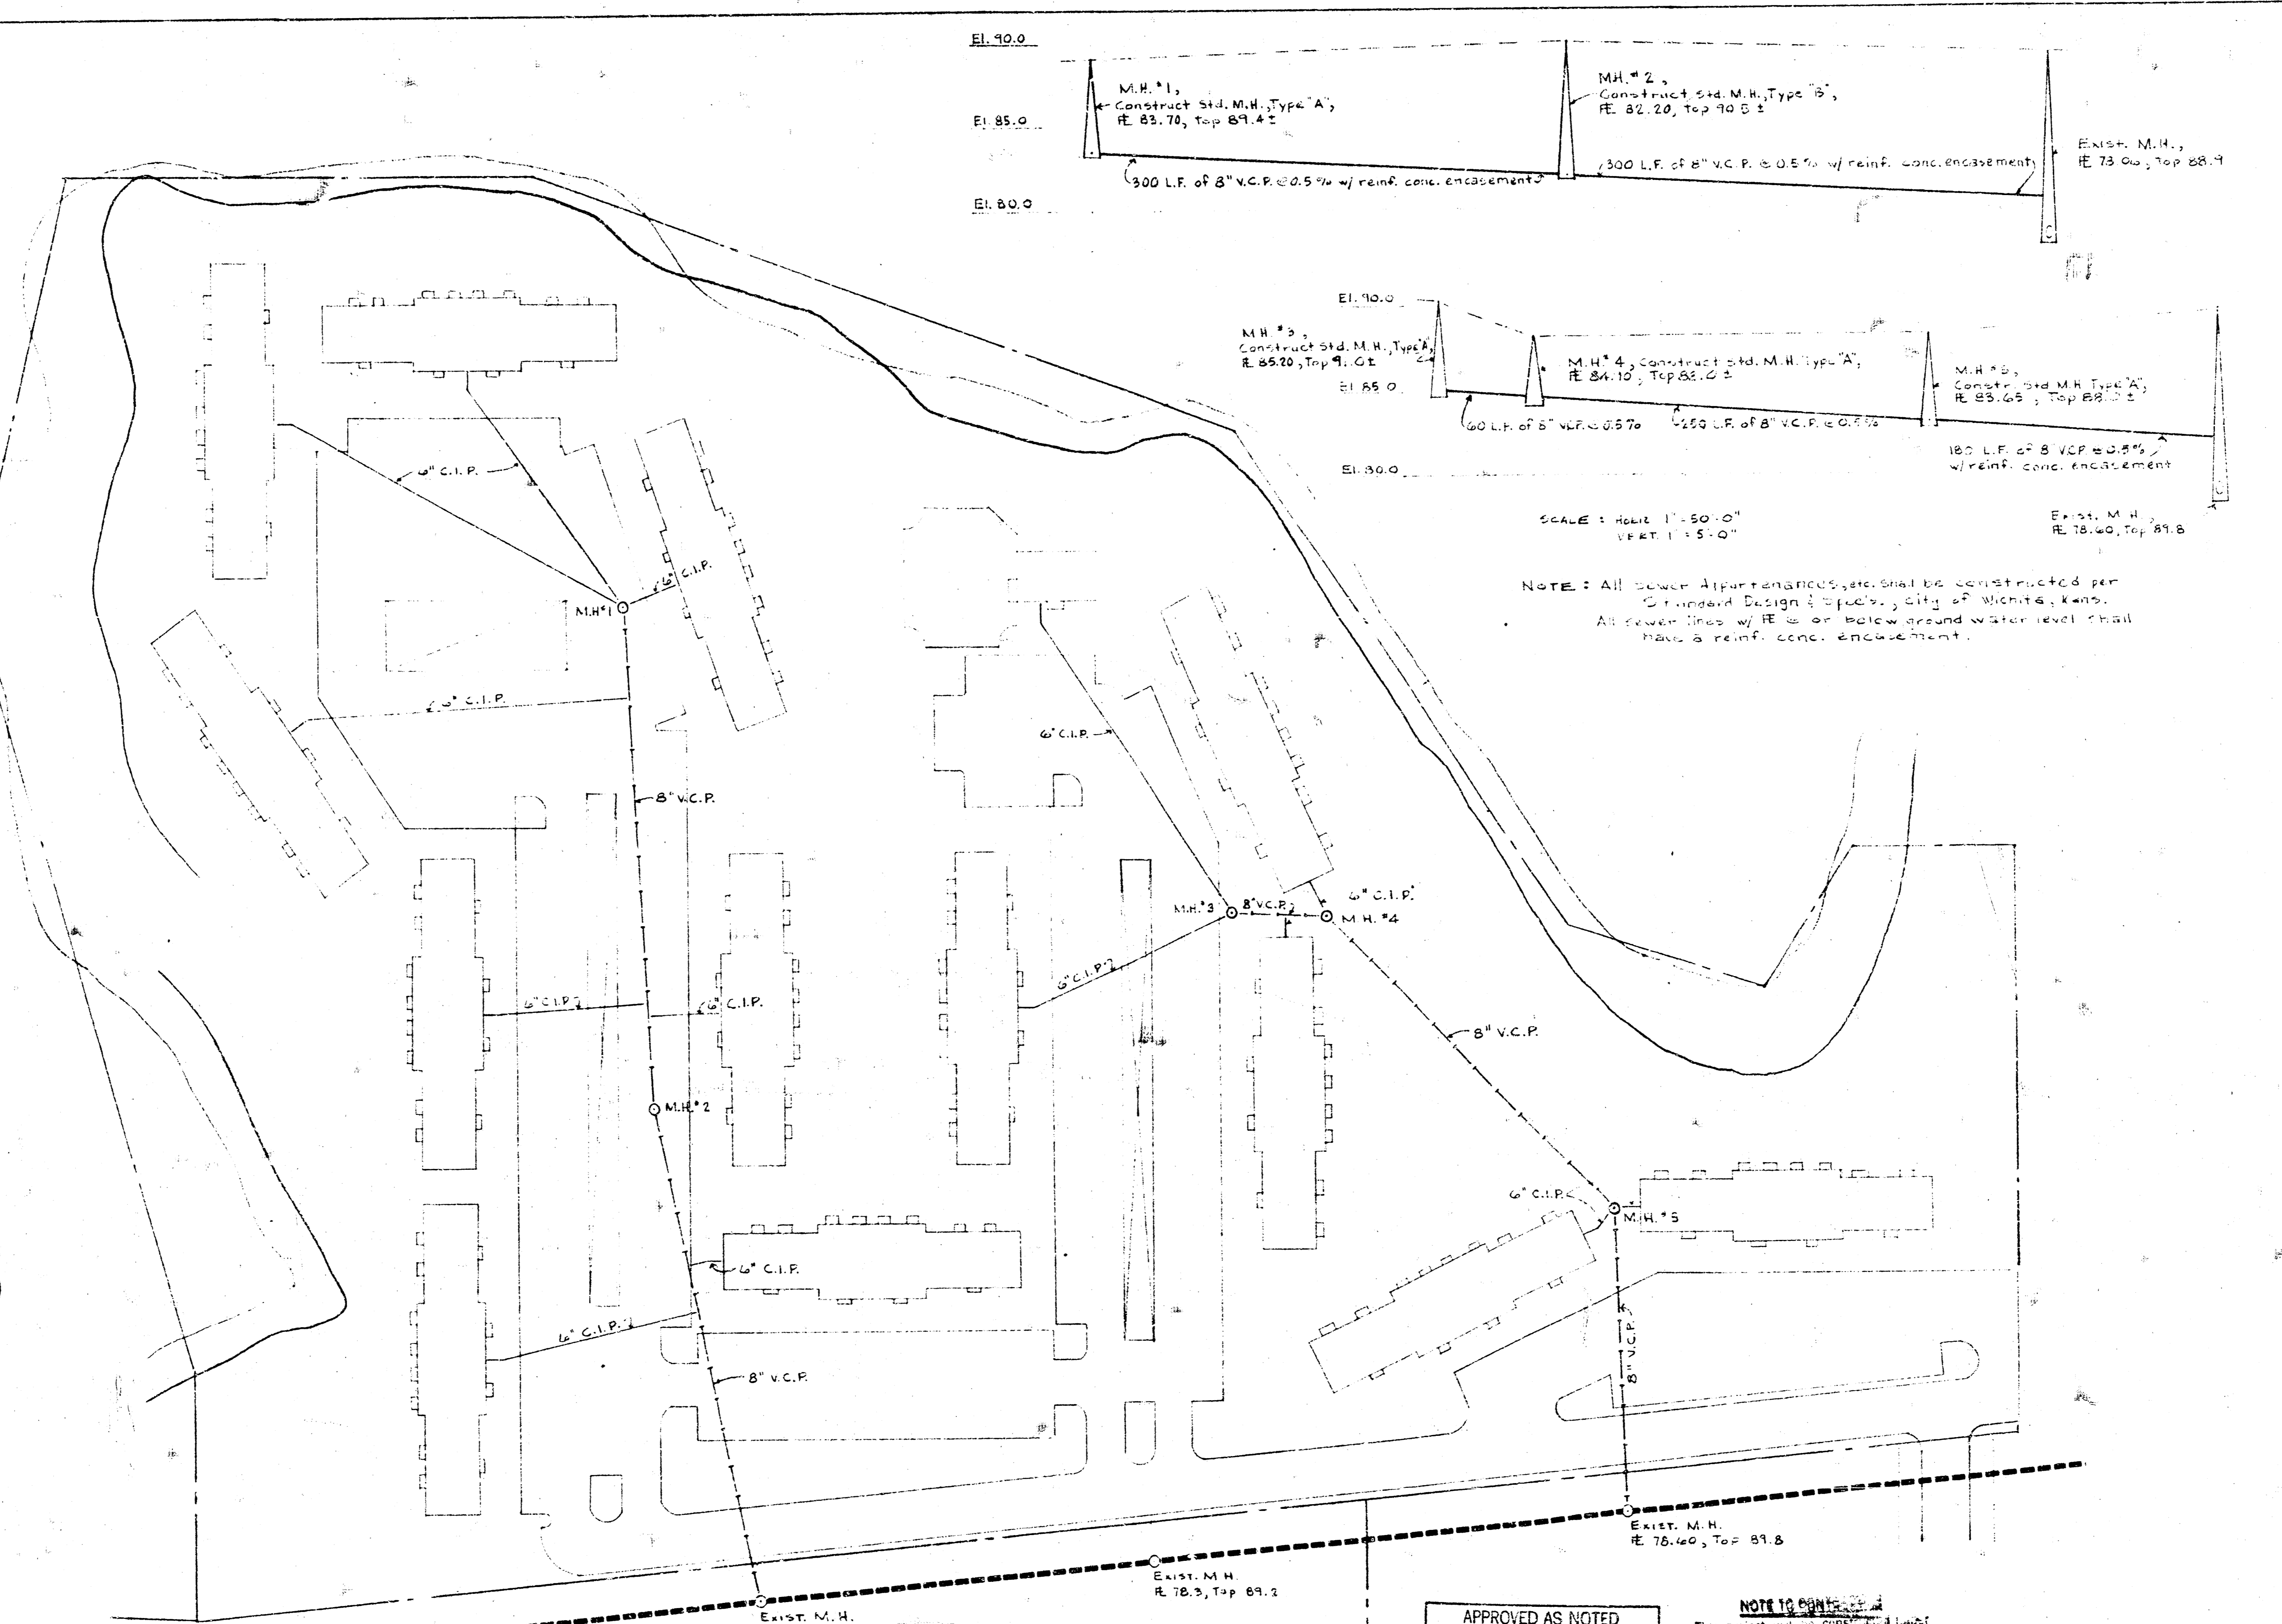

SCALE: HORIZ. 1" = 50'-0"
VERT. 1" = 5'-0"

NOTE: All power Appurtenances, etc. shall be constructed per Standard Design & Specs., City of Wichita, Kans.
All power lines w/ 12" or below ground water level shall have 6" reinf. conc. encasement.

NOTE: NEW M.H. SHALL BE CONSTRUCTED A MIN. OF 2' FROM E.O. OF DRAINAGE VALES

UTILITY PLAN
SCALE: 1" = 50'-0"

APPROVED AS NOTED
By CITY ENGINEER OF WICHITA
Sanitary Sewers _____
Storm Sewers _____
Driveway Approaches _____

NOTE TO CONTRACTOR
This project will be constructed under the supervision of the CITY ENGINEER and conforming to the SPECIFICATIONS of the CITY OF WICHITA. The CONTRACTOR will reimburse the City of Wichita for all cost of Engineering, Surveying, and Inspection.

SOUTHLAKE VILLAGE

DICK BRABHAM - ARCH. 15