



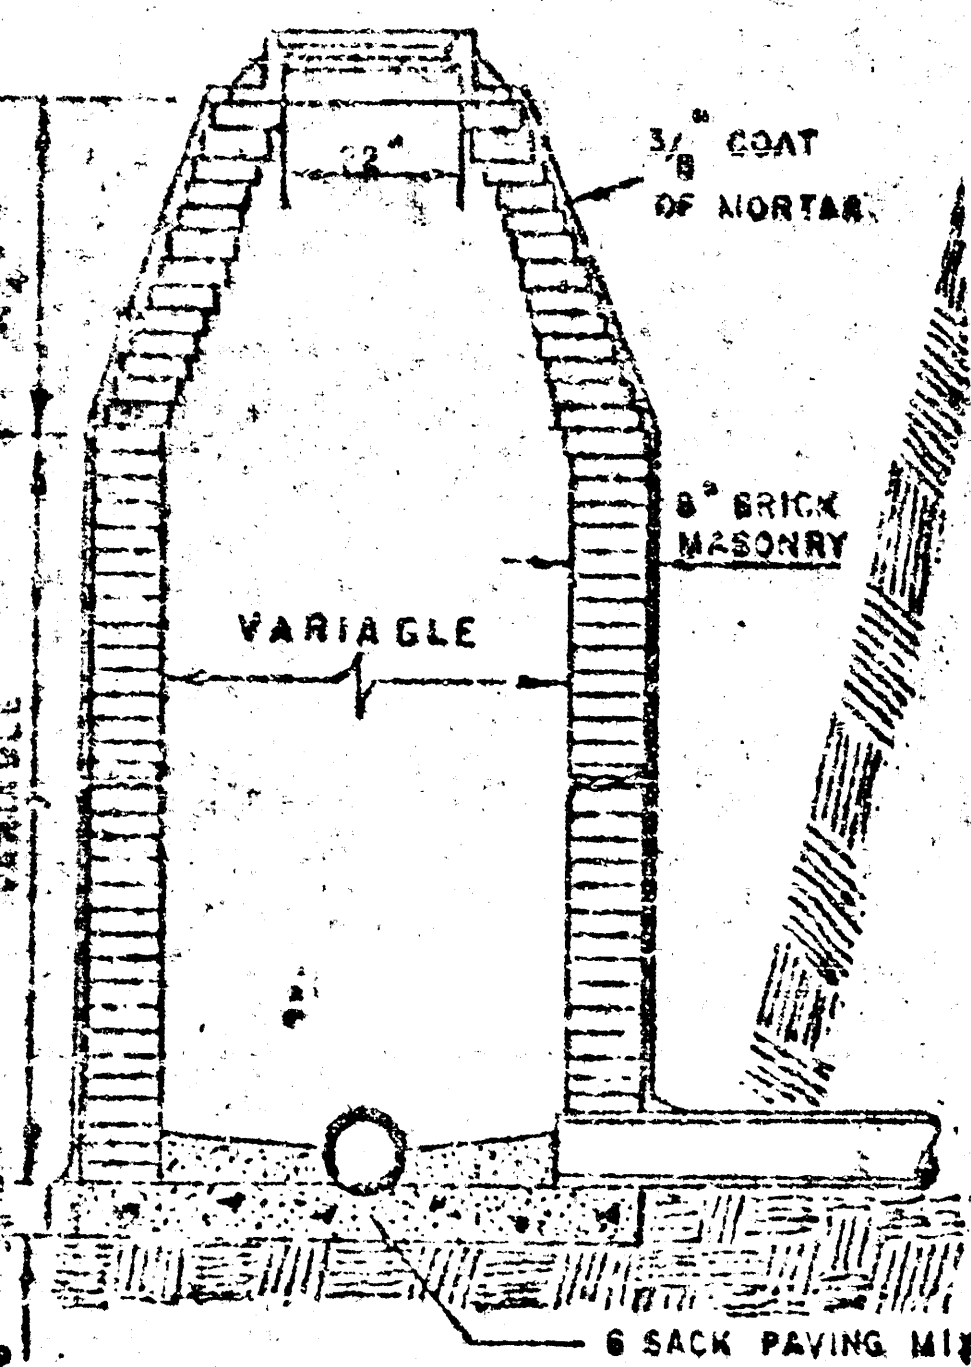


STANDARD MANHOLE
TYPE "A"


* 6" ON 5' DIA. M.H.

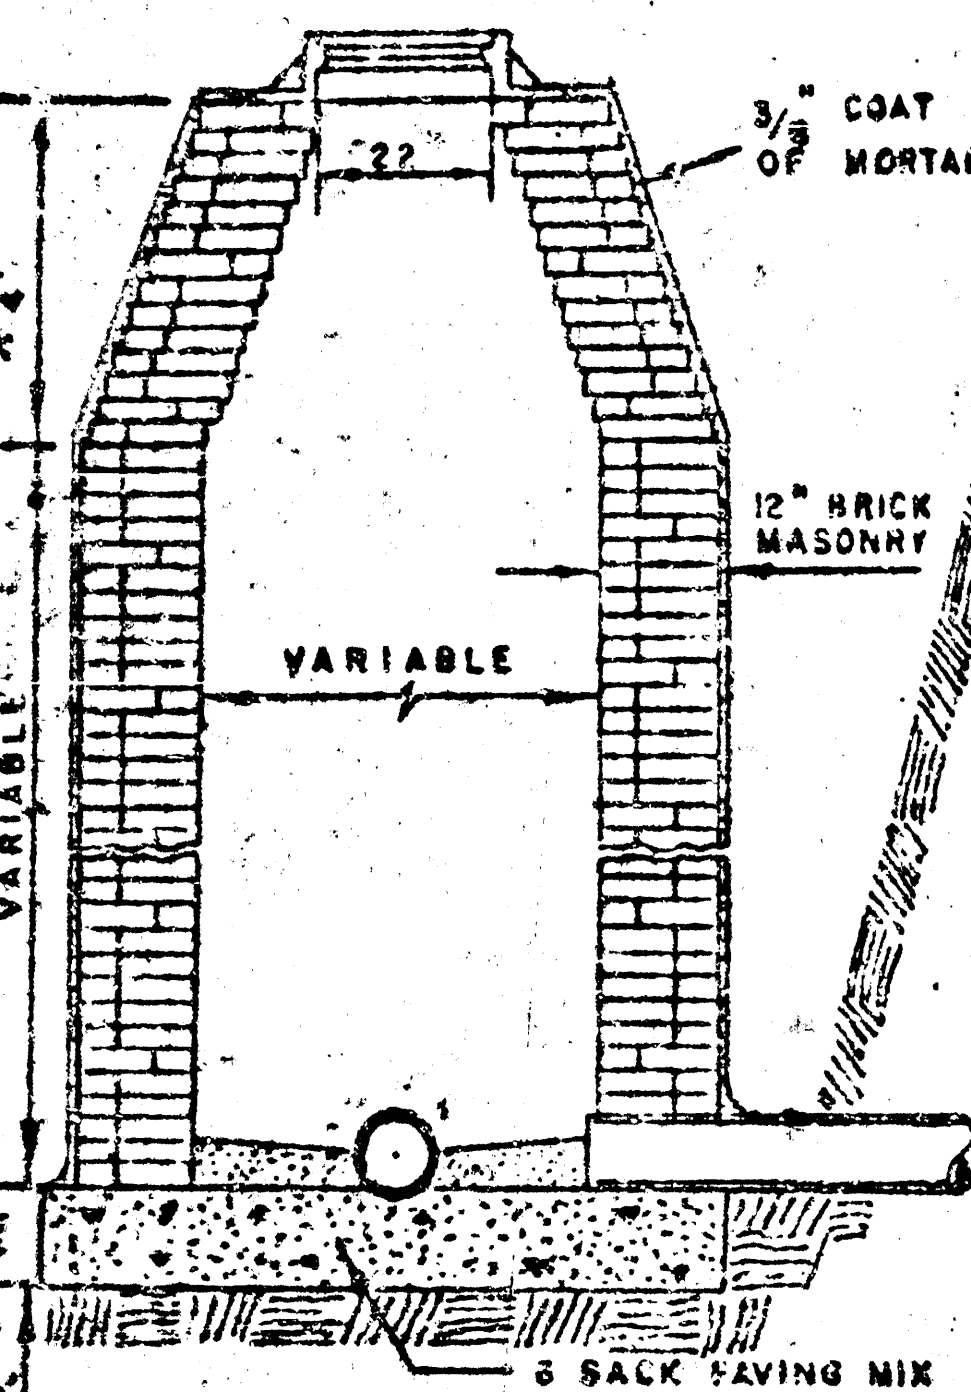

STANDARD MANHOLE
TYPE "B"

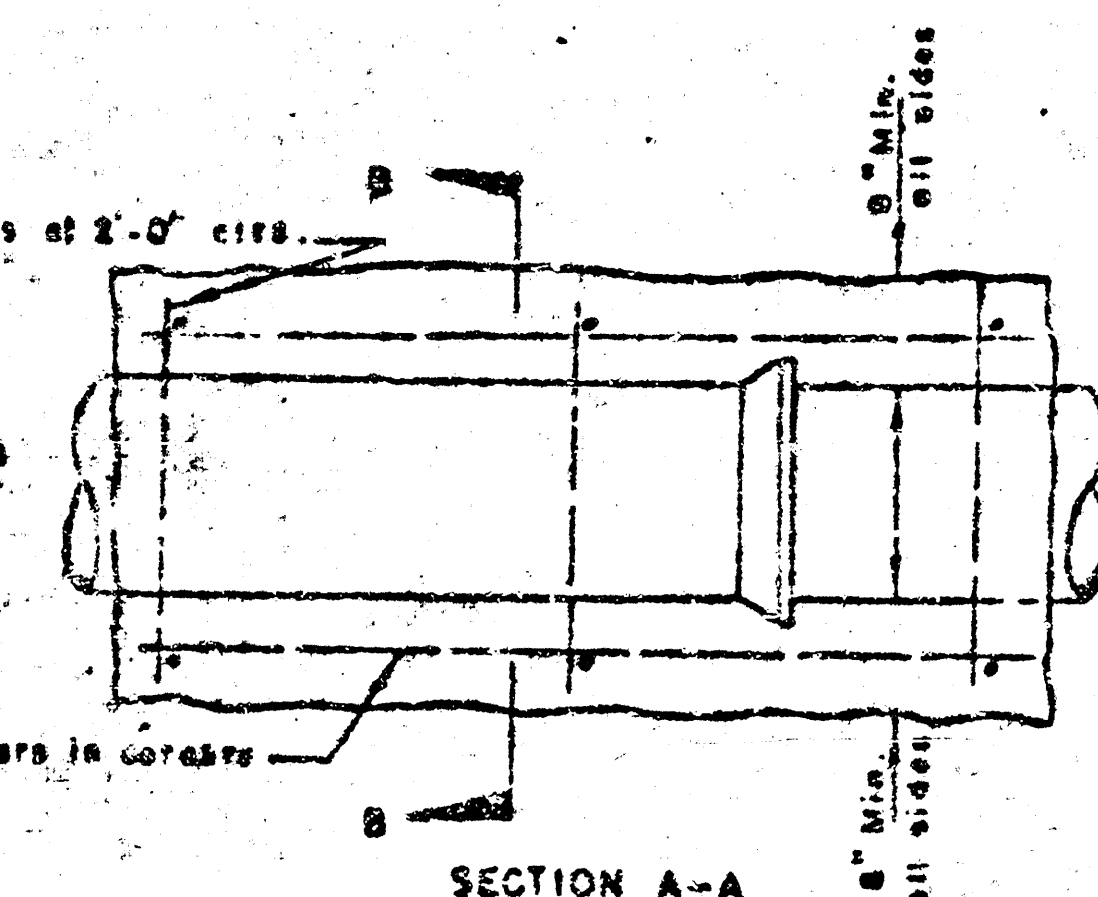


SECTION A-A

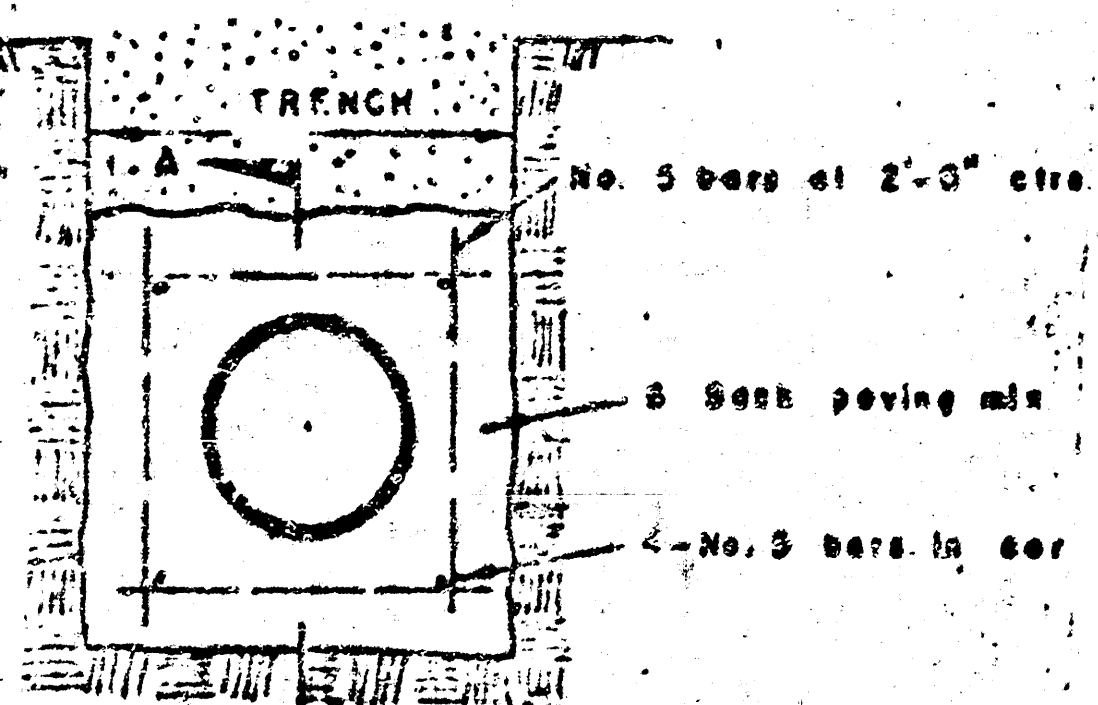

SECTION B-B

FORCED CONCRETE ENCASEMENT

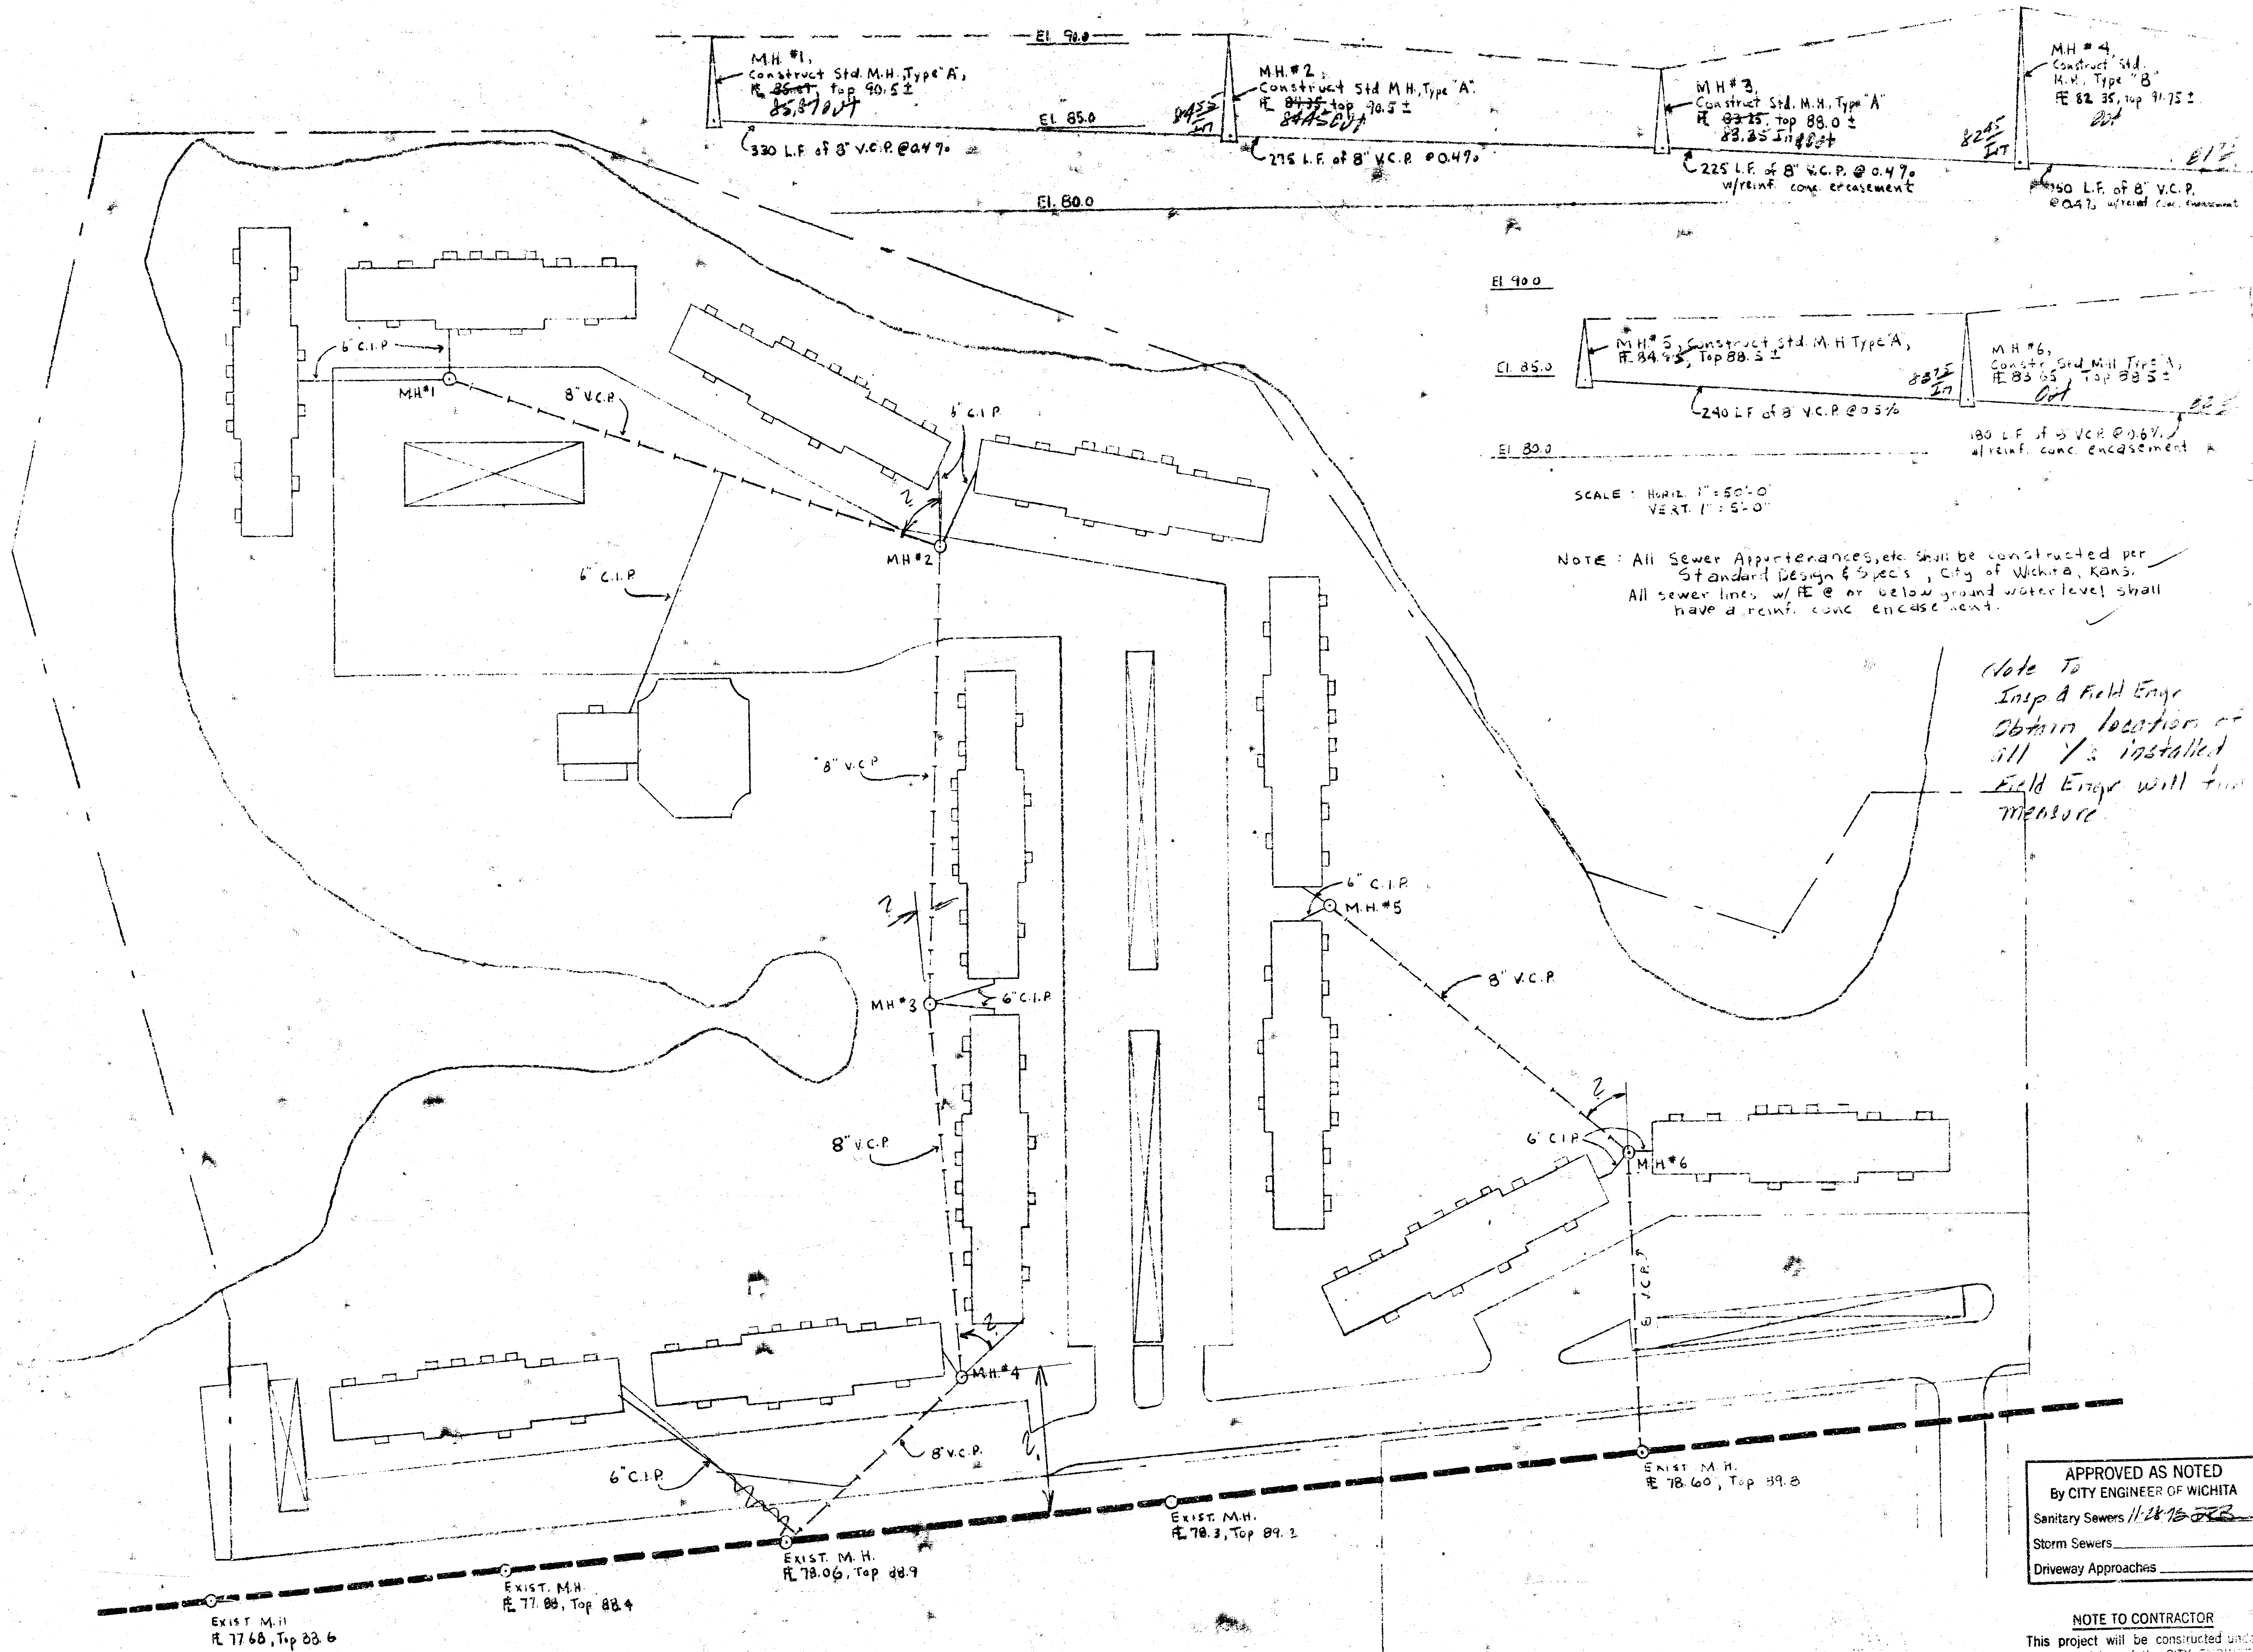

UTILITY PLAN

SCALE - 1" = 50'-0"

APPROVED AS NOTED
 By CITY ENGINEER OF WICHITA
 Sanitary Sewers 11-28-15 JEB
 Storm Sewers _____
 Driveway Approaches _____

NOTE TO CONTRACTOR
 This project will be constructed under the supervision of the CITY ENGINEER and conforming to the SPECIFICATIONS of the CITY OF WICHITA. The CONTRACTOR will reimburse the City of Wichita for all cost of Engineering, Plans, and Inspection.