



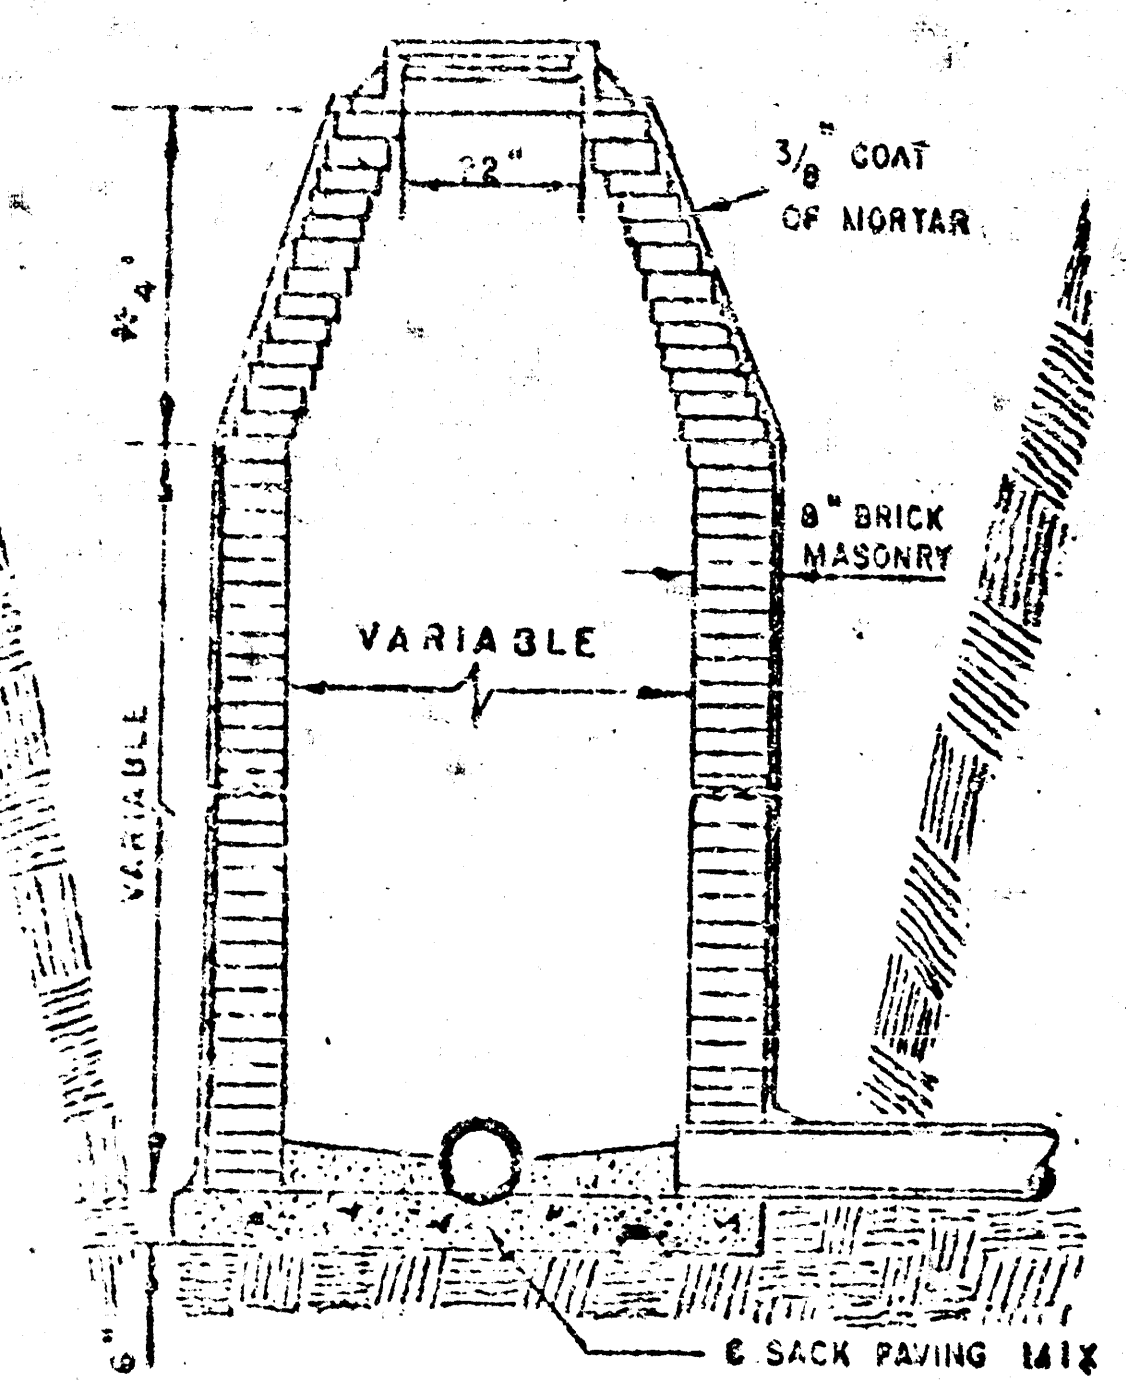


STANDARD MANHOLE
TYPE "A"


* 6" ON 5' DIA. M.H.

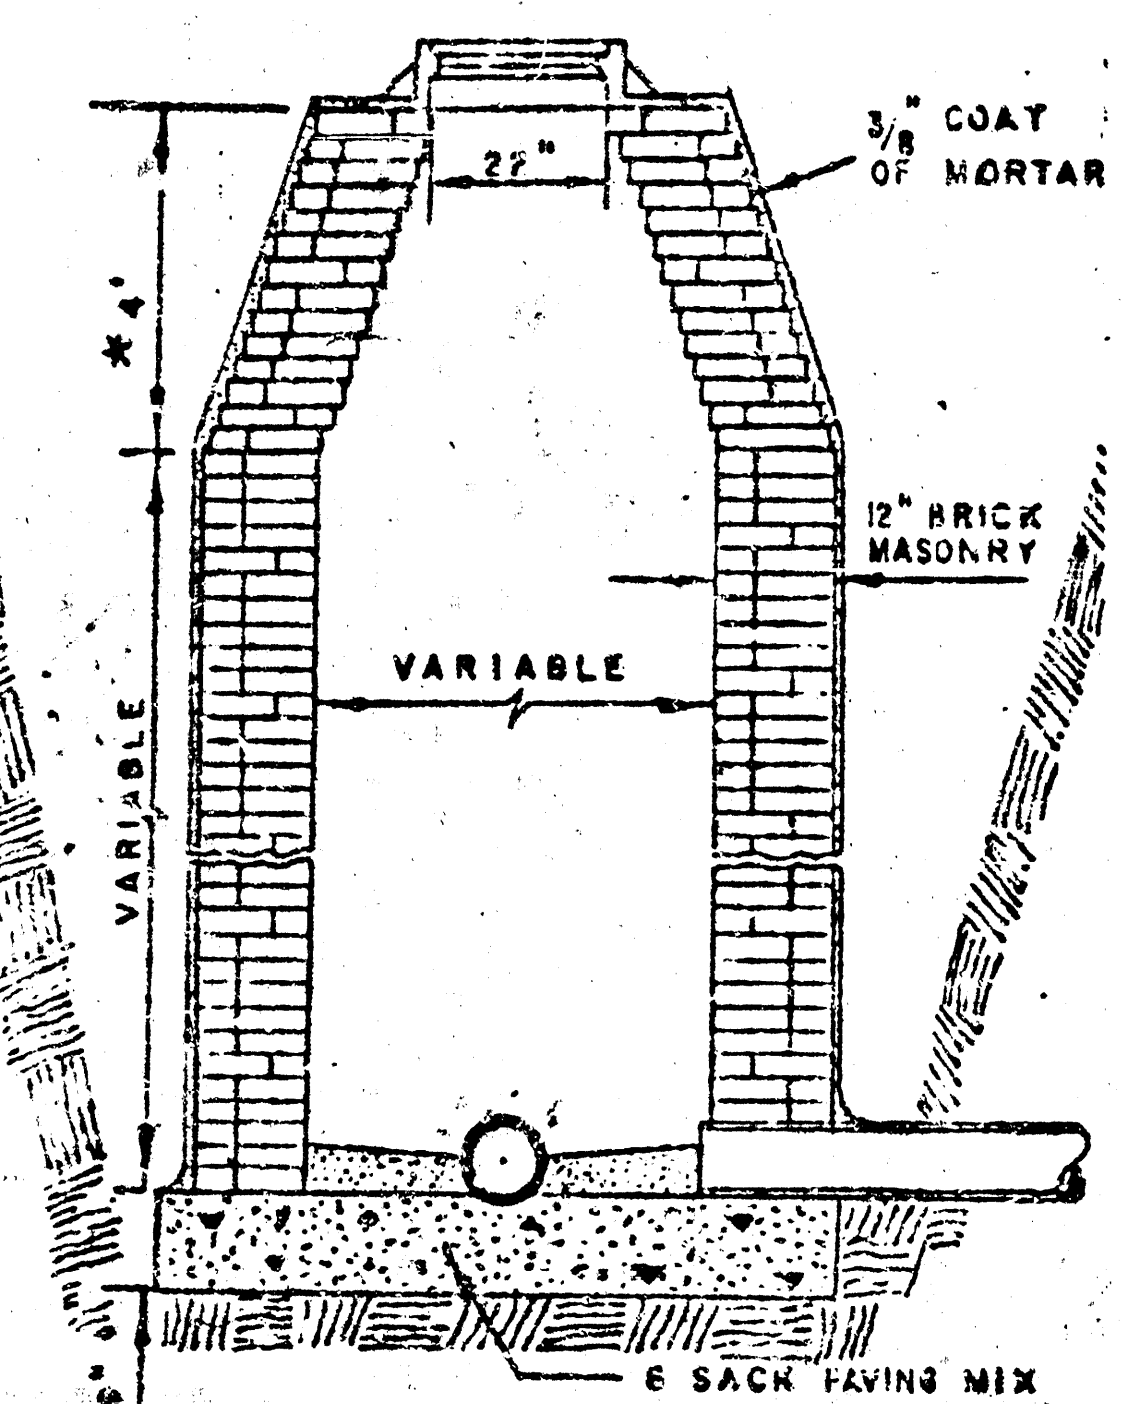

STANDARD MANHOLE
TYPE "B"

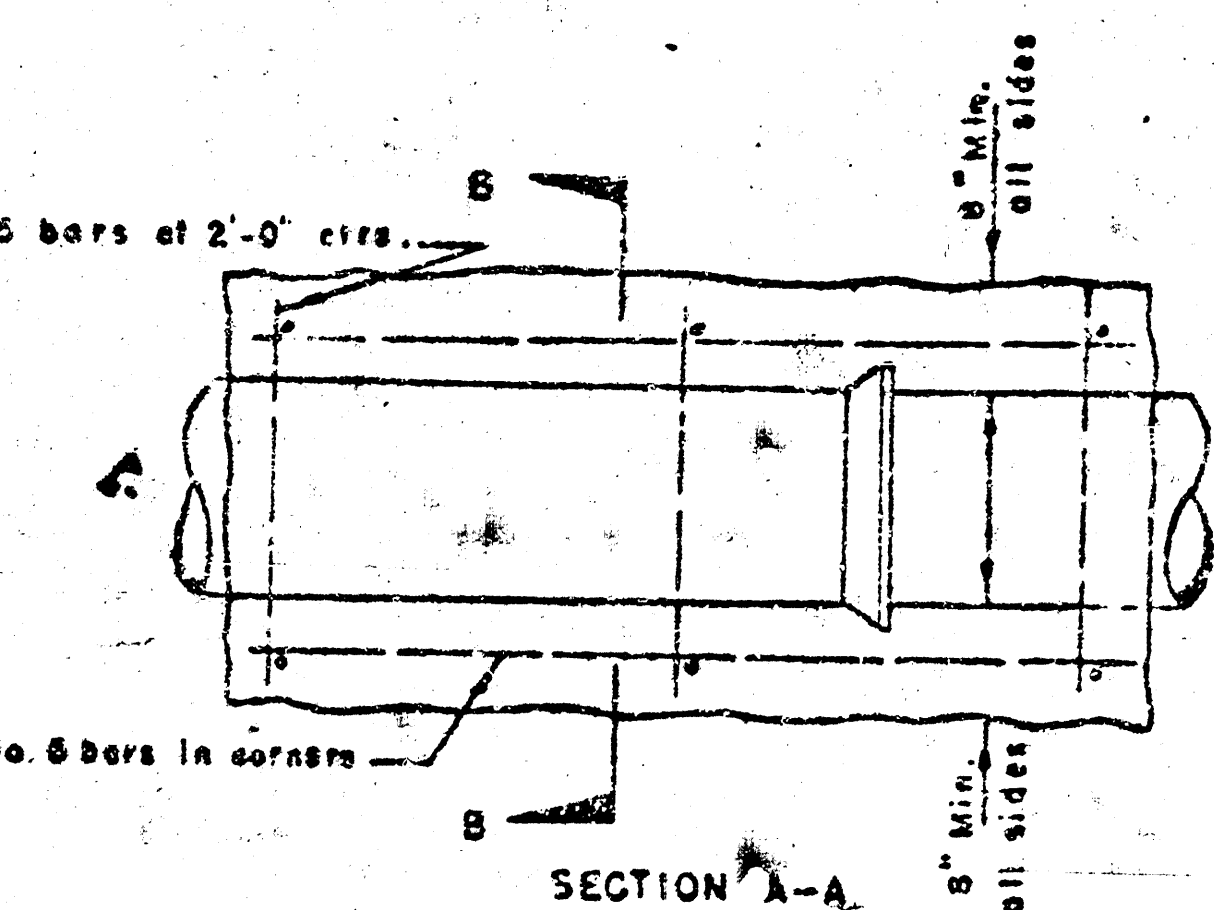


SECTION A-A

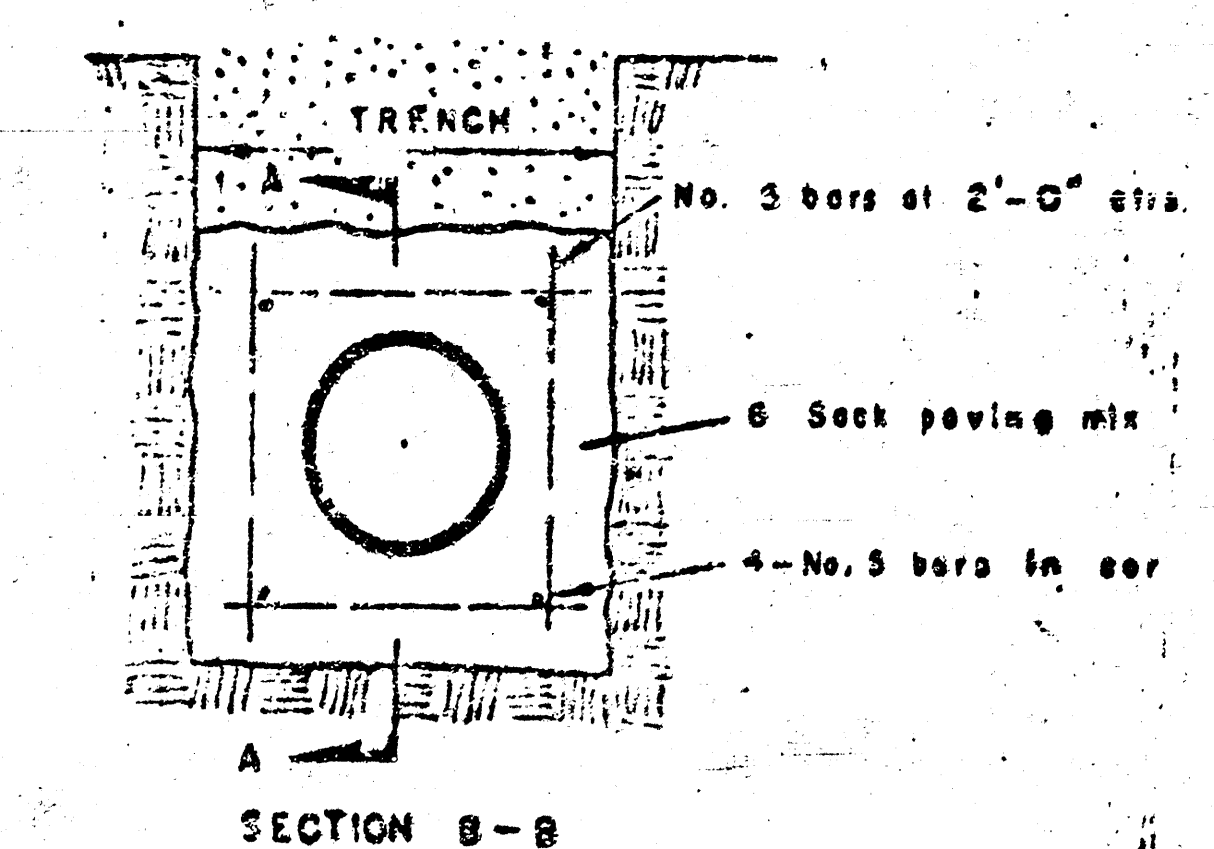

SECTION B-B

INFORCED CONCRETE ENCASEMENT

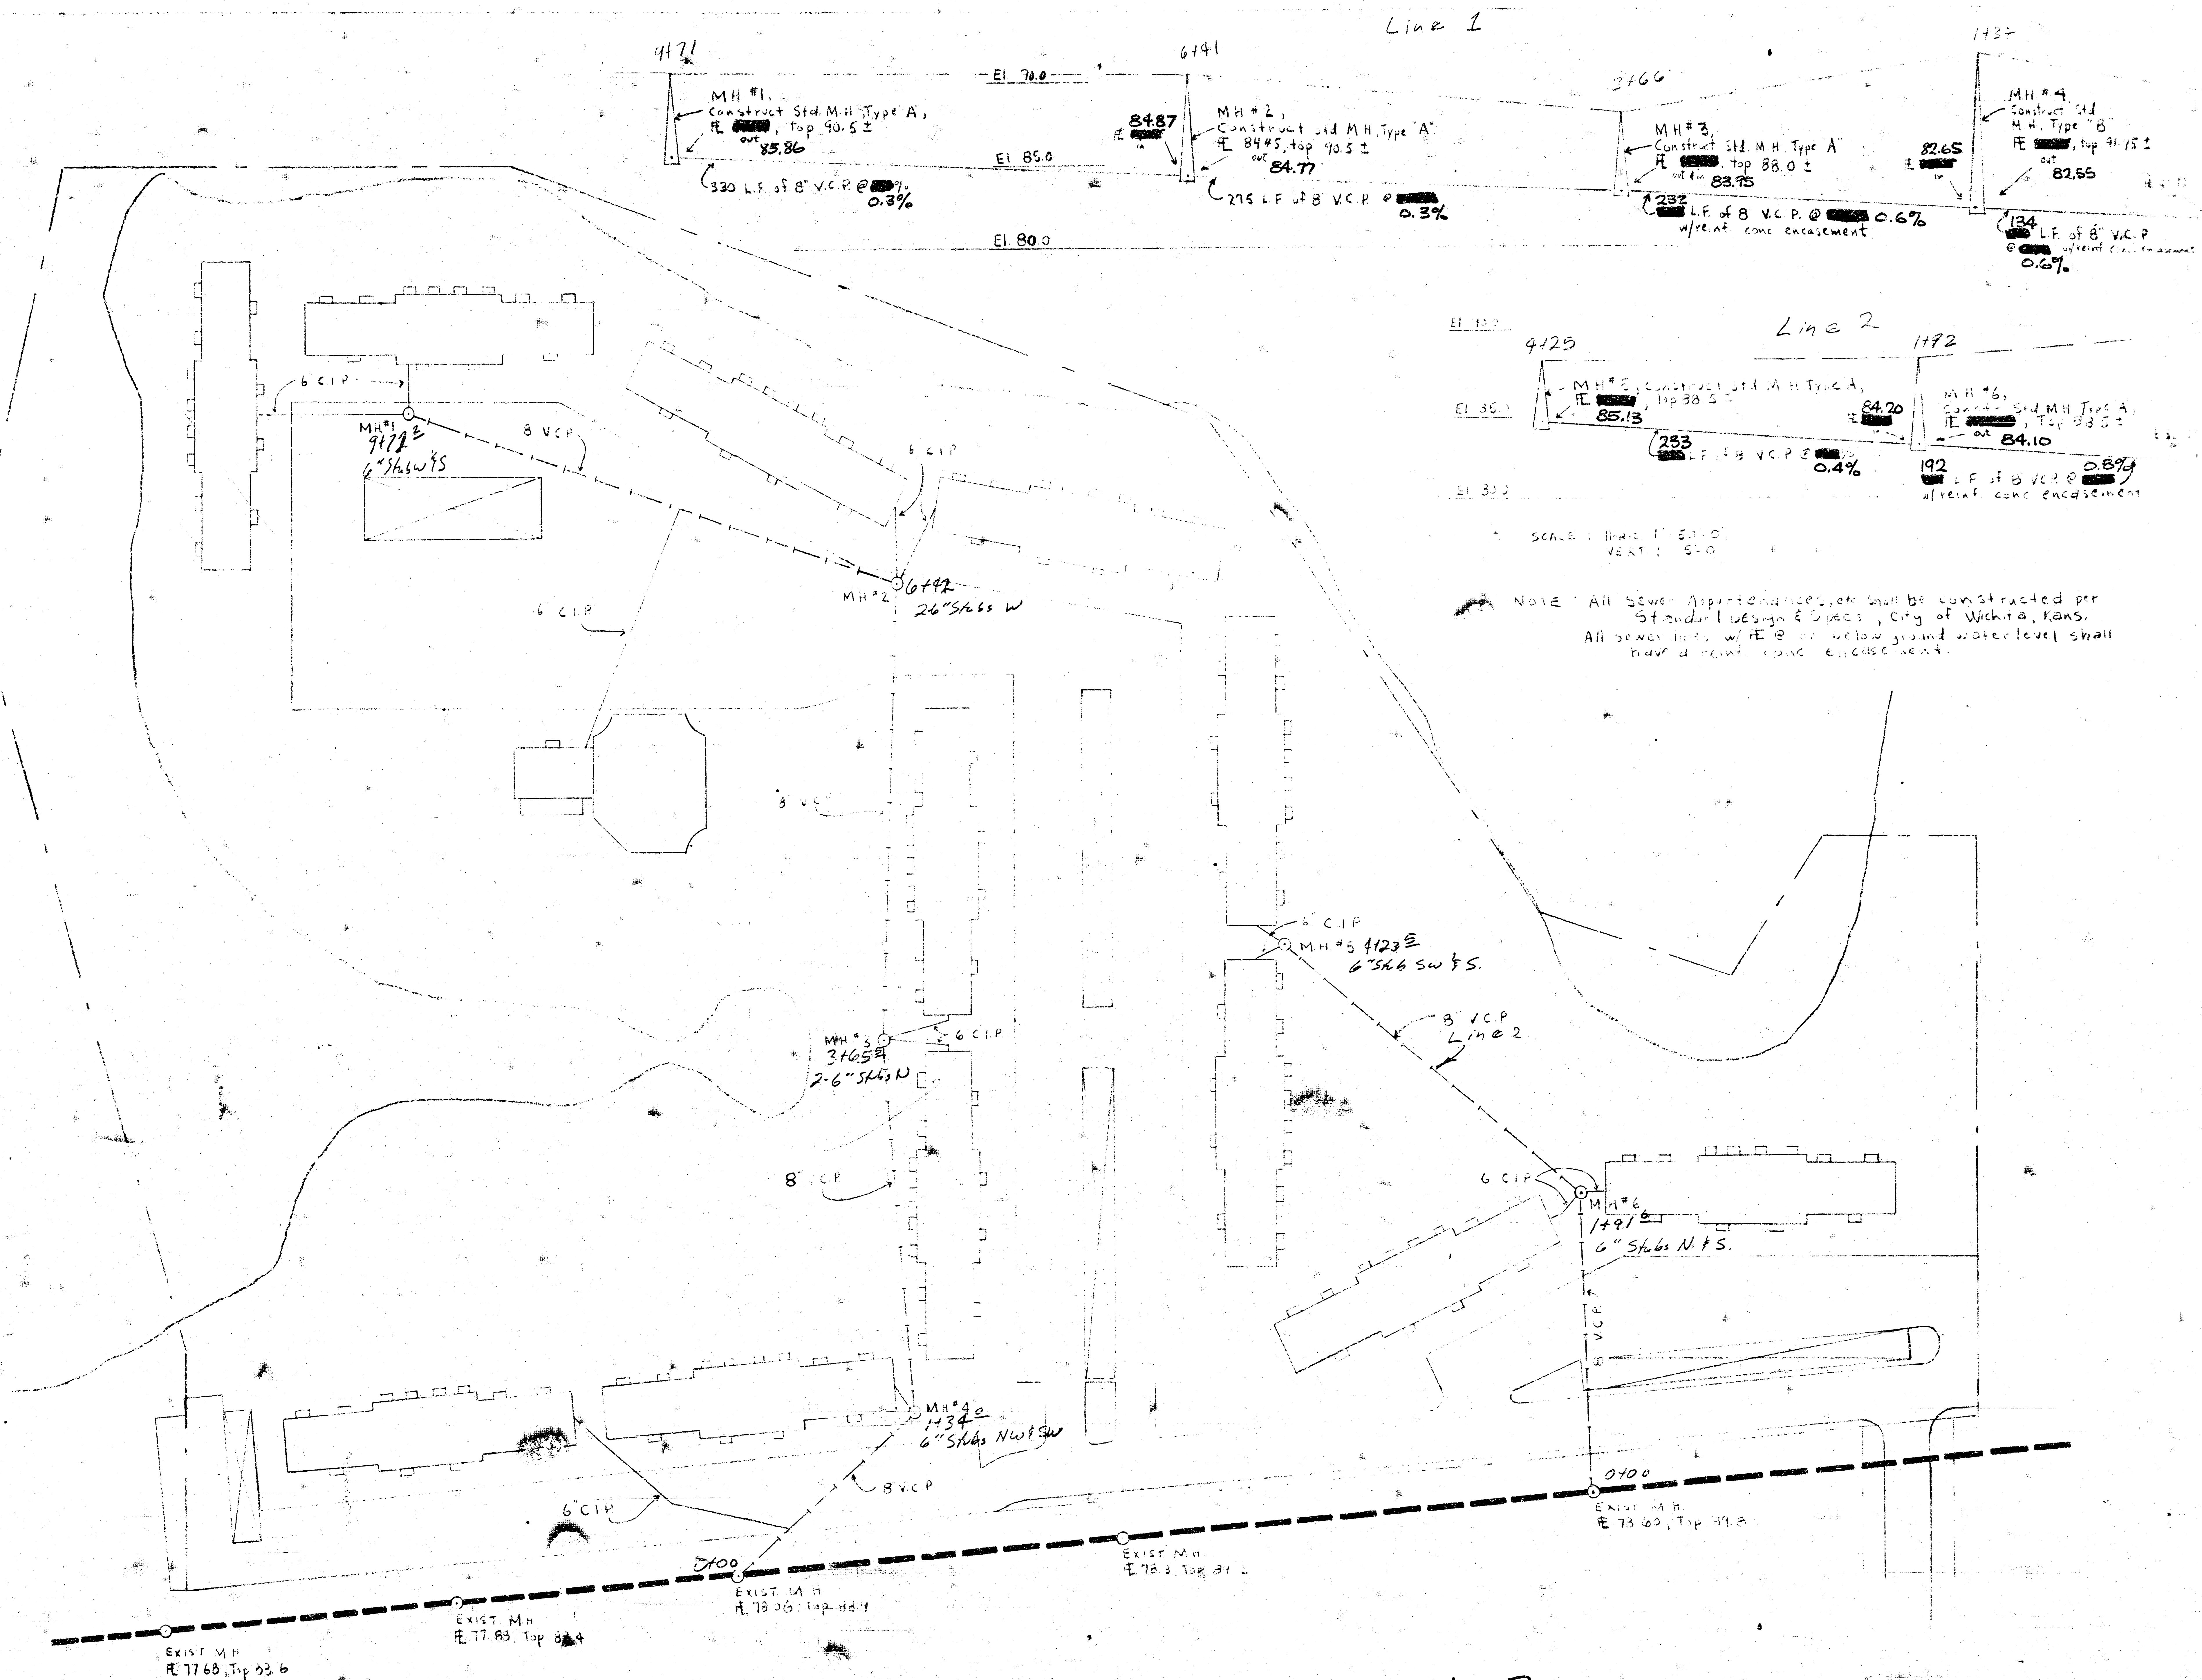

UTILITY PLAN

As BUILT