

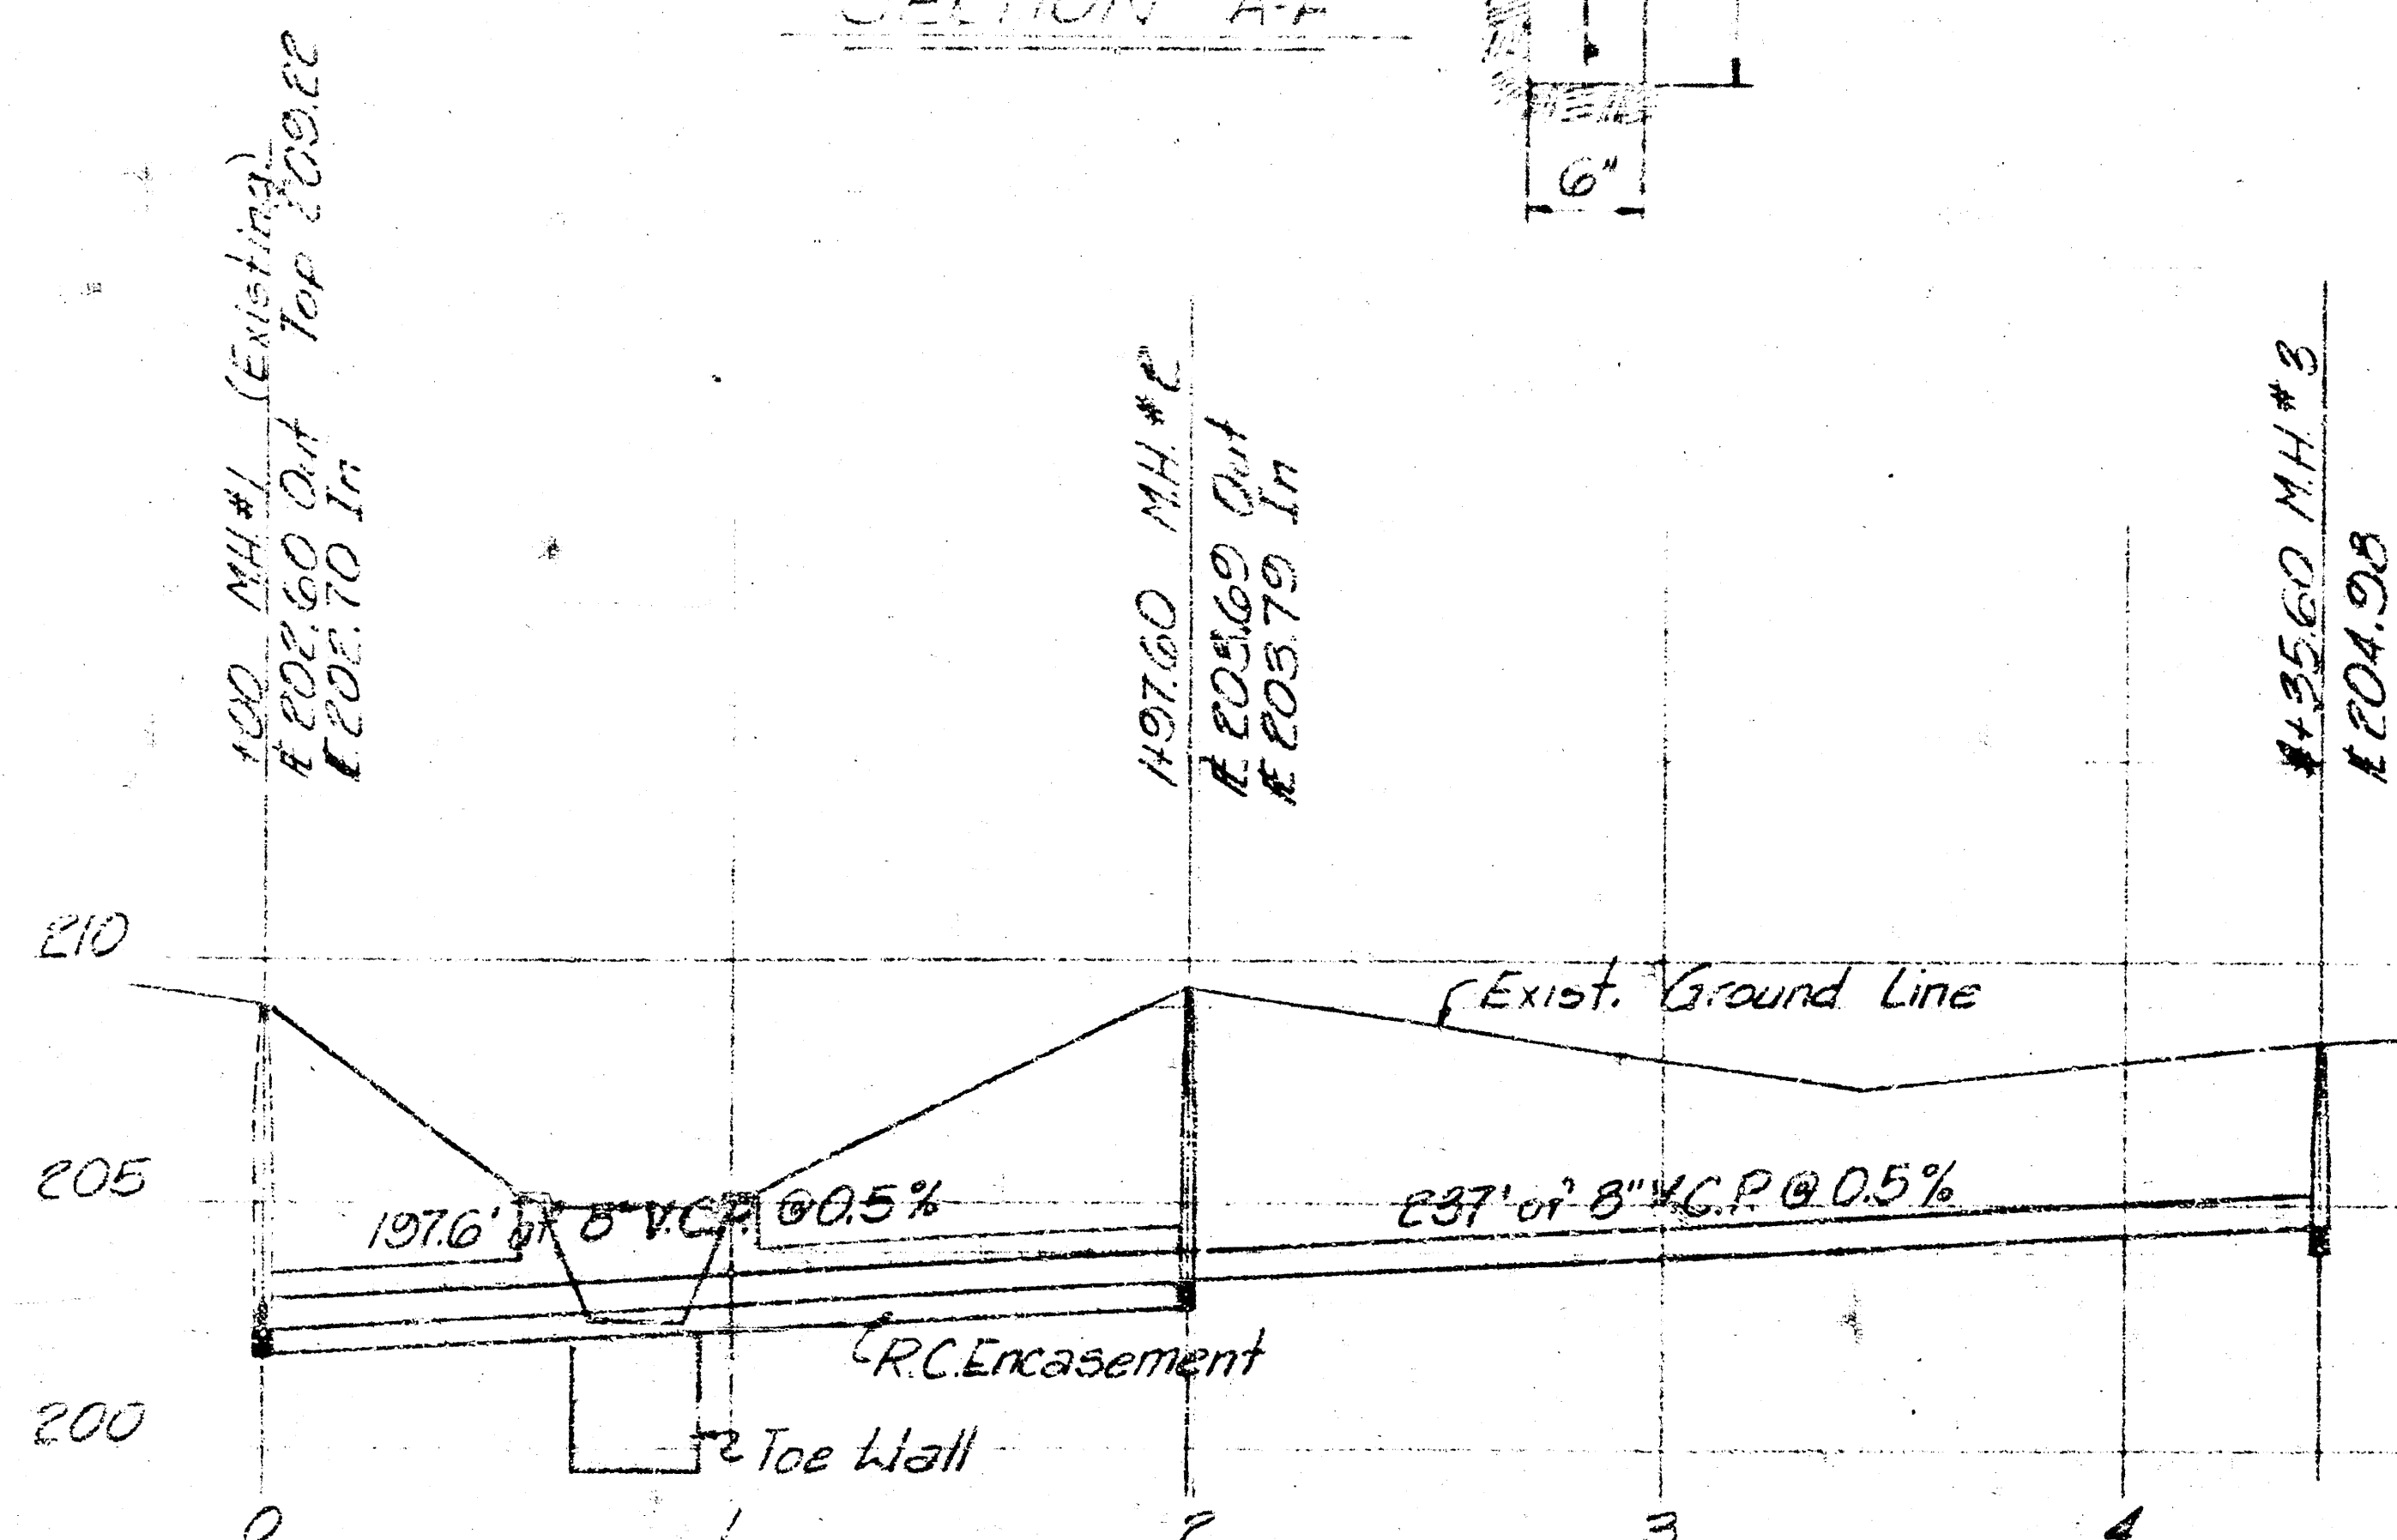
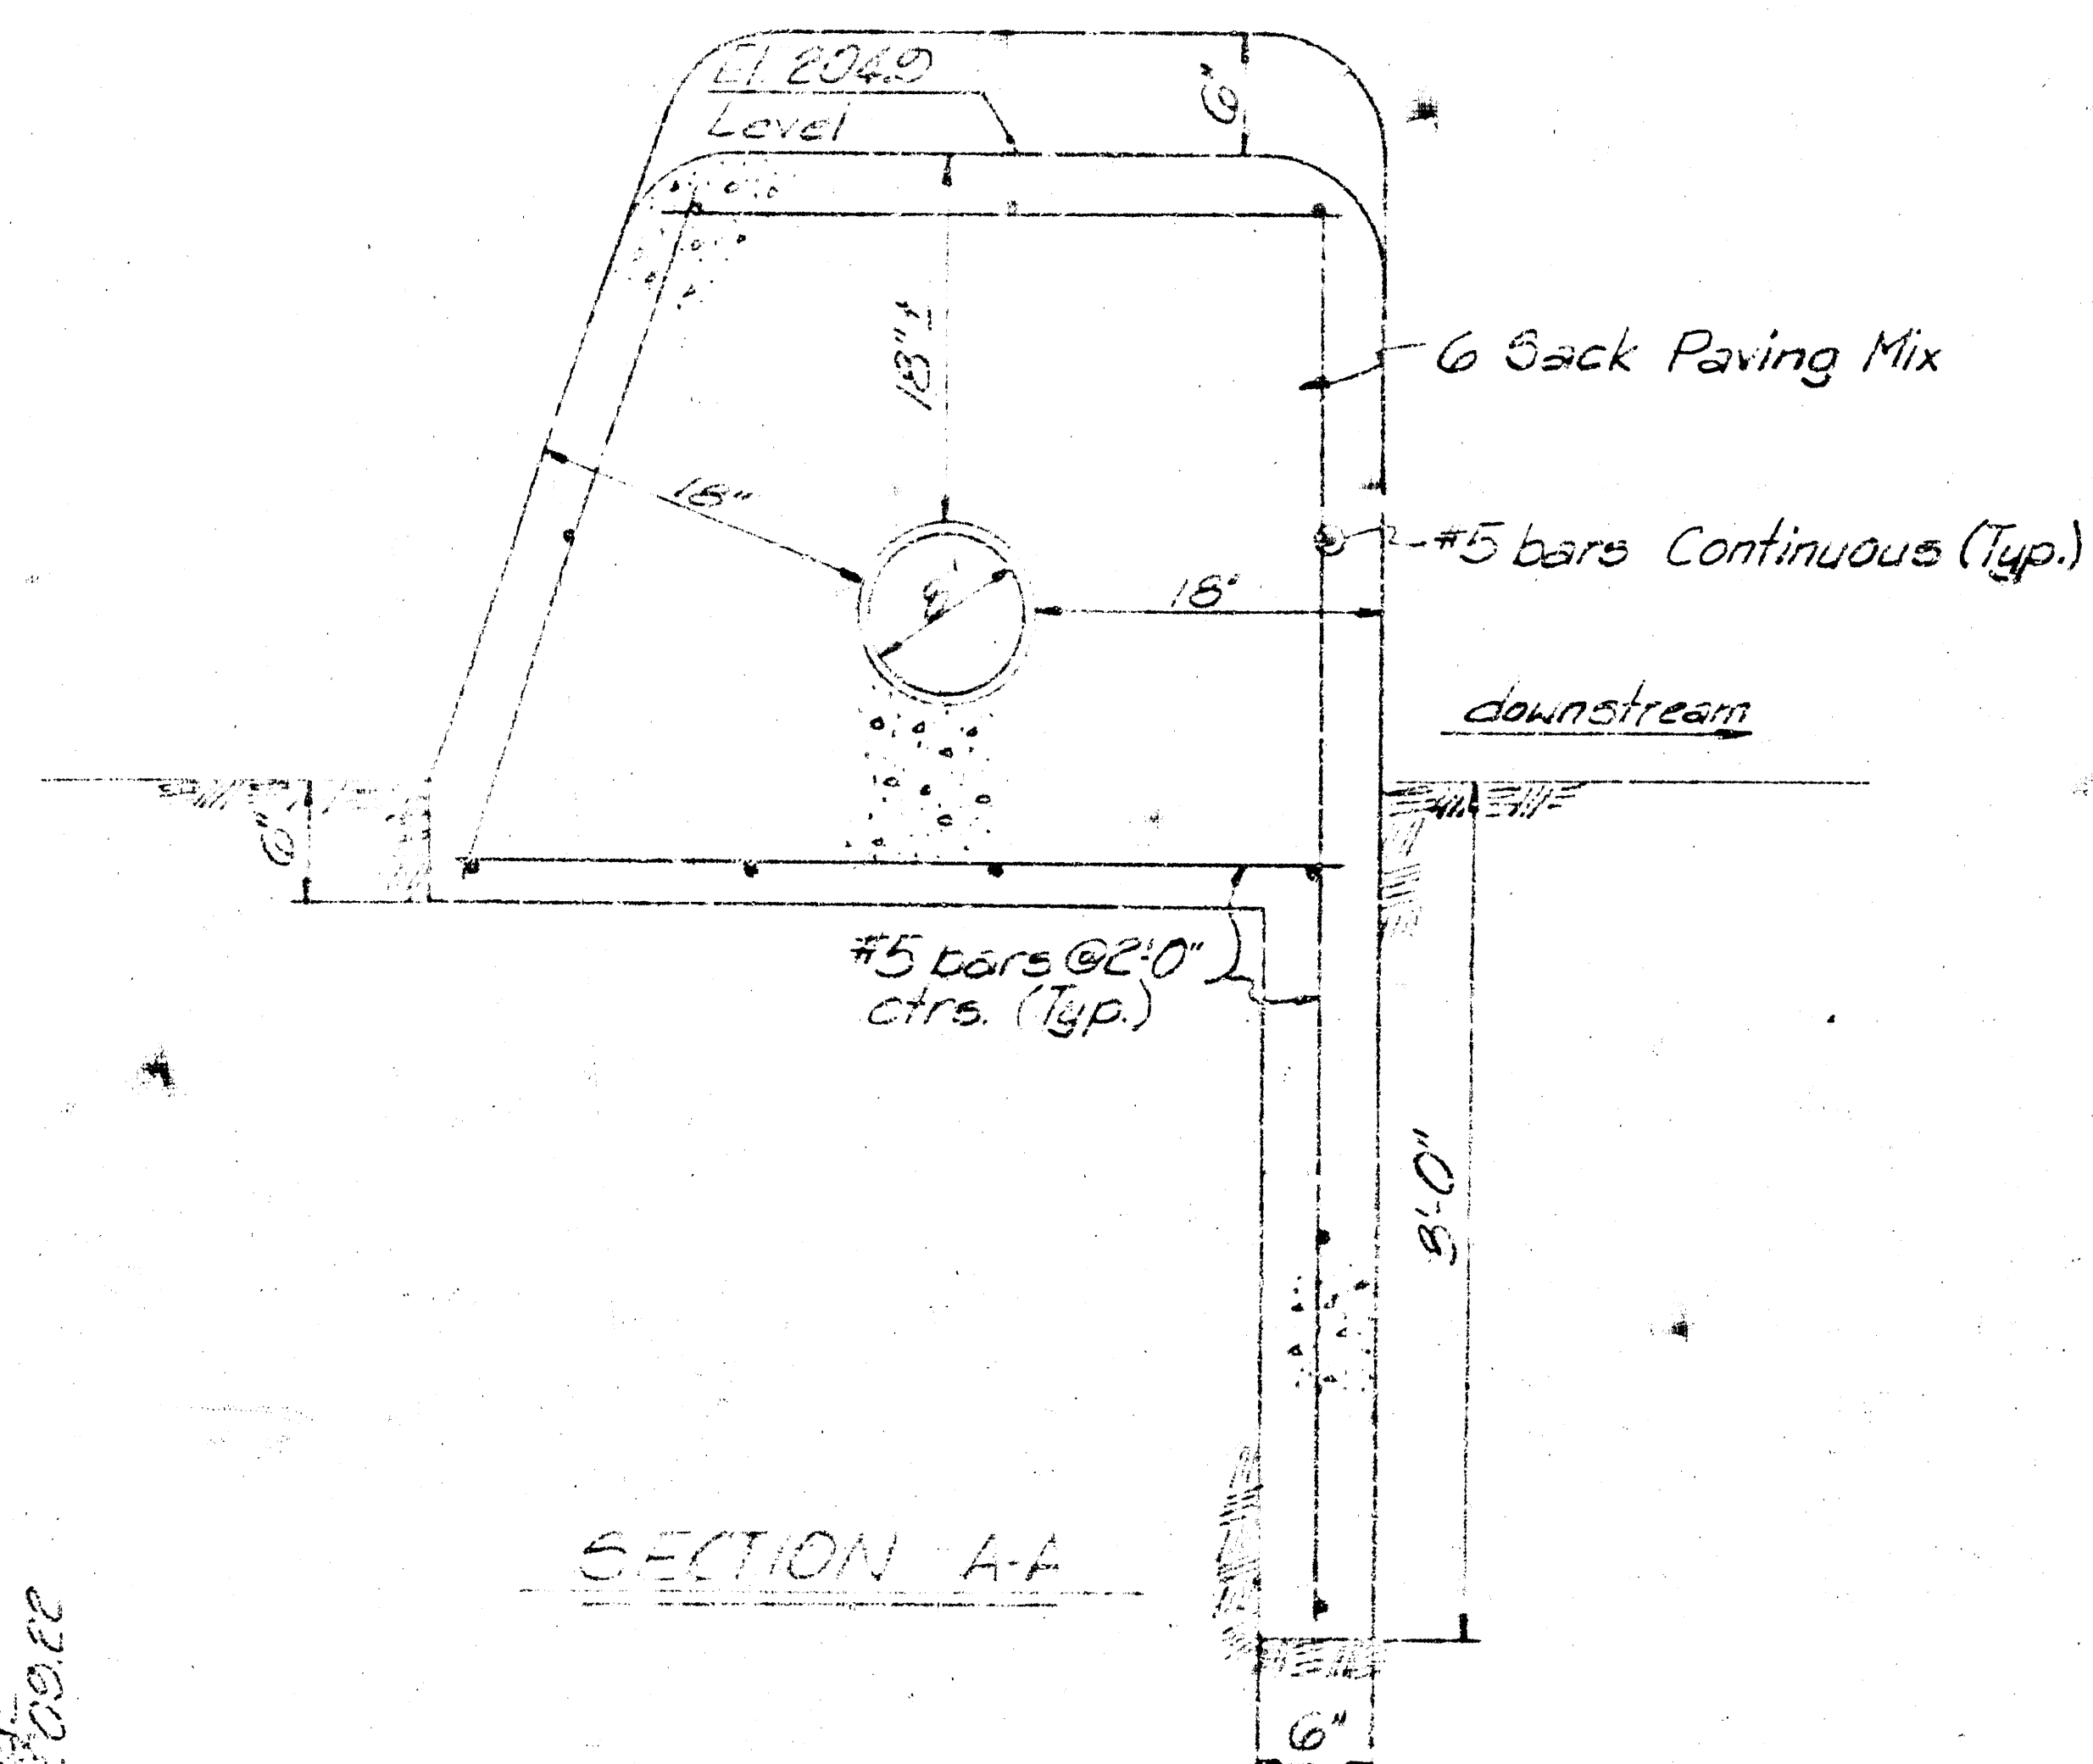


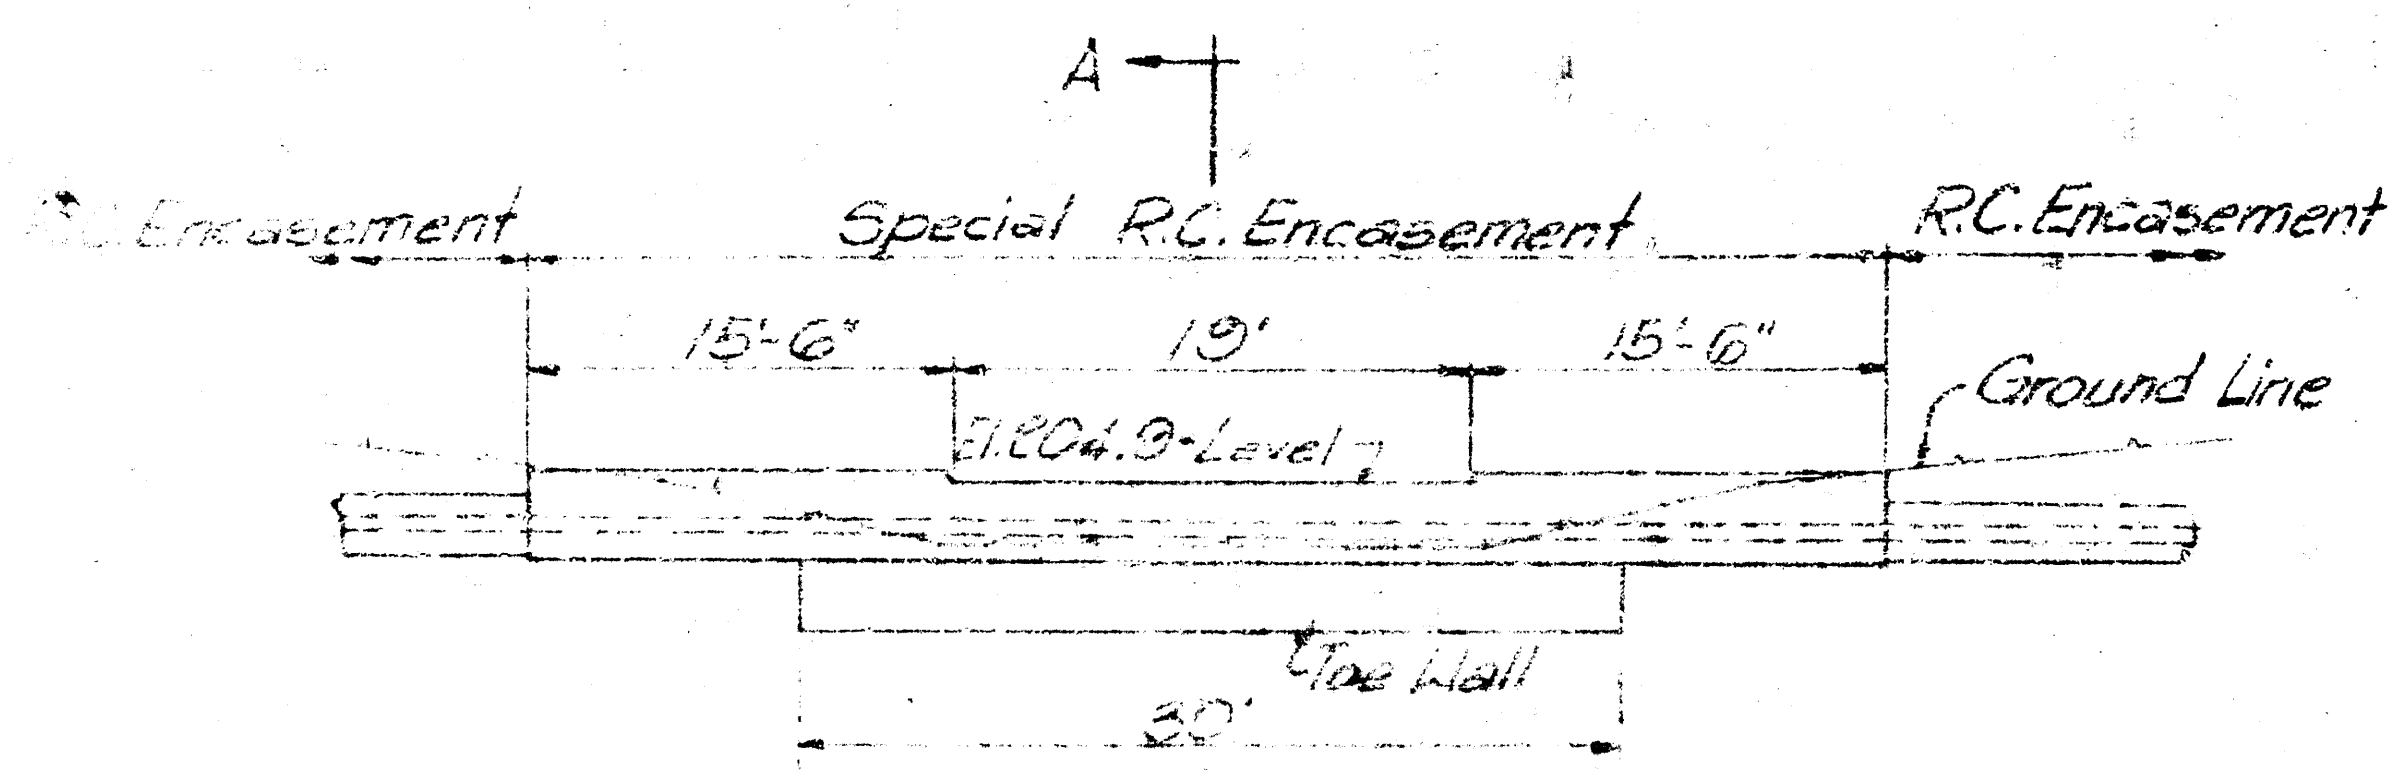

DRIVE

SPRING

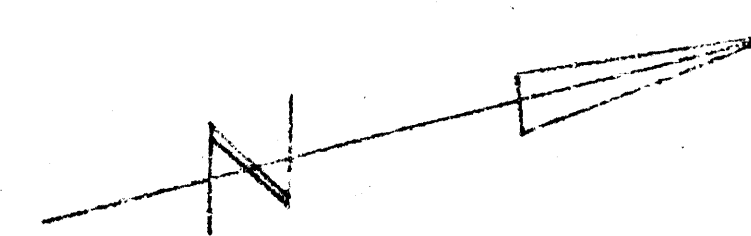

SCALE 1"=50'

LOT 18
(1436 Spring Drive)

LOT 20

LOT 22

Sta. 4+34.60 Const.
Std. Type A Manhole
Install 4" Stub S.

86°46'32"

Stone Planter

8" V.C.P.

4" Pipe

20' Easement

82°27'40"

Sta. 1+97.60 Const.
Std. Type A Manhole
Install 4" Stub N.W.

15' Cottonwood

15' Cottonwood

Creek Bottom

Flagpole


Existing 8" V.C.P.

Existing 16' Easement

Sta. 0+00 (New Line) Tie
8" V.C.P. to exist. manhole
Sta. 9+67.6 Lat. 49A
DC. 5. #2 San. Sew. #2

LOT 21

PLAN

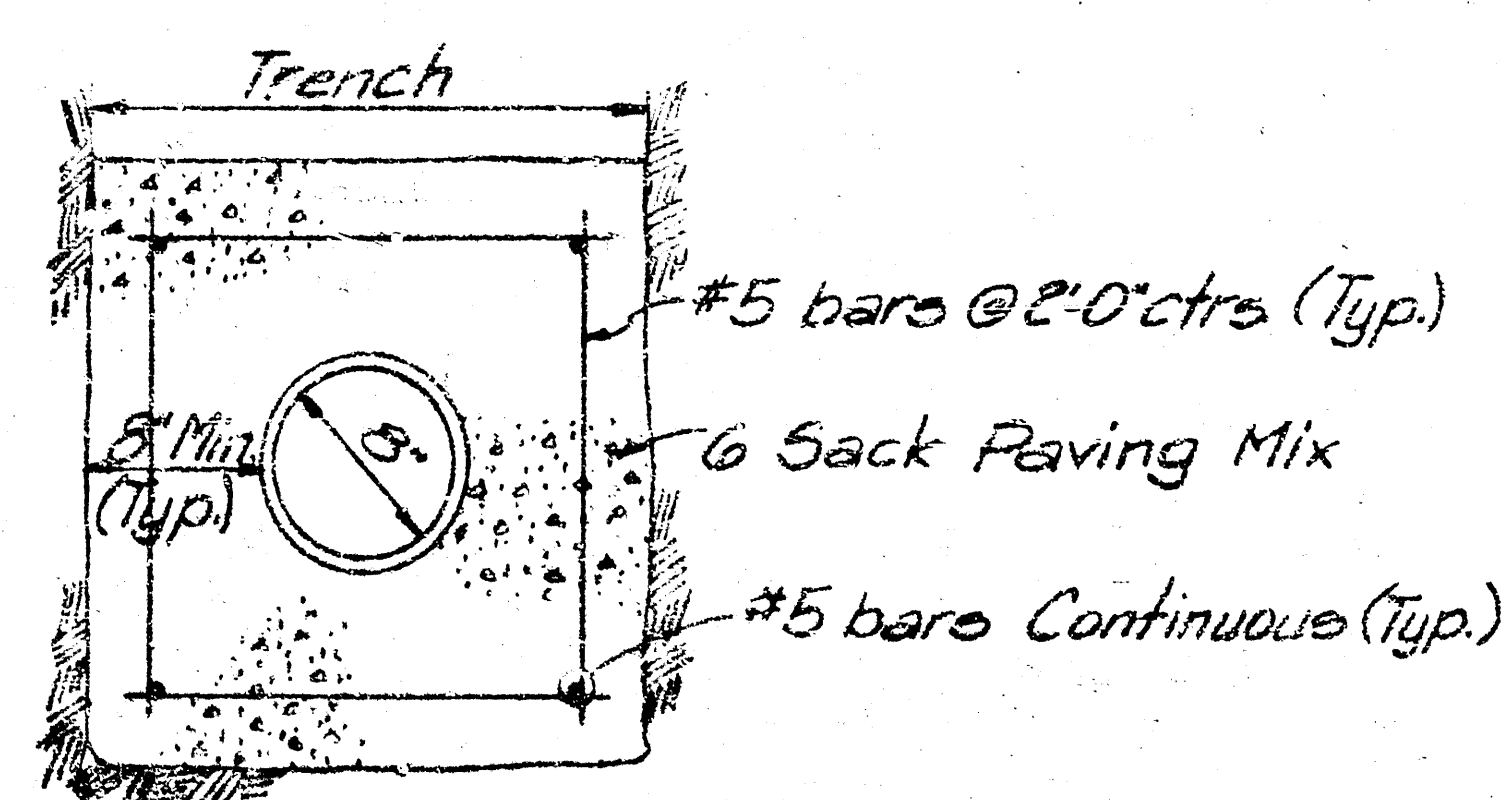

NOTE TO CONTRACTOR

This project will be constructed under the supervision of the CITY ENGINEER and conforming to the SPECIFICATIONS of the CITY OF WICHITA. The CONTRACTOR will reimburse the City of Wichita for all cost of ~~inspections~~ inspection.

9-27-75

APPROVED AS NOTED
By CITY ENGINEER OF WICHITA

Sanitary Sewers O.E.S.

Storm Sewers

Driveway Approaches

SANITARY SEWER EXTENSION TO
LOTS 18, 20, & 22 IN REPLAT OF
SPRING ACRES
City Project No. DBKN705033