


Hand-drawn map showing a rectangular area with various measurements and labels. The map is oriented with North at the top.

Labels and measurements include:

- Top left: 37.22 Dist. N.H.
- Top right: 40.5
- Bottom right: 37.22
- Bottom left: 11/6/4
- Bottom center: 12/1
- Bottom right: 12/1
- Center: 37.22
- Left side: 12/1
- Right side: 12/1

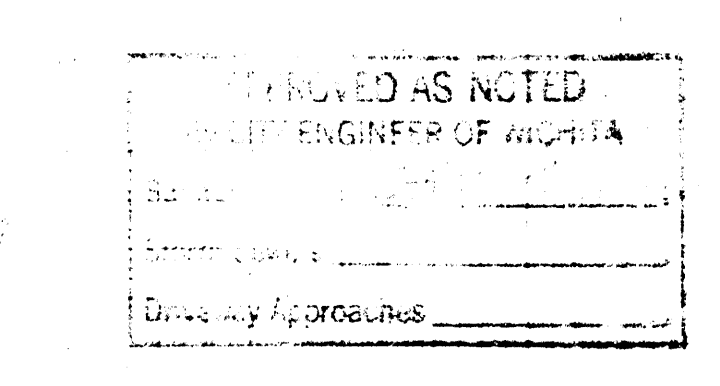

As Built Plans from SS 1078
SANITARY SEWER EXTENSION
TAFT ST. APARTMENTS
425 TAFT
WICHITA, KANSAS
DECEMBER 1971
Mid-States Constr. Co.