

Scale: Horiz. 1" = 20'  
Vert. 1" = 5'


8-27-76  
APPROVED AS NOTED  
By CITY ENGINEER OF WICHITA  
Sanitary Sewers *D.E.S.*  
Storm Sewers \_\_\_\_\_  
Sidewalk Approaches \_\_\_\_\_

NOTE TO CONTRACTOR  
This project will be constructed under the supervision of the CITY ENGINEER and conforming to the SPECIFICATIONS of the CITY OF WICHITA. The CONTRACTOR will reimburse the City of Wichita for all cost of engineering, plans, and inspection.

Note: Contractor shall verify the flowline elevation of the existing 8" VCP sewer at the new manhole (Sta. 0+00) prior to beginning trenching operations.

BM - City Std. Disc - 32'E 6-29'S  
MacArthur & Broadway - E1 89 85

90  
85  
80

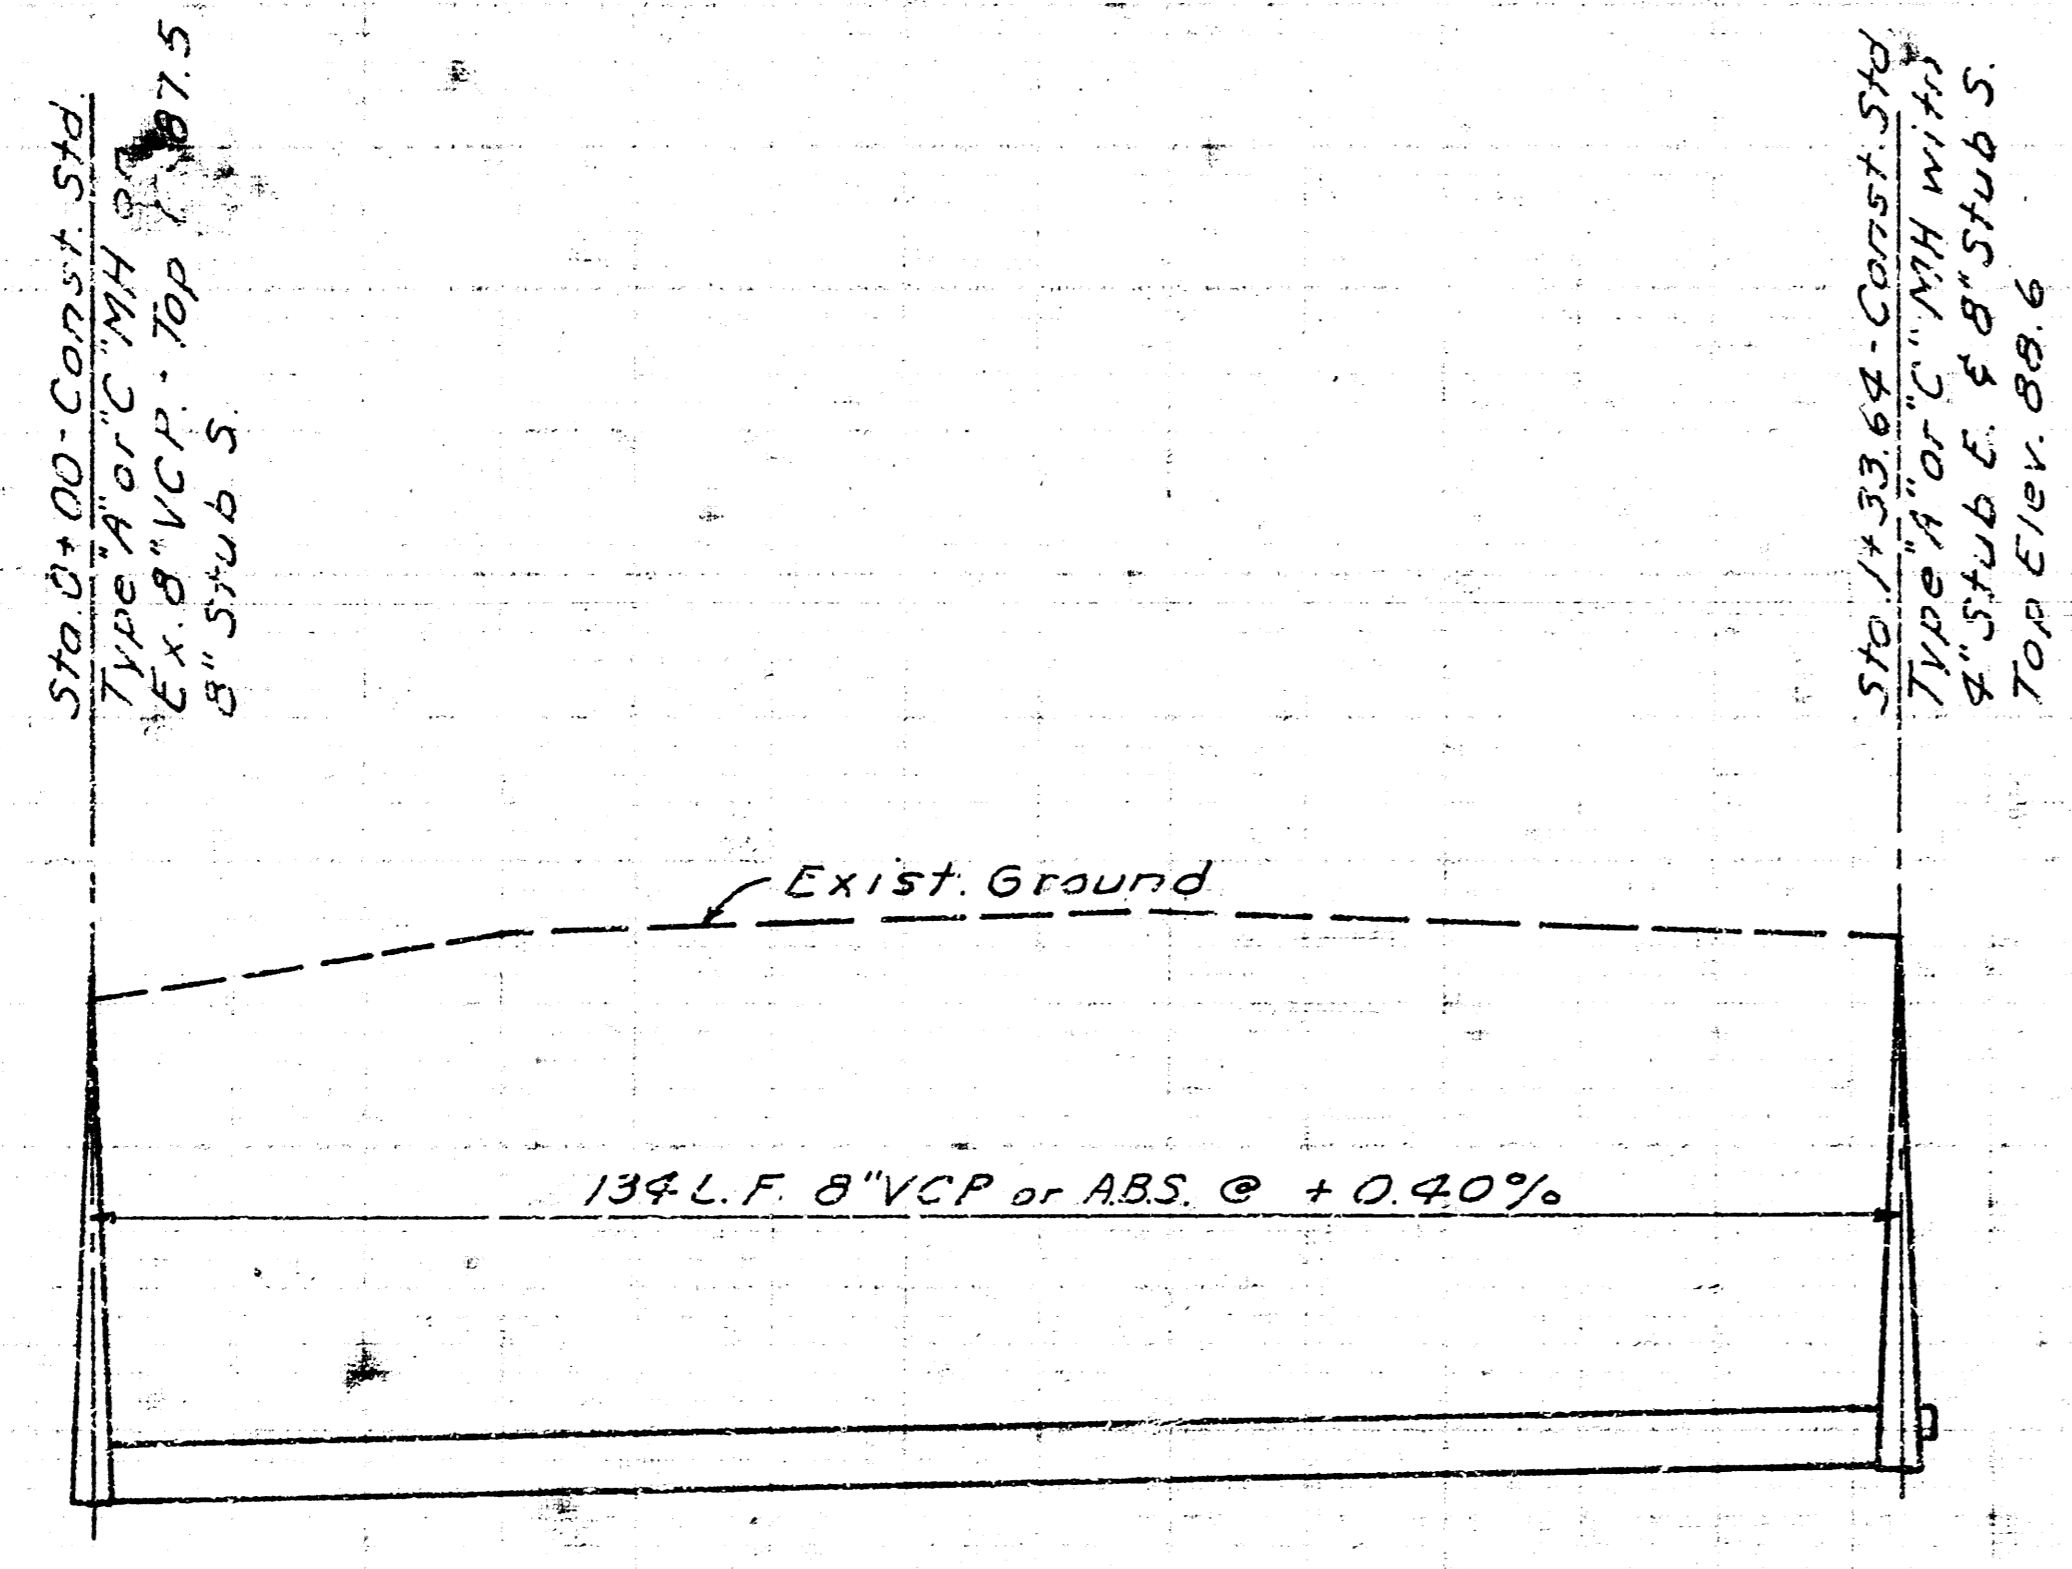

Out 78.35  
In 80.40 S.E.  
E 80.60  
08 08 3  
(3) 2278 W 1  
(5) E 018 B 1  
E 8 08 100 2