

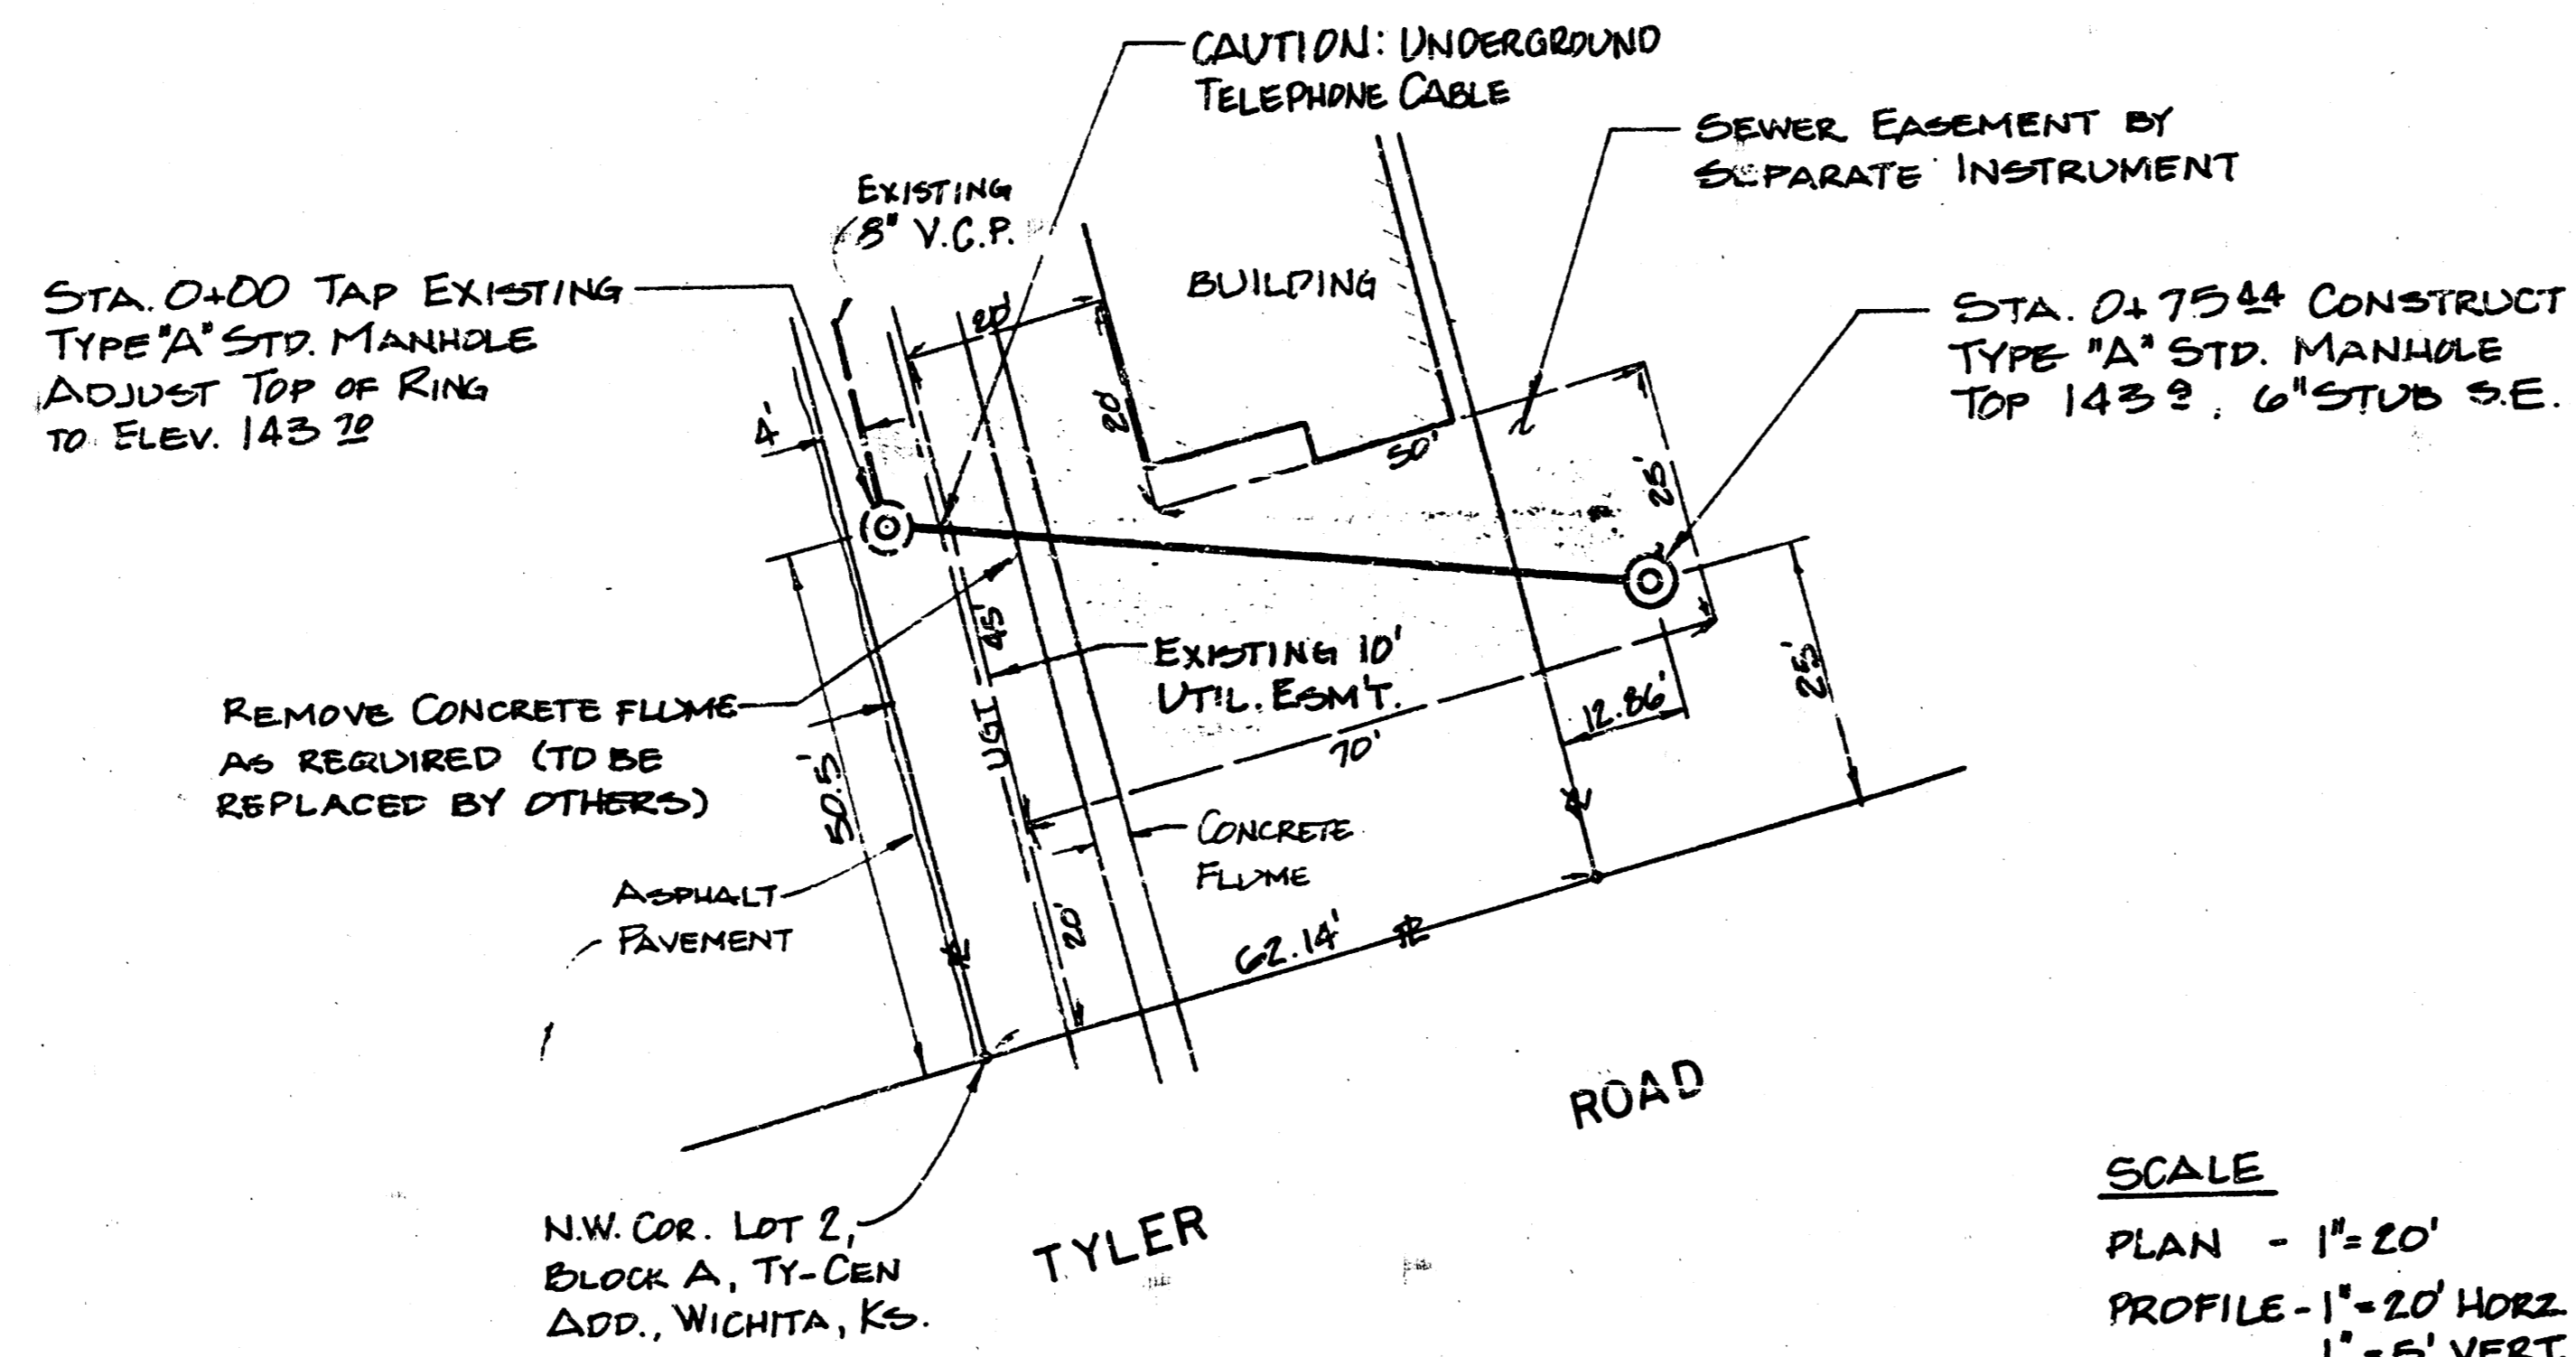


PLAN
 NOTED: REVISIONS
 DATE: 1-19-84

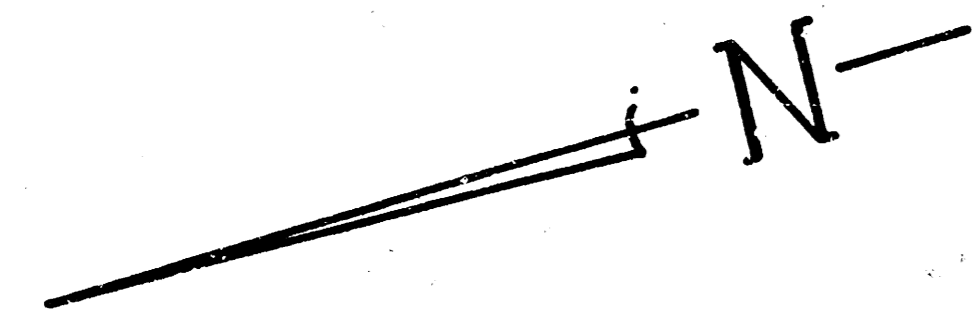


SCALE
 PLAN - 1" = 20'
 PROFILE - 1" = 20' HORIZ.
 1" = 5' VERT.

BENCH MARK
 CITY OF WICHITA STD. DISC
 562' N + 56' N. & CENTRAL +
 TYLER, ELEV. 143.99

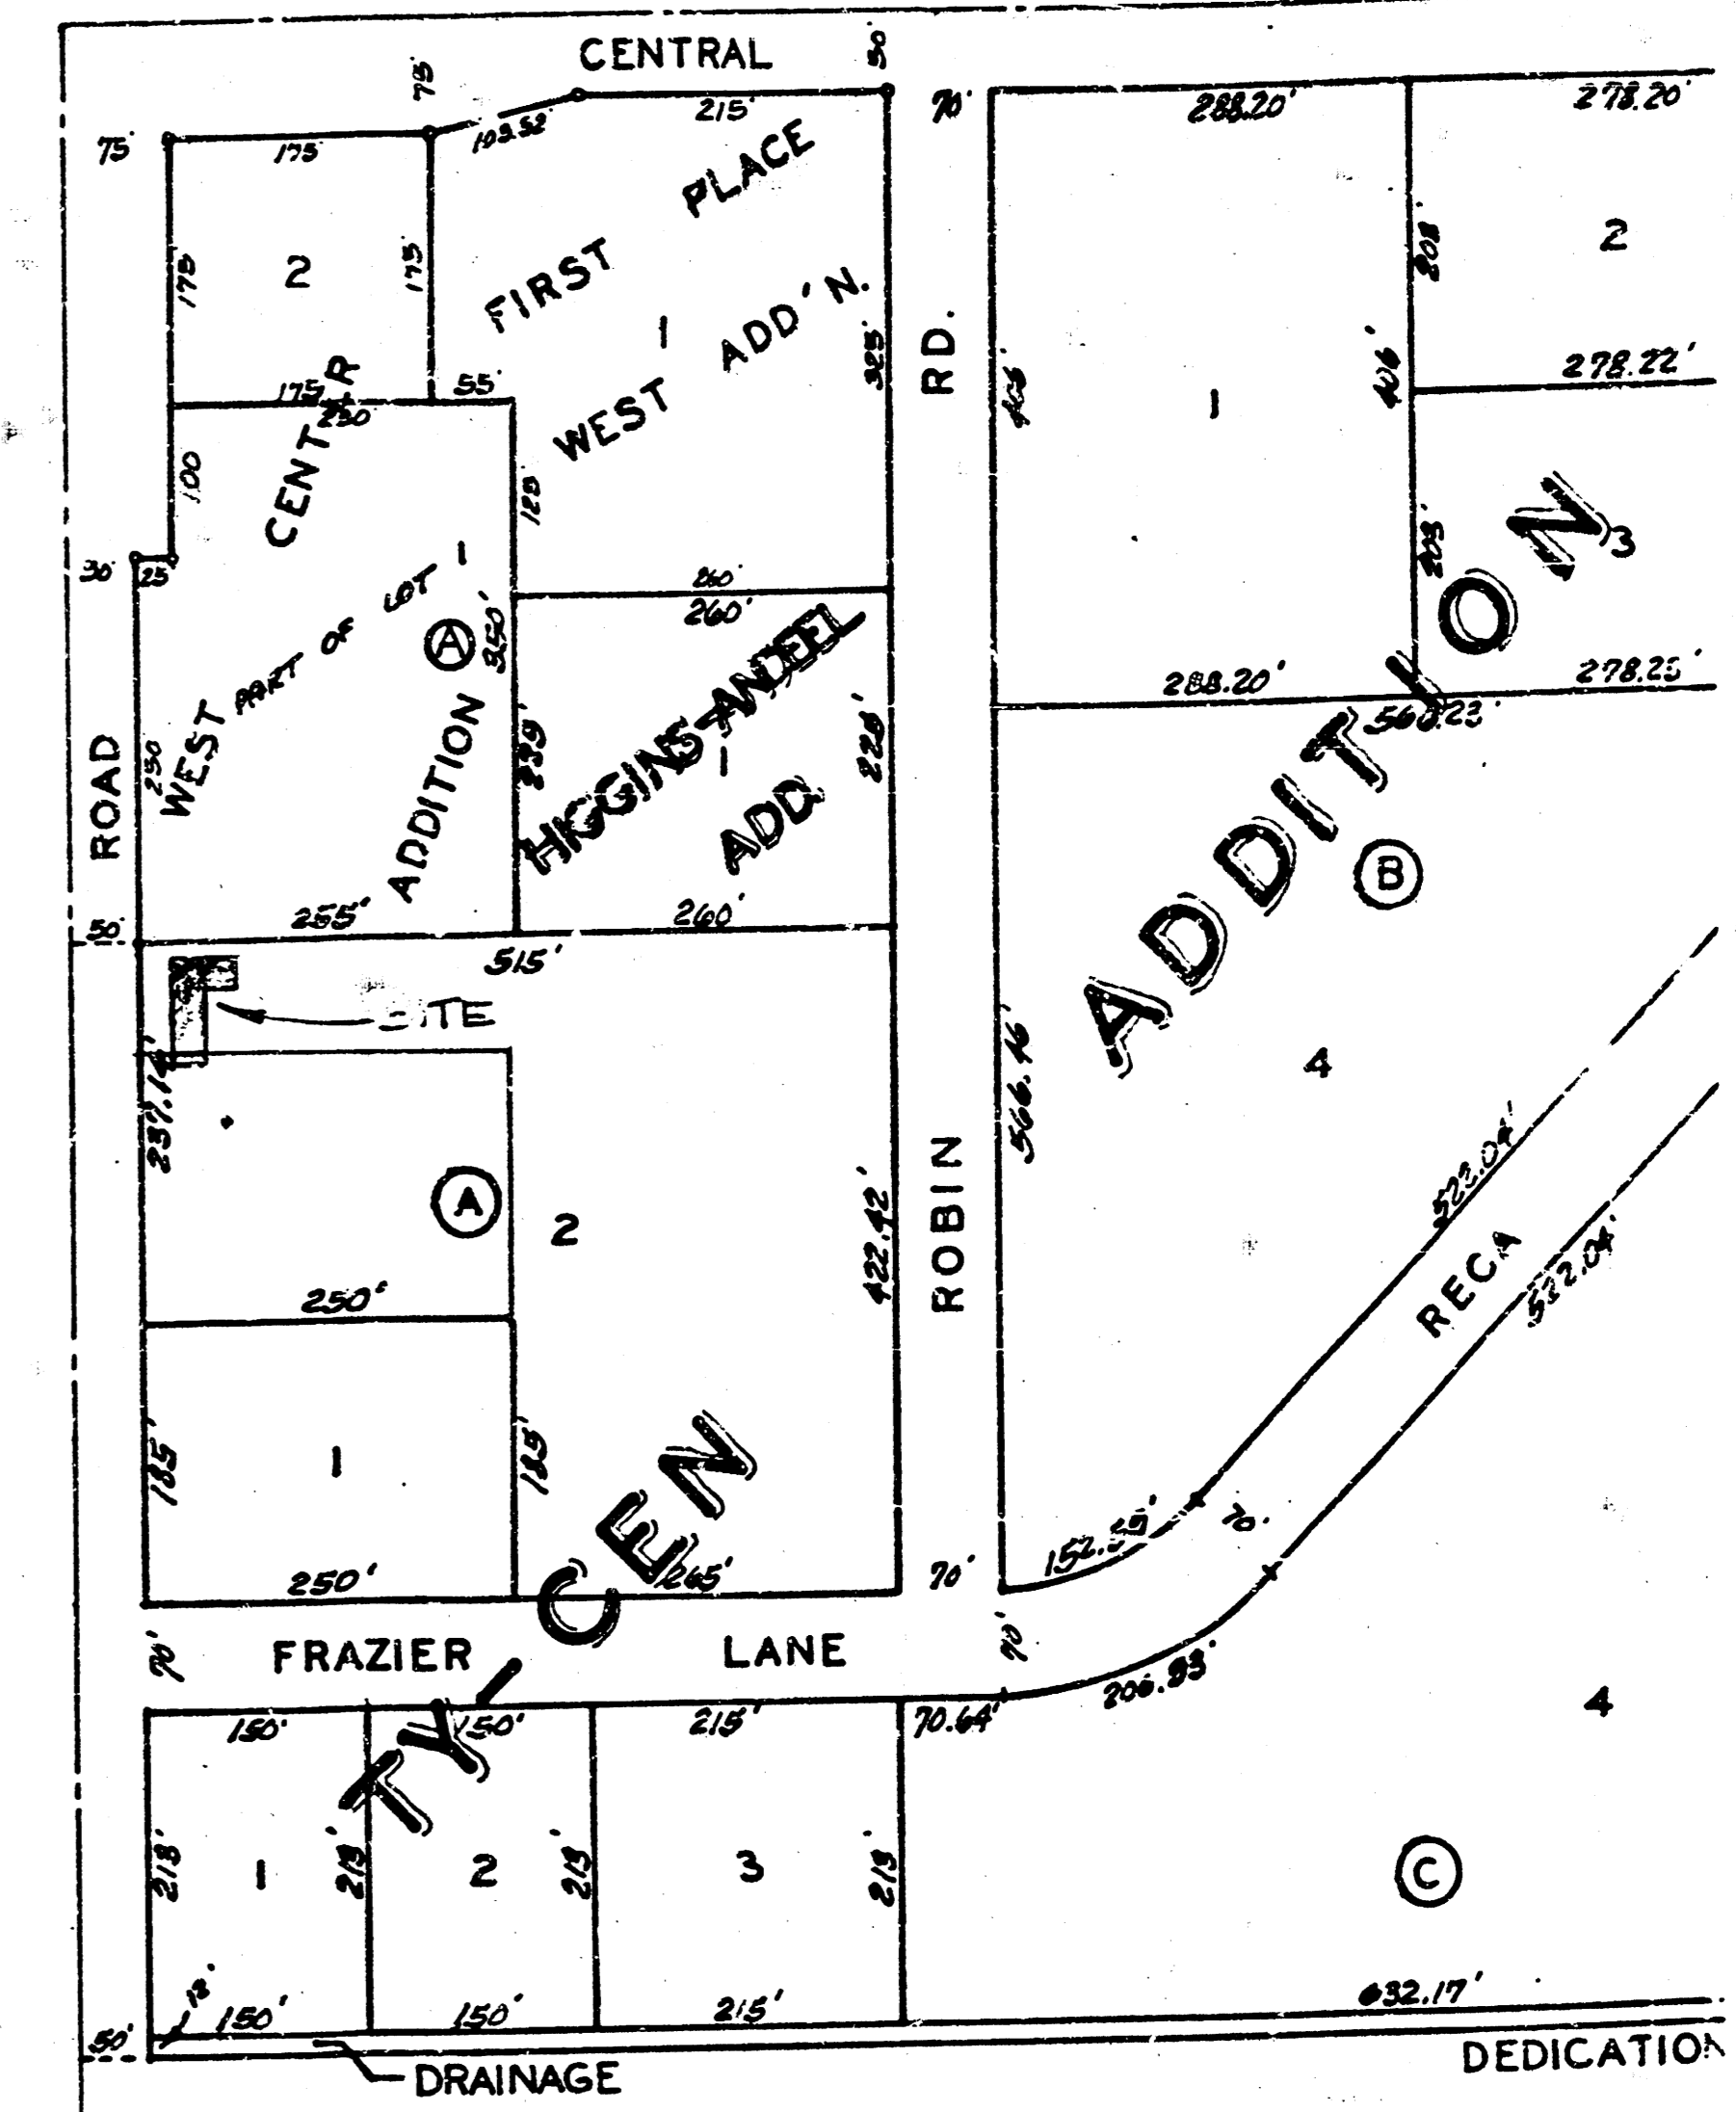


LOCATION MAP

PROFILE
 NOTED: REVISIONS
 DATE: 1-19-84

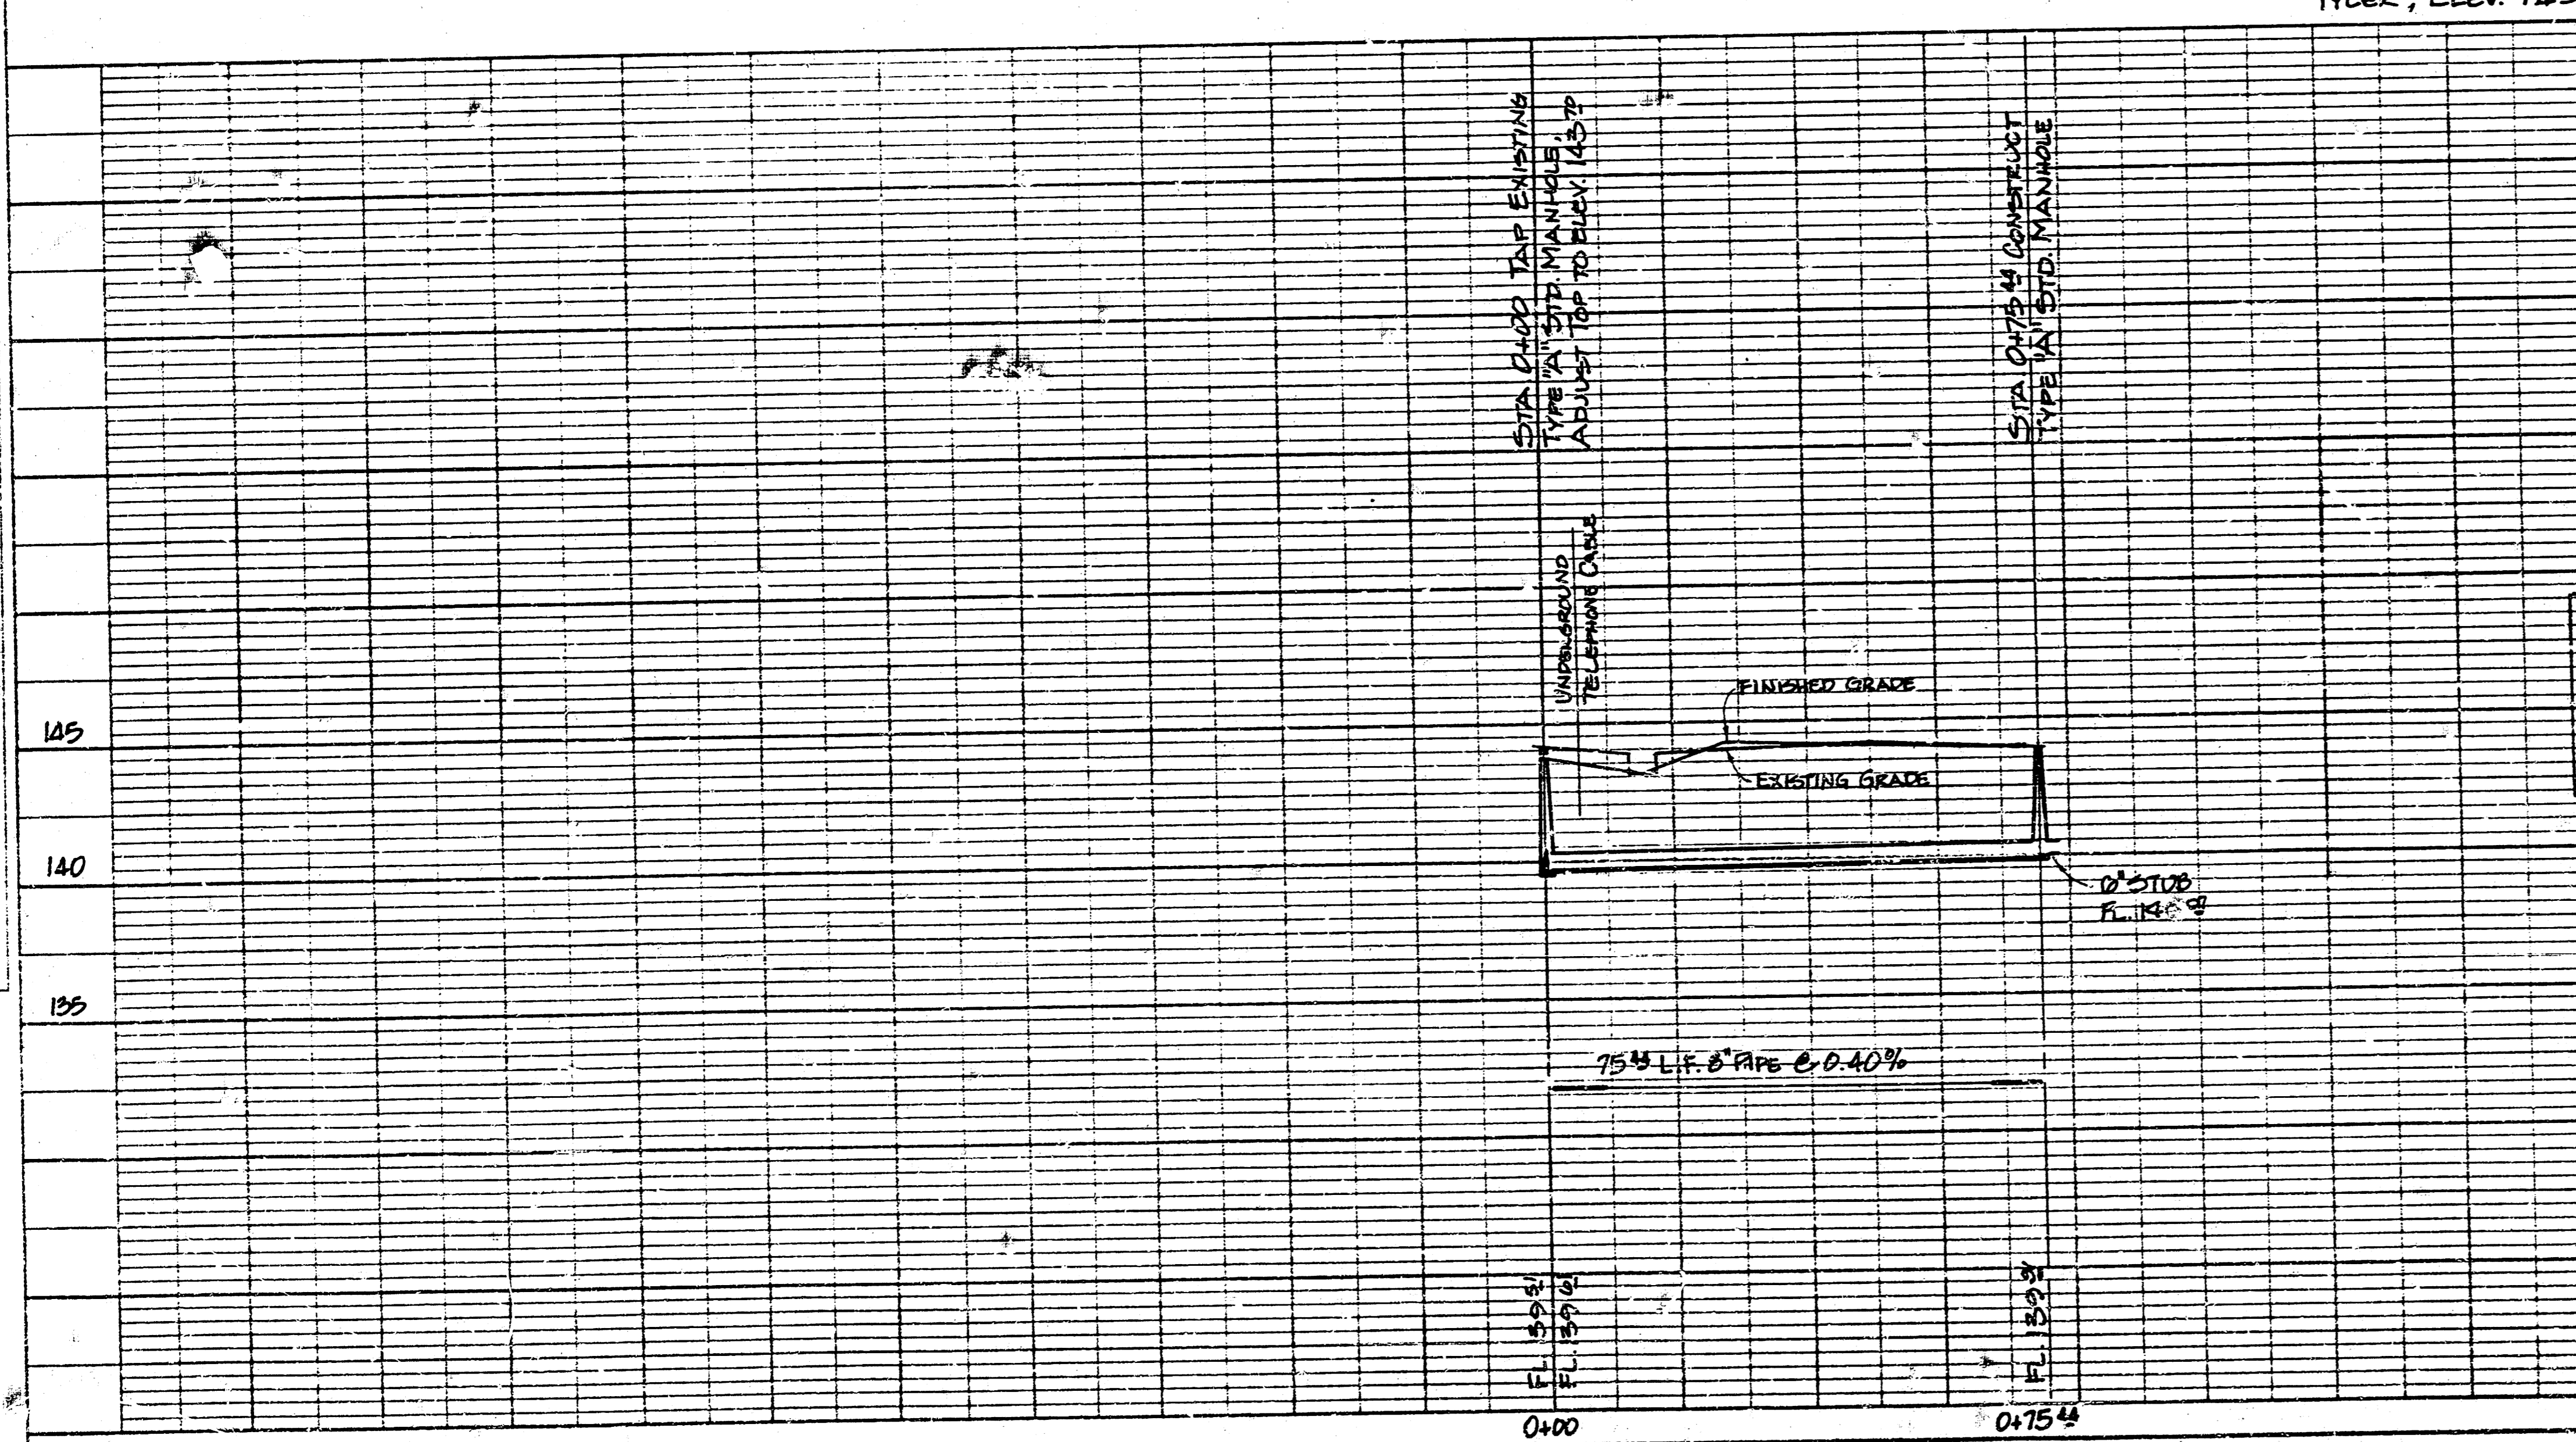

APPROVED AS NOTED
 By CITY ENGINEER OF WICHITA
 Sanitary Sewers: *[Signature]*
 Storm Sewers: _____
 Driveway Approaches: _____

NOTE TO CONTRACTOR
 This project will be constructed under
 the supervision of the CITY ENGINEER
 and conform to the SPECIFICATIONS
 of the CITY OF WICHITA, Inc. CON-
 TRACTOR shall be responsible for the City of Wichita
 for all costs of inspection.

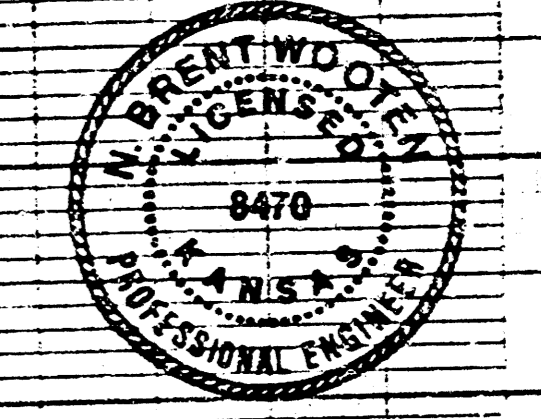

DATE: 1-19-84

SANITARY SEWER EXTENSION
 To Part of Lot 2, Block A, Ty-
 Cen Addition, Wichita, Kansas

Private Project no.
 458-76-245-80000-000-008

BAUGHMAN COMPANY, P.A.
 SURVEYING & ENGINEERING
 316/263-2721 • 300 LAURA • WICHITA, KANSAS 67211

FILMED FROM THE BEST
 AVAILABLE COPY.....