

SANITARY SEWER IMPROVEMENTS TO SERVE LOT 1 TYLER ACRES SIXTH ADDITION

Project Number
836 PPS (S07861)

CITY OF WICHITA, KANSAS
Michael E. Lindebak, P. E., City Engineer

GENERAL NOTES

- Contractor will be required to provide notice to utility companies a minimum of twenty-four (24) hours prior to any excavation, as follows:

Kansas One-Call	687-2470
Cablevision	262-4270
or	263-2061
K.P.L. Gas Service Company	383-9650
Kansas Gas & Electric Company	383-9600
Arkla Gas Company	942-8350
Southwestern Bell Telephone Company	1-571-2611
City of Wichita Water Department	268-4908
City of Wichita Sewer Department	268-4071
- Exist. utilities and their locations, as shown on the plans, represent the best information obtainable for design. Location information has been obtained from the various utility companies and is either from company record drawings or company-provided field locations. The Contractor will be required to work around existing utilities which do not conflict with proposed construction.
- The Contractor to verify utility locations prior to construction of this project.
- Utility service and installation shall be coordinated with the respective utility owners. Contacts are:


KG&E Gas	Steve Orth	261-6867
K.C. & E.	Miles Capps	261-6434
Wichita Water	Chuck Steven	268-4555
	Joe Bottinelly	268-4908
Southwestern Bell	Jim Tobin	268-2759

BENCHMARK


Top of East MH
Elev. = 153.29 (City Datum)

AS-BUILT

Date: 7/29/98
Signed: [Signature]

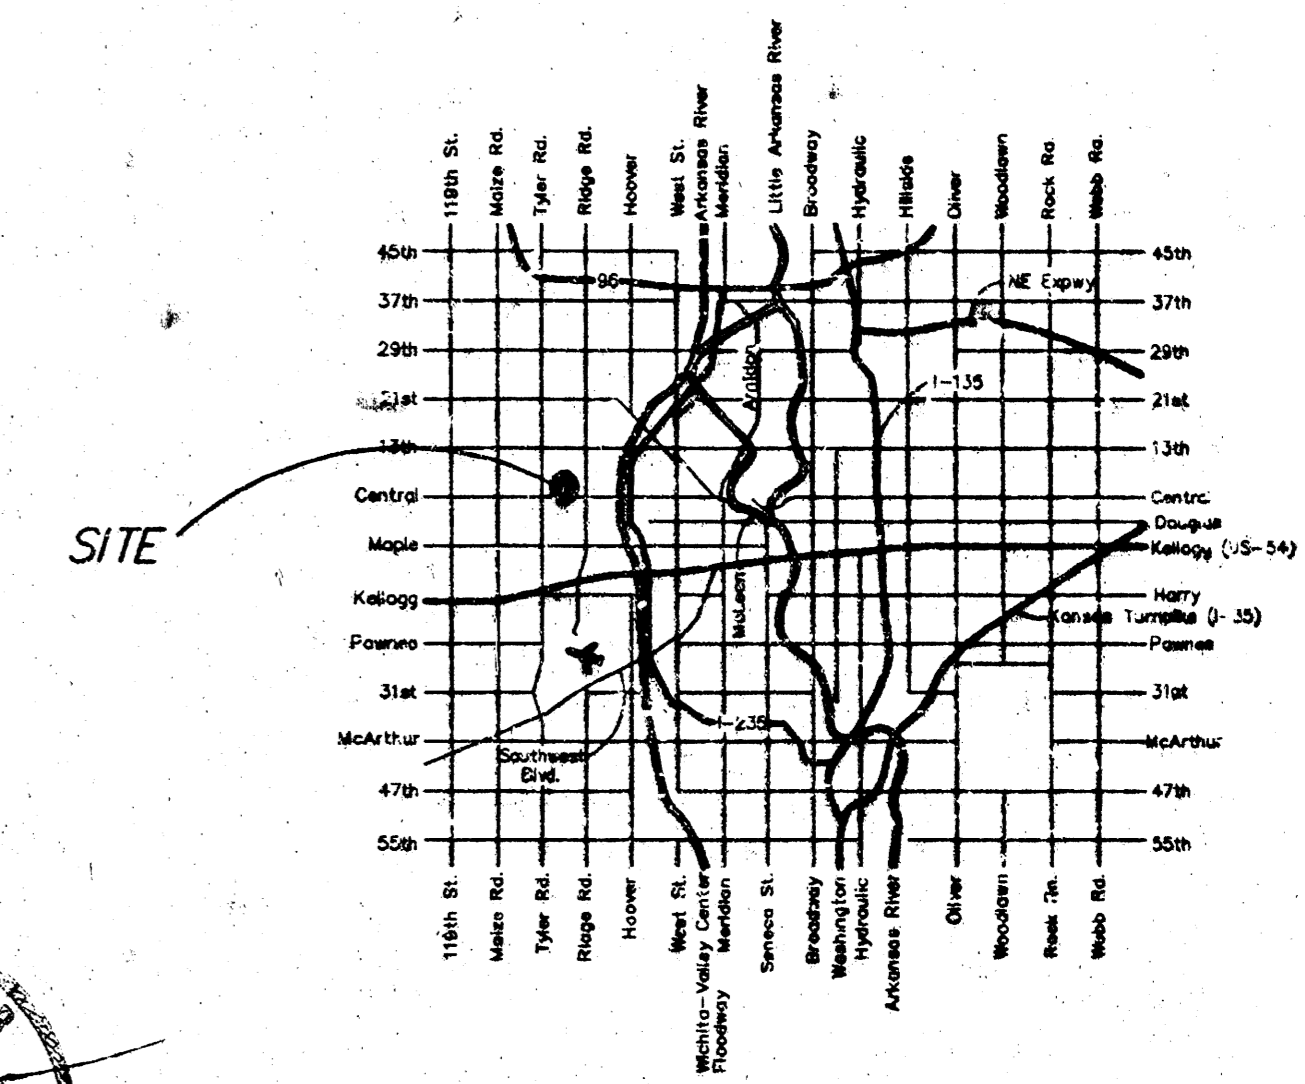

LOCATION MAP

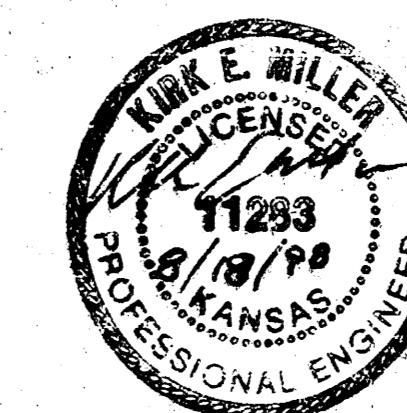

APPROVED AS NOTED BY CITY ENGINEER OF WICHITA
 SANITARY SEWERS VRH 8/18/98
 Inspection and testing for this project are to be provided by a Licensed Consulting Engineering Firm under contract with the Owner/Developer. Said inspection is to be in accordance with the City of Wichita standard construction engineering practices and certified by a Licensed Professional Engineer. No work shall be performed in dedicated easements or public right-of-way by the Contractor without such inspection nor shall work be commenced without written authorization by the City Engineer. All construction and materials shall comply with the City of Wichita Specifications and Standards (on file and available in the City Engineer's Office).

Booked
10/16/98
I-257
RCL

	PROJECT NUMBER				AM NO.	TYLER ACRES SIXTH ADDITION		SHEET
	DESIGN	DRAWN	FILE	DATE	98119	SS LINE		
	JG	JG	PLAN	8/10/98		WICHITA, KS		OF
								1