


VETERANS ADMINISTRATION  
 WASHINGTON, D. C.  
 APPROVED: *Frank D. Hines*  
 ADMINISTRATOR  
 ASSISTANT ADMINISTRATOR  
 DIRECTOR OF CONSTRUCTION  
 CIVIL ENGINEER

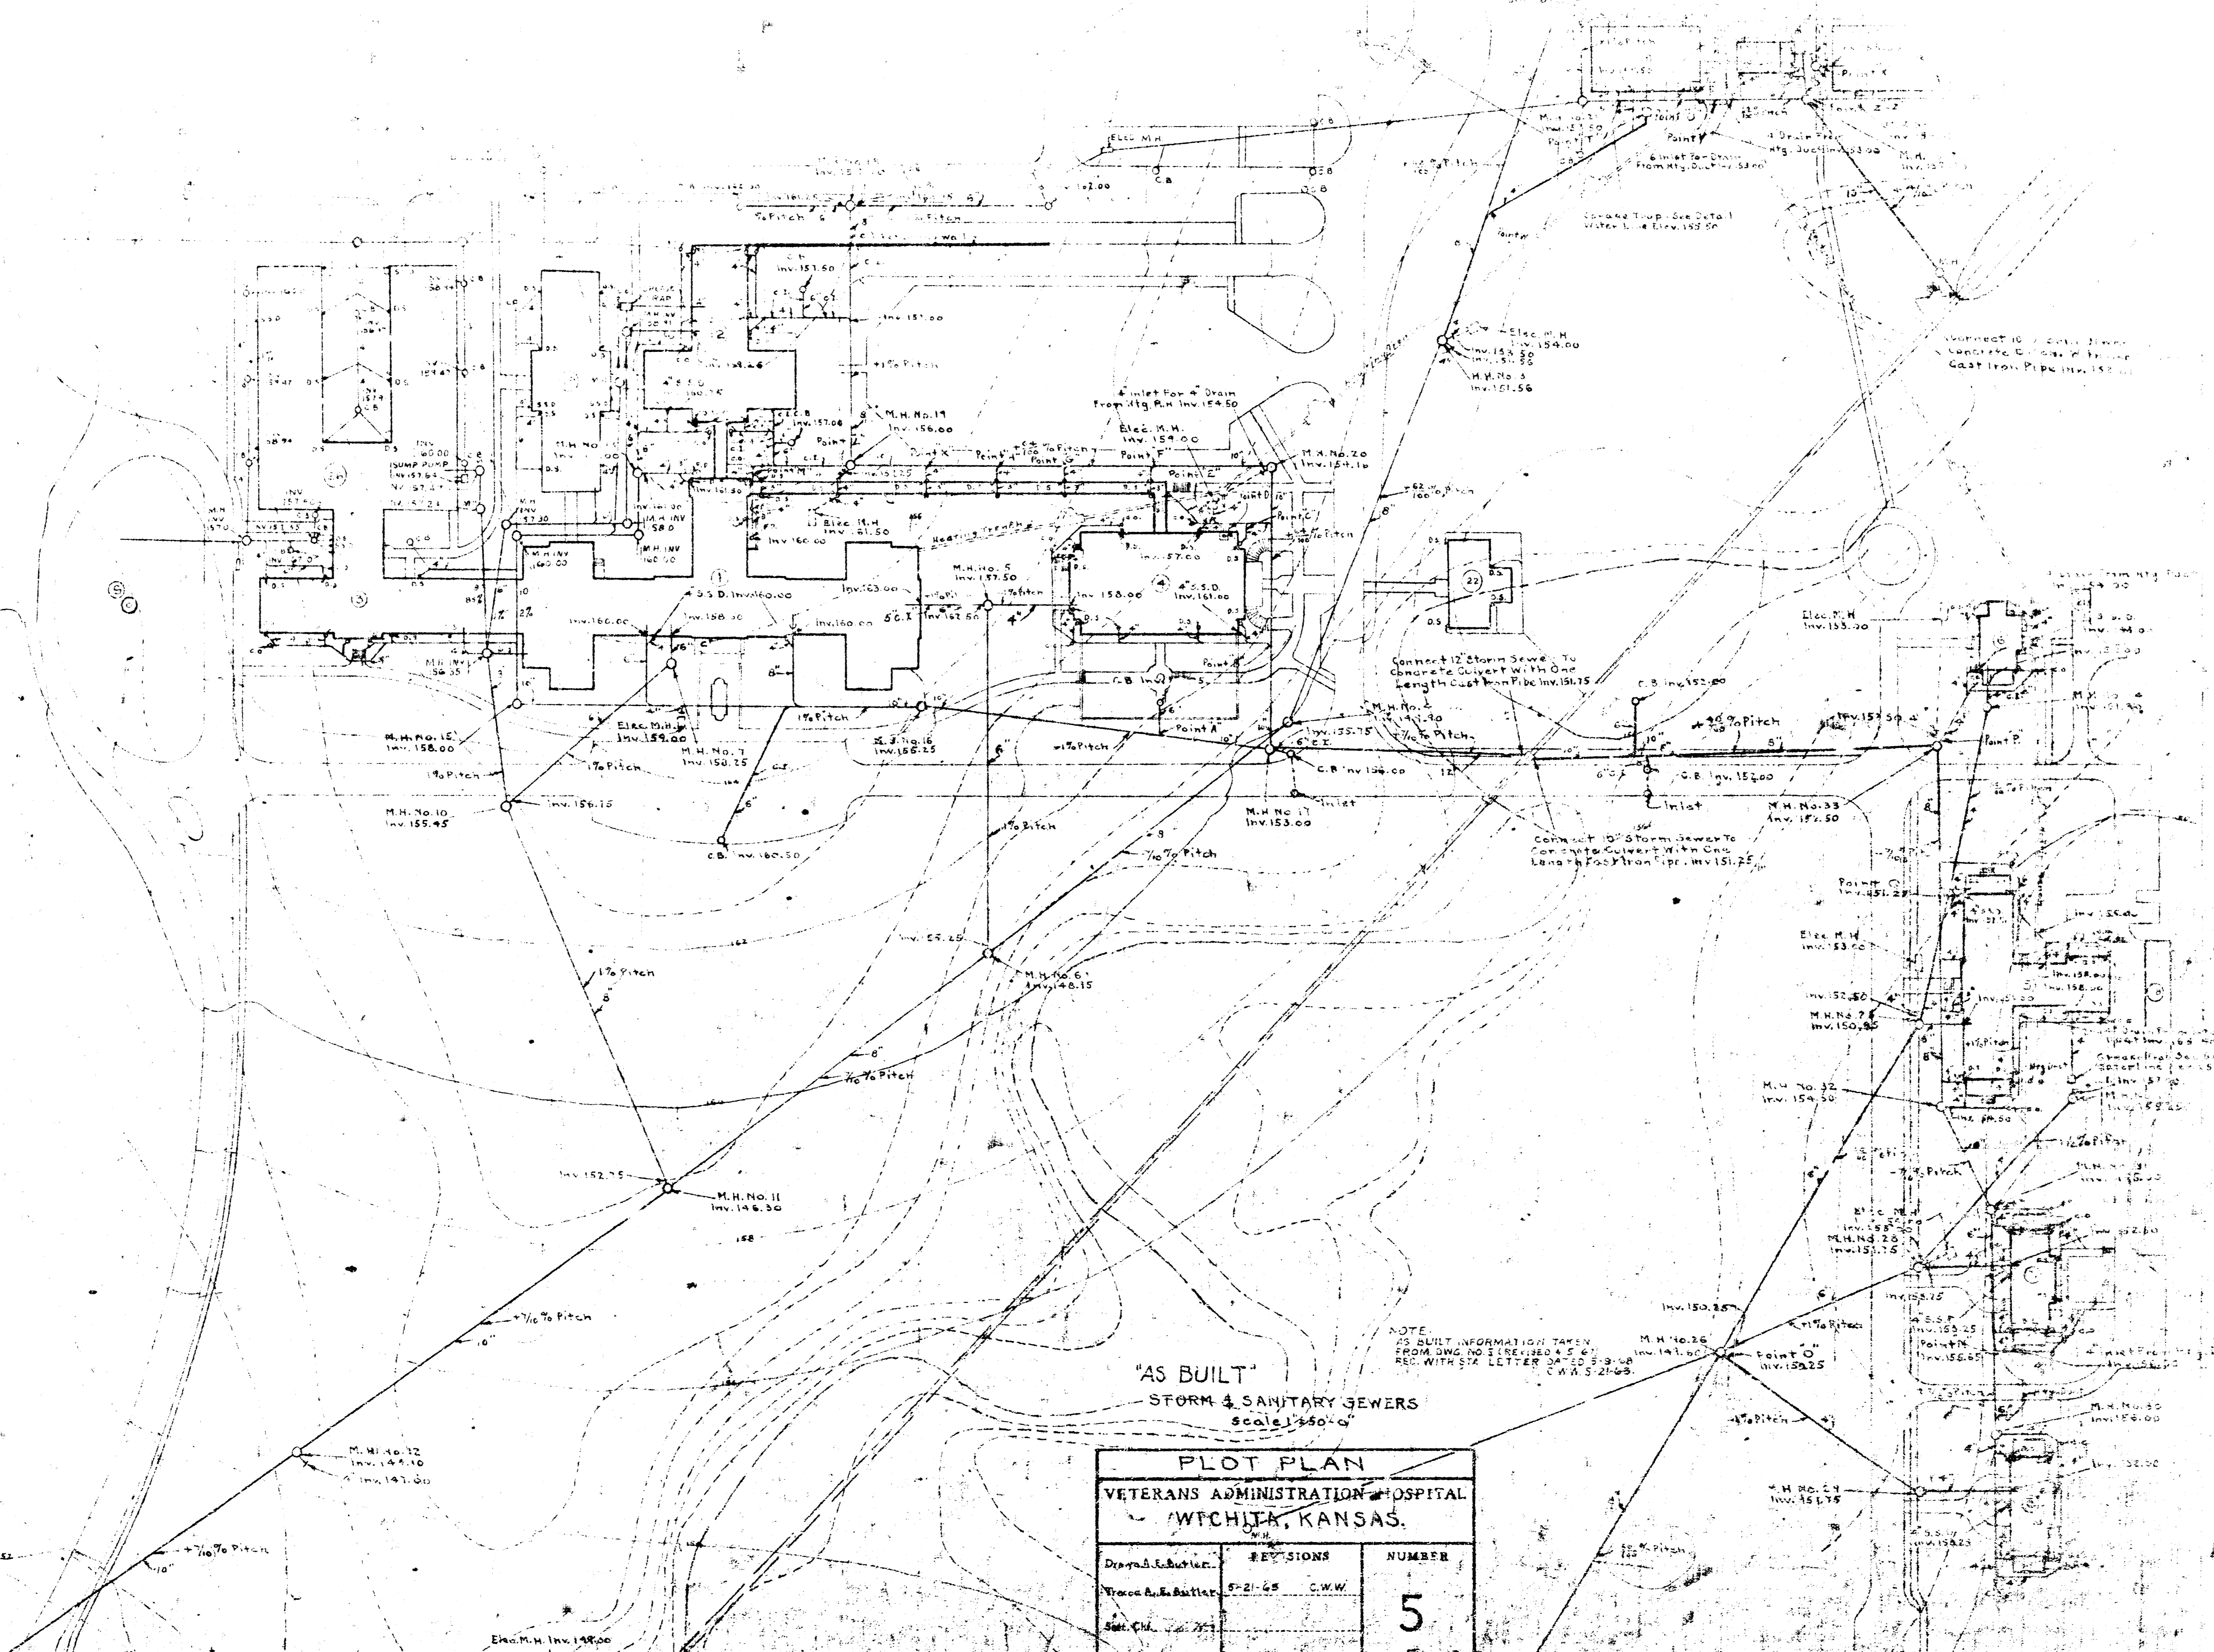

'AS BUILT'  
 STORM & SANITARY SEWERS  
 Scale 1/4\"/>


PLOT PLAN		
VETERANS ADMINISTRATION HOSPITAL WICHITA, KANSAS.		
Drawn & Checked	REVISIONS	NUMBER
Trace & E. Butler	2-21-65 C.W.W.	5
See C.H. 2-21-65		
Date: April 1965		SHEET 5 OF 13

NOTE: AS BUILT INFORMATION TAKEN FROM DWG. NO. 1 REVISED 4-5-65. REC. WITH STR. LETTER DATED 5-9-65. C.W.A.S. 21-65.

CONNECT NEW STORM & SANITARY SEWERS TO EXISTING PLACE

REMOVE LOCATIONS OF MANHOLES SHOWN IN PLACE

CONNECT NEW STORM & SANITARY SEWERS TO EXISTING PLACE

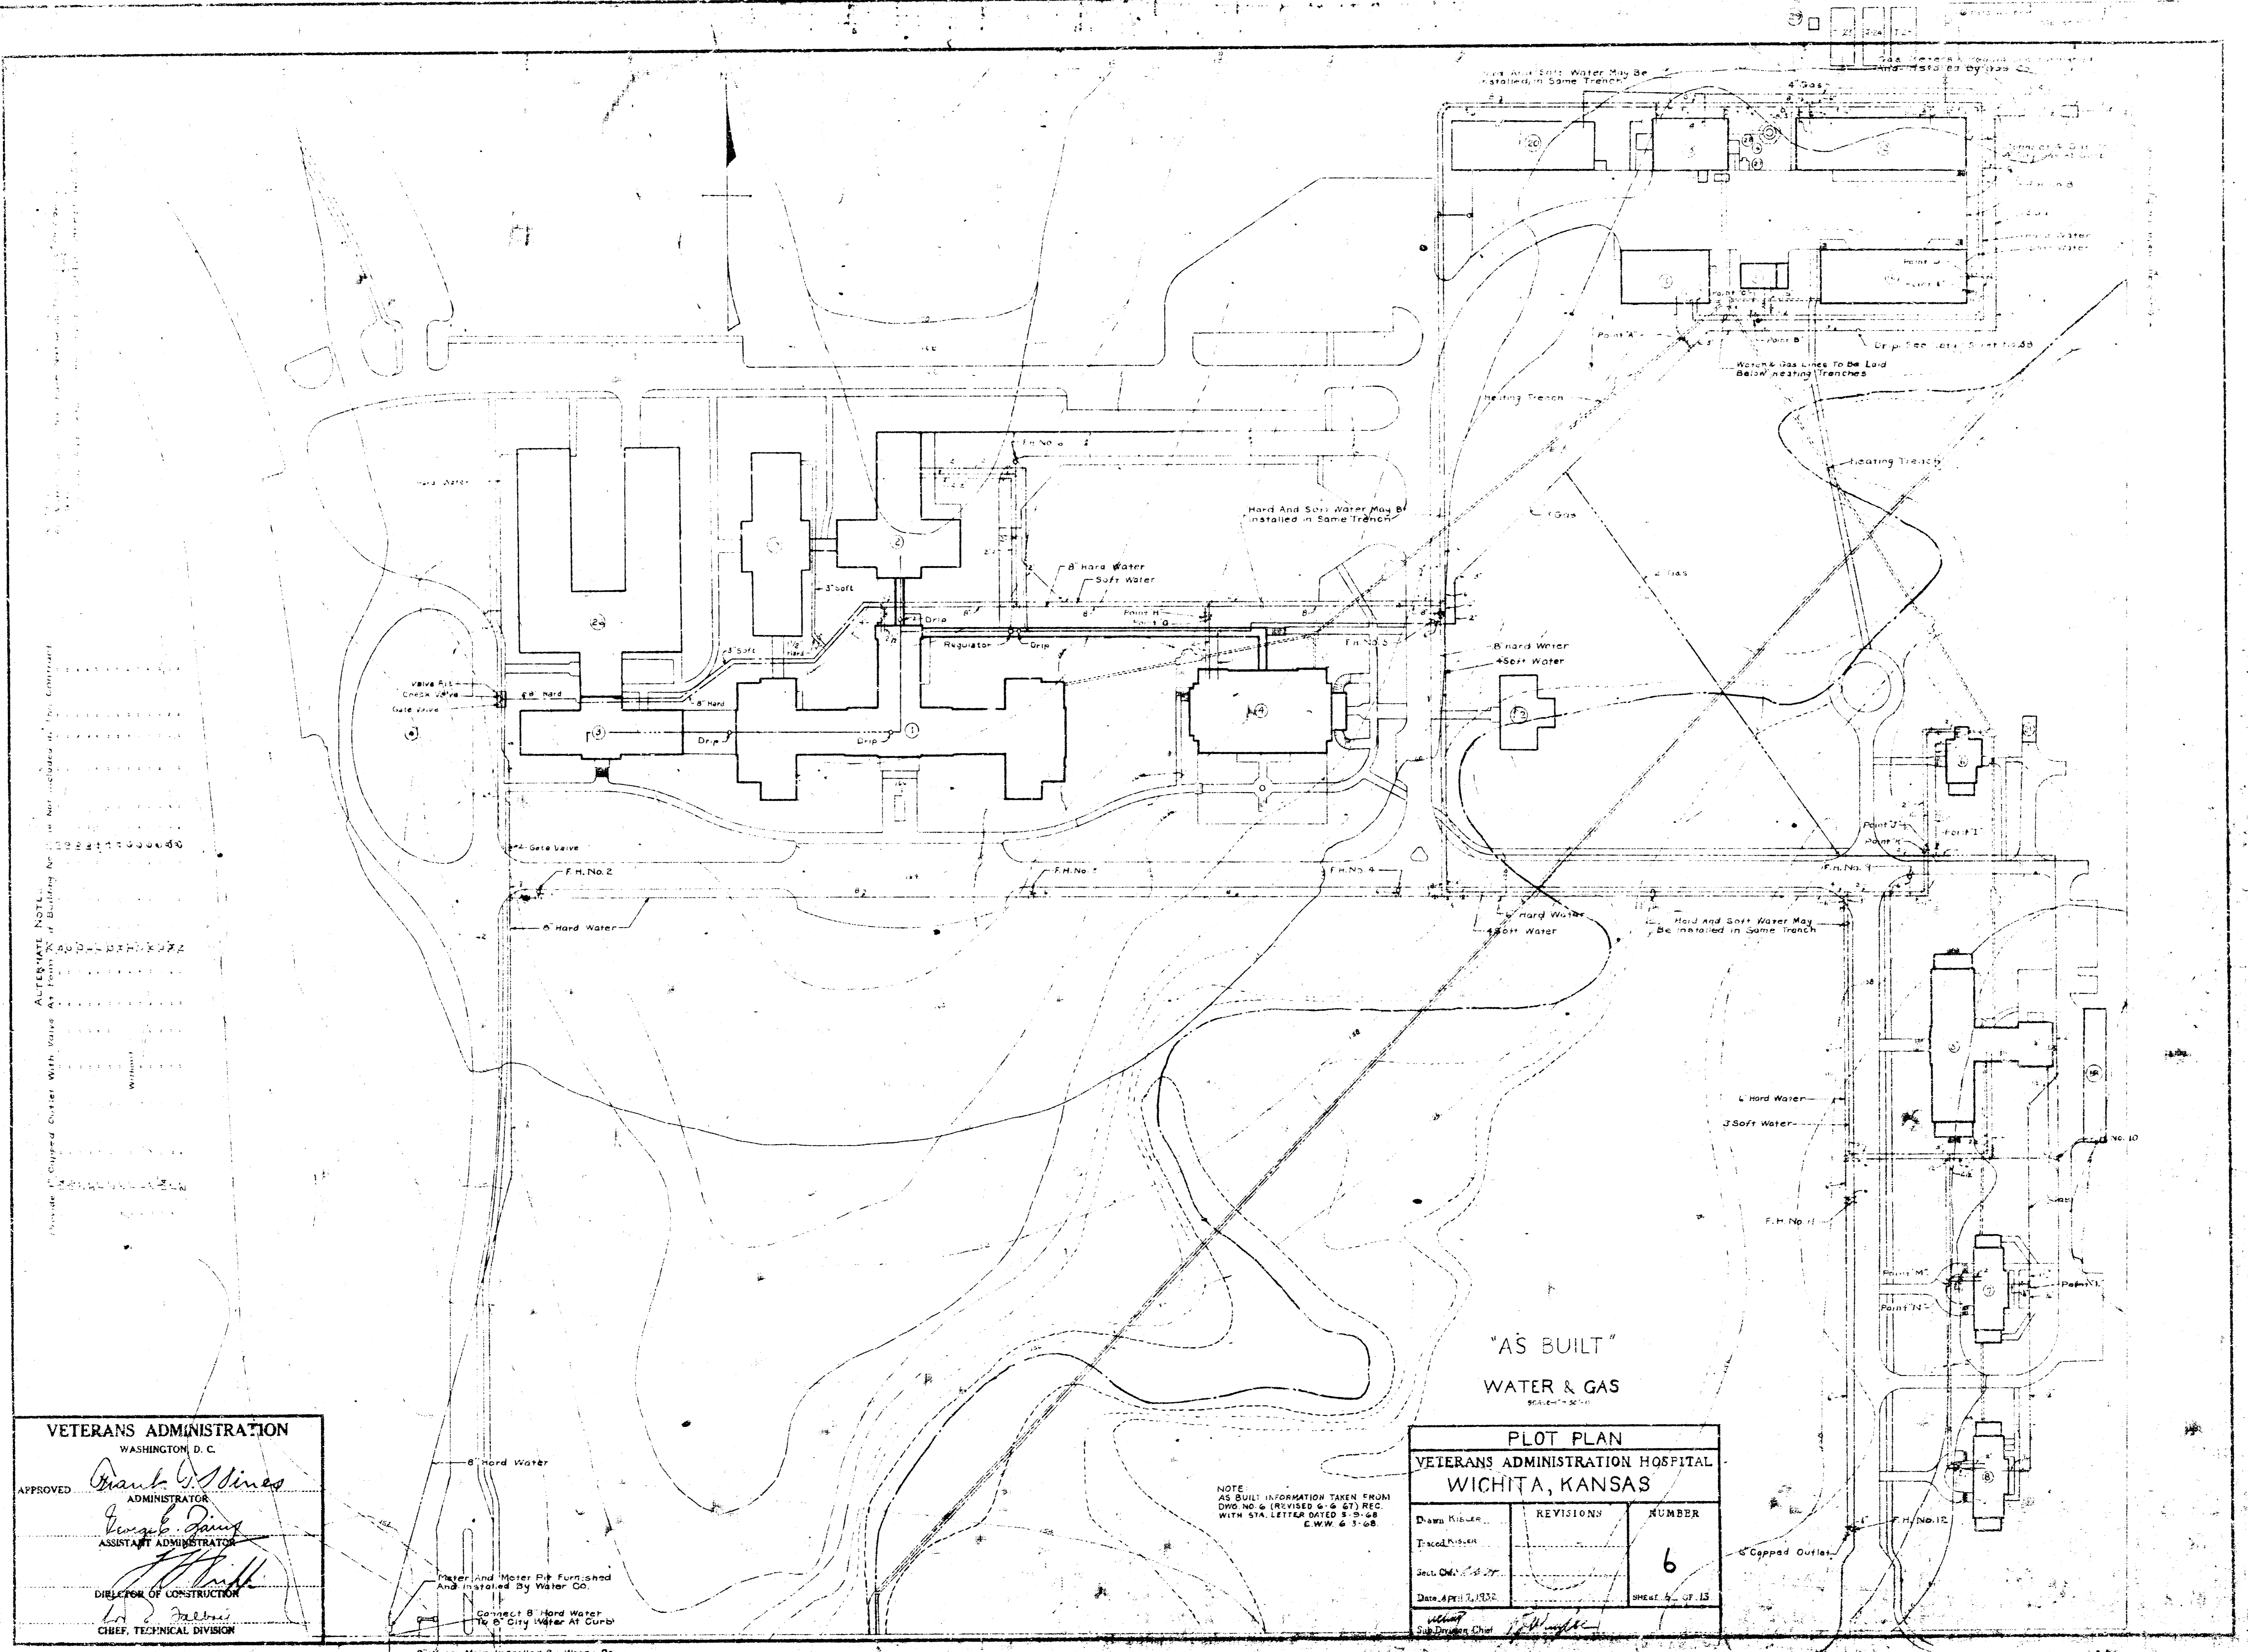

ALTERNATE NOTE:  
 Provide if Capped Outlet With Valve At Point X of Building As Shown on Drawing No. 100-111-1000-1000  
 Without

VETERANS ADMINISTRATION  
 WASHINGTON, D. C.  
 APPROVED: *Frank G. Hines*  
 ADMINISTRATOR  
*George B. Jones*  
 ASSISTANT ADMINISTRATOR  
*[Signature]*  
 DIRECTOR OF CONSTRUCTION  
*[Signature]*  
 CHIEF, TECHNICAL DIVISION

Water and Meter Pit Furnished and Installed by Water Co.  
 Connect 8\"/>

NOTE:  
 AS BUILT INFORMATION TAKEN FROM  
 DWG. NO. 100-111-1000-1000  
 WITH STA. LETTER DATED 3-9-58  
 C.W.W. 6 3-58

**"AS BUILT"**  
**WATER & GAS**

**PLOT PLAN**  
**VETERANS ADMINISTRATION HOSPITAL**  
**WICHITA, KANSAS**

Drawn By	REVISIONS	NUMBER
Frank G. Hines		6
Set. Chf. [Signature]		
Date April 2, 1952		SHEET 6 OF 15
Sub-Division Chief [Signature]		

FILE FOLDER NO.