

RESOURCE LIST

GAS CO.
KANSAS GAS & ELECTRIC
JIM STULTZ, P.E.
1021 EAST 26TH STREET NORTH
WICHITA, KANSAS 67219
PH: (316) 832-3122


ELECTRIC
K&E (WESTAR ENERGY)
SHANE PRICE
1800 E. CENTRAL
WICHITA, KANSAS 67201
PH: (316) 261-6685

SANITARY SEWER
CITY OF WICHITA ENGINEERING
VICKY HUANG, P.E.
455 N. MAIN (7TH FLOOR)
WICHITA, KANSAS 67202
PH: (316) 268-4236

WATER
CITY OF WICHITA WATER & SEWER DEPT.
JILL PERKINS
455 N. MAIN (8TH FLOOR)
WICHITA, KANSAS 67202
PH: (316) 268-4555

CITY OF WICHITA ENGINEERING
JULIA KALMAN, P.E.
455 N. MAIN (7TH FLOOR)
WICHITA, KANSAS 67202
PH: (316) 268-4632

TELEPHONE
SWBT
GREG SHARPE
154 NORTH BROADWAY, ROOM 480
WICHITA, KANSAS 67202
PH: (316) 268-2245

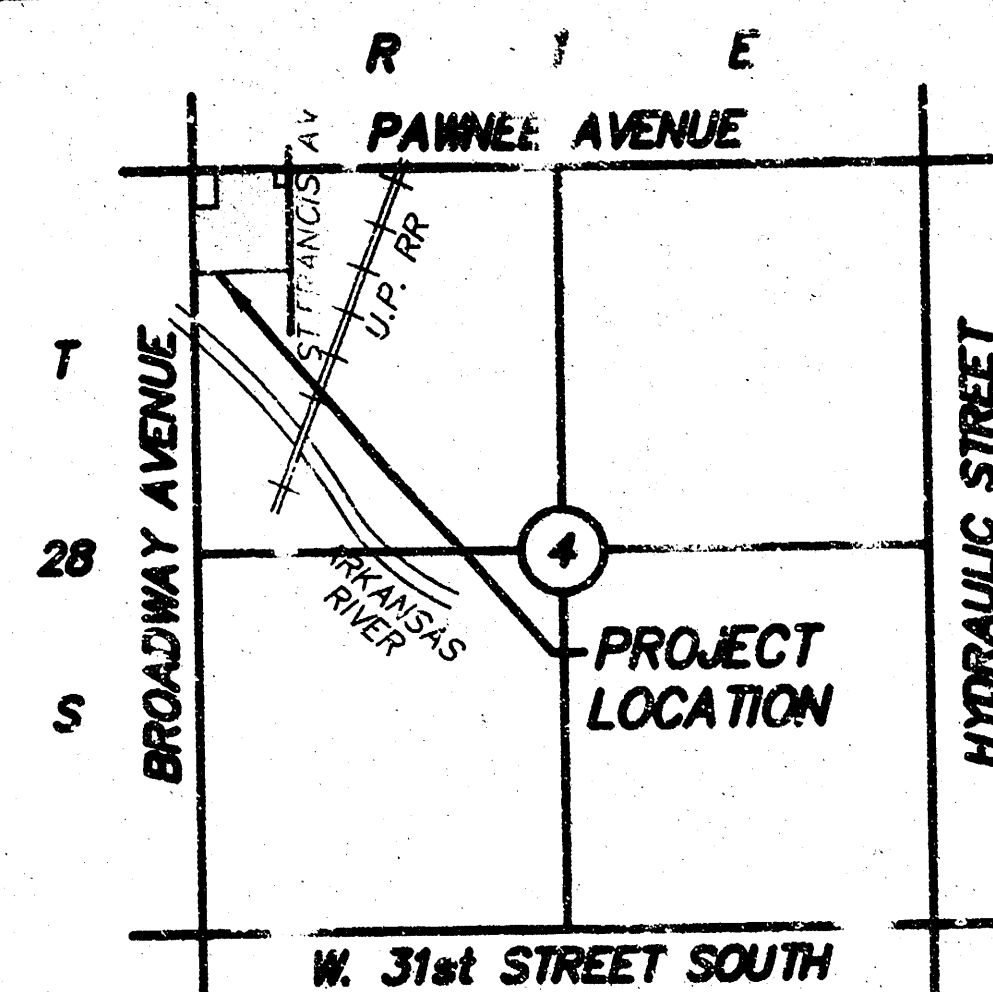

LOCATION MAP
NOT TO SCALE

SANITARY SEWER PLAN WAL-MART

SUPERCENTER #1099-01

LOT 1

PUBLIC PROJECT NUMBER 1362PPS (607861)


CITY OF WICHITA, KANSAS

NEIL D. CABLE, P.E. CITY ENGINEER

MONTH 2003

SHEET INDEX

- SS-1 TITLE SHEET
- SS-2 SANITARY SEWER PLAN & PROFILE
- SS-3 SANITARY SEWER PLAN & PROFILE
- SS-4 MISCELLANEOUS CITY SANITARY SEWER DETAILS
- SS-5 MISCELLANEOUS SANITARY SEWER DETAILS

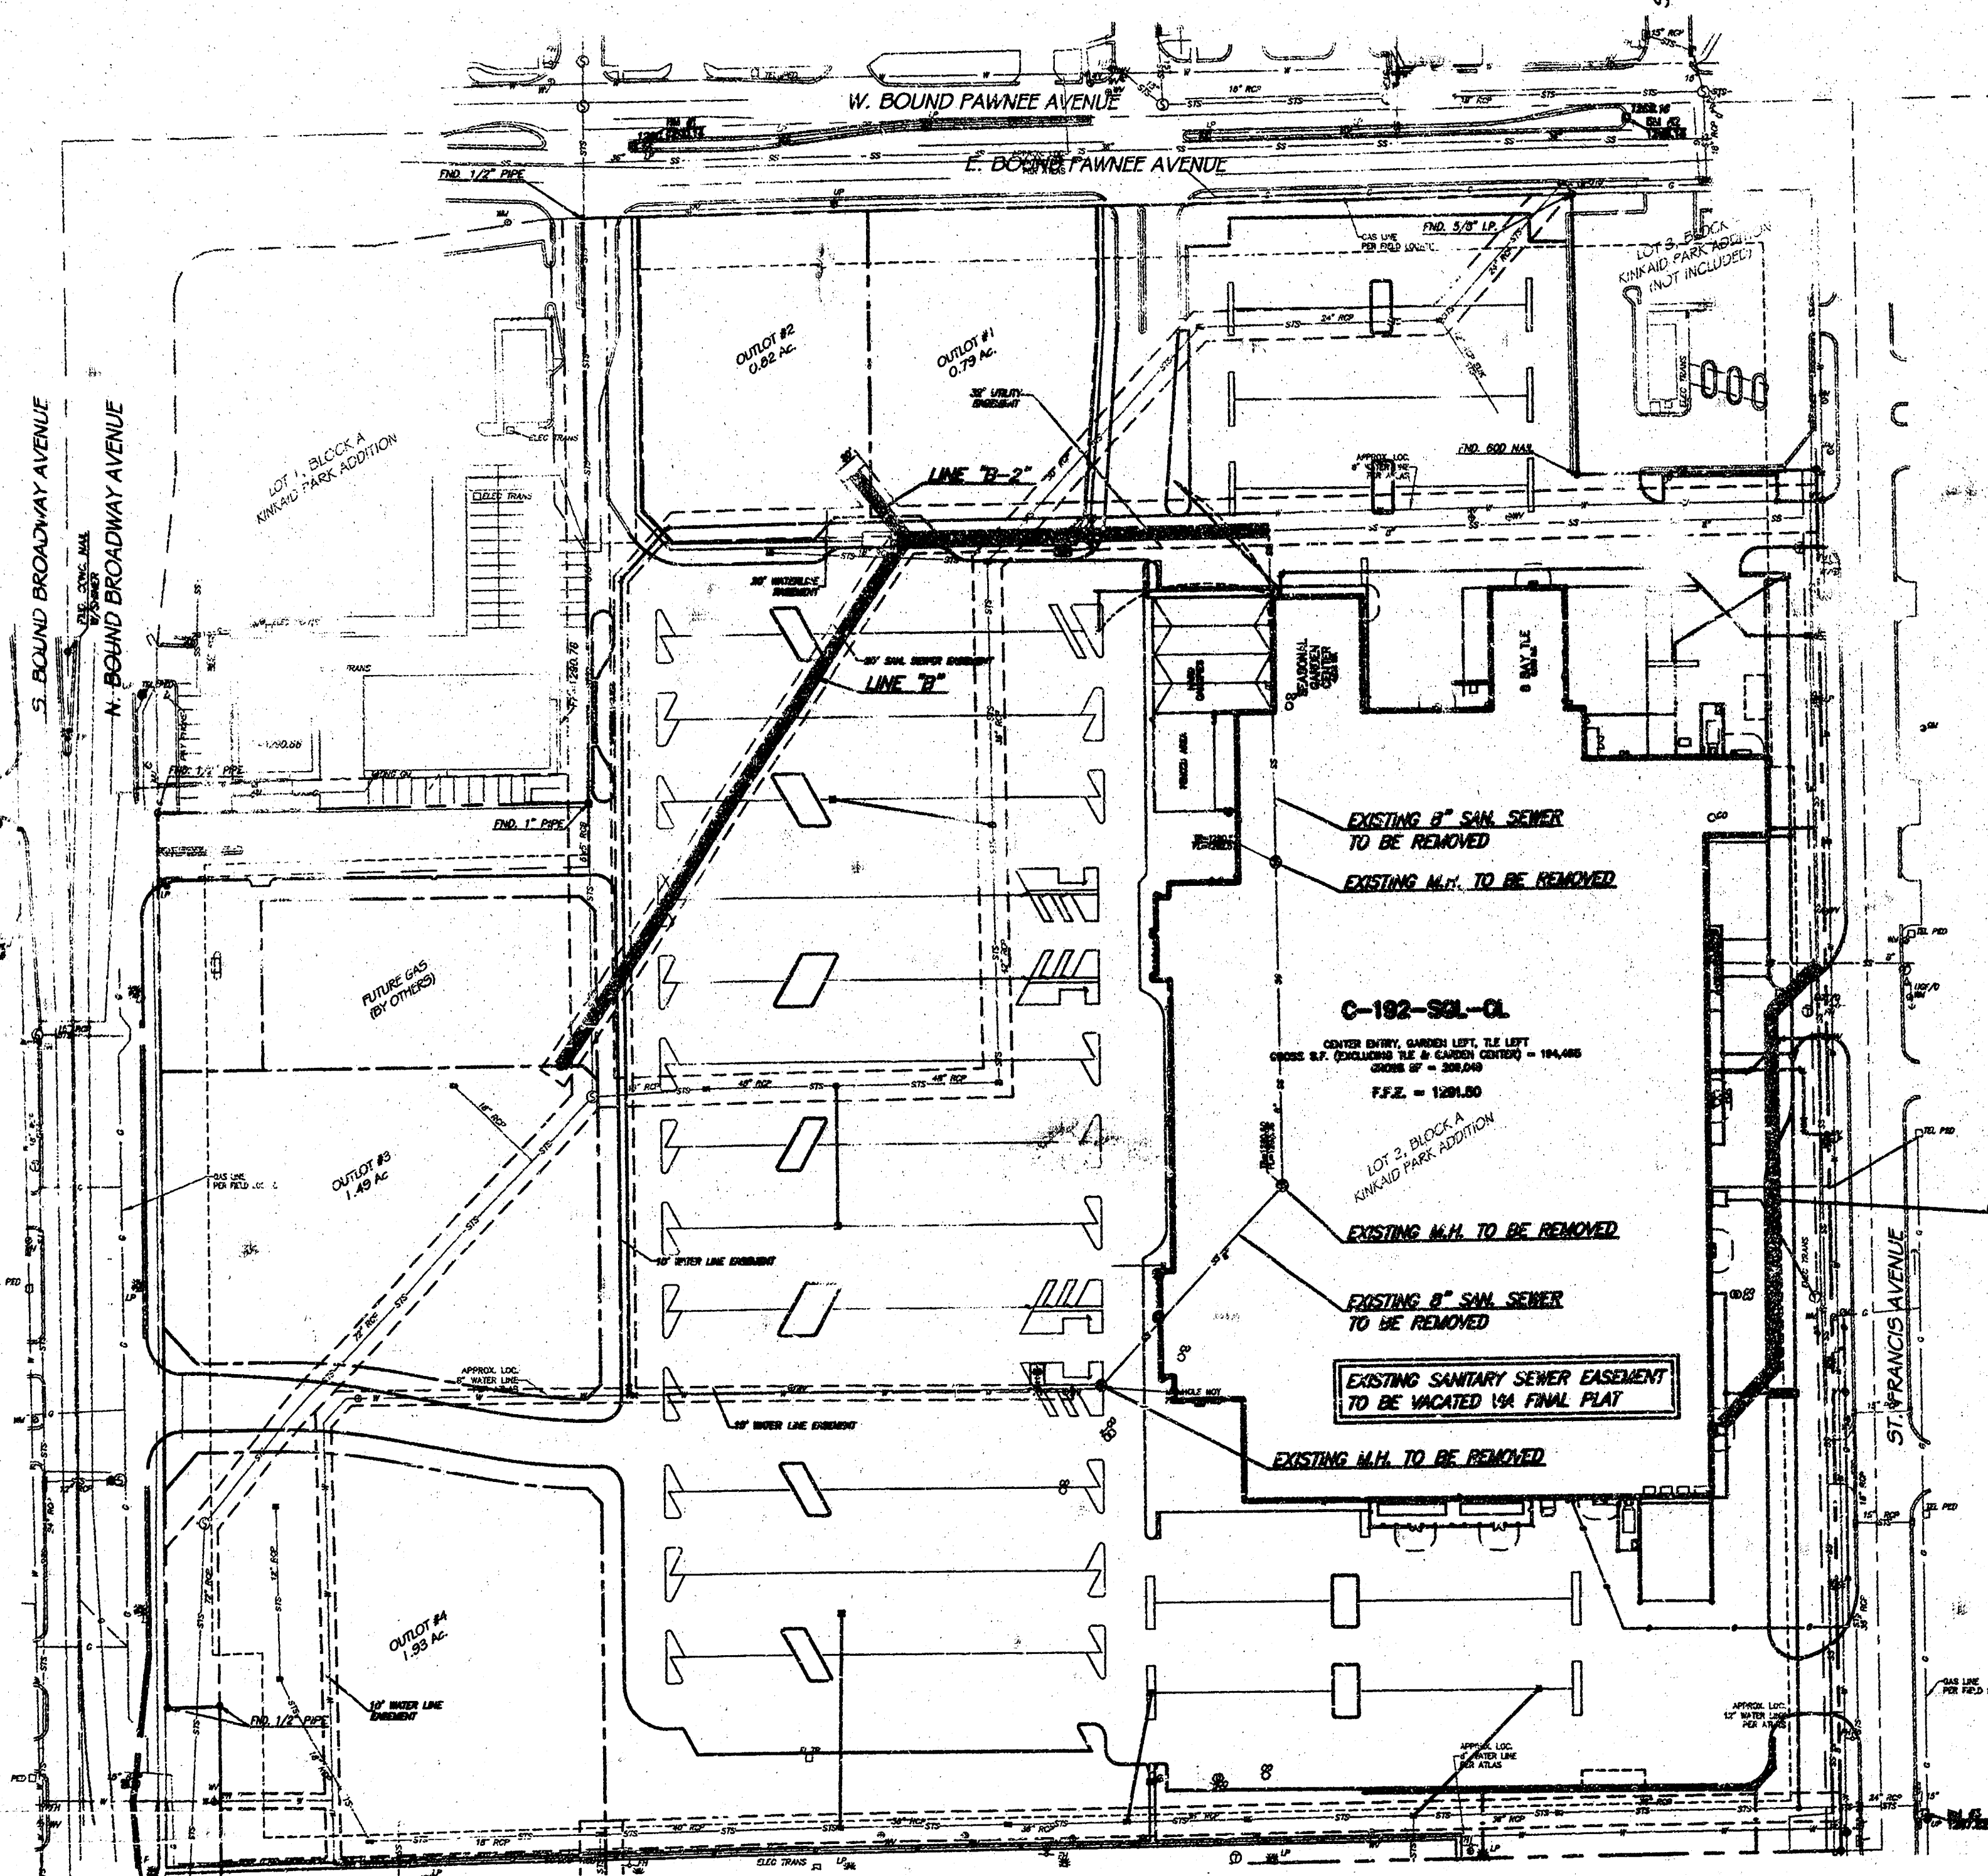

Legal Description

A tract of land lying in the Northwest Quarter (NW/4) of Section Four (4), Township Twenty-eight (28) South, Range One (1) East of the 6th P.M., also being a part of the recorded plat of KINKAID PARK, an addition to Wichita, Sedgwick County, Kansas, being more particularly described as follows:
Lot Two (2), Block A, KINKAID PARK, an addition to Wichita, Sedgwick County, Kansas.
Said tract contains a mathematical error of closure of 1:94,592,190.
Said tract contains 1,180,290 square feet or 27.0957 acres more or less.

General Notes

1. Contractor will be required to provide notice to utility companies a minimum of forty-eight (48) hours prior to any excavation, as follows:
Kansas One-Call 687-2470
The Contractor must notify the following in case of an emergency:
Cox Communications 262-0661
Kansas Gas Service Company 381-8000
Kansas Gas & Electric Company 381-8000
PacifiCorp Gas Company 1-800-303-0357
Southwestern Bell Telephone Company 1-800-370-5380
City of Wichita Water Department 268-4900
City of Wichita Sewer Department 268-4071
2. All water mains and appurtenances shall be installed in accordance with City of Wichita, Kansas Standards Specifications for Water Main Installations No. 14533.
3. Opening and closing of water valves shall be done slowly to prevent damage to the water distribution system from water hammer. All valves closed by the contractor must be reopened as new construction permits. Project Inspector must certify that any valve closed by the contractor is reopened. Contractor will be permitted to operate water valves only when the project Inspector assigned to the project is present.
4. All disturbed R/W areas not intended for pavement or sidewalk construction shall be seeded with Kansas Premium Rescue Blend at a rate of 8 lb./1000 Sq. Ft., fertilized with a 16-0-0 ratio at a rate of 4 lb./1000 Sq. Ft., and mulched with Prairie Hay at a rate of 32 lb./1000 Sq. Ft. Mulch shall be "patted" with forks or punched into soil to reduce loss due to wind.
5. Utility service lines, poles, wire busses, meters, etc. are to be adjusted as necessary by others prior to construction unless the plans specifically call for their adjustment by the Contractor or unless the plans specifically identify a utility to be adjusted by its owner during construction. Existing utilities and their location, as shown on the plans represent the best information obtainable. The contractor shall be required to work around existing utilities within the right-of-way which do not conflict with proposed construction.
6. The water main shall be constructed on the alignment shown by the plans. Trees and shrubs which are in direct conflict with proposed new construction shall be removed by the Contractor with the Engineer's approval. Trees and shrubs which are not in direct conflict with proposed new construction shall be saved and protected from damage.
7. Contractor shall not start work on the project until the project Inspector is assigned to the project and is present on the site. Contractor shall not start on the project until all necessary bonds and permits have been obtained. Any work done without inspection will be required to be uncovered for inspection.
8. Rubble from the removal of miscellaneous structures and excess excavation which is to be wasted shall be disposed of on sites to be provided by the Contractor. These sites shall be approved by the Engineer as to suitability, appearance and site location. Locations that, in the opinion of the Engineer, will leave an unsightly appearance will not be approved. All disposed sites must be approved by the Kansas Dept. of Health and Environment. Material either stockpiled or disposed of in a flood plain would require additional archaeological investigations unless buried in a previously approved borrow location.

APPROVED AS NOTED
BY CITY ENGINEER OF WICHITA

Sanitary Sewer VRH 8/22/03

Sewer VRH 8/22/03

Driveway Approaches VRH 8/22/03

Water Mains VRH 8/22/03

Paving VRH 8/22/03

NOTE TO CONTRACTORS
Inspection and testing for this project are to be provided by a Licensed Consulting Engineering Firm under contract with the Owner/Developer. Said inspection shall be in accordance with the City of Wichita standard construction engineering practices and certified by a Licensed Professional Engineer. No work shall be performed in dedicated easements or public right-of-way by the Contractor without such inspection, nor shall any work be commenced without written authorization by the City Engineer.


BENCHMARKS

- BM #1 CUT "X" ON NOSE OF MEDIAN AT PAWNEE & TOPEKA
ELEV=1280.14
- BM #2 CUT "X" ON W. END MEDIAN CL. PARKWAY N. OF S.E. PROPERTY CORNER
ELEV=1280.18
- BM #3 R.R. SPIKE IN POWER POLE APR. 28 N. OF S.E. PROP. COR. ON E. SIDE ST. FRANCIS
ELEV=1287.52
- BM #4 CUT "X" ON TOP OF CURB @ S.E. BROADWAY & S. EXT. TO WAL-MART
ELEV=1280.08


CONTRACTOR:
NOWAK CONST.CO.
200 S. GODDARD RD.
GODDARD, KS. 67052

AS-BUILTS SEPT. 2004

SANITARY SEWER PLAN			
WAL-MART SUPERCENTER #1099-01			
PAWNEE & BROADWAY WICHITA, KANSAS			
SPEAR & McCALEB CO., P.C. 815 West Main - Oklahoma City, OK 73106 PH: 405-232-7715 Fax: 405-232-7859 KANSAS CERTIFICATE OF AUTHORIZATION NO. E-335 EXP. DEC. 2004			
No. Revision	By	Date	
1	DR. PLOT	IST	7/23/03
2	CHANGES PER CITY COMMENTS	IST	8/04/03
DATE: 07/15/03		SCALE:	SHEET NO.
DRAWN BY:		NTS.	SS1
PROJECT NO.: 3800			
ENGINEER: TERENCE L. HAYNES, P.E. #14563			

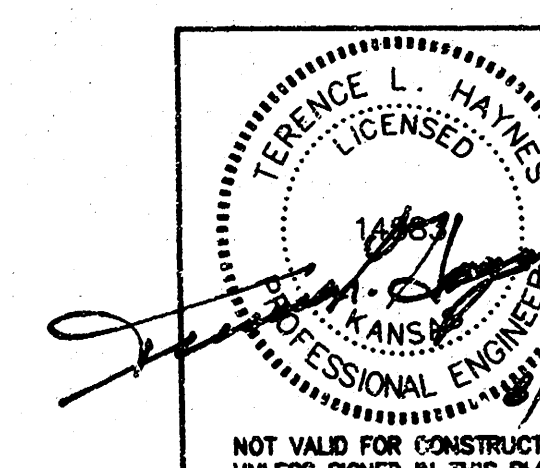



14 07 01 03

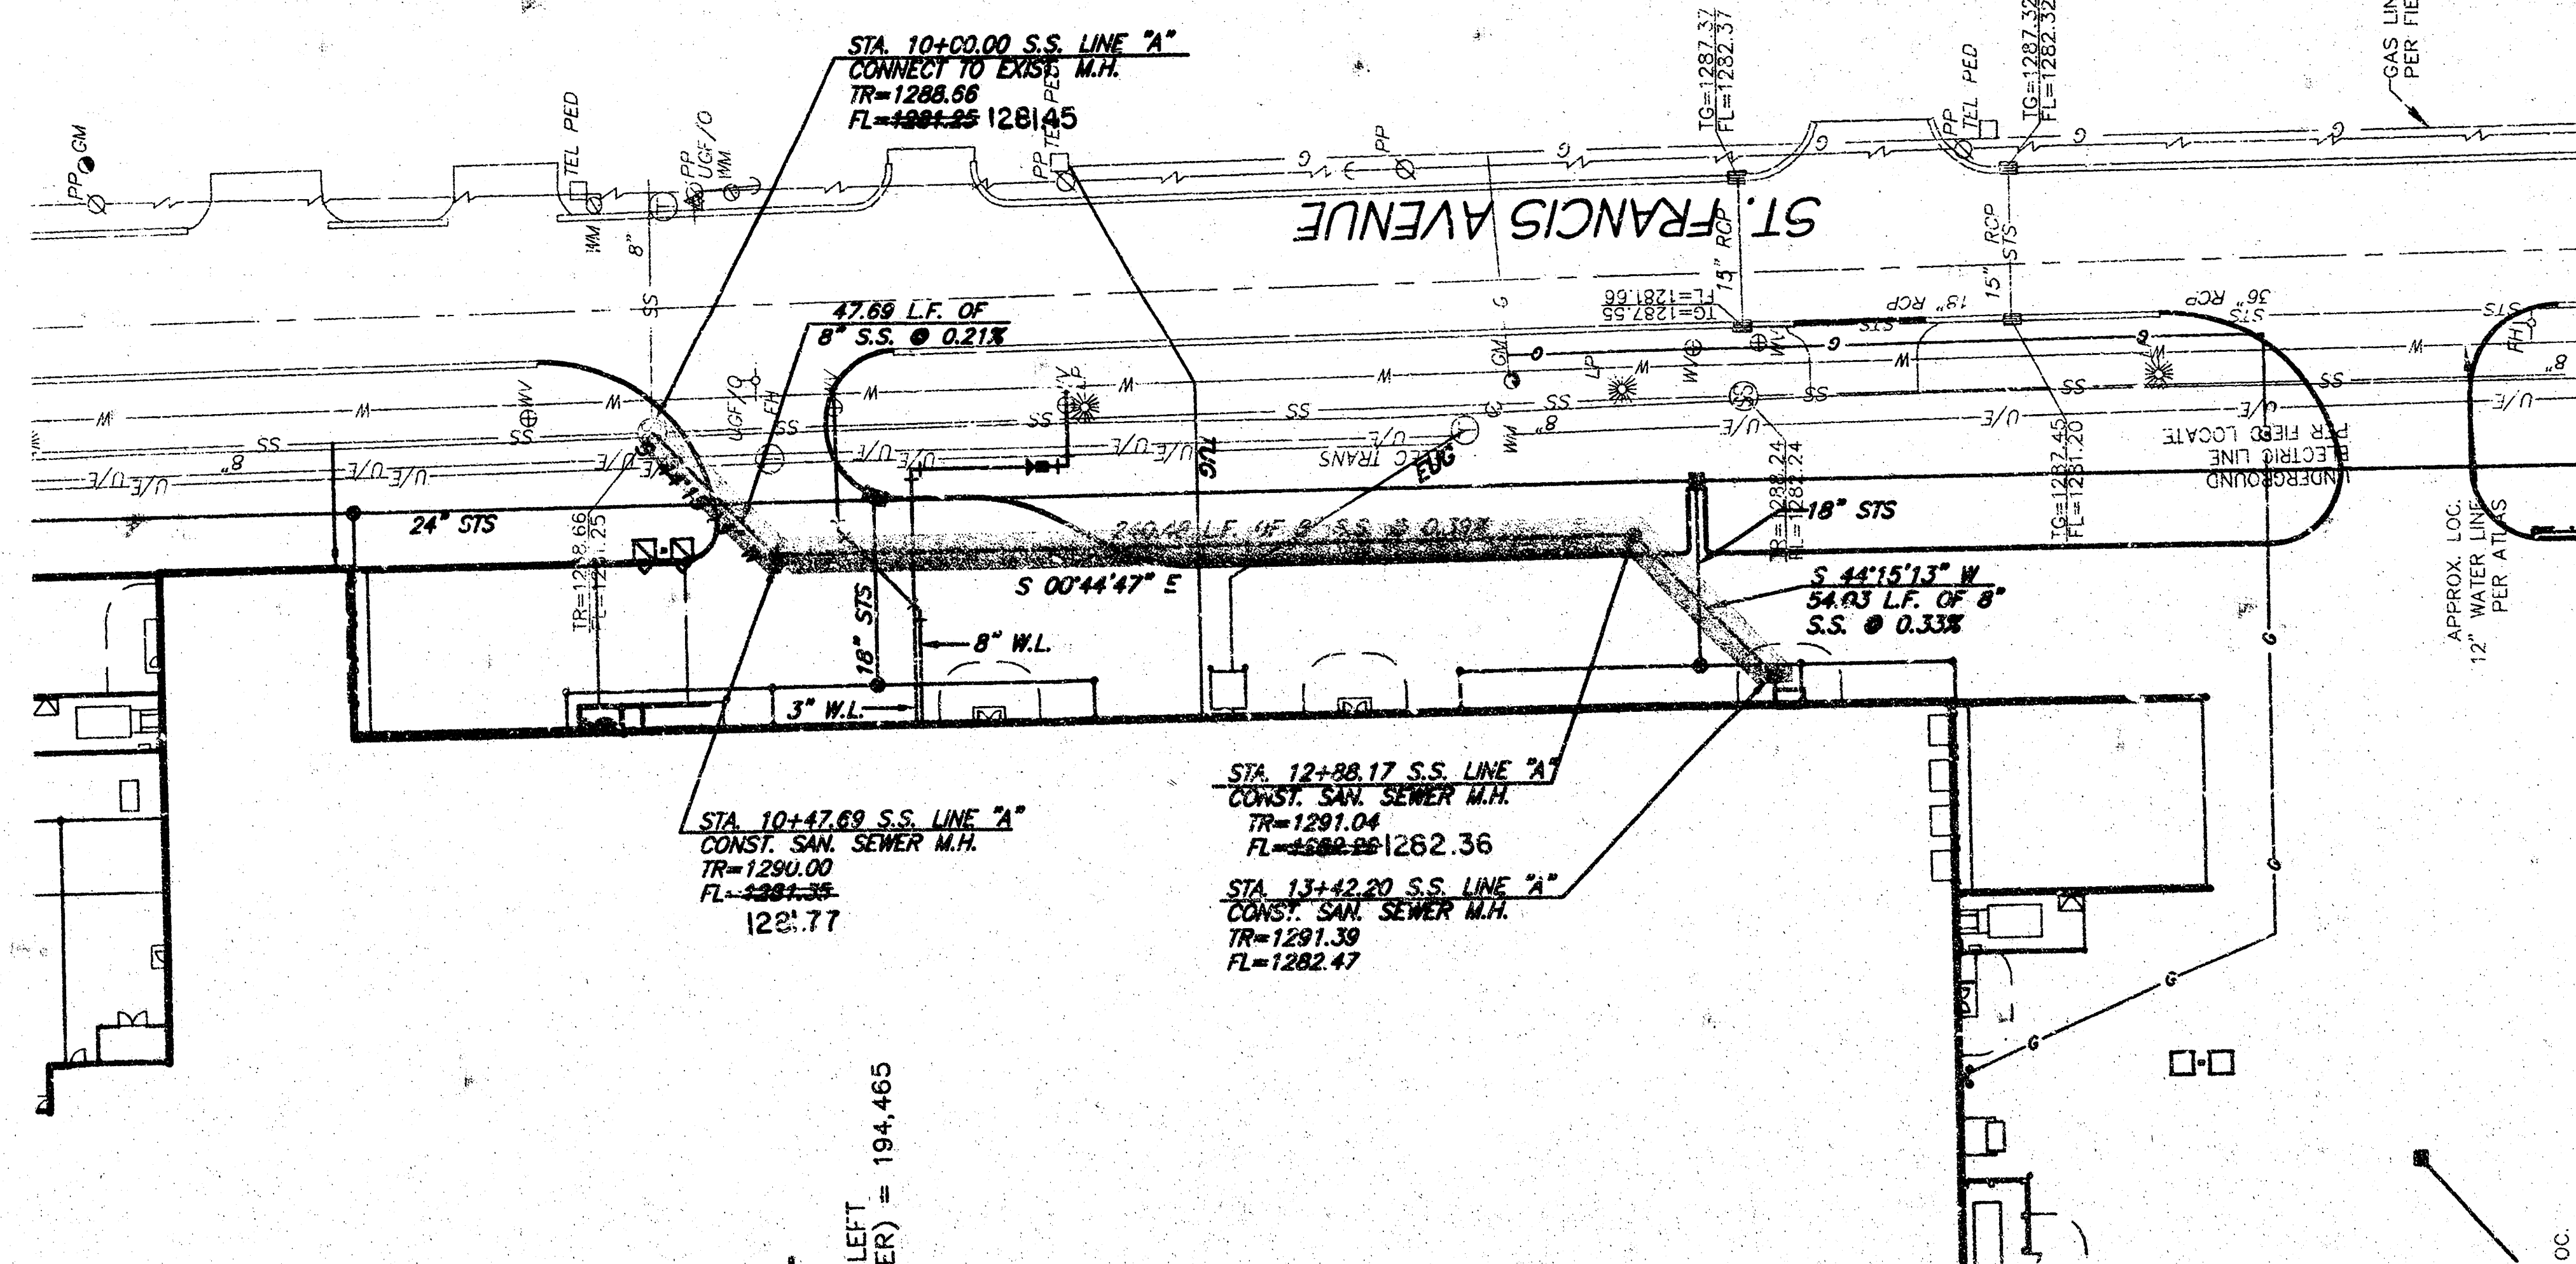

CAUTION - NOTICE TO CONTRACTOR


THE CONTRACTOR IS SPECIFICALLY CAUTIONED THAT THE LOCATION AND/OR ELEVATION OF EXISTING UTILITIES AS SHOWN ON THESE PLANS IS BASED ON RECORDS OF THE VARIOUS UTILITY COMPANIES AND, WHERE POSSIBLE, MEASUREMENTS TAKEN IN THE FIELD. THE INFORMATION IS NOT TO BE RELIED ON AS BEING EXACT OR COMPLETE. THE CONTRACTOR MUST CALL THE APPROPRIATE UTILITY COMPANY AT LEAST 48 HOURS BEFORE ANY EXCAVATION TO REQUEST EXACT FIELD LOCATION OF UTILITIES. IT SHALL BE THE RESPONSIBILITY OF THE CONTRACTOR TO RELOCATE ALL EXISTING UTILITIES WHICH CONFLICT WITH THE PROPOSED IMPROVEMENTS SHOWN ON THE PLANS.

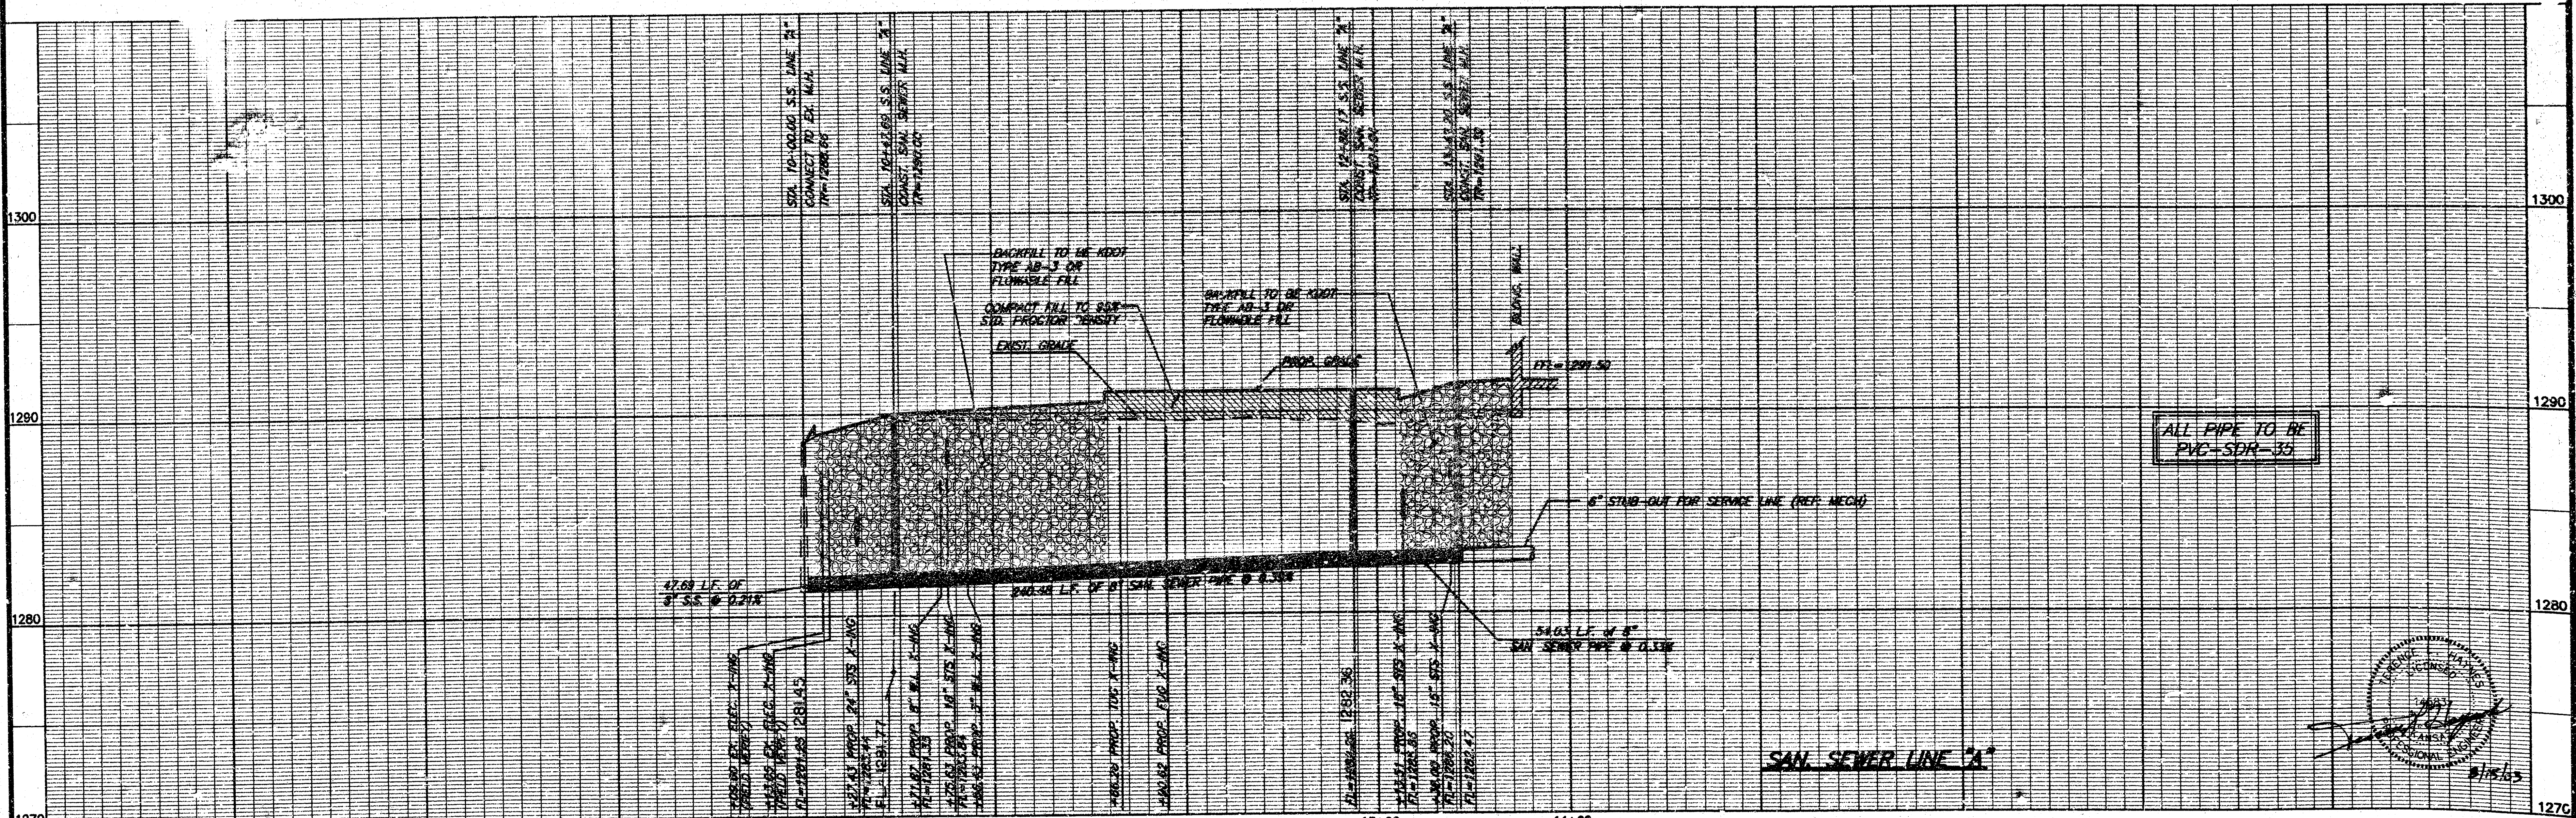

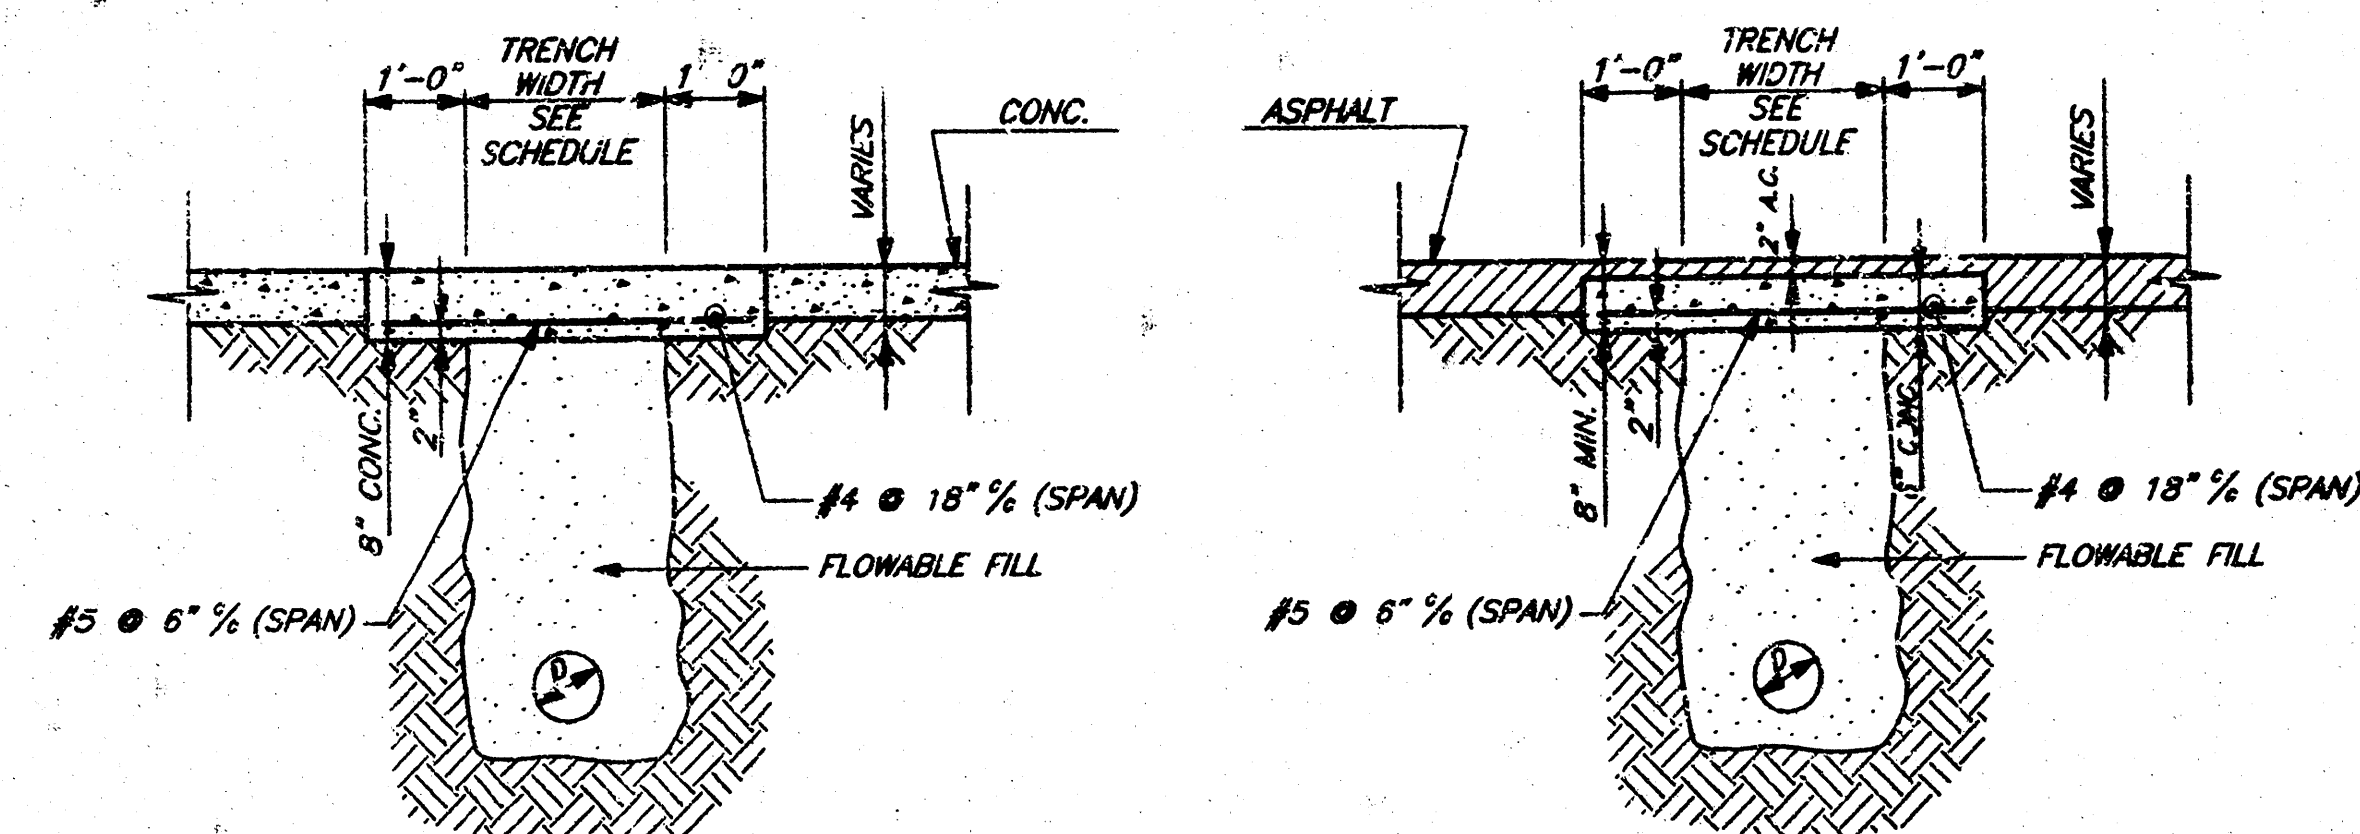

TYPICAL SECTION PAVING CUTS AND PERMANENT REPAIRS
(TAFT AVENUE)

PIPE INSIDE DIAMETER		STANDARD TRENCH WIDTH	
MM	IN.	MM	IN.
150	6	450	18
200	8	600	24
250	10	750	30
300	12	900	36
375	15	900	36
450	18	900	36
525	21	1,050	42
600	24	1,050	42
675	27	1,200	48
750	30	1,200	48
900	36	1,350	54
1,050	42	1,500	60
1,200	48	1,650	66

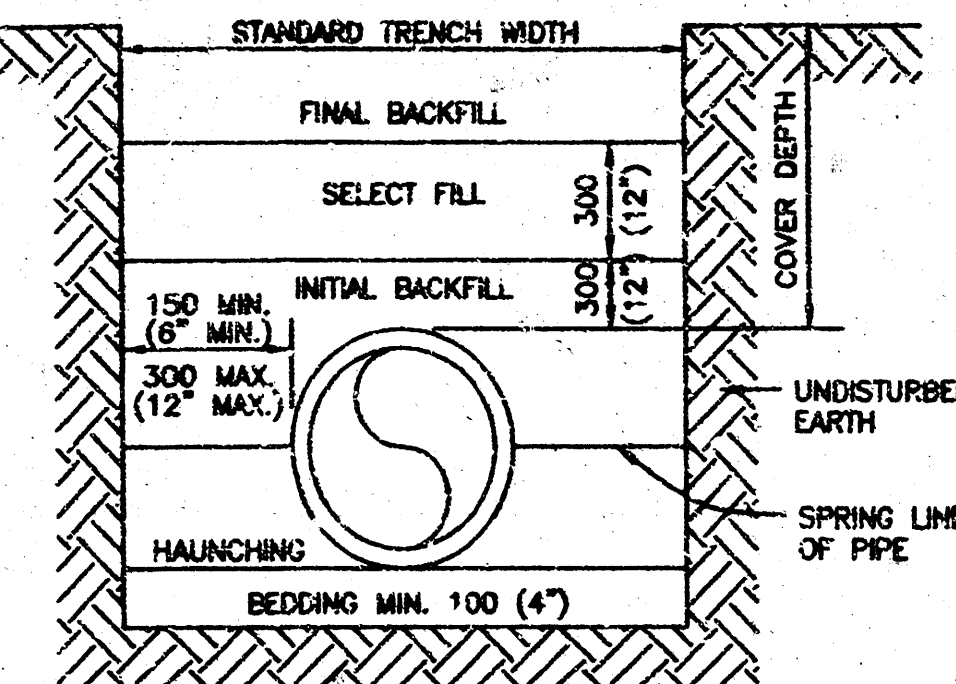

BEDDING MATERIALS						
BACKFILL DESCRIPTION	NON-PAVED AREAS			PAVED AREAS (See Note 8)		
	PVC	DUCTILE IRON	HDPE	PVC	DUCTILE IRON	HDPE
FINAL BACKFILL	EXCAVATED MATERIAL	EXCAVATED MATERIAL	EXCAVATED MATERIAL	SBM	SBM	SBM
SELECT BACKFILL	SELECT FILL	SELECT FILL	SELECT FILL	SBM	SBM	SBM
INITIAL BACKFILL	COVER ≤ 10'-SAND OR SBM > 10'-SBM	SELECT FILL	COVER ≤ 10'-SAND OR SBM > 10'-SBM	SBM	SBM	SBM
HAUNCHING	COVER ≤ 10'-SAND OR SBM > 10'-SBM	SELECT FILL	COVER ≤ 10'-SAND OR SBM > 10'-SBM	SBM	SBM	SBM
BEDDING	See Note 5	See Note 5	See Note 5	See Note 5	See Note 5	See Note 5

- NOTES:
1. INSTALLATION AND BACK FILLING SHALL MEET MANUFACTURERS RECOMMENDATIONS.
 2. SELECT FILL CONSISTS OF EXCAVATED MATERIALS CONTAINING NO ROCKS LARGER THAN 50 MM (2").
 3. STANDARD BEDDING MATERIAL (SBM) SHALL CONFORM KDOT, TYPE A-2.5, AGGREGATE BASE OR FLOWABLE FILL PER CITY OF WICHITA STANDARDS.
 4. COMPACTION REQUIREMENTS:
a. 95% MAXIMUM STANDARD PROCTOR DENSITY IN ACCORDANCE WITH ASTM D698.
 5. BEDDING SHALL BE 100 MM (4") SAND OR TYPE A-2.5 AGGREGATE BASE.
 6. IN SANDY SOIL, CONTRACTOR MAY BACKFILL WITH NATIVE MATERIAL AND USE WARNING TAPE 10" ABOVE PIPE.
 7. NO WATER JETTING ALLOWED.
 8. THE BACKFILL MATERIAL SHALL EXTEND A MINIMUM OF 2-Feet BEHIND THE BACK OF CURB, OR THE EDGE OF PAVEMENT WHERE NO CURB EXISTS.
- METRIC UNITS ARE IN MM WITH ENGLISH UNITS IN PARENTHESIS, UNLESS INDICATED OTHERWISE.

PIPE TRENCHING AND BEDDING

AS-BUILTS SEPT. 2004

(PRIVATE) SANITARY SEWER DETAILS

WAL-MART SUPERCENTER #1099-01

PAWNEE & BROADWAY
WICHITA, KANSAS

SPEAR & McCALEB CO., P.C.

815 West Main - Oklahoma City, OK 73106

PH: 405-232-7715 Fax: 405-232-7859

KANSAS CERTIFICATE OF AUTHORIZATION NO. E-335 EXP. DEC. 2004

No. 1099-01 Date

DATE: 07/15/03

DRAWN BY:

PROJECT NO.: 3800


ENGINEER:

SCALE:

N.T.S.


SHEET NO.

SS4

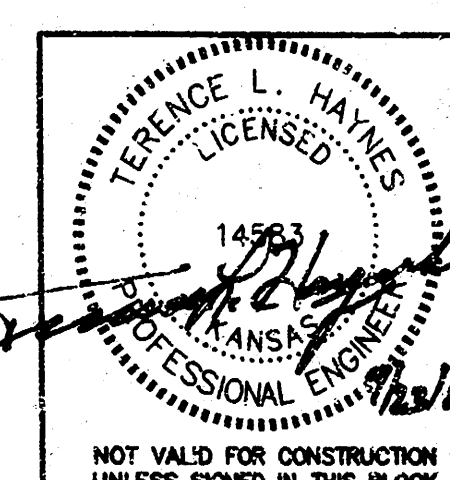

299 SDEI
Jawohn
22

SEWER APPURTENANCES DETAILS

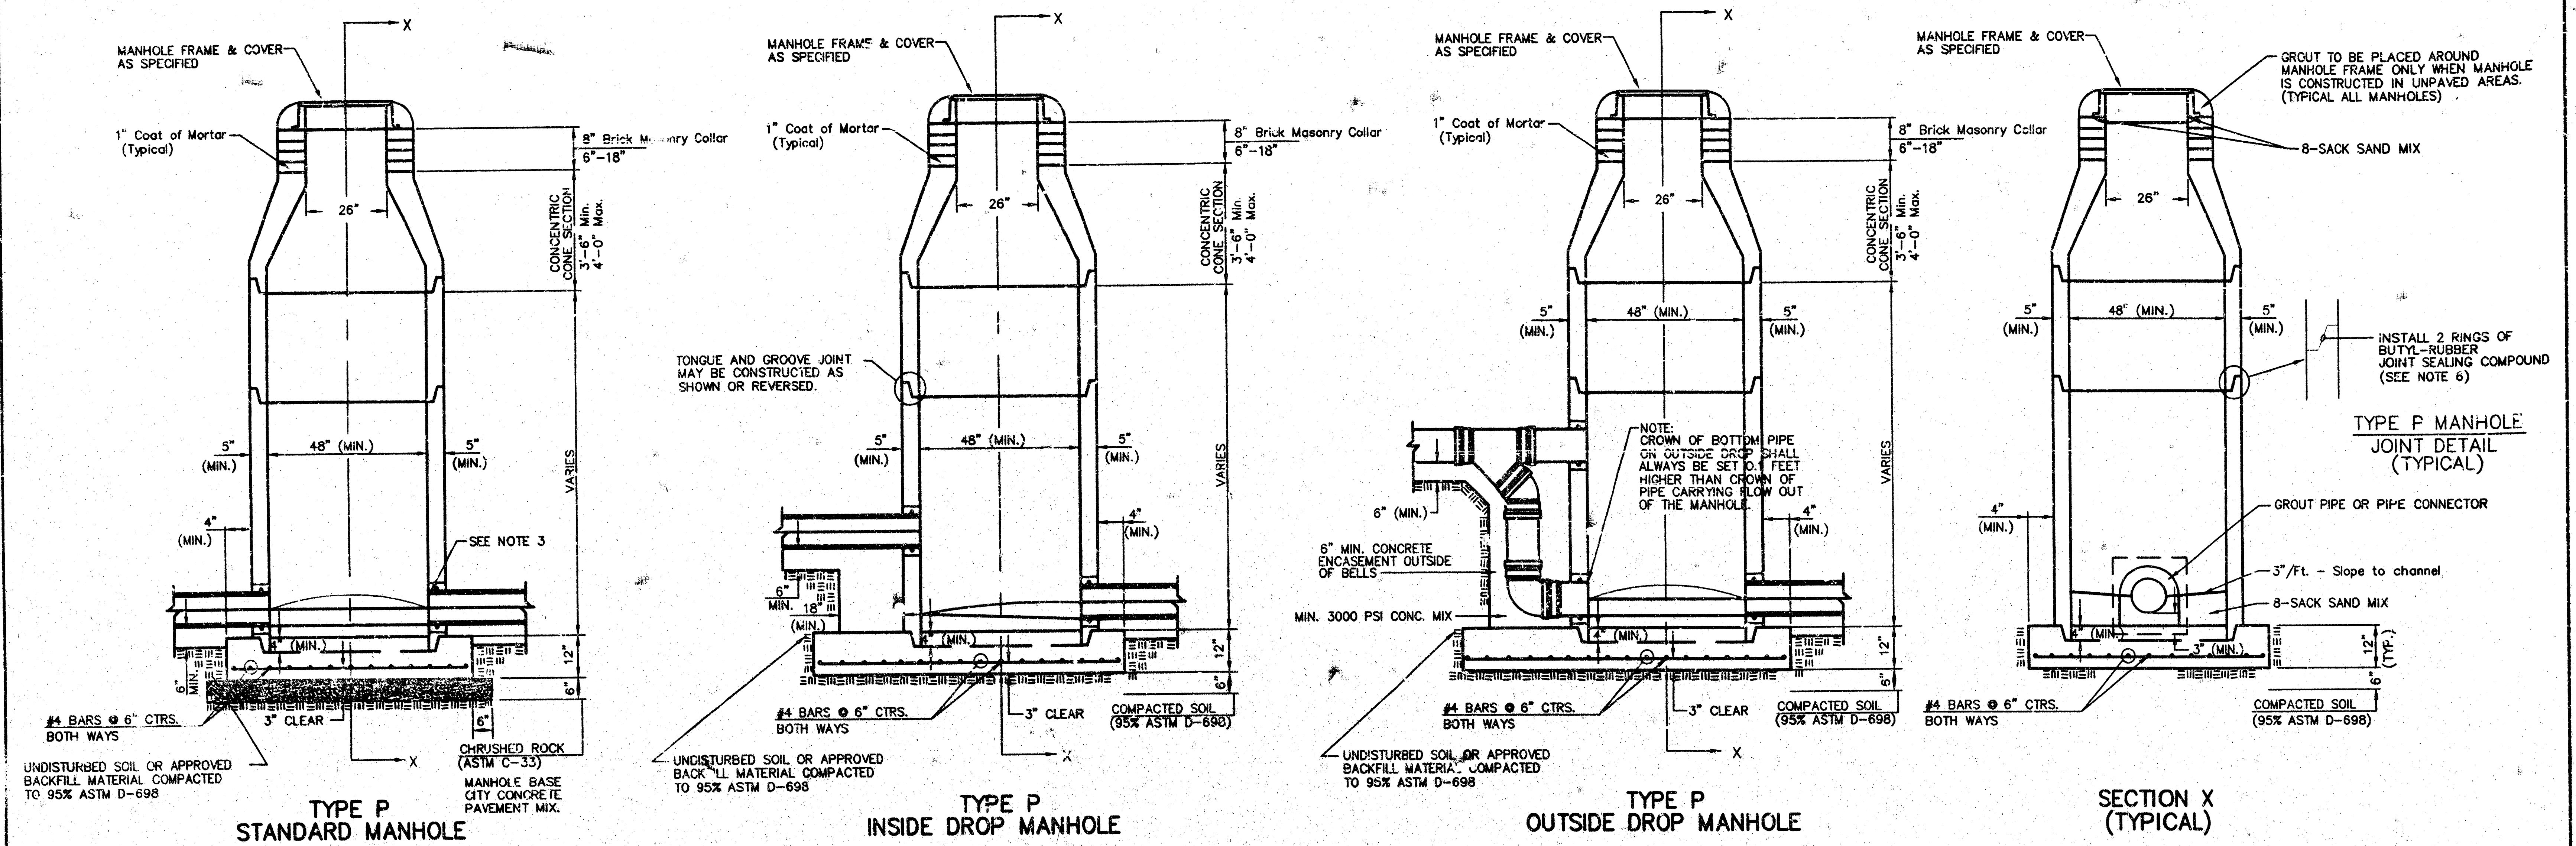

- GENERAL NOTES**
- PRECAST MANHOLE NOTES**
1. ALL PRECAST CONCRETE MANHOLE SECTIONS SHALL CONFORM TO THE LATEST REVISIONS OF A.S.T.M. C478 AS MODIFIED BY THE SPECIFICATIONS.
 2. NON-SHRINK GROUT SHALL BE NON-METALLIC TYPE.
 3. APPROVED FLEXIBLE WATERSTOP GASKETS SHALL BE INSTALLED TO JOIN THE SEWER TO THE MANHOLE WALL WHEN A.B.S. COMPOSITE PIPE OR P.V.C. PIPE IS USED. FOR OTHER TYPES OF PIPE THE SEWER SHALL BE GROUTED IN PLACE WITH NON-SHRINK GROUT. THE SEWER PIPE SHALL BE SUPPORTED WITH CONCRETE ENCASEMENT A MINIMUM OF 3 FEET FROM THE MANHOLE WALL AND TO THE FIRST JOINT FOR V.C.P. SUCH THAT THE JOINT REMAINS FLEXIBLE.
 4. ALL INSIDE SURFACES OF THE CONCRETE MANHOLE WHICH WOULD BE EXPOSED TO SEWER GAS SHALL BE COATED WITH 2 COATS TNEWC SERIES 66 HI-BUILD EPOXYLINE, DRY THICKNESS OF 8 MILS (MIN.).
 5. EXTERIOR MANHOLE WALLS SHALL BE COATED WITH 1 COAT MOBILARMA 633 BITUMINOUS COATING.
 6. JOINT SEALING COMPOUND SHALL BE KENT SEAL NO. 2 OR APPROVED EQUAL.
 7. PRECAST MANHOLES SHALL BE SET AT LEAST 4 INCHES INTO THE MANHOLE BASE.
 8. TOP OF MANHOLE FLOOR SLAB SHALL BE AT LEAST 3 INCHES BELOW THE FLOW LINE OF THE OUTLET PIPE TO INSURE SUFFICIENT MINIMUM THICKNESS OF SHAPED INVERT.
 9. LIFTING HOLES SHALL BE FILLED WITH NON-SHRINK GROUT AND THE INTERIOR SURFACE COATED AS SPECIFIED.
 10. MORTAR USED IN MASONRY CONSTRUCTION SHALL CONTAIN 8 SACKS OF CEMENT PER CUBIC YARD. CONCRETE USED IN MANHOLE BASES SHALL CONFORM TO THE REQUIREMENTS OF CONCRETE FOR CONCRETE PAVEMENT CONSTRUCTION AS SPECIFIED IN THE CITY STANDARD PAVING SPECIFICATIONS USING CITY CONCRETE PAVEMENT MIX WITHOUT AIR ENTRAINING ADMIXTURE. MORTAR SHALL BE PLACED AROUND THE MANHOLE RING AS SHOWN ON THE DRAWINGS WHEN MANHOLES ARE CONSTRUCTED IN UNPAVED AREAS. MANHOLES CONSTRUCTED WHERE PIPE SIZES ARE SMALLER THAN 24" SHALL HAVE AN INSIDE DIAMETER OF 4". MANHOLES CONSTRUCTED WHERE PIPE SIZES ARE 24" OR LARGER SHALL HAVE AN INSIDE DIAMETER OF 5". COMPLETED MANHOLE SHALL BE WITHOUT LEAKS AND WATER TIGHT.

11. REINFORCING STEEL SHALL BE INSTALLED IN THE MANHOLE BASES AND SHALL CONSIST OF NO. 4 BARS PLACED ON 6" CENTERS IN BOTH DIRECTIONS. THE MANHOLE BASE REINFORCEMENT SHALL BE PLACED AT LEAST 1" ABOVE THE BOTTOM OF THE MANHOLE BASE. ALL COSTS FOR FURNISHING AND INSTALLING REINFORCING STEEL SHALL BE INCLUDED IN THE UNIT PRICE BID FOR THE MANHOLE.
12. OPENINGS SHALL BE CUT INTO THE MANHOLE WALL WHEN OUTSIDE DROPS ARE CONSTRUCTED ON EXISTING MANHOLES. SUCH OPENINGS CUT INTO EXISTING MANHOLES SHALL BE AS SMALL AS PRACTICAL TO FACILITATE INSTALLING AND GROUTING THE NEW PIPE IN PLACE. WATERSTOP GASKETS SHALL BE USED WITH P.V.C. AND A.B.S. COMPOSITE PIPE. THE NEW PIPE SHALL BE GROUTED INTO THE OPENING USING AN APPROVED NONSHRINK GROUT FOR THE FULL MANHOLE WALL THICKNESS. THE EXTERIOR OF THE COMPLETED CONNECTION SHALL BE SEALED WITH AN APPROVED BITUMINOUS COATING SUCH THAT THE CONNECTION WILL BE WATER TIGHT. FLOOR OF MANHOLE SHALL BE MODIFIED TO FORM NEW FLOW CHANNEL FOR THE NEW CONNECTION AS INDICATED BY THE DRAWING. THIS WORK, INCLUDING MODIFICATION OF MANHOLE FLOOR, SHALL BE PAID FOR AT THE UNIT PRICE BID FOR OUTSIDE DROP STACK CONSTRUCTED ON EXISTING MANHOLE.
13. THE FLOORS OF ALL MANHOLES SHALL BE SHAPED WITH FLOW CHANNELS SUCH THAT THE MANHOLES WILL BE SELF CLEANING AND FREE OF AREAS WHERE SOLIDS COULD BE DEPOSITED AS SEWAGE FLOWS THROUGH THE MANHOLE FROM ALL INLET PIPES TO THE OUTLET PIPE. FLOW CHANNELS SHALL BE FORMED TO MATCH THE BOTTOM HALVES OF THE INFLUING PIPES AND THE OUTFLOWING PIPE AS SHOWN BY THE DRAWINGS EXCEPT FOR INSIDE DROP MANHOLES. FLOW CHANNELS FOR INSIDE DROP MANHOLES SHALL BE CONSTRUCTED AS INDICATED BY THE DRAWING. MANHOLE FLOORS SHALL HAVE SLOPES OF 3 INCHES PER FOOT IN THE AREAS OUTSIDE OF THE FLOW CHANNELS SLOPED TOWARD THE FLOW CHANNELS. PIPES LAID THROUGH MANHOLES SHALL HAVE THE TOP HALF REMOVED TO NEAT LINES FOR THE FULL INSIDE DIAMETER OF THE MANHOLE. MANHOLE FLOORS SHALL THEN BE SHAPED AROUND THE BOTTOM HALF OF THE PIPE WHICH FORMS THE FLOW CHANNEL.
14. PIPES INSTALLED WITHIN THE EXCAVATION MADE FOR THE MANHOLE SHALL BE CRADLED WITH CONCRETE TO THE LIMITS OF THE MANHOLE EXCAVATION. WHEN CLAY PIPE IS USED, THE CRADLE SHALL EXTEND TO THE FIRST JOINT OUTSIDE THE MANHOLE. THE CRADLE SHALL BE TERMINATED AT THE CLAY PIPE JOINT IN A MANNER WHICH WILL MAINTAIN THE FLEXIBILITY OF THE JOINT. COST OF CRADLE WITHIN MANHOLE EXCAVATION OR TO CLAY PIPE JOINTS ADJACENT TO MANHOLE SHALL BE INCLUDED IN THE UNIT PRICE BID FOR THE MANHOLE.

15. MANHOLE COVER CASTINGS AND MANHOLE FRAME CASTINGS SHALL CONFORM TO THE REQUIREMENTS AS INDICATED IN THE STANDARD SPECIFICATIONS AND AS SHOWN IN THE STANDARD DETAIL DRAWING.
16. THE VERTICAL DROP IN INSIDE DROP MANHOLES SHALL NOT EXCEED 2' FOR INFLUING PIPES SIZED 12" OR SMALLER AND 2' FOR INFLUING PIPES LARGER THAN 12". THE CROWNS OF INFLUING PIPES SHALL NEVER BE SET LOWER THAN THE CROWN OF THE OUTFLOWING PIPE.
17. STANDARD MANHOLES AND STANDARD INSIDE DROP MANHOLES SHALL BE BID AS STANDARD MANHOLES FOR THE TYPE AND DIAMETER INDICATED. OUTSIDE DROP MANHOLES SHALL BE BID AS STANDARD OUTSIDE DROP MANHOLES FOR THE TYPE AND DIAMETER INDICATED. ALL MANHOLE DIAMETERS WILL BE 4' UNLESS INDICATED OTHERWISE.
18. A BRICK MASONRY COLLAR SHALL BE INSTALLED BETWEEN THE CAST IRON FRAME AND THE CONCENTRIC CONE. THE COLLAR WILL HAVE 8" WALLS AND A VERTICAL HEIGHT OF 6" MINIMUM AND 18" MAXIMUM. A 1" COAT OF MORTAR WILL BE PLASTERED ON THE OUTSIDE OF THE COLLAR. THE USE OF PRE-CAST CONCRETE SPACERS FOR MANHOLE TOP ADJUSTMENT IS ALSO ALLOWED.
19. CHRUSHED ROCK CONFORMING TO ASTM C-33 WITH A GRADATION OF NO. 67 SHALL BE INSTALLED AT THE BASE OF THE MANHOLE TO A DEPTH OF NO LESS THAN 6", AND SHALL EXTEND NO LESS THAN 6" OUTSIDE THE DIAMETER OF THE CONCRETE FLOOR OF THE MANHOLE.

AS-BUILTS SEPT. 2004

THE CITY OF WICHITA CITY ENGINEER'S OFFICE CITY HALL - SEVENTH FLOOR 1001 NORTH MAIN STREET WICHITA, KANSAS 67202 (316) 268-1111 FAX		STANDARD TYPE 'P' MANHOLES	
		NEIL D. CABLE, P.E. - CITY ENGINEER	
PROJECT NUMBER	XXX-XXXXX	INDEX CODE	XXXXXX
DATE	MAR 96	SHEET NO. SS5	

PMH/DWG 17 01 01 03