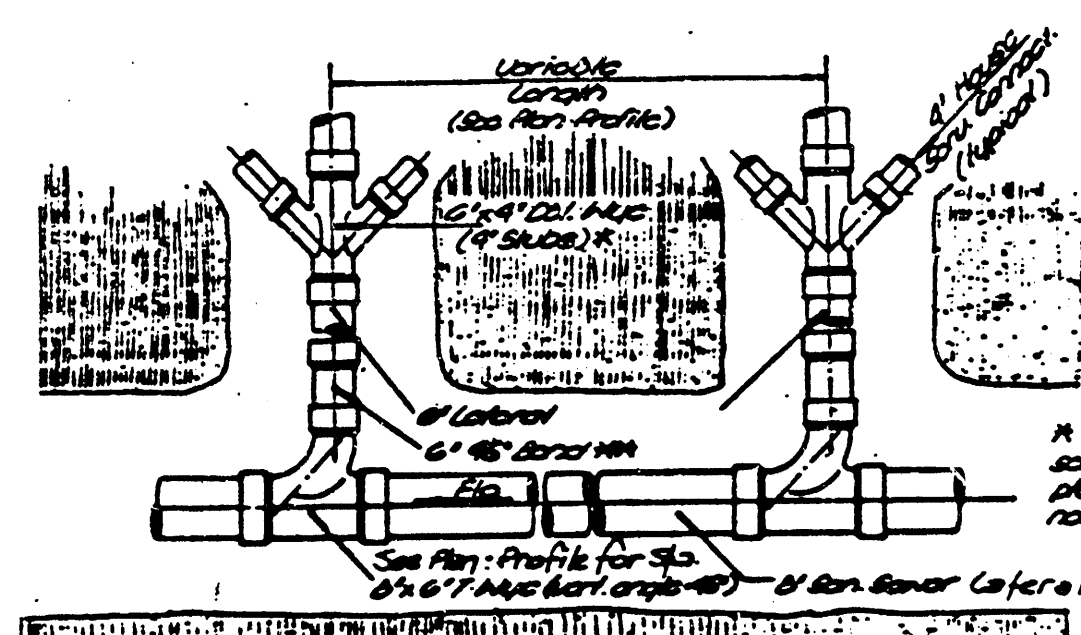


PLAN	SURVEYED	DATE	1
NOTE BOOK	PLOTTED	BY	2
No.	ALIGNMENT CHECKED	BY	3
	BY	4	4


1. Contractor shall contact the Sewer Maintenance Division of the Dept. of Public Works to arrange for the taps on the existing 8" VCP (Lines 1 and 3). Any costs or fees for such taps shall be included in the Contractors bid.
2. Contractor to verify locations of underground utilities prior to any excavation.
3. Contractor shall preserve property corner irons. Any such irons disturbed by the Contractors operations shall be re-established at the Contractor's expense, by a licensed surveyor in accordance with state law.
4. Trees and fences to be removed as necessary for construction.

[illegible]

APPROVED AS NOTED
 PLUMBER ENGINEER OF VICTORIA
 Sanitary Sewers CLB 12/30/06
 Storm sewers _____
 Driveway Approaches _____
 Water Mains _____
 Pavement _____

NOTE TO CONTRACTOR

INSPECTION AND TESTING FOR THIS PROJECT IS TO BE PROVIDED BY A LICENSED CONSULTING ENGINEERING FIRM UNDER CONTRACT WITH THE OWNER DEVELOPER. SAID INSPECTION TO BE IN ACCORDANCE WITH THE CITY OF VIRGINIA STANDARD SPECIFICATIONS AND METHODS AND PRACTICES AND CERTIFIED BY A LICENSED PROFESSIONAL ENGINEER TO WORK SHALL BE FURNISHED TO THE PROJECT MANAGER AT THE END OF EACH MONTH OR MAY BE AT THE REQUEST OF THE PROJECT MANAGER SHALL HAVE NO EFFECT ON THE CONTRACT PRICE. ANY CHANGES TO THE STANDARD SPECIFICATIONS SHALL BE MADE ONLY BY WRITTEN AUTHORIZATION OF THE PROJECT MANAGER.

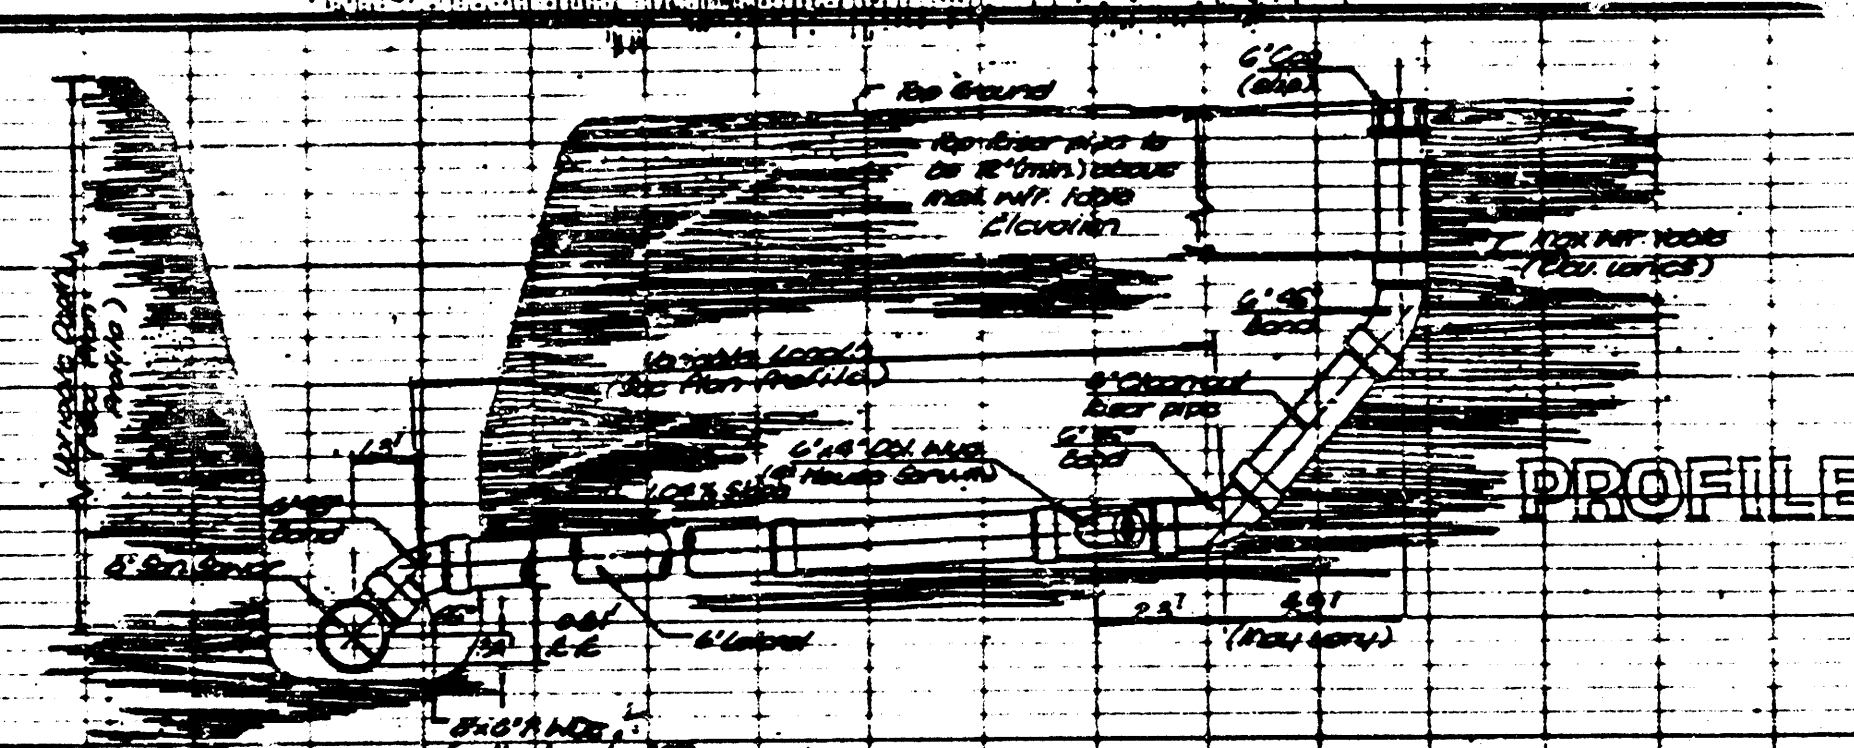

Revised as-built 3-10-84

PRIVATE SANITARY SEWER
LOTS 1-5, WALNUT GROVE 5TH ADDN.

PROJ. NO. 466-16-245-80001-666-000-15

BAUGHMAN COMPANY, P.A.
SURVEYING & ENGINEERING
316/282-7271 • 316 ELIUS • WICHITA, KANSAS 67211

Design:	Drawn:	Approved:	Date:	Scale:
TJR	TJR		20 DEC 88	" = 40

12x	12x		2000000	1.10
-----	-----	--	---------	------

**FILMED FROM THE BEST
AVAILABLE COPY.....**