


VICINITY MAP
SCALE: 1" = 150'

9-27-83

APPROVED AS NOTED
 By CITY ENGINEER OF WICHITA
 Sanitary Sewers: *P.E.D.*
 Storm Sewers:
 Driveway Approaches:

NOTE TO CONTRACTOR
 This project will be constructed under
 the supervision of the CITY ENGINEER
 and conforming to the SPECIFICATIONS
 of the CITY OF WICHITA. The CON-
 TRACTOR will prepay the City of Wichita
 for all costs of inspection.

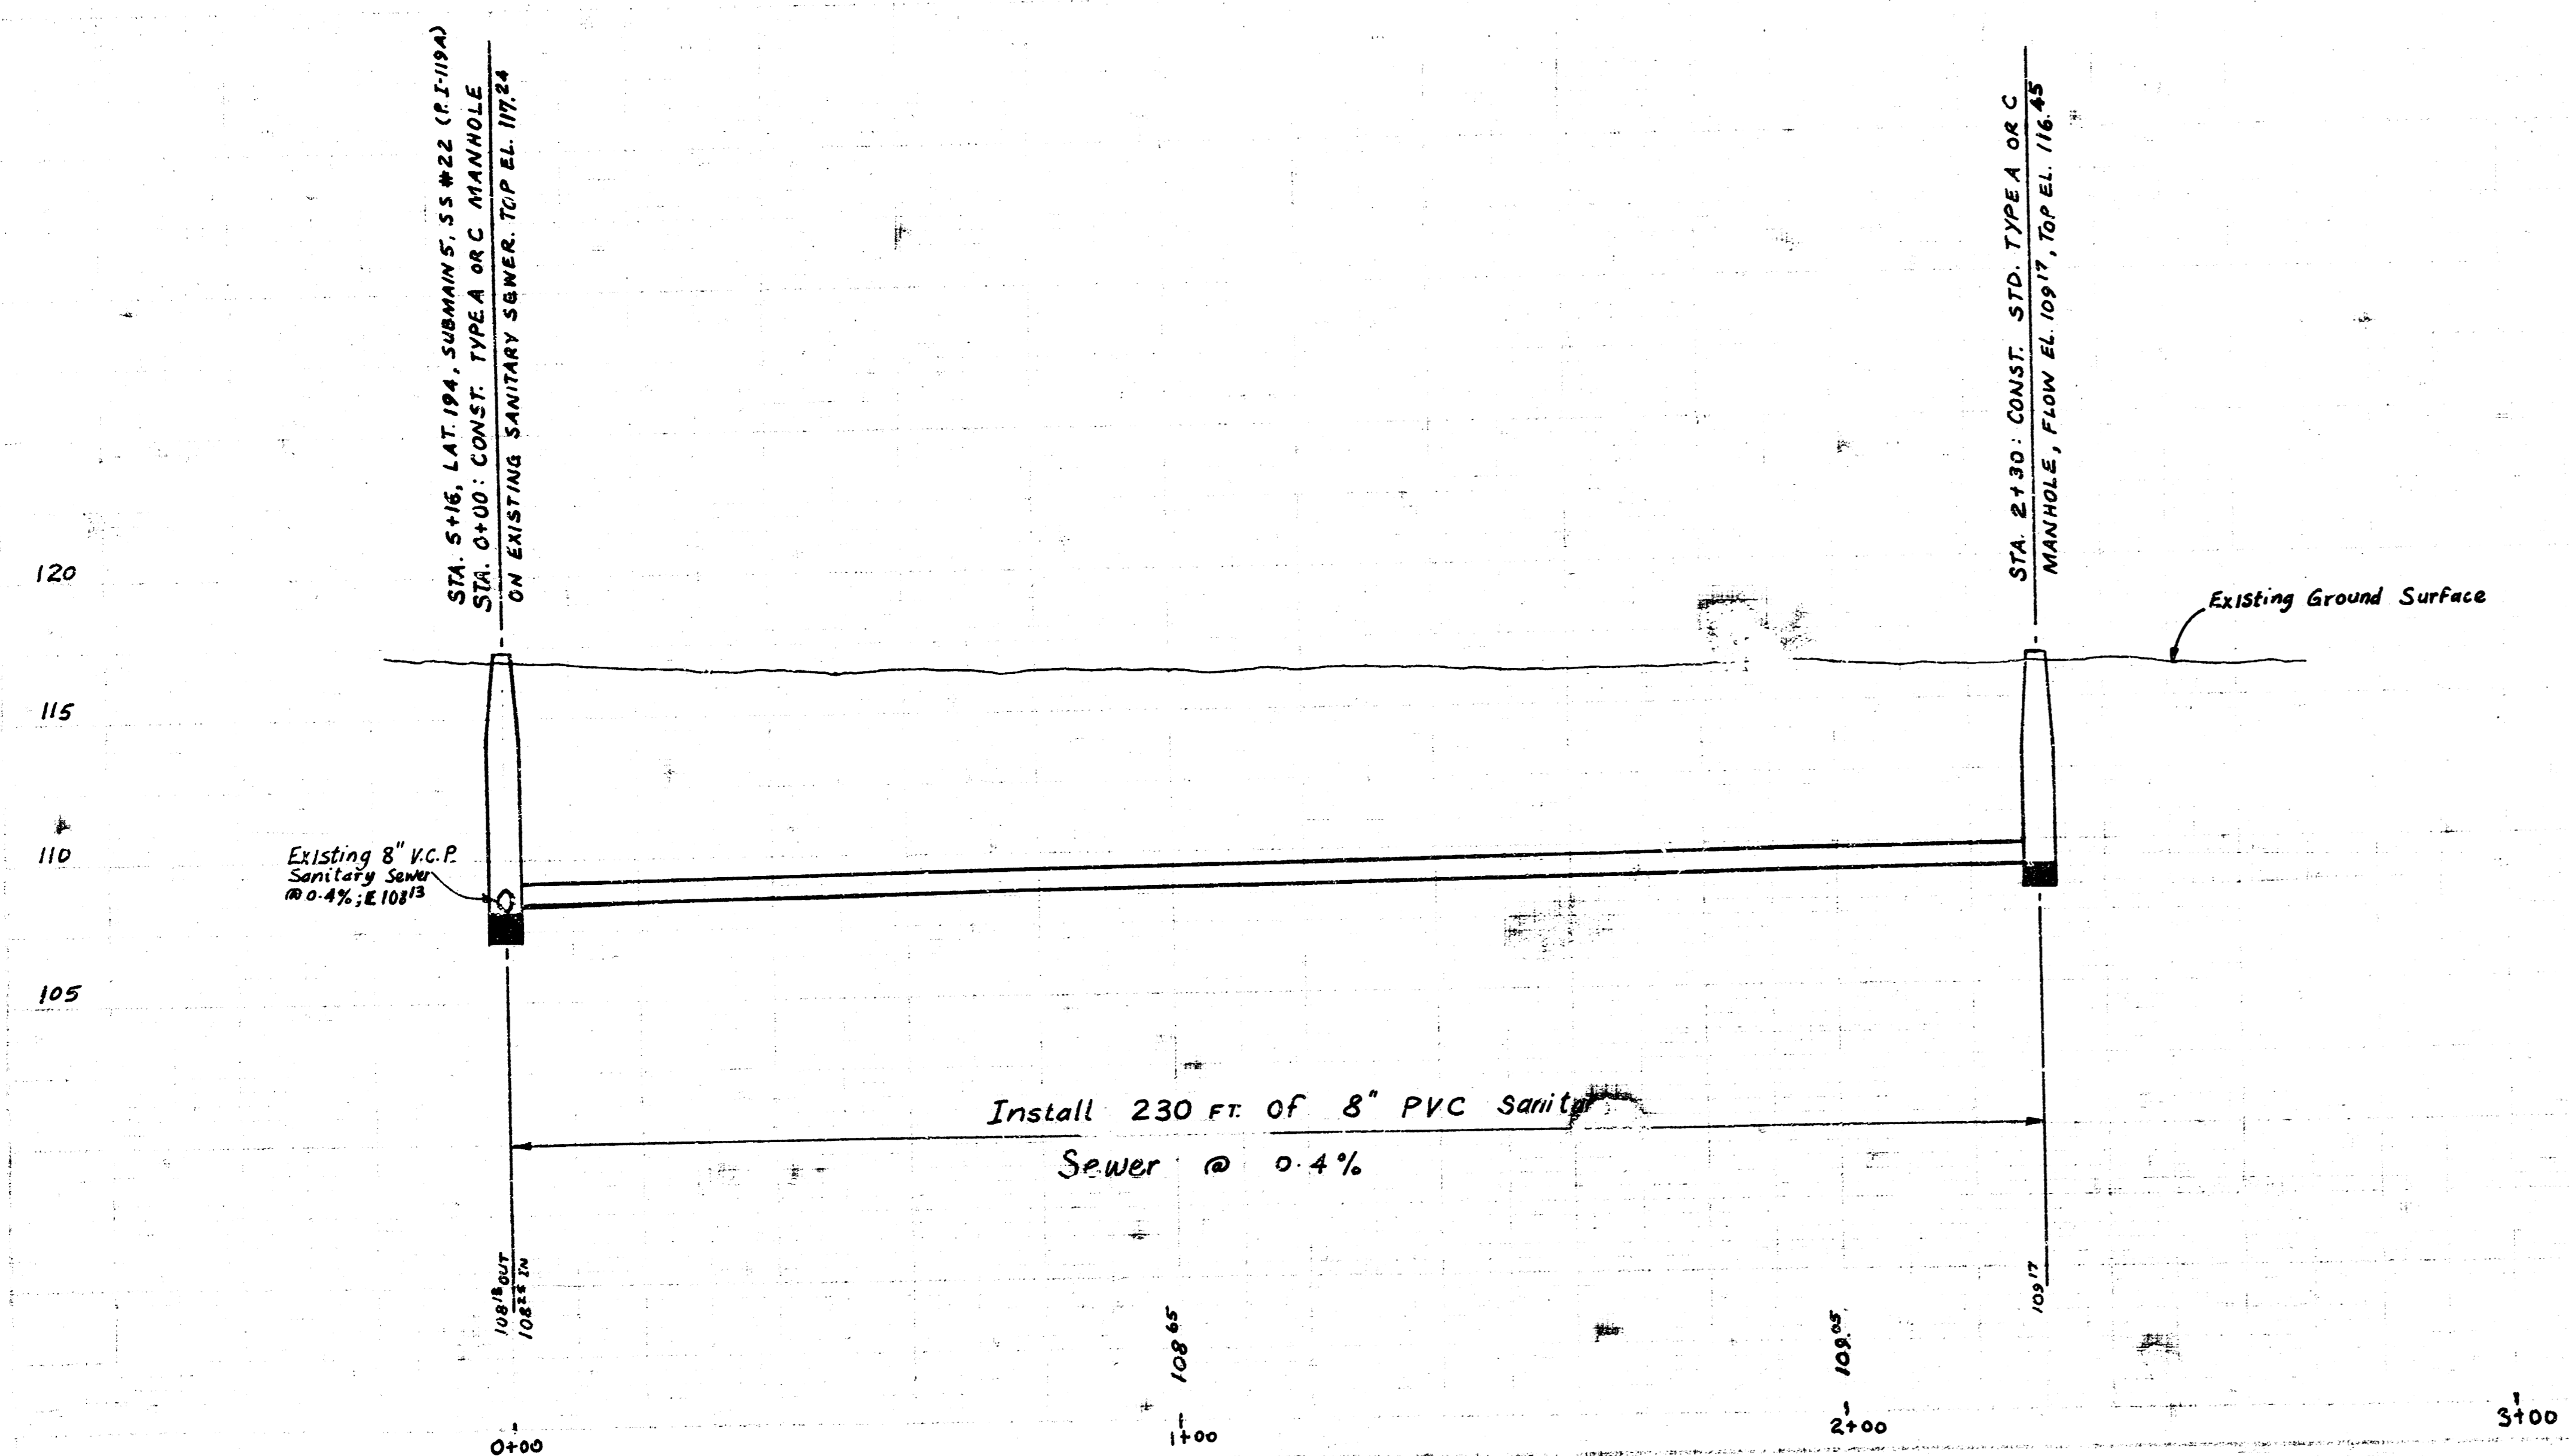

Sanitary Sewer Extension to serve Lots 2, 3 and
 4 of W-C ADDITION, WICHITA, SEDGWICK CO., KANSAS.
 CITY OF WICHITA PRIVATE PROJ. NO. 468 76 245 80000 000 000 008
FIRESIDE ENGINEERING CO.
 WICHITA, KANSAS PHONE: (316) 744-0307
 SEPT 1983.

14 5 3 11