
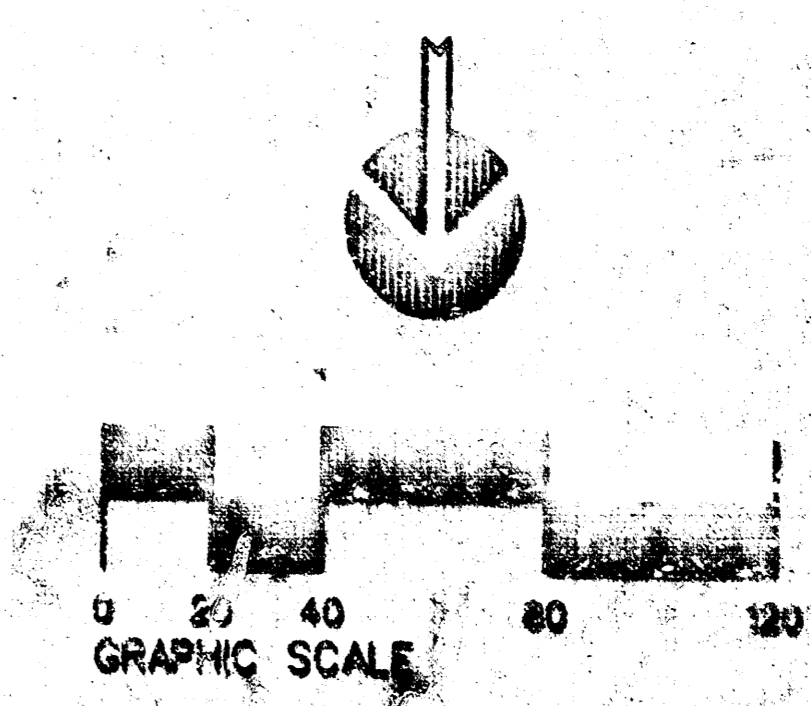


REINFORCING PER 8/5-6 SPANNING ACROSS ROOF

TUNNEL CROSSING SECTION


STA 1+93
END 8" PVC
STORM SEWER

STA 0+00
EXISTING MANHOLE
DURING CONSTRUCTION
OF UNDERGROUND TUNNEL
SEWER LINE TO REMAIN
IN SERVICE AND PROTECTED.
STA 0+52
END OF CONSTRUCTION

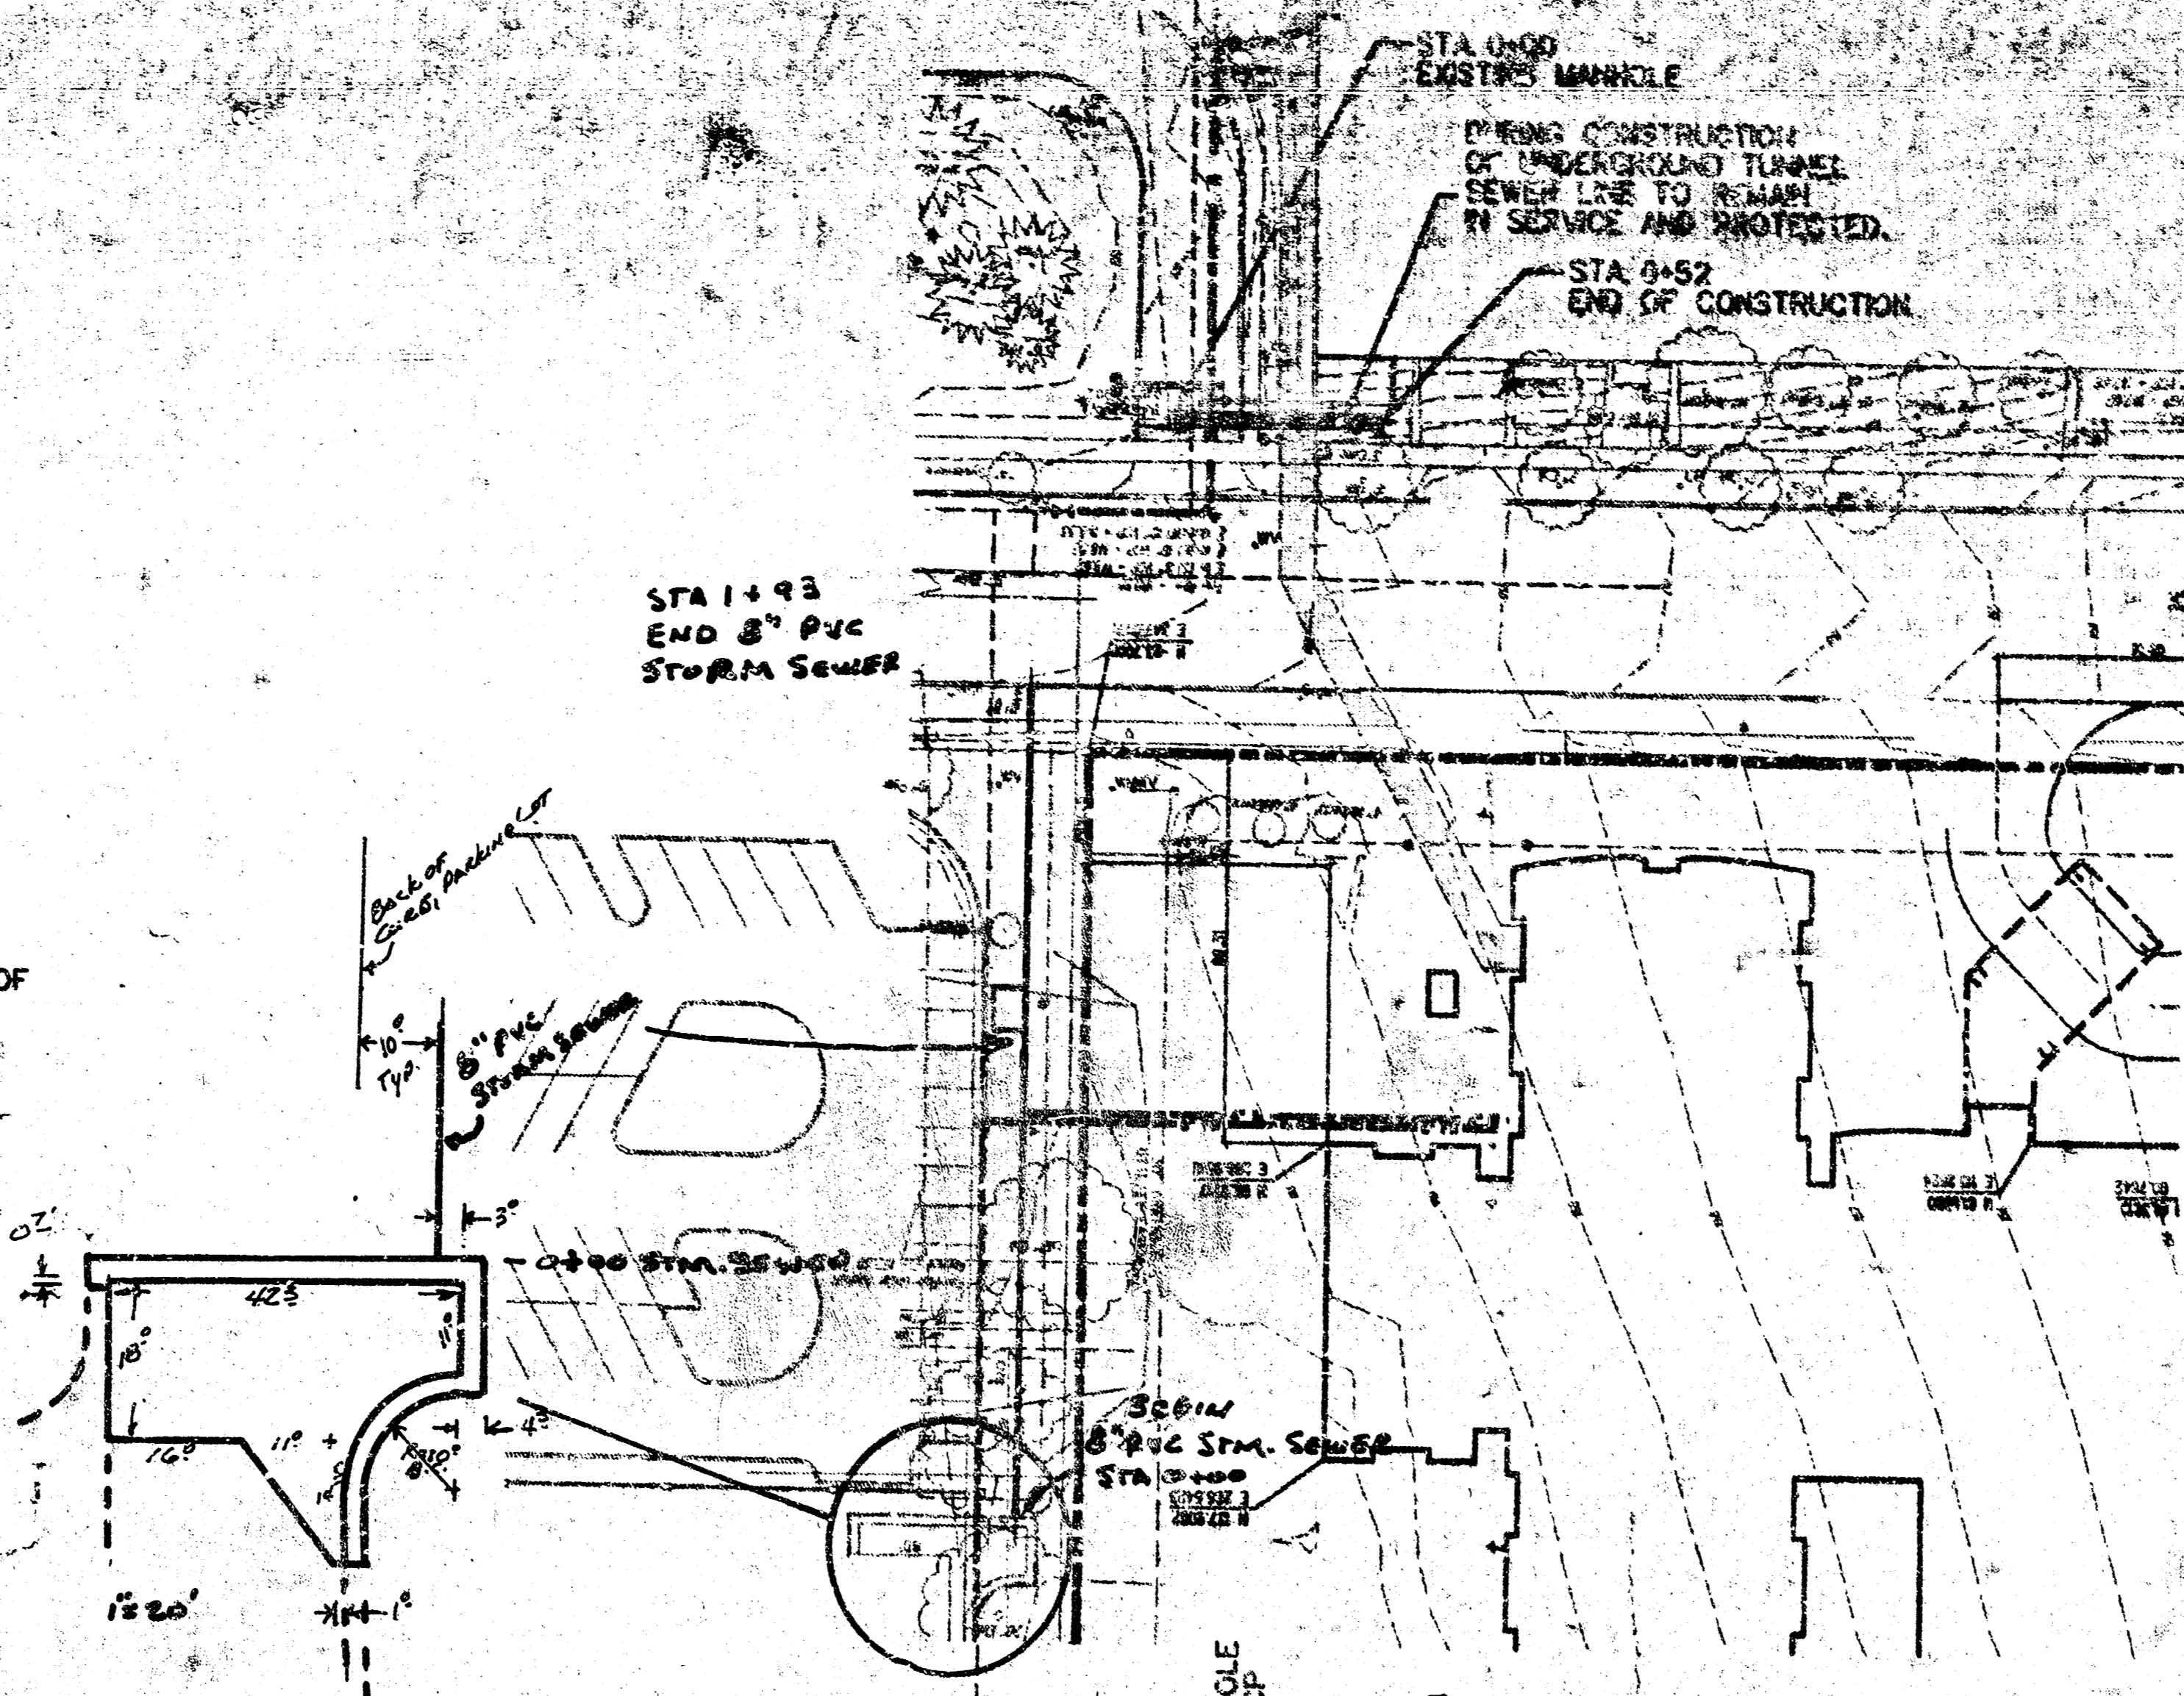

As Built Plans
S.E. Anderson, P.E./L.S.
December, 1995

PROFILE VERT. = 1"=1'
PLAN = 1"=40'

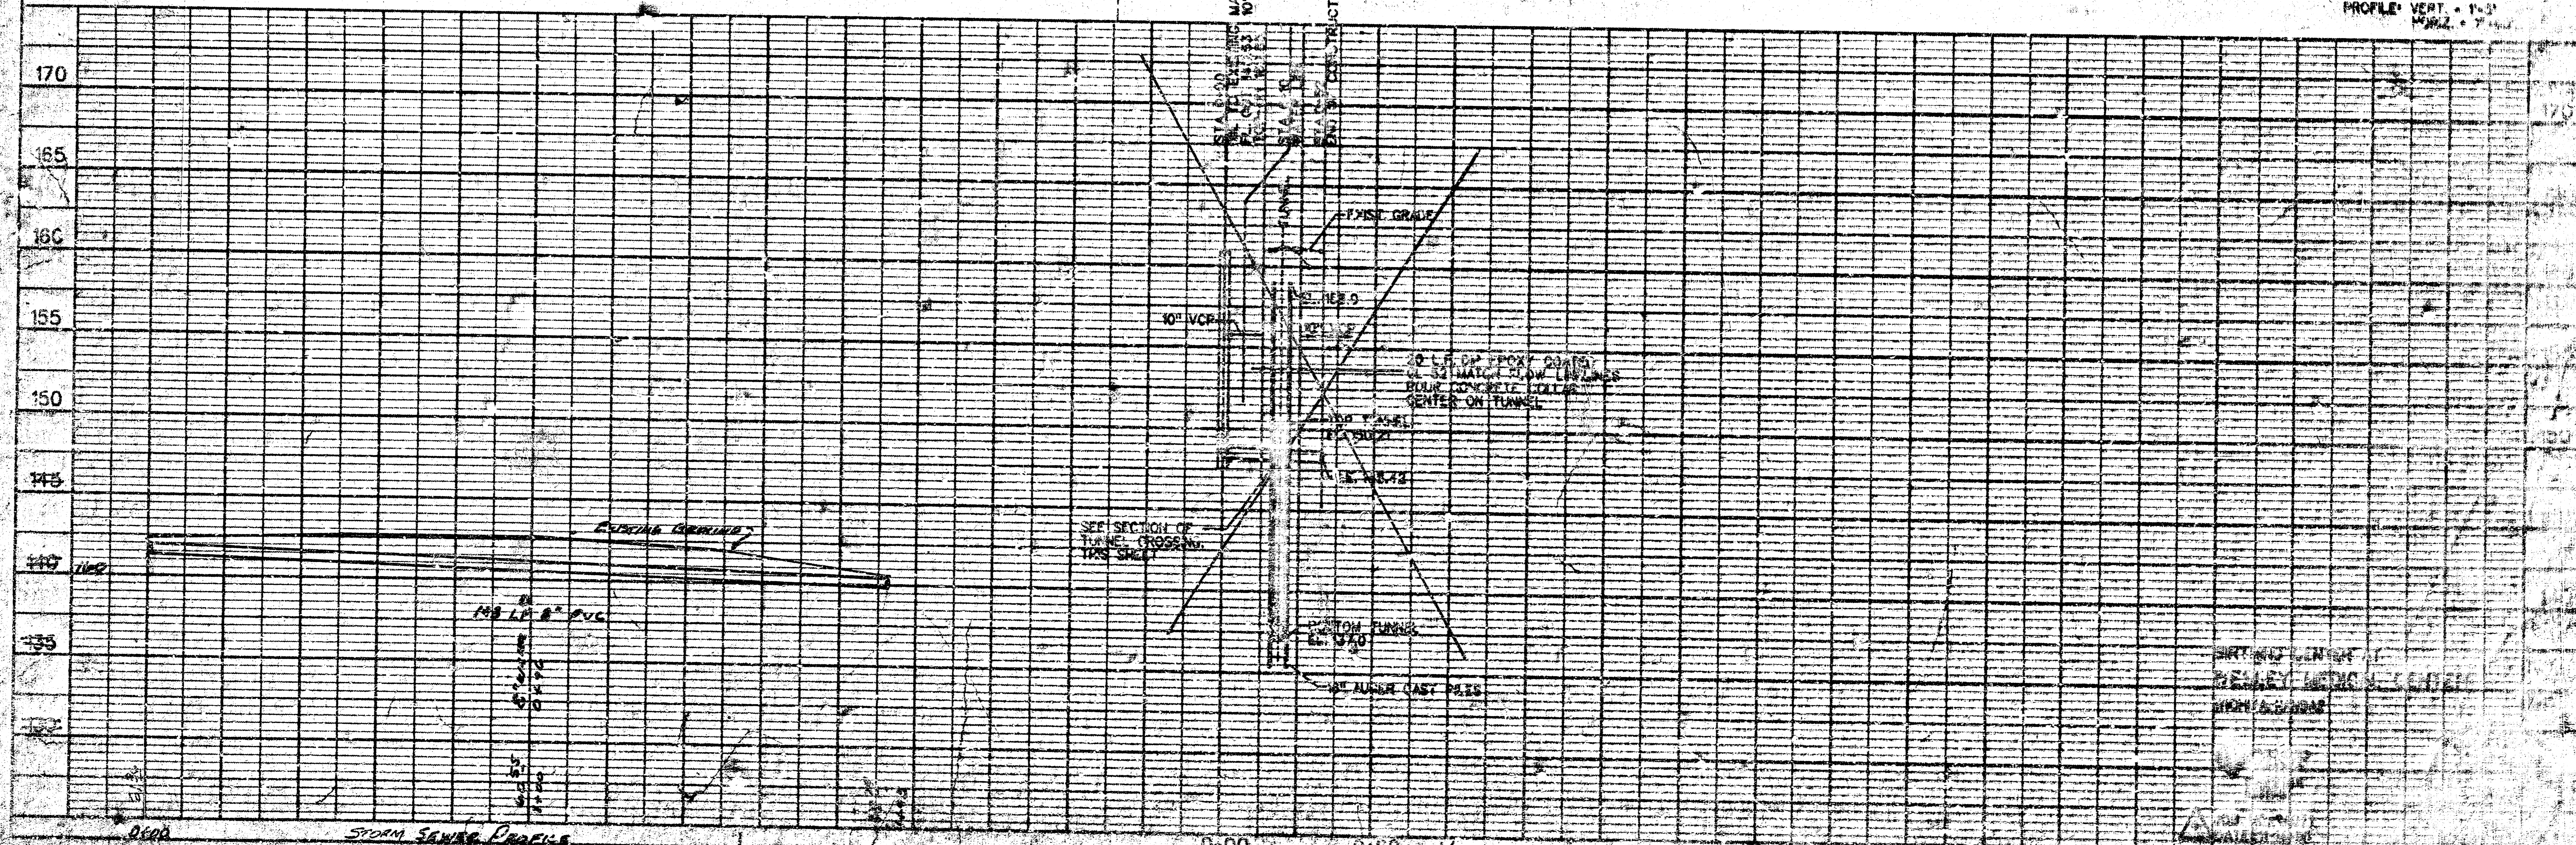

SANITARY SEWER MAINLINE PROFILE